

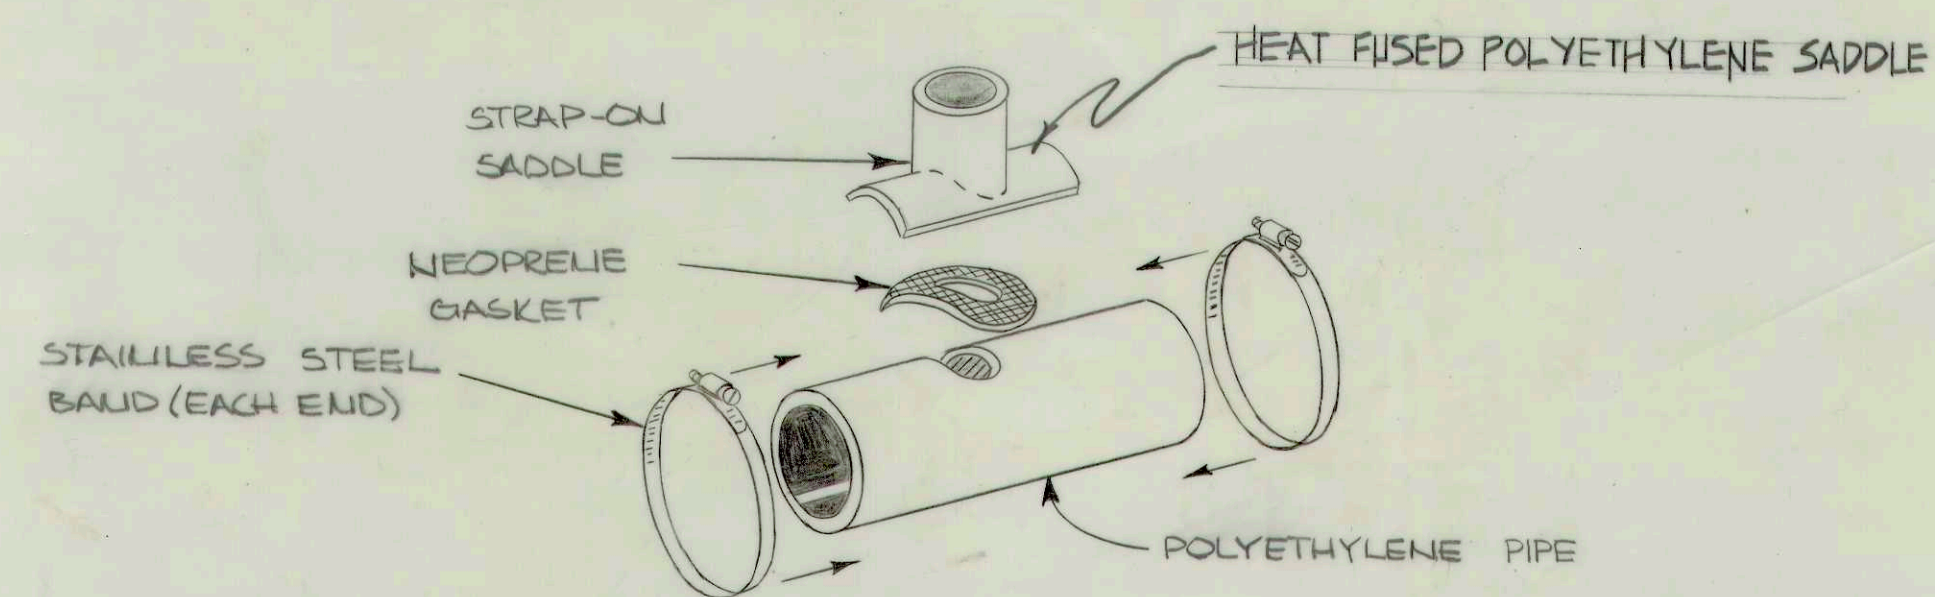
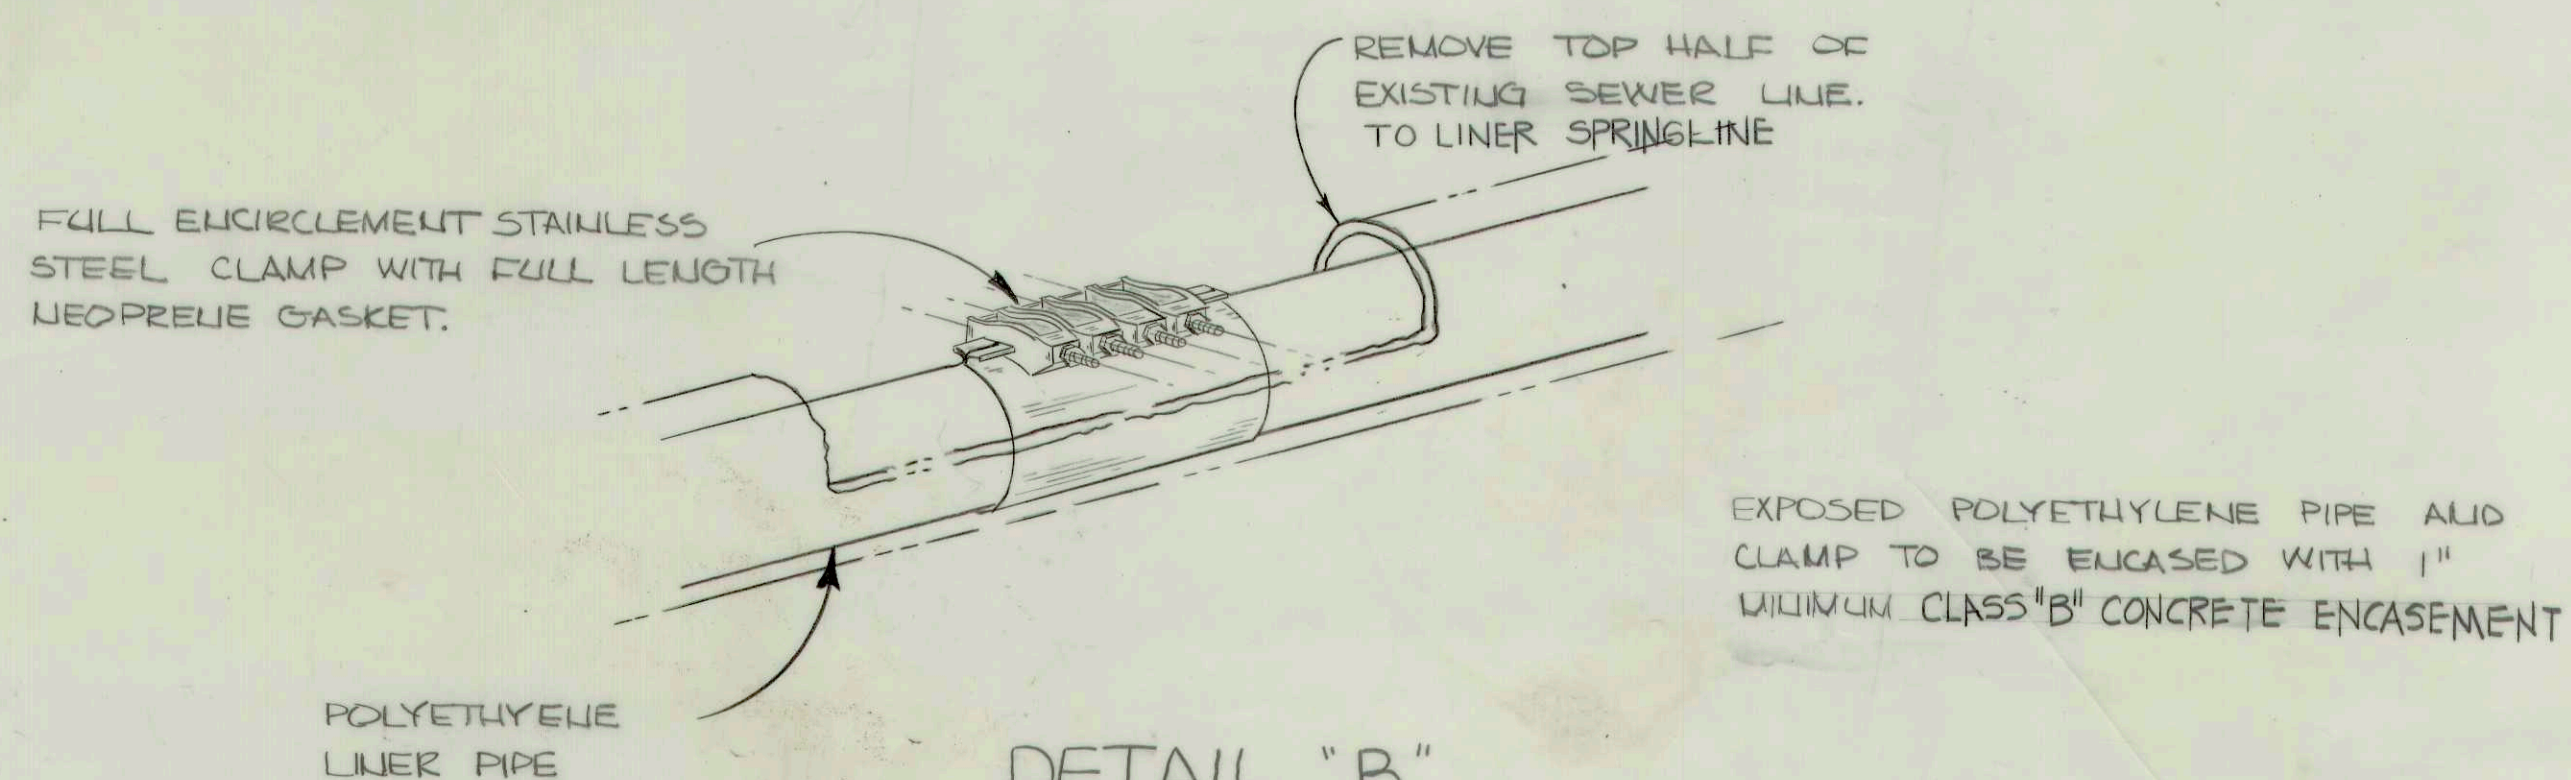
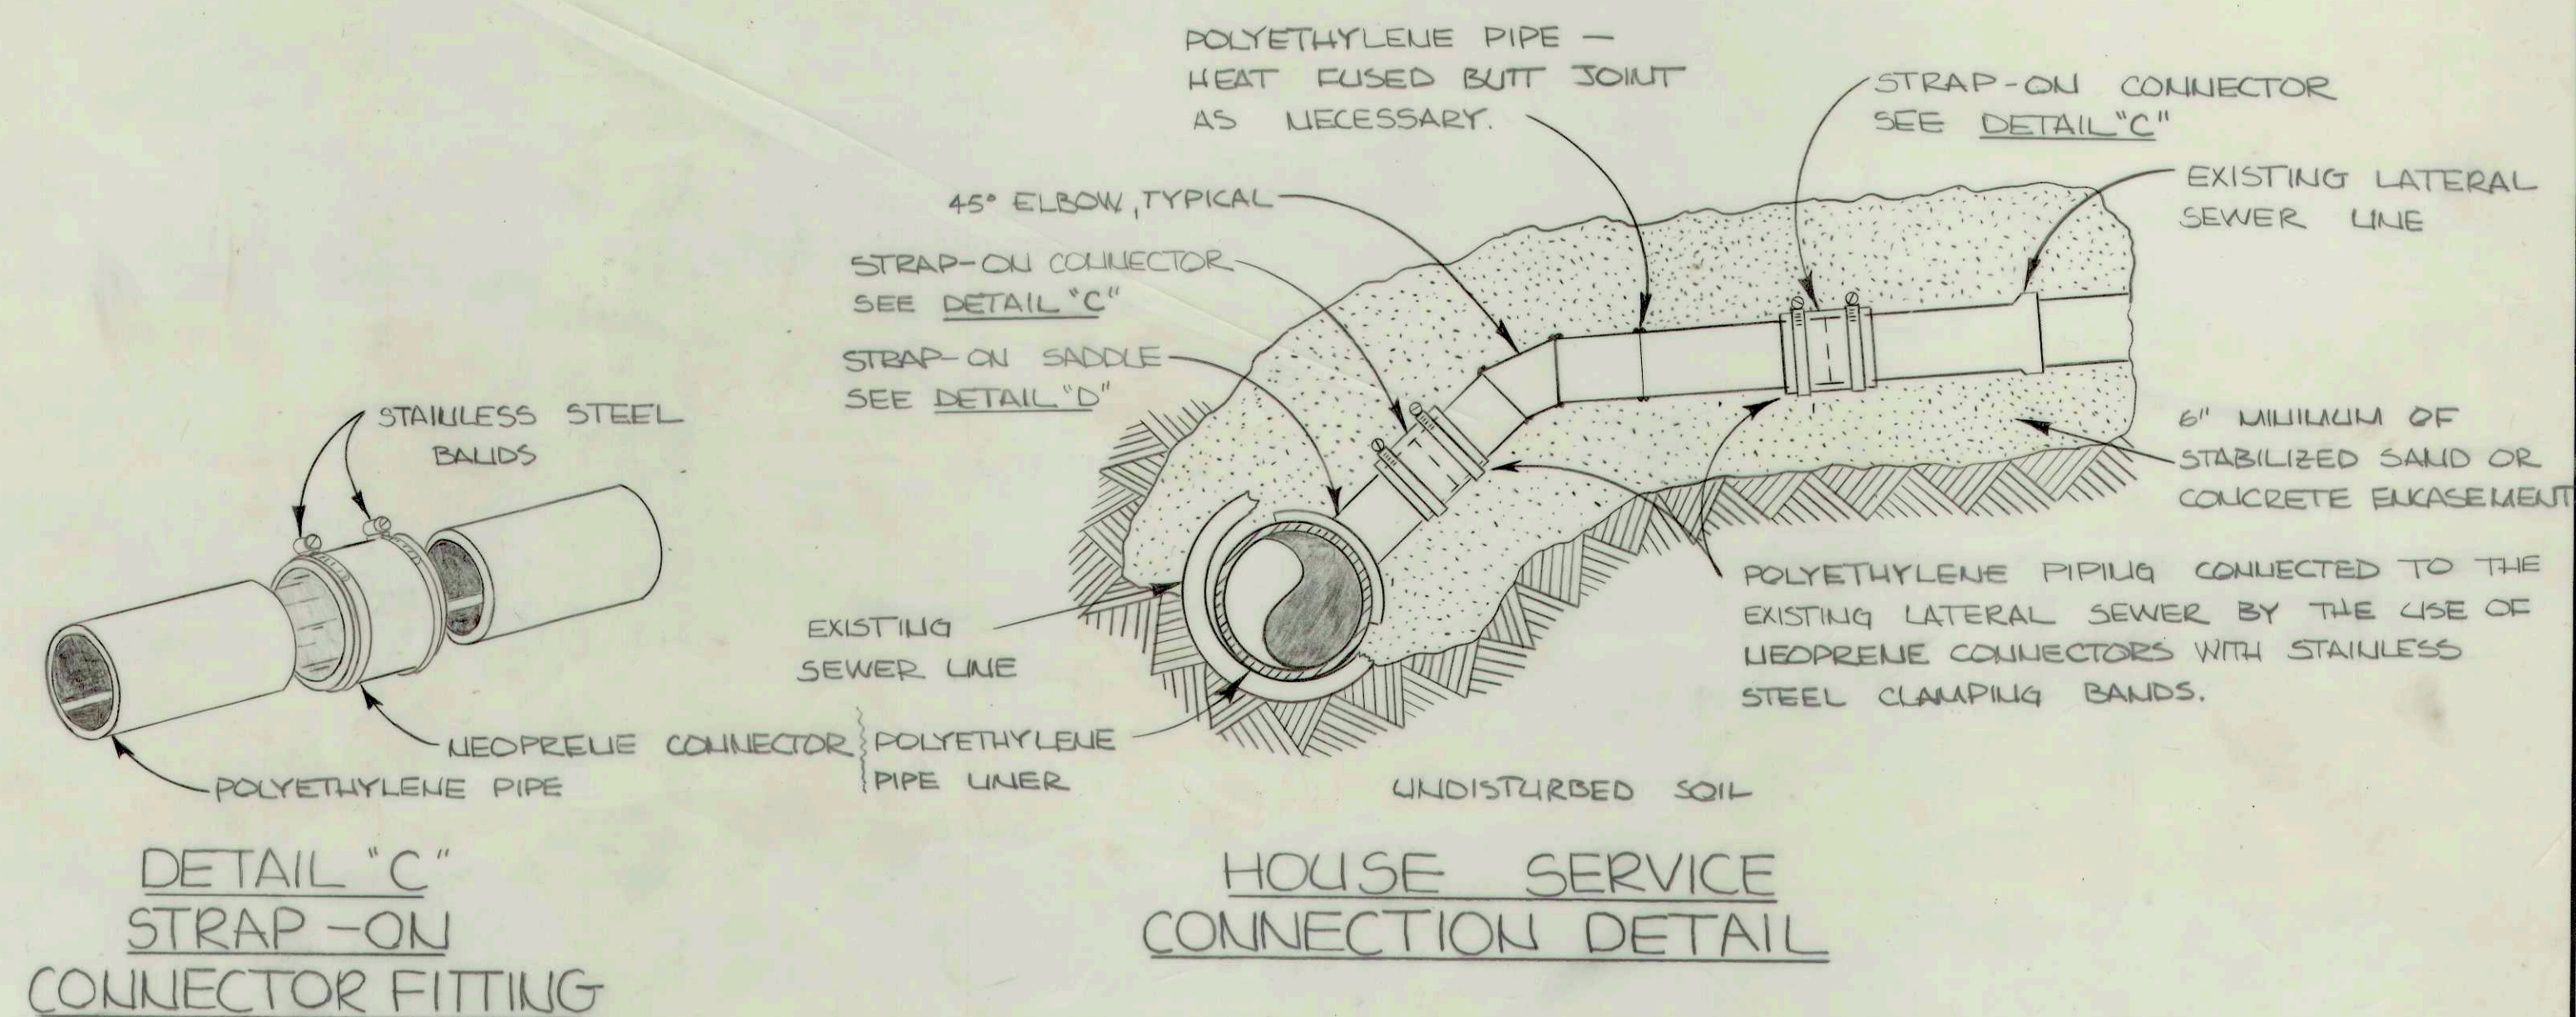
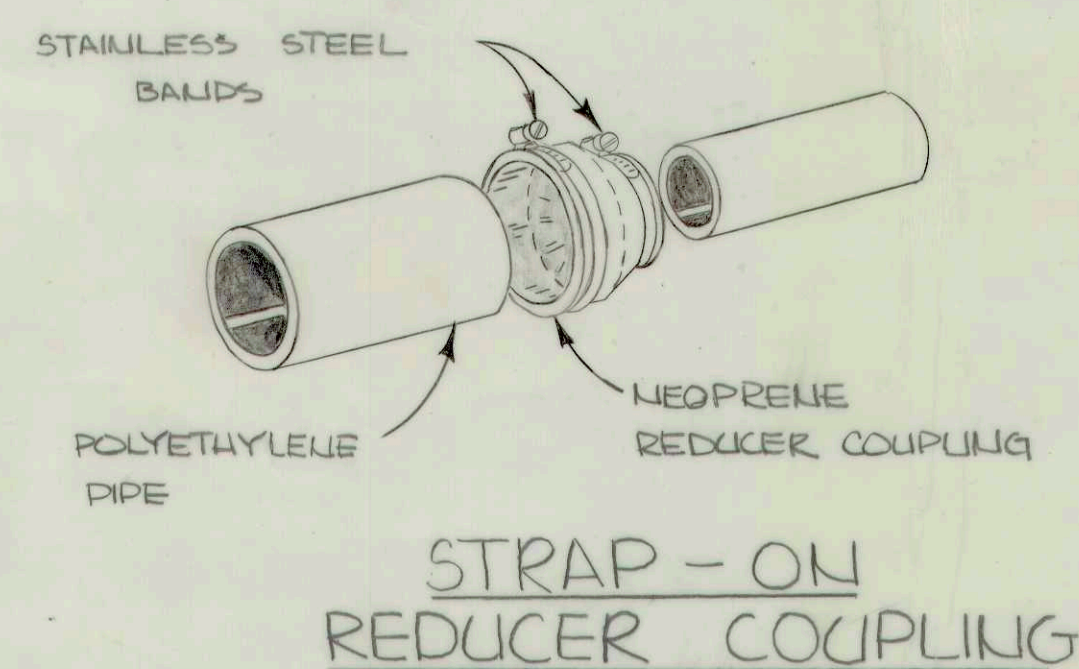


# TYPICAL SLIPLINING WITH HIGH DENSITY POLYETHYLENE PIPE

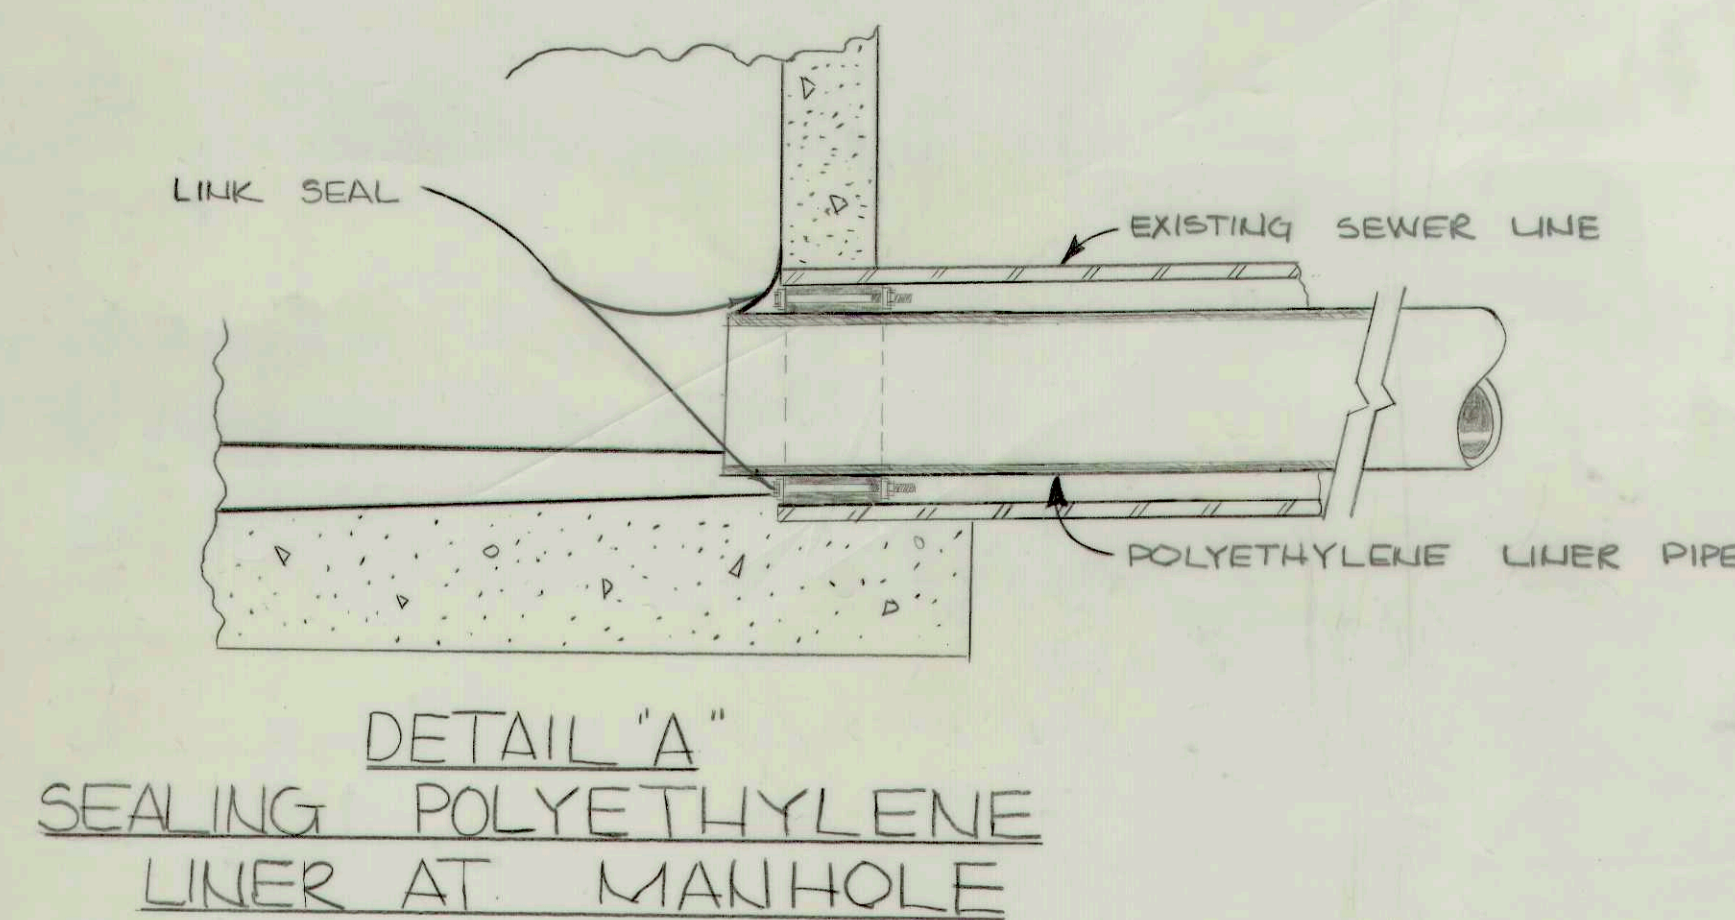

## RECORD DRAWING

| FALL CREEK WASTEWATER FACILITIES |                                                                                             |       |
|----------------------------------|---------------------------------------------------------------------------------------------|-------|
| Scale: NONE                      | SLIPLINING DETAIL                                                                           | Sheet |
| Date: 3-30-83                    | BEAM LONGEST & NEFF<br>Consulting Engineers<br>8136 Castleton Road<br>Indianapolis, Indiana | 99    |
| Dr. By: E.N.                     |                                                                                             |       |
| Certified By: E.R.               |                                                                                             |       |

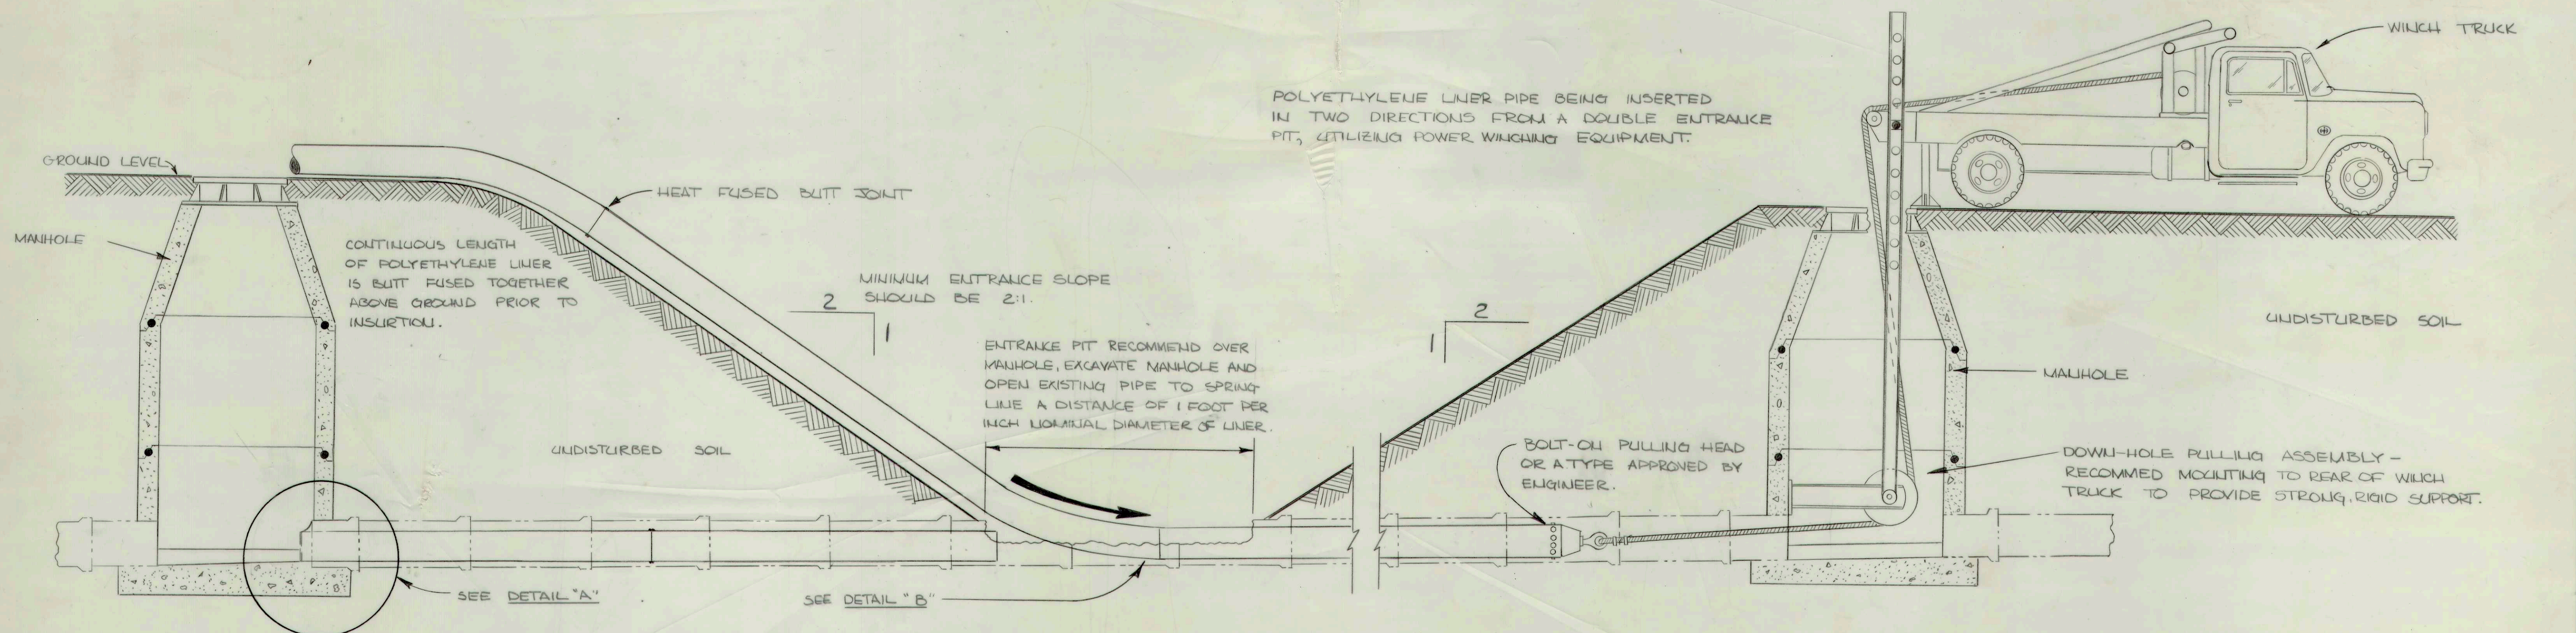