


FALL CREEK REGIONAL WASTE DISTRICT WASTEWATER FACILITIES

DIVISION 'C' FALL CREEK COLLECTION SYSTEM

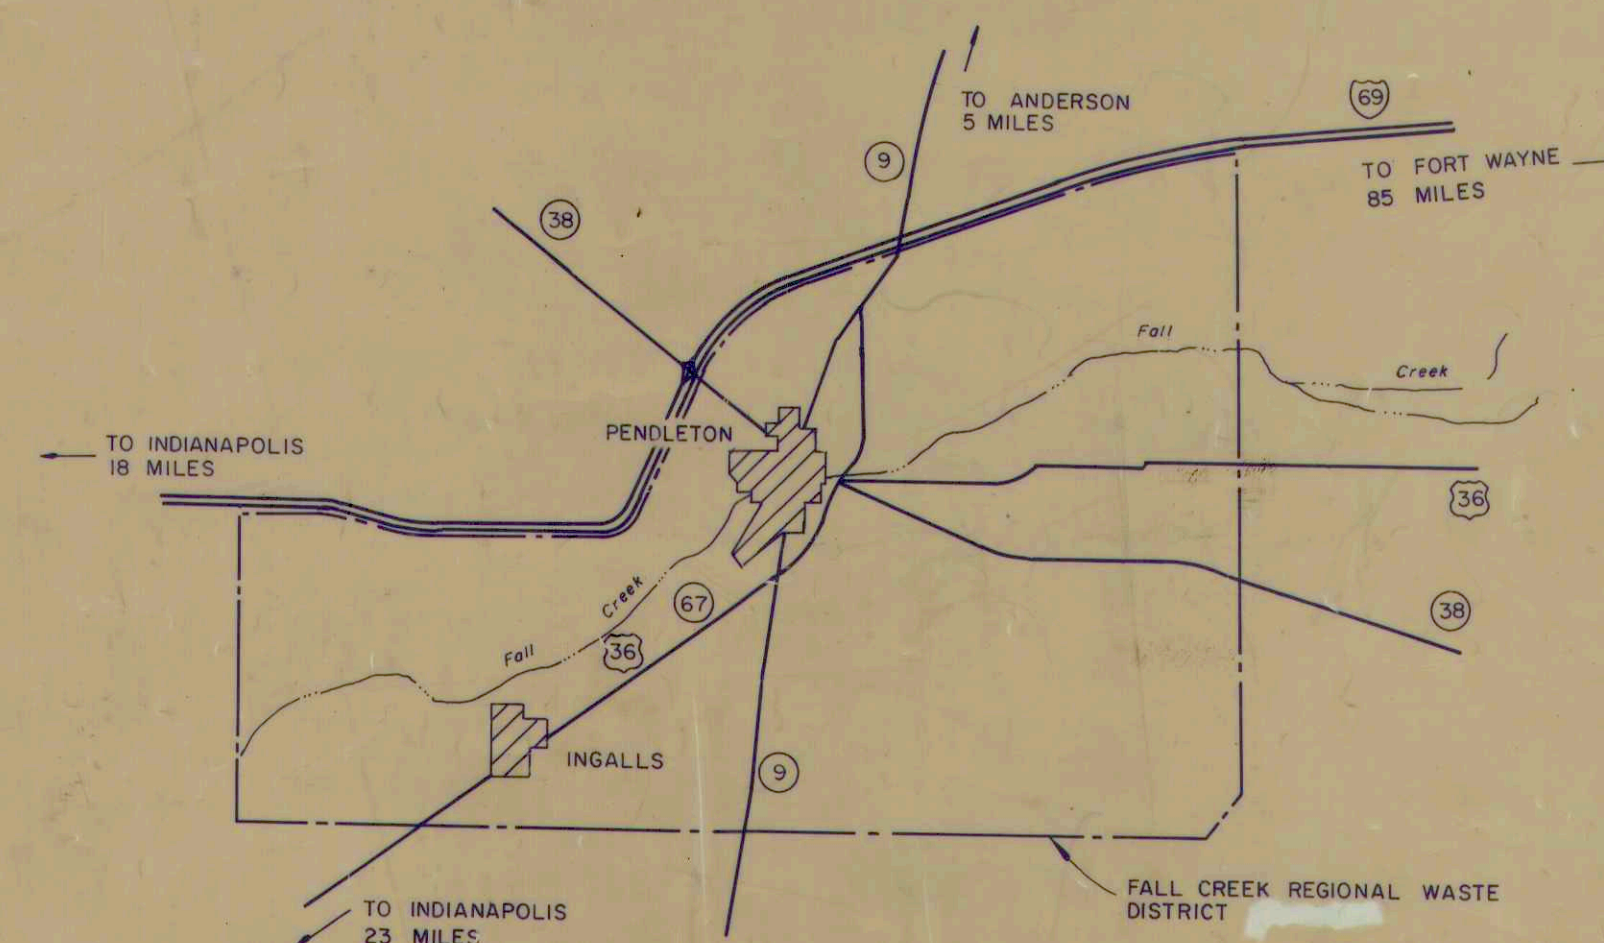

LOCATION OF SECTION INDICATED




PLANS PREPARED BY:

BEAM, LONGEST & NEFF, INC.

CONSULTING ENGINEERS

INDIANAPOLIS, INDIANA

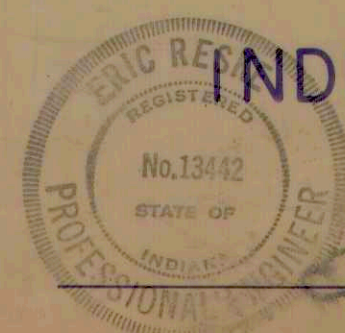

CERTIFIED

March 30, 1983
DATE

APPROVED BY: William Clark

WILLIAM CLARK - PRESIDENT

Marvin Kelly

MARVIN KELLY - VICE PRESIDENT

Morris McCurdy

MORRIS MCCURDY - TREASURER

Robert Post

ROBERT POST - SECRETARY

Hugh Begley

HUGH BEGLEY - MEMBER

Robert Buss

ROBERT BUSS - MEMBER

John Ellingwood

JOHN ELLINGWOOD - MEMBER

Charles Hennis

CHARLES HENNIS - MEMBER

Paul Stoner

PAUL STONER - MEMBER

3-29-83
DATE

RECORD DRAWING