


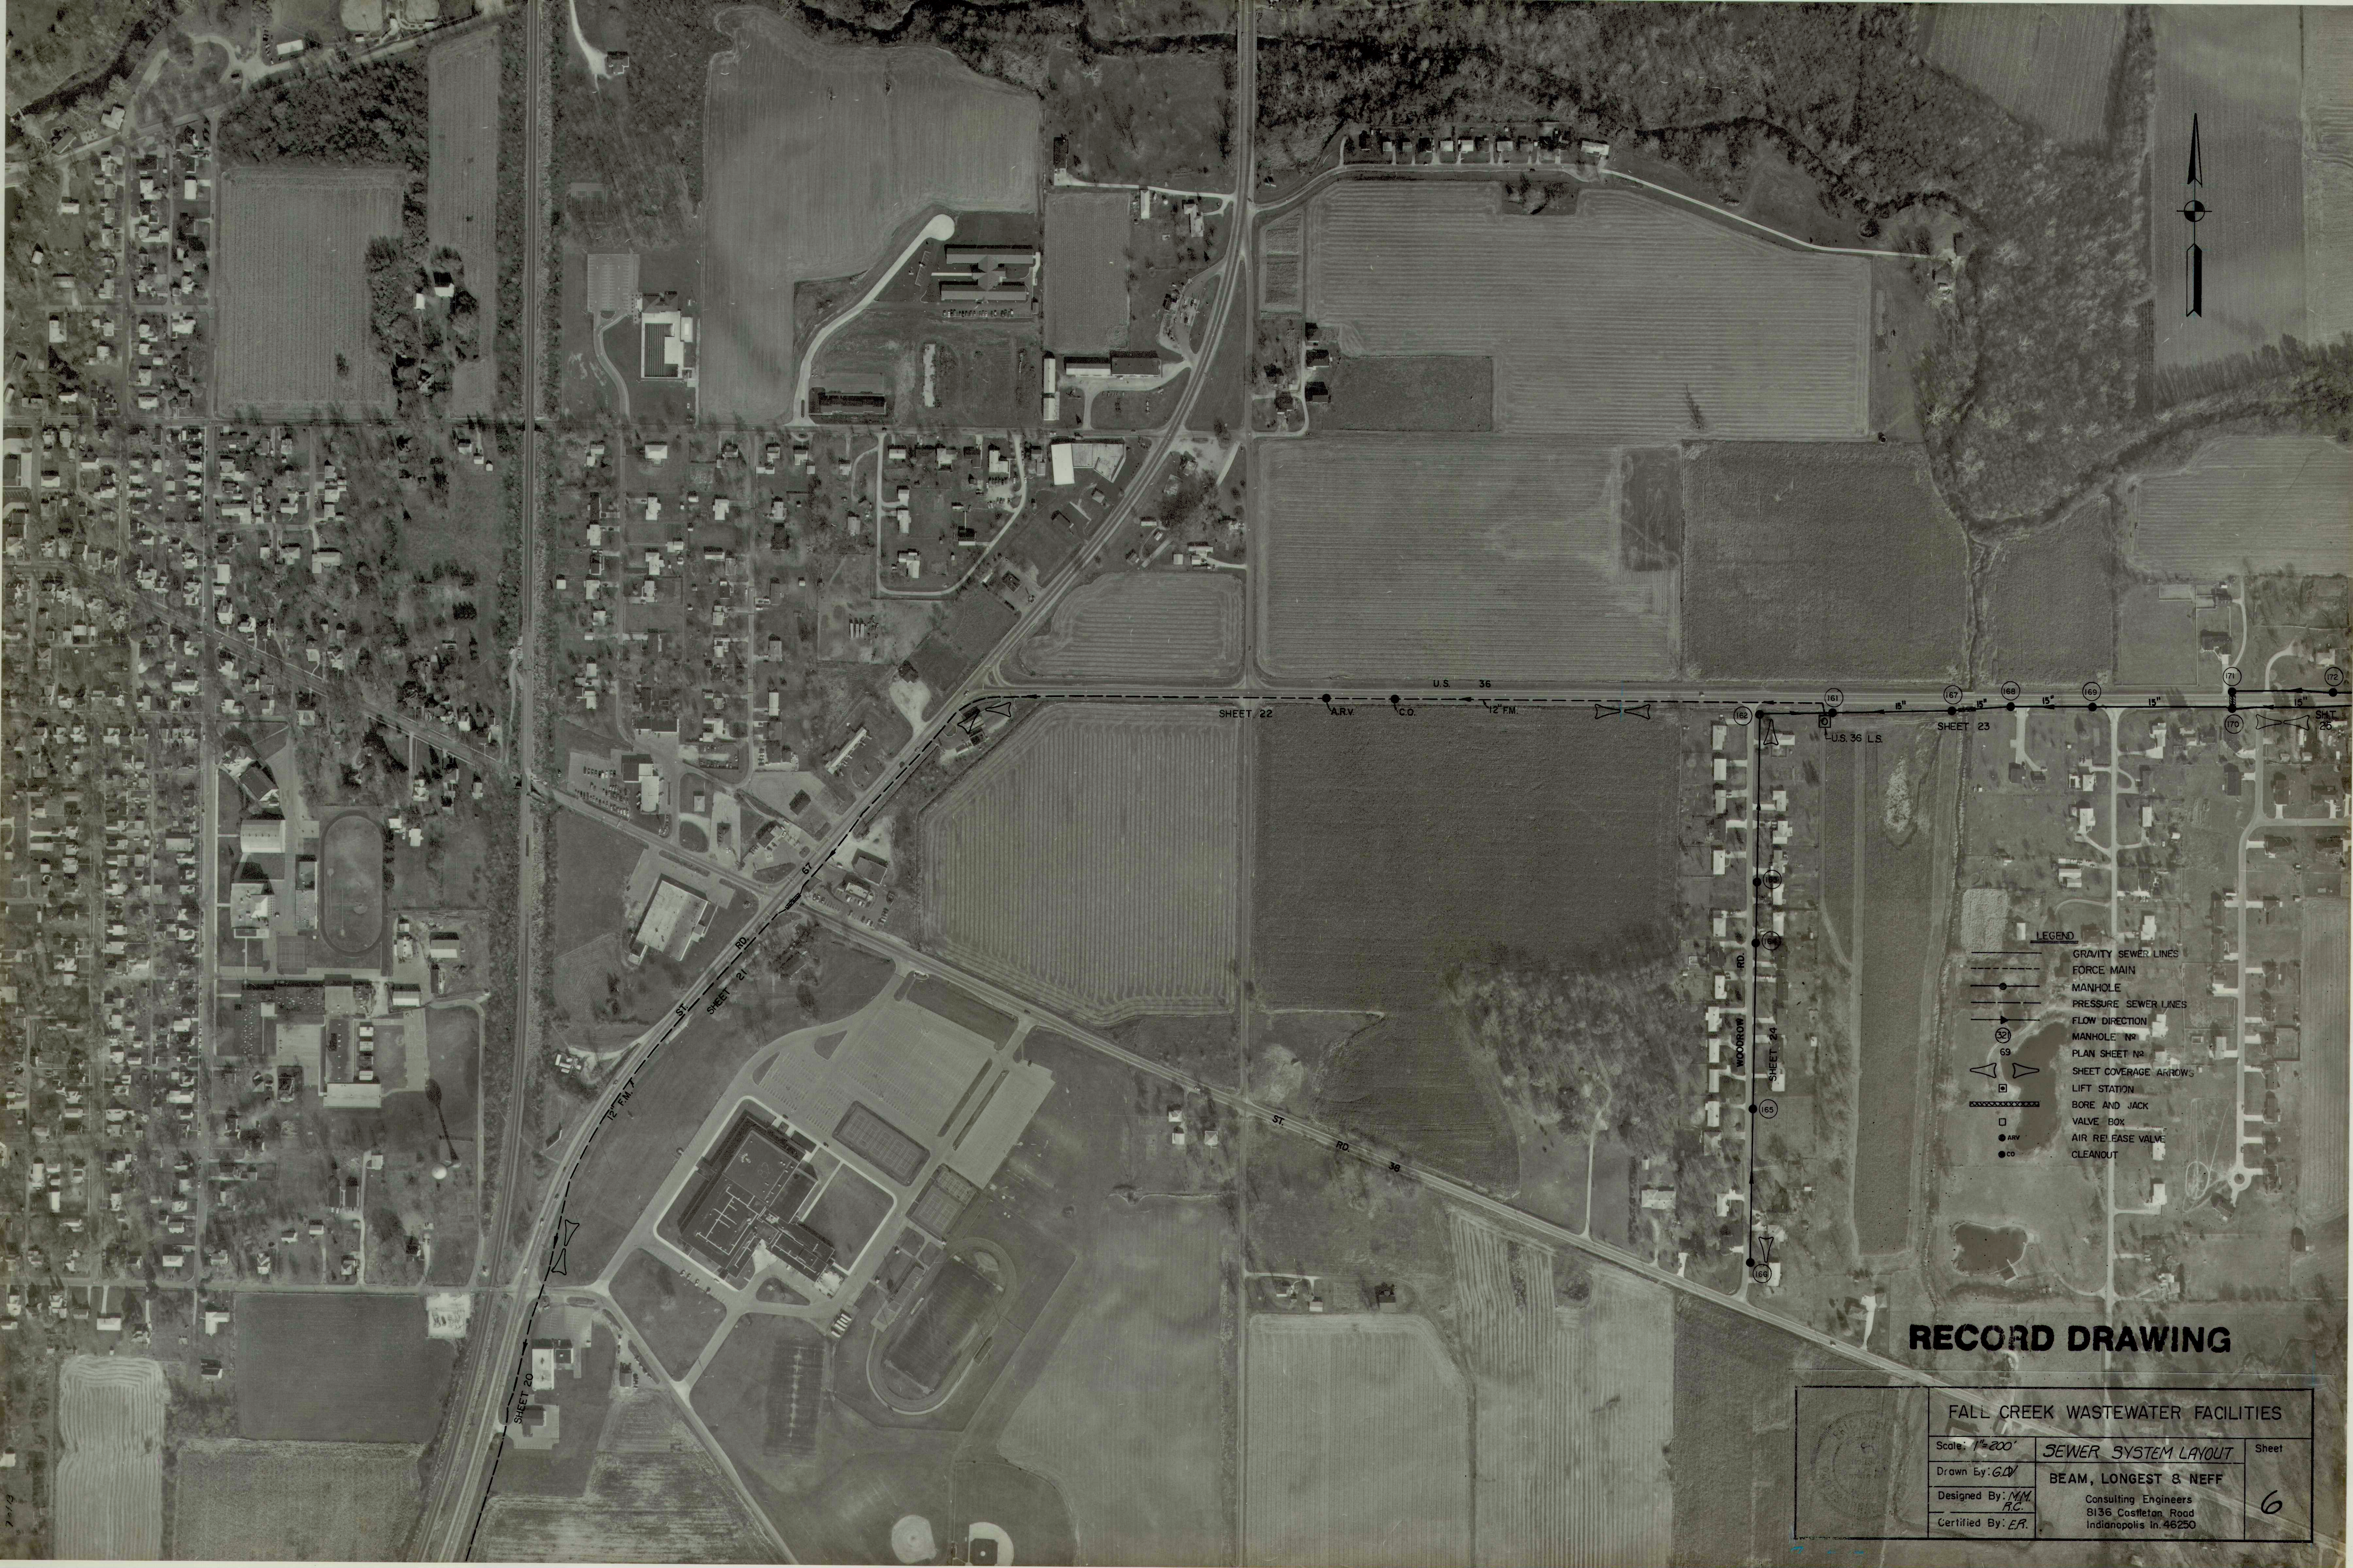

RECORD DRAWING

FALL CREEK WASTEWATER FACILITIES		
Scale: 1"=200'	SEWER SYSTEM LAYOUT	Sheet
Drawn By: G.D.V.	BEAM, LONGEST & NEFF	6
Designed By: M.M. R.C.	Consulting Engineers 8136 Cassletan Road Indianapolis In. 46250	
Certified By: E.R.		