


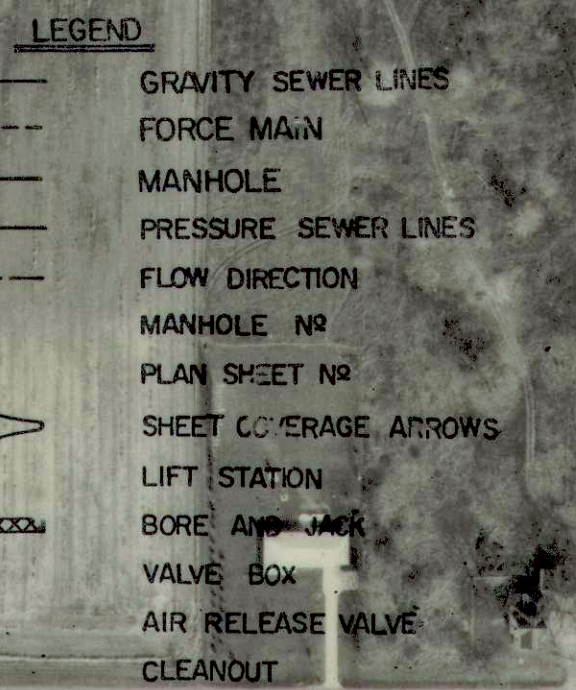

FALL CREEK WASTEWATER FACILITIES

SEWER SYSTEM LAYOUT

BEAM, LONGEST & NEFF

Consulting Engineers
8136 Castleton Road
Indianapolis In. 46250

heet

8