

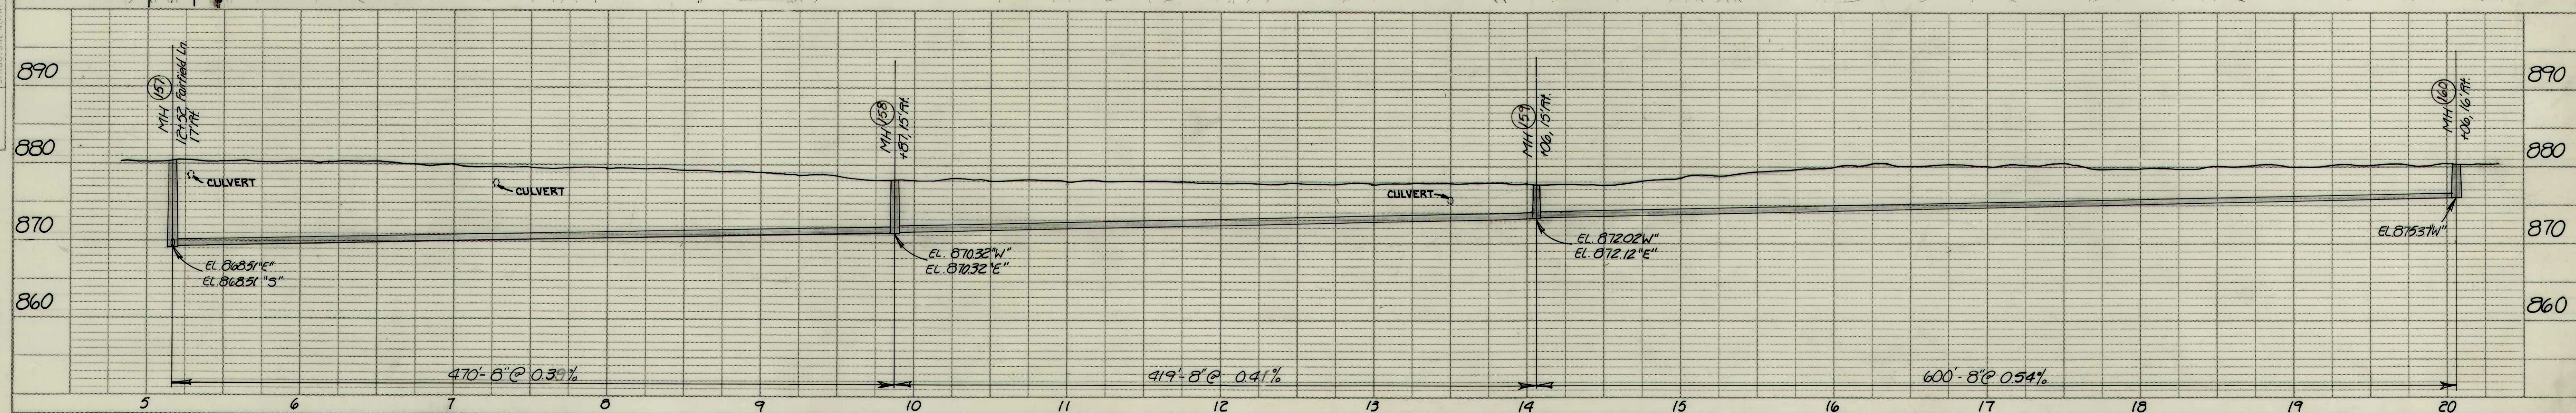
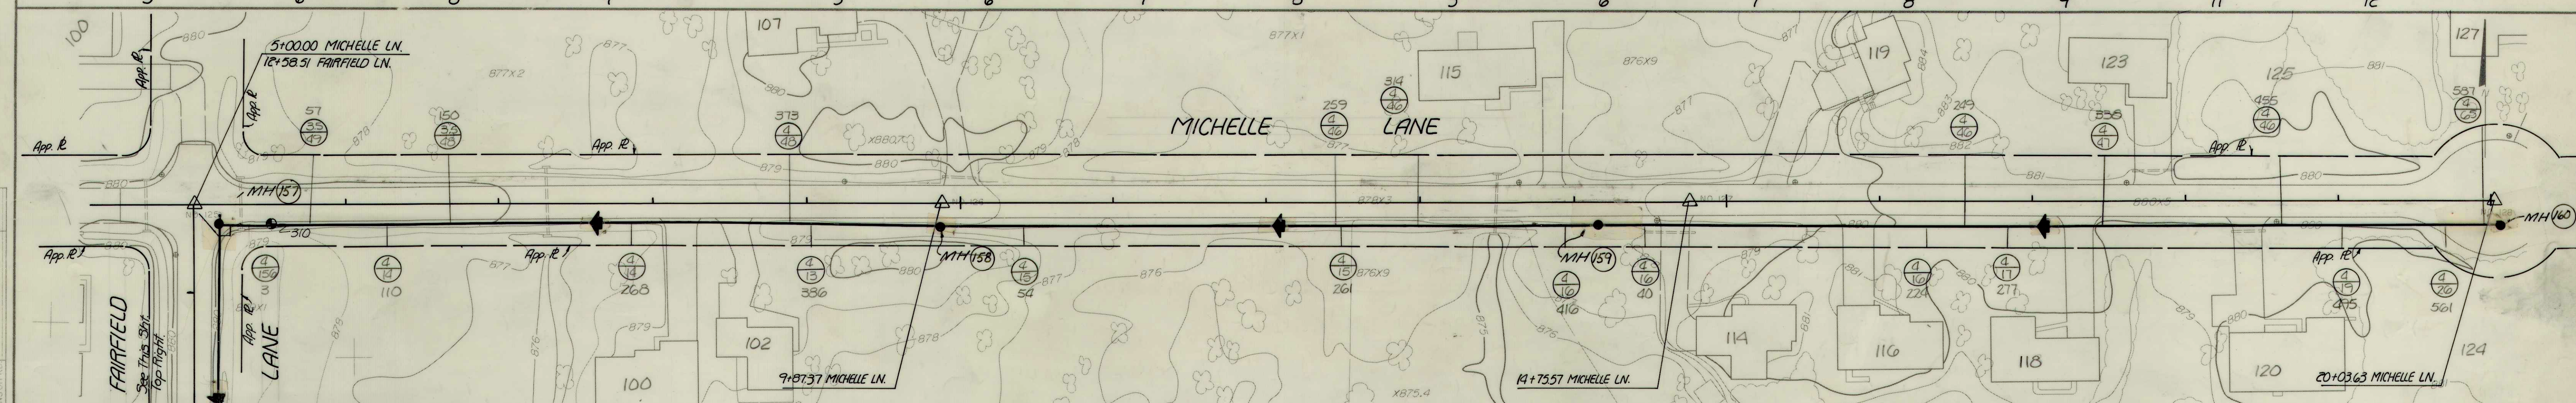


DATE:
 BY:
 SURVEYED:
 PLOTTED:
 NOTE BOOK:
 NO.
 CHECKED:
 NO.
 STRUCTURE NOTATION:
 NO.

DATE:
 BY:
 SURVEYED:
 PLOTTED:
 NOTE BOOK:
 NO.
 CHECKED:
 NO.
 STRUCTURE NOTATION:
 NO.

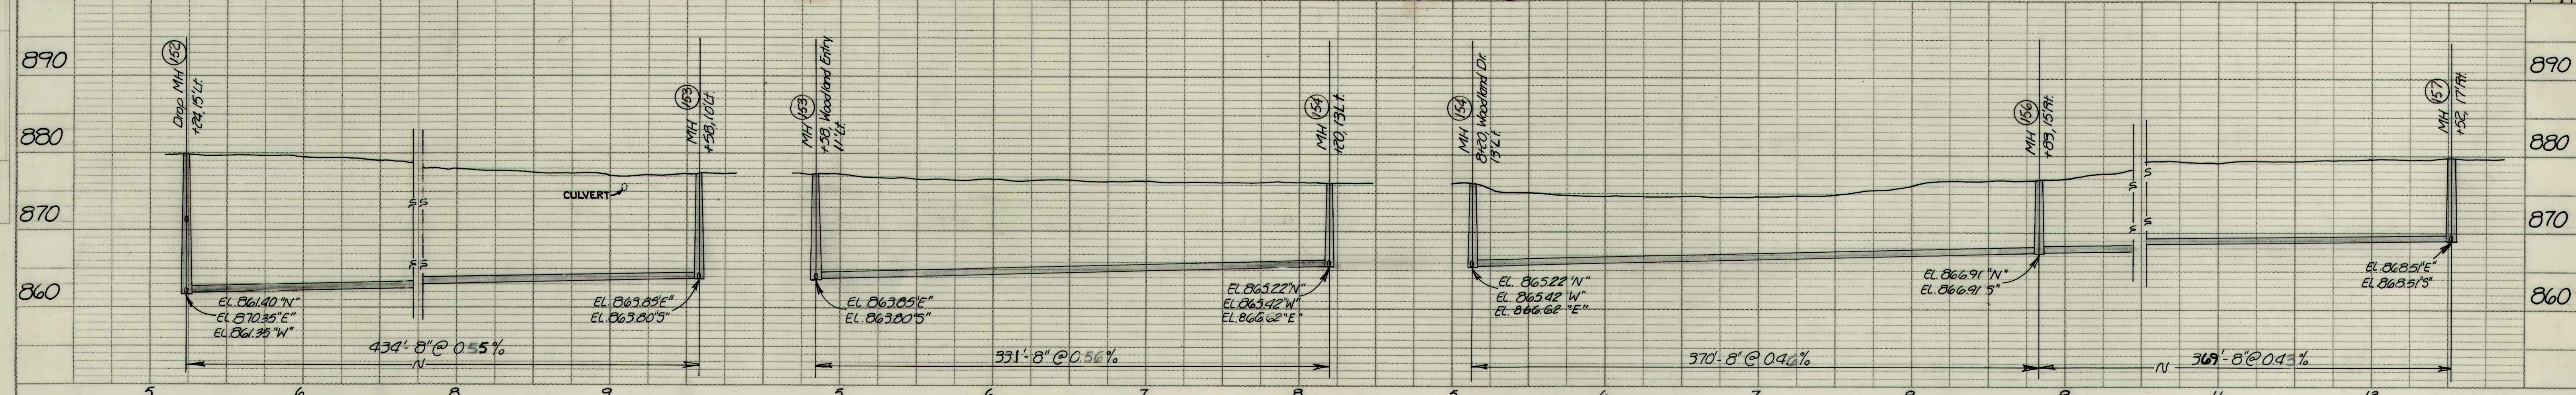

RECORD DRAWING

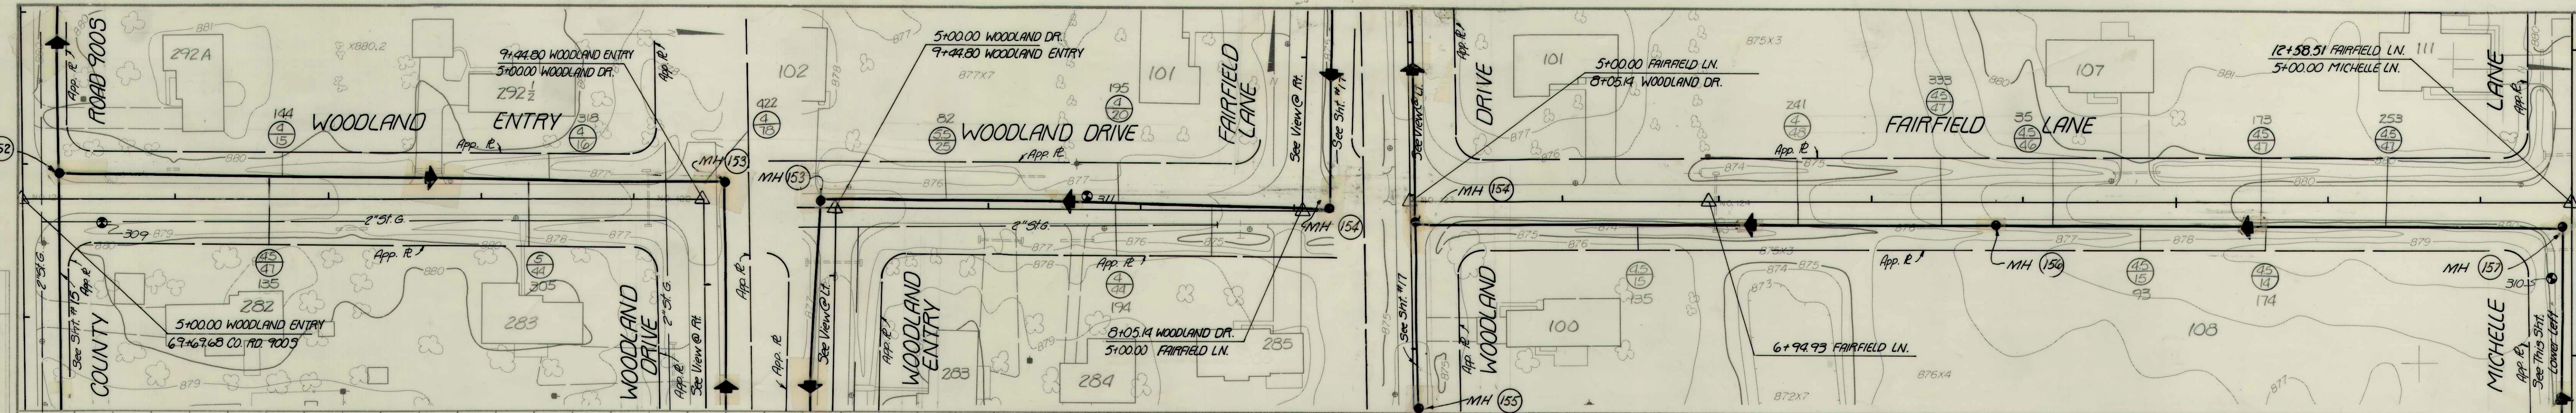

WOODLAND ENTRY & DR./FAIRFIELD LN.
MICHELLE LANE
FALL CREEK R.W.D. PLAN & PROFILE SHEET
HORIZ. 1"=50'
VERT. 1"=10'
BEAM, LONGEST & NEFF, INC.
CONSULTING ENGINEERS
INDIANAPOLIS, INDIANA
14