
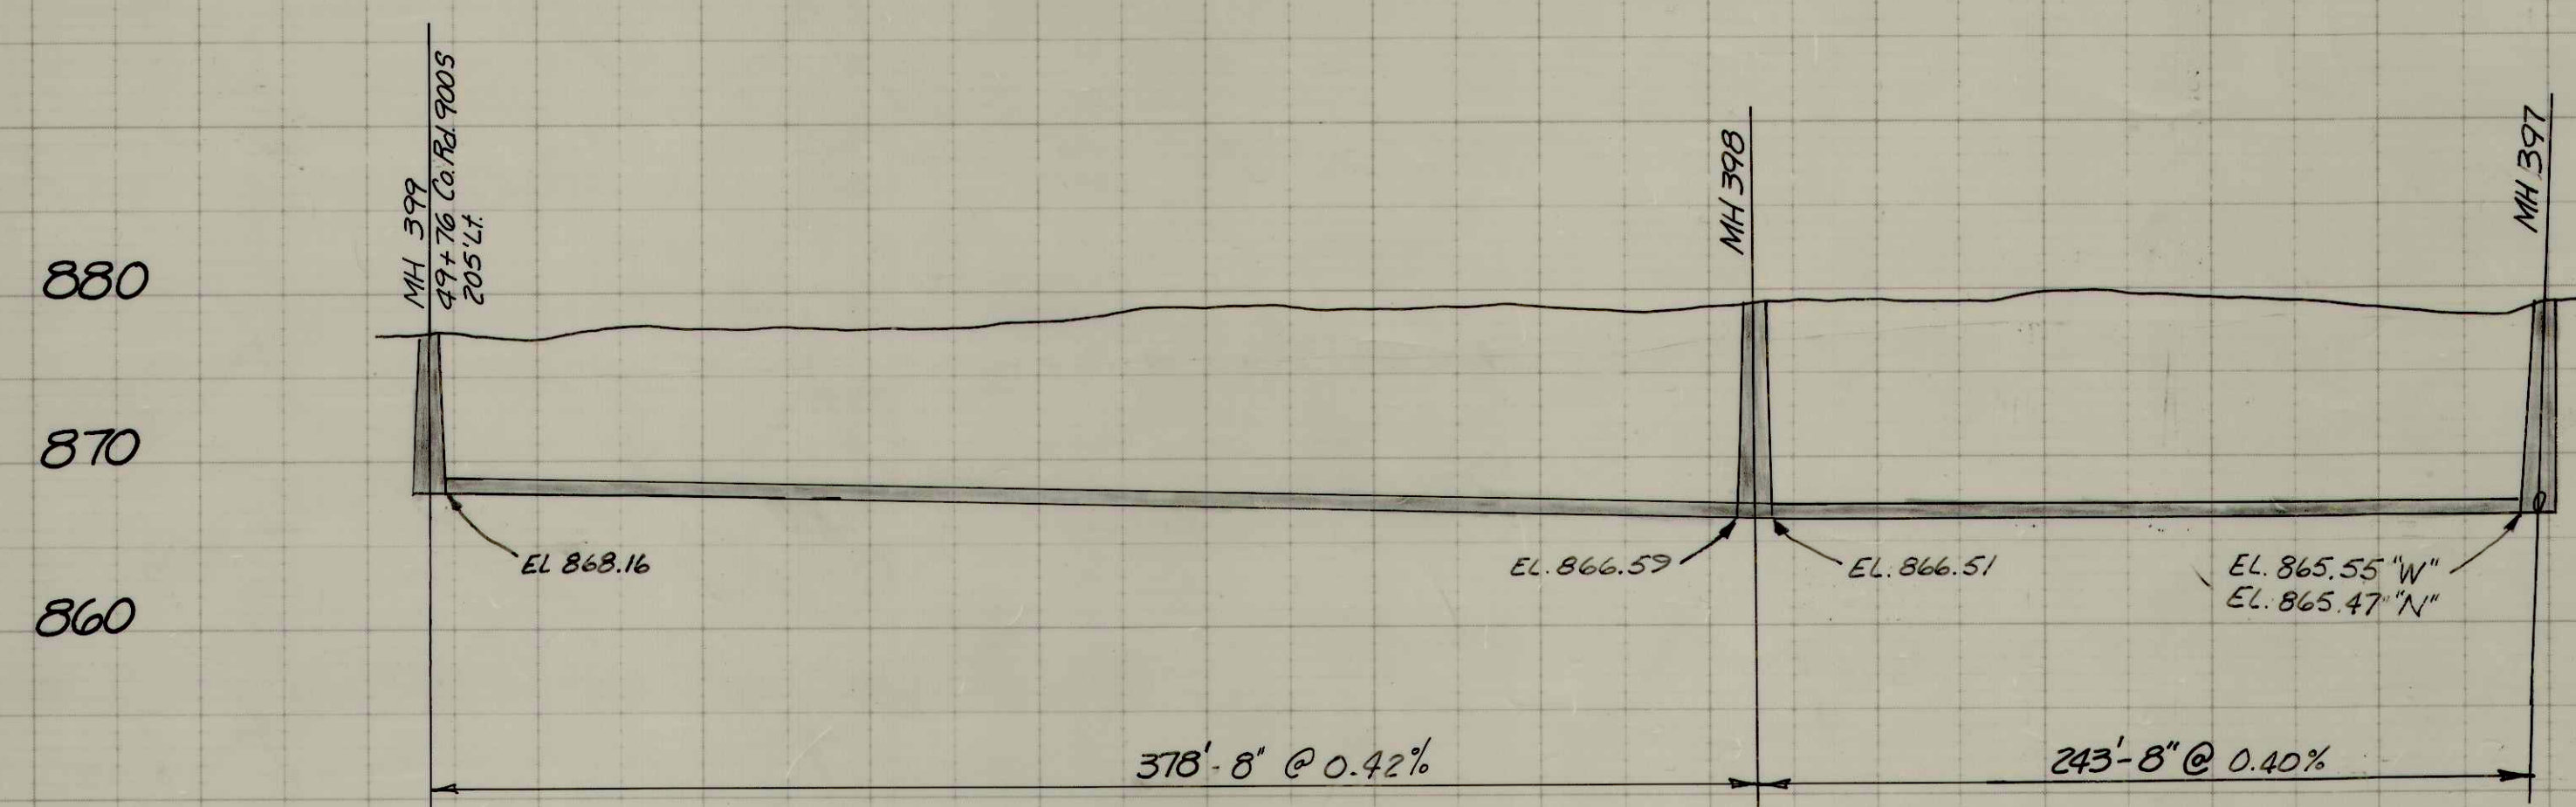


PLAN
 SURVEYED
 NOTED
 NOTE BOOK
 NO.

PROFILE
 SURVEYED
 NOTED
 NOTE BOOK
 NO.

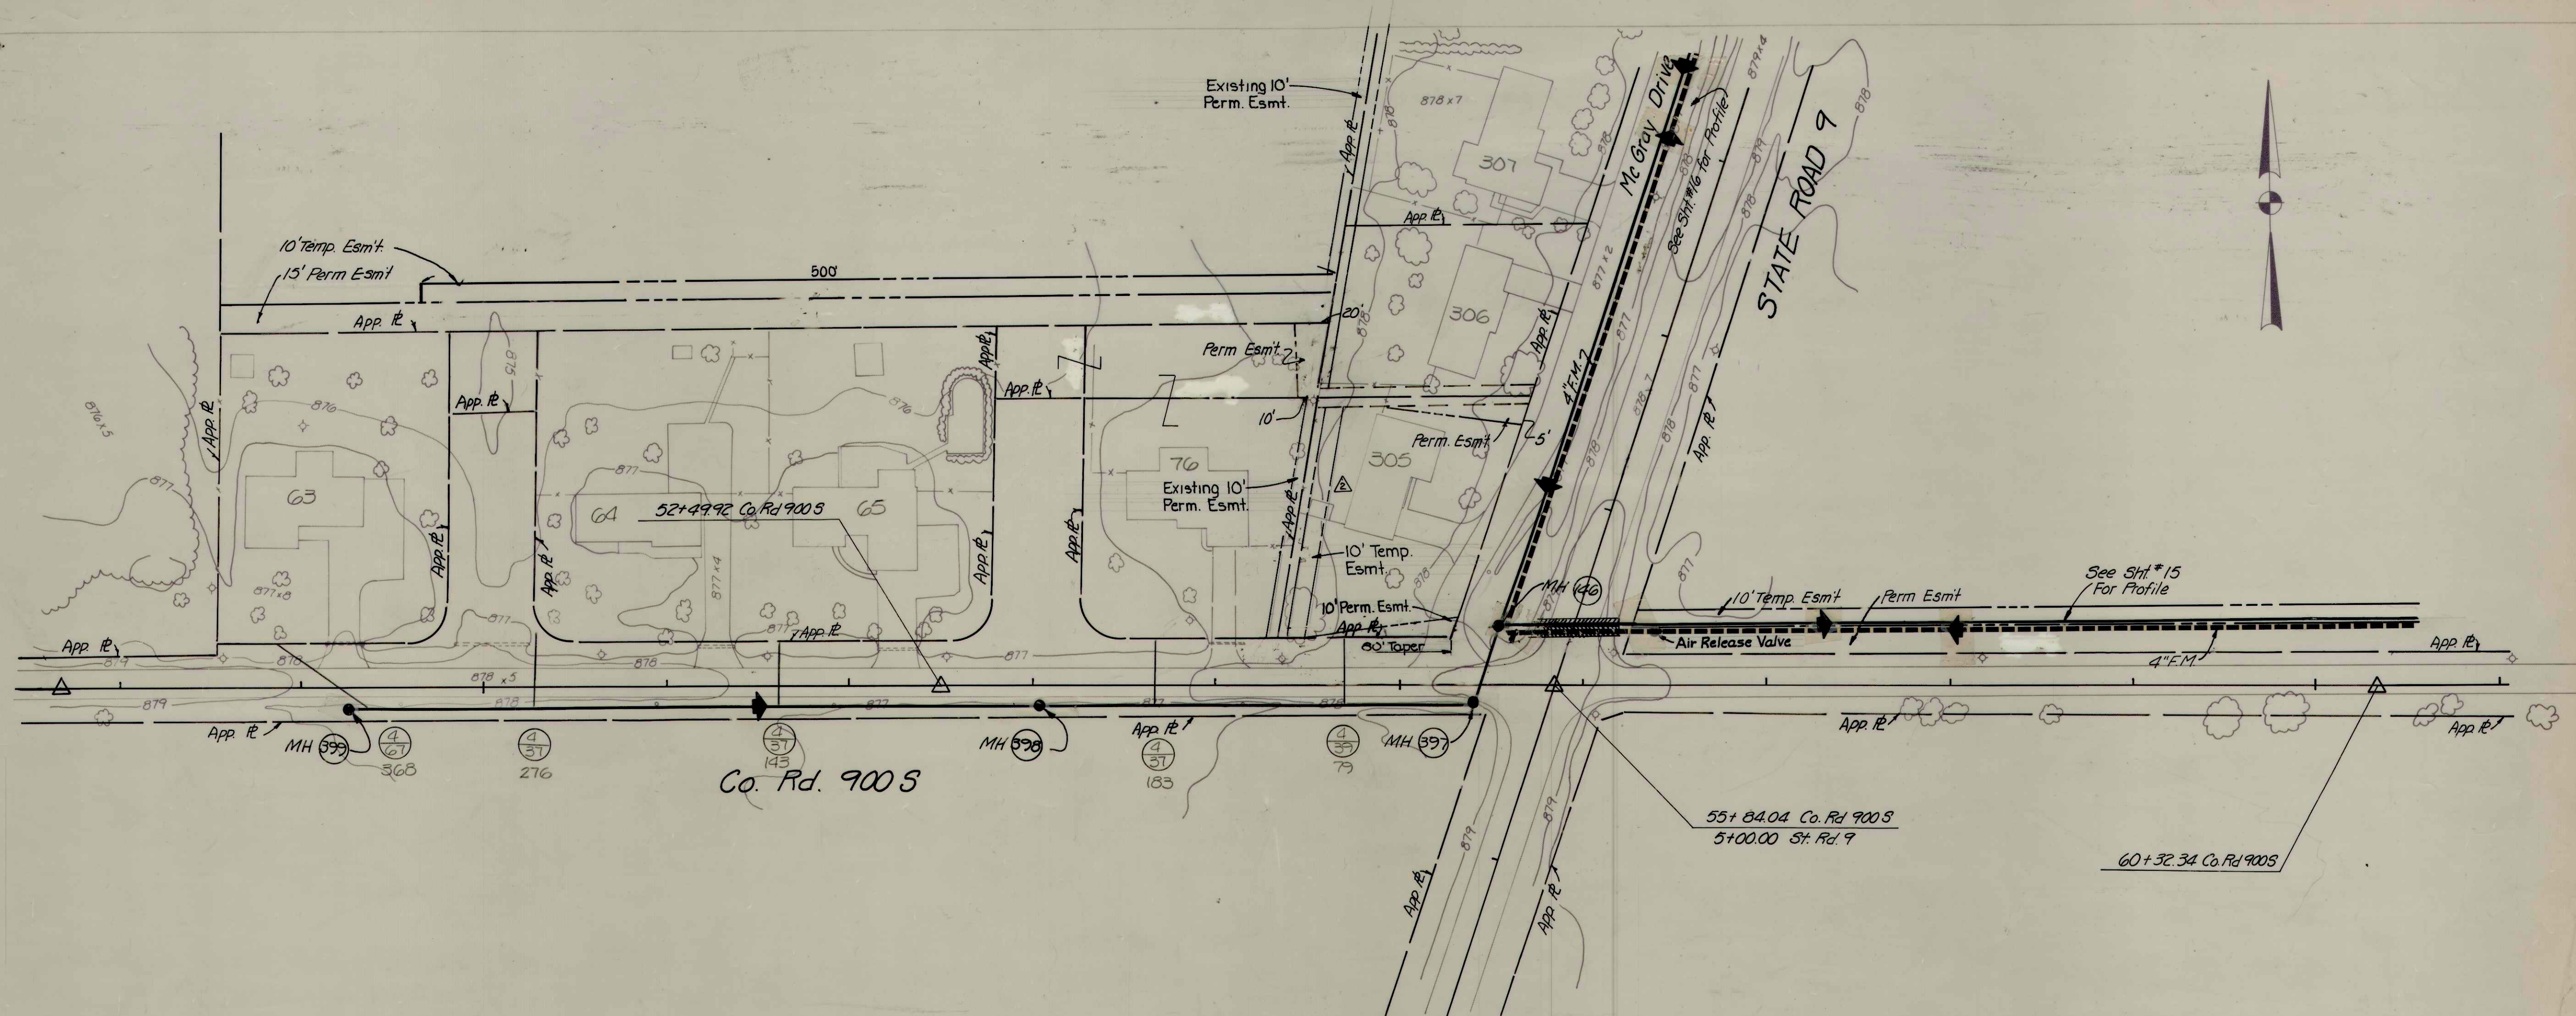

Revision: 3-20-84
 (Remove App. R)

COUNTY ROAD 900 SOUTH
 FALL CREEK R.W.D. PLAN & PROFILE SHEET
 HORIZ. 1"=50'
 VERT. 1"=10'
 BEAM, LONGEST & NEFF, INC.
 CONSULTING ENGINEERS
 INDIANAPOLIS, INDIANA
 15A

RECORD DRAWING

Rev. 11-8-83 Δ Rev. 7-30-85

PLATE 3 PLAN, PROFILE & STANDARD
 1975