


PLAN	SURVEYED	DATE
NO.	BY	
NOTE BOOK	PLOTTED	
	GRADES CHECKED	
	STRUCTURE NOTATIONS CHECKED	

PROFILE	SURVEYED	DATE
NO.	BY	
NOTE BOOK	PLOTTED	
	GRADES CHECKED	
	STRUCTURE NOTATIONS CHECKED	



RECORD DRAWING

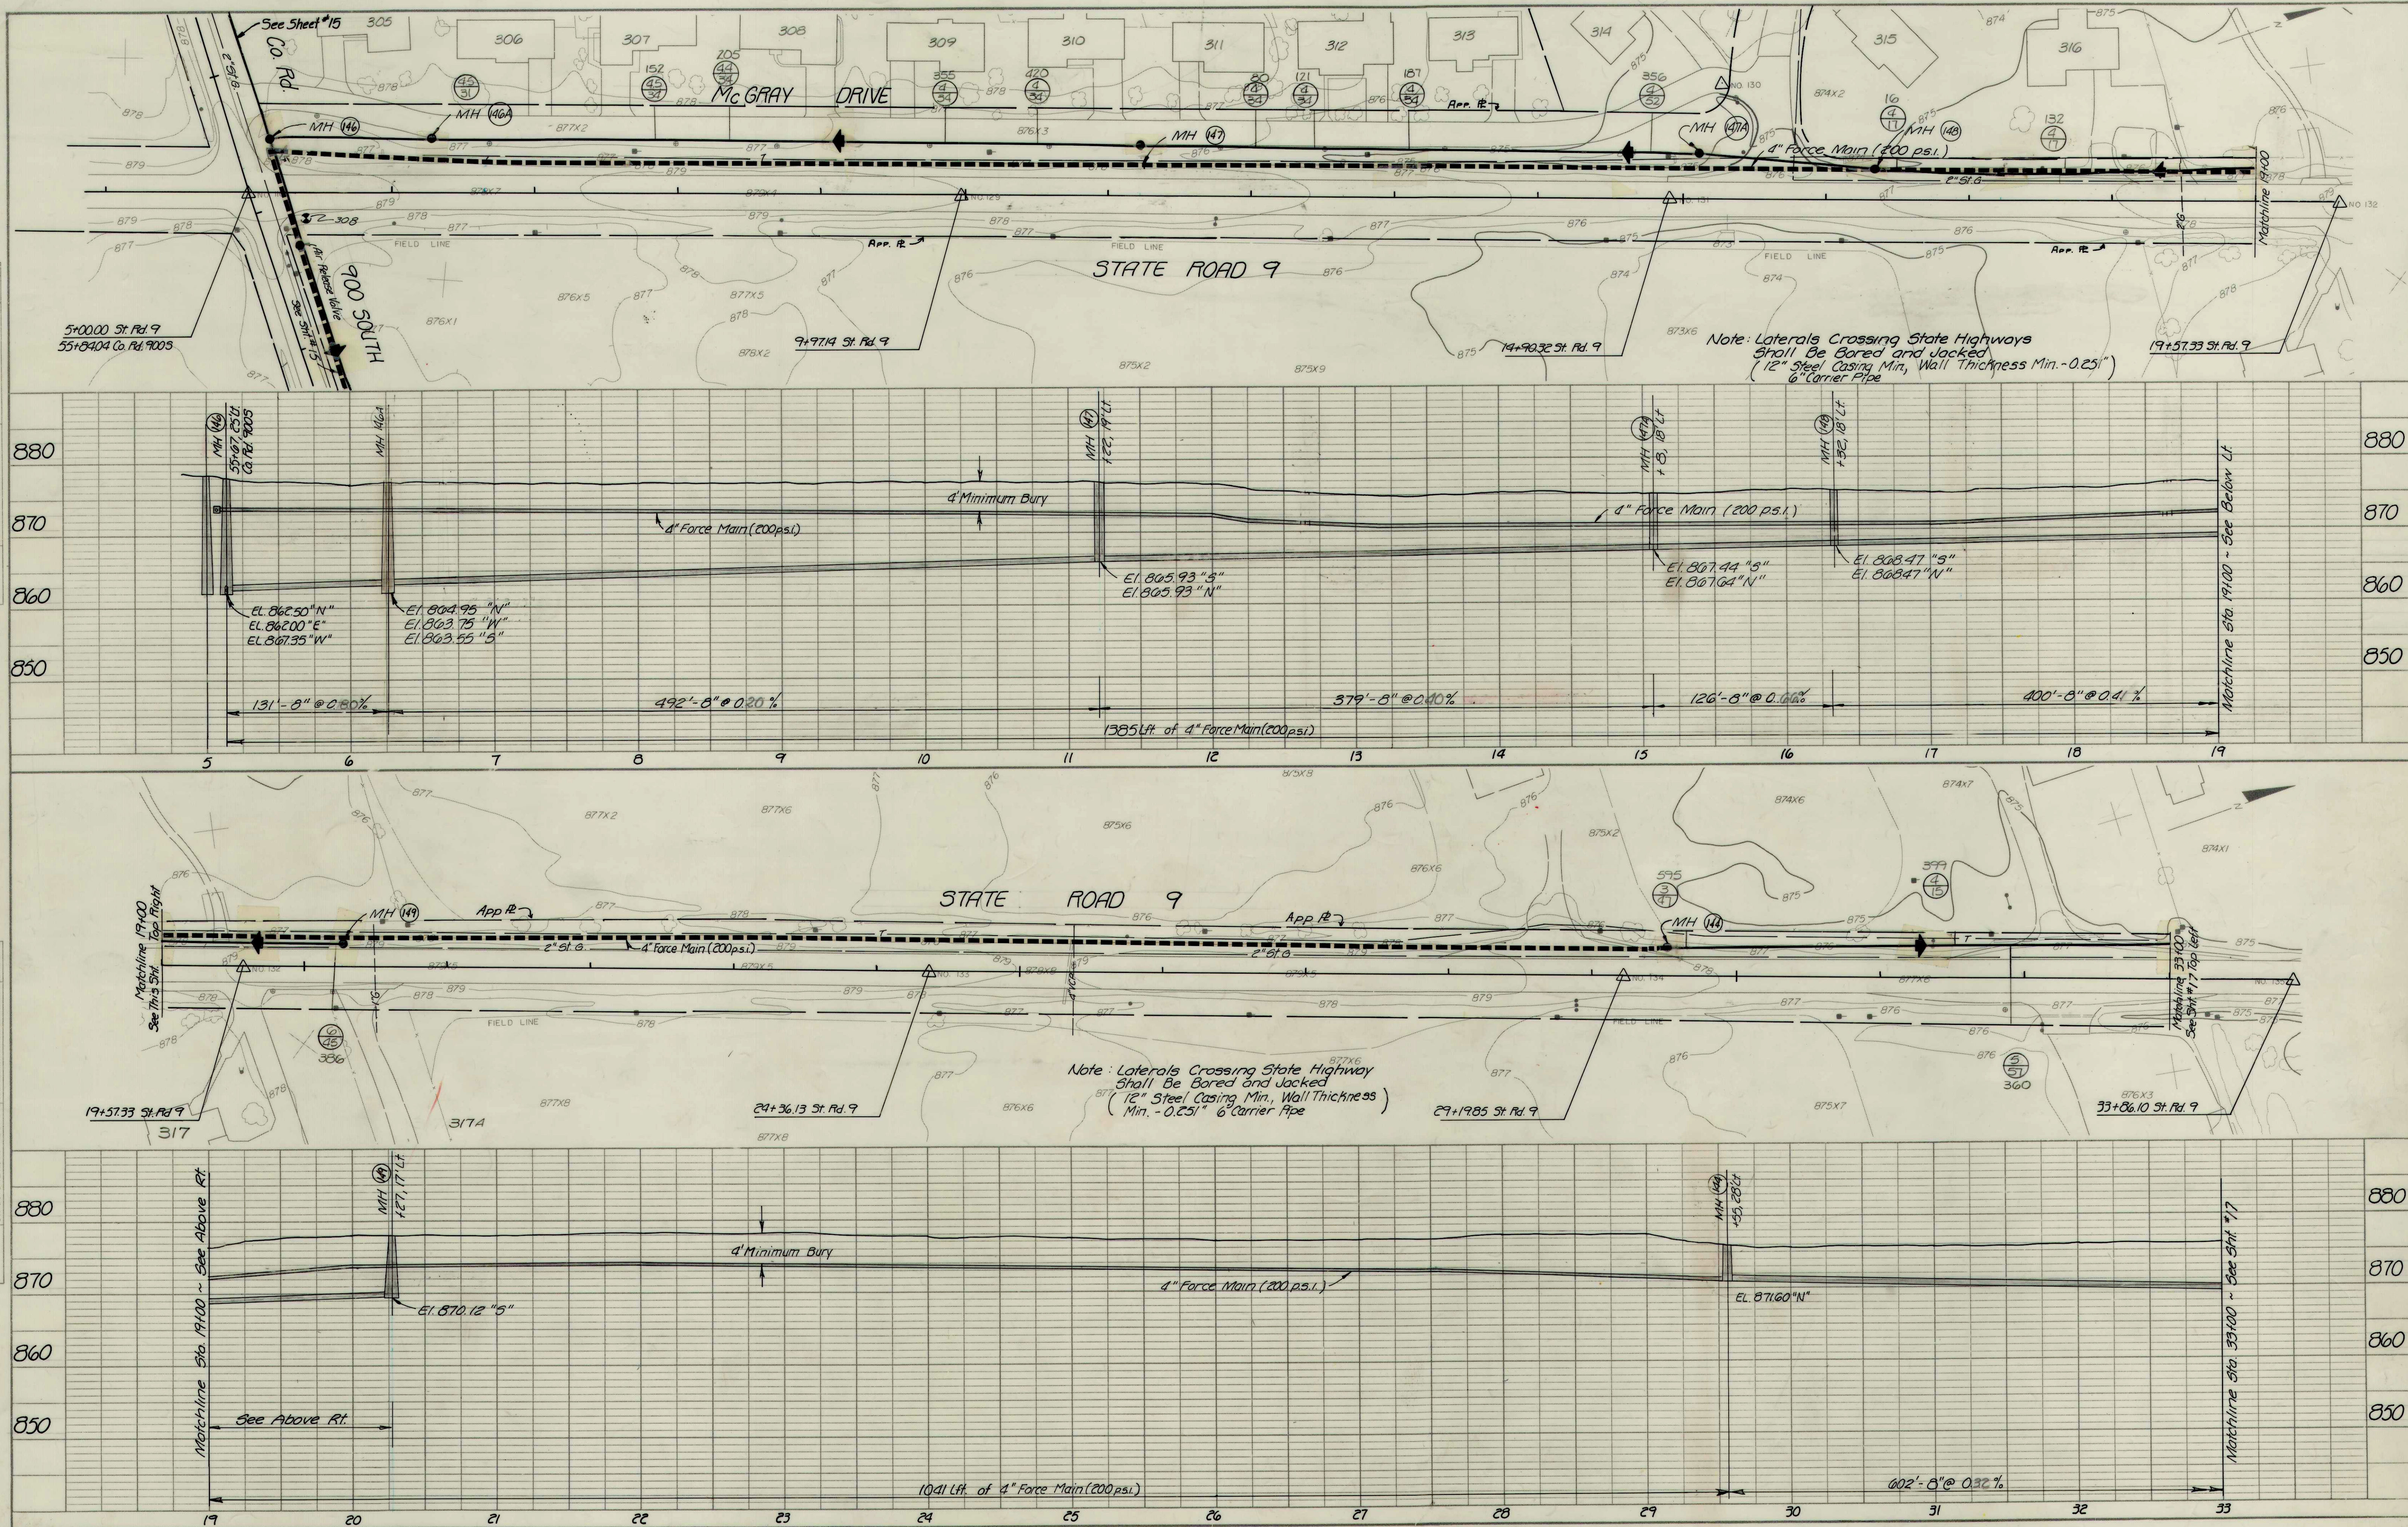

STATE ROAD 9	
FALL CREEK R.W.D. PLAN & PROFILE	SHEET
HORIZ. 1"=50'	BEAM, LONGEST & NEFF, INC.
VERT. 1"=10'	CONSULTING ENGINEERS
	INDIANAPOLIS, INDIANA
	16