


PLAN	SURVEYED	DATE
	PLOTTED	BY
	NOTE BOOK	ALIGNMENT CHECKED
	NO.	NO. OF WAY CHECKED

PROFILE	SURVEYED	DATE
	PLOTTED	BY
	NOTE BOOK	VERTICAL CHECKED
	NO.	STRUCTURE NOTATIONS



RECORD DRAWING

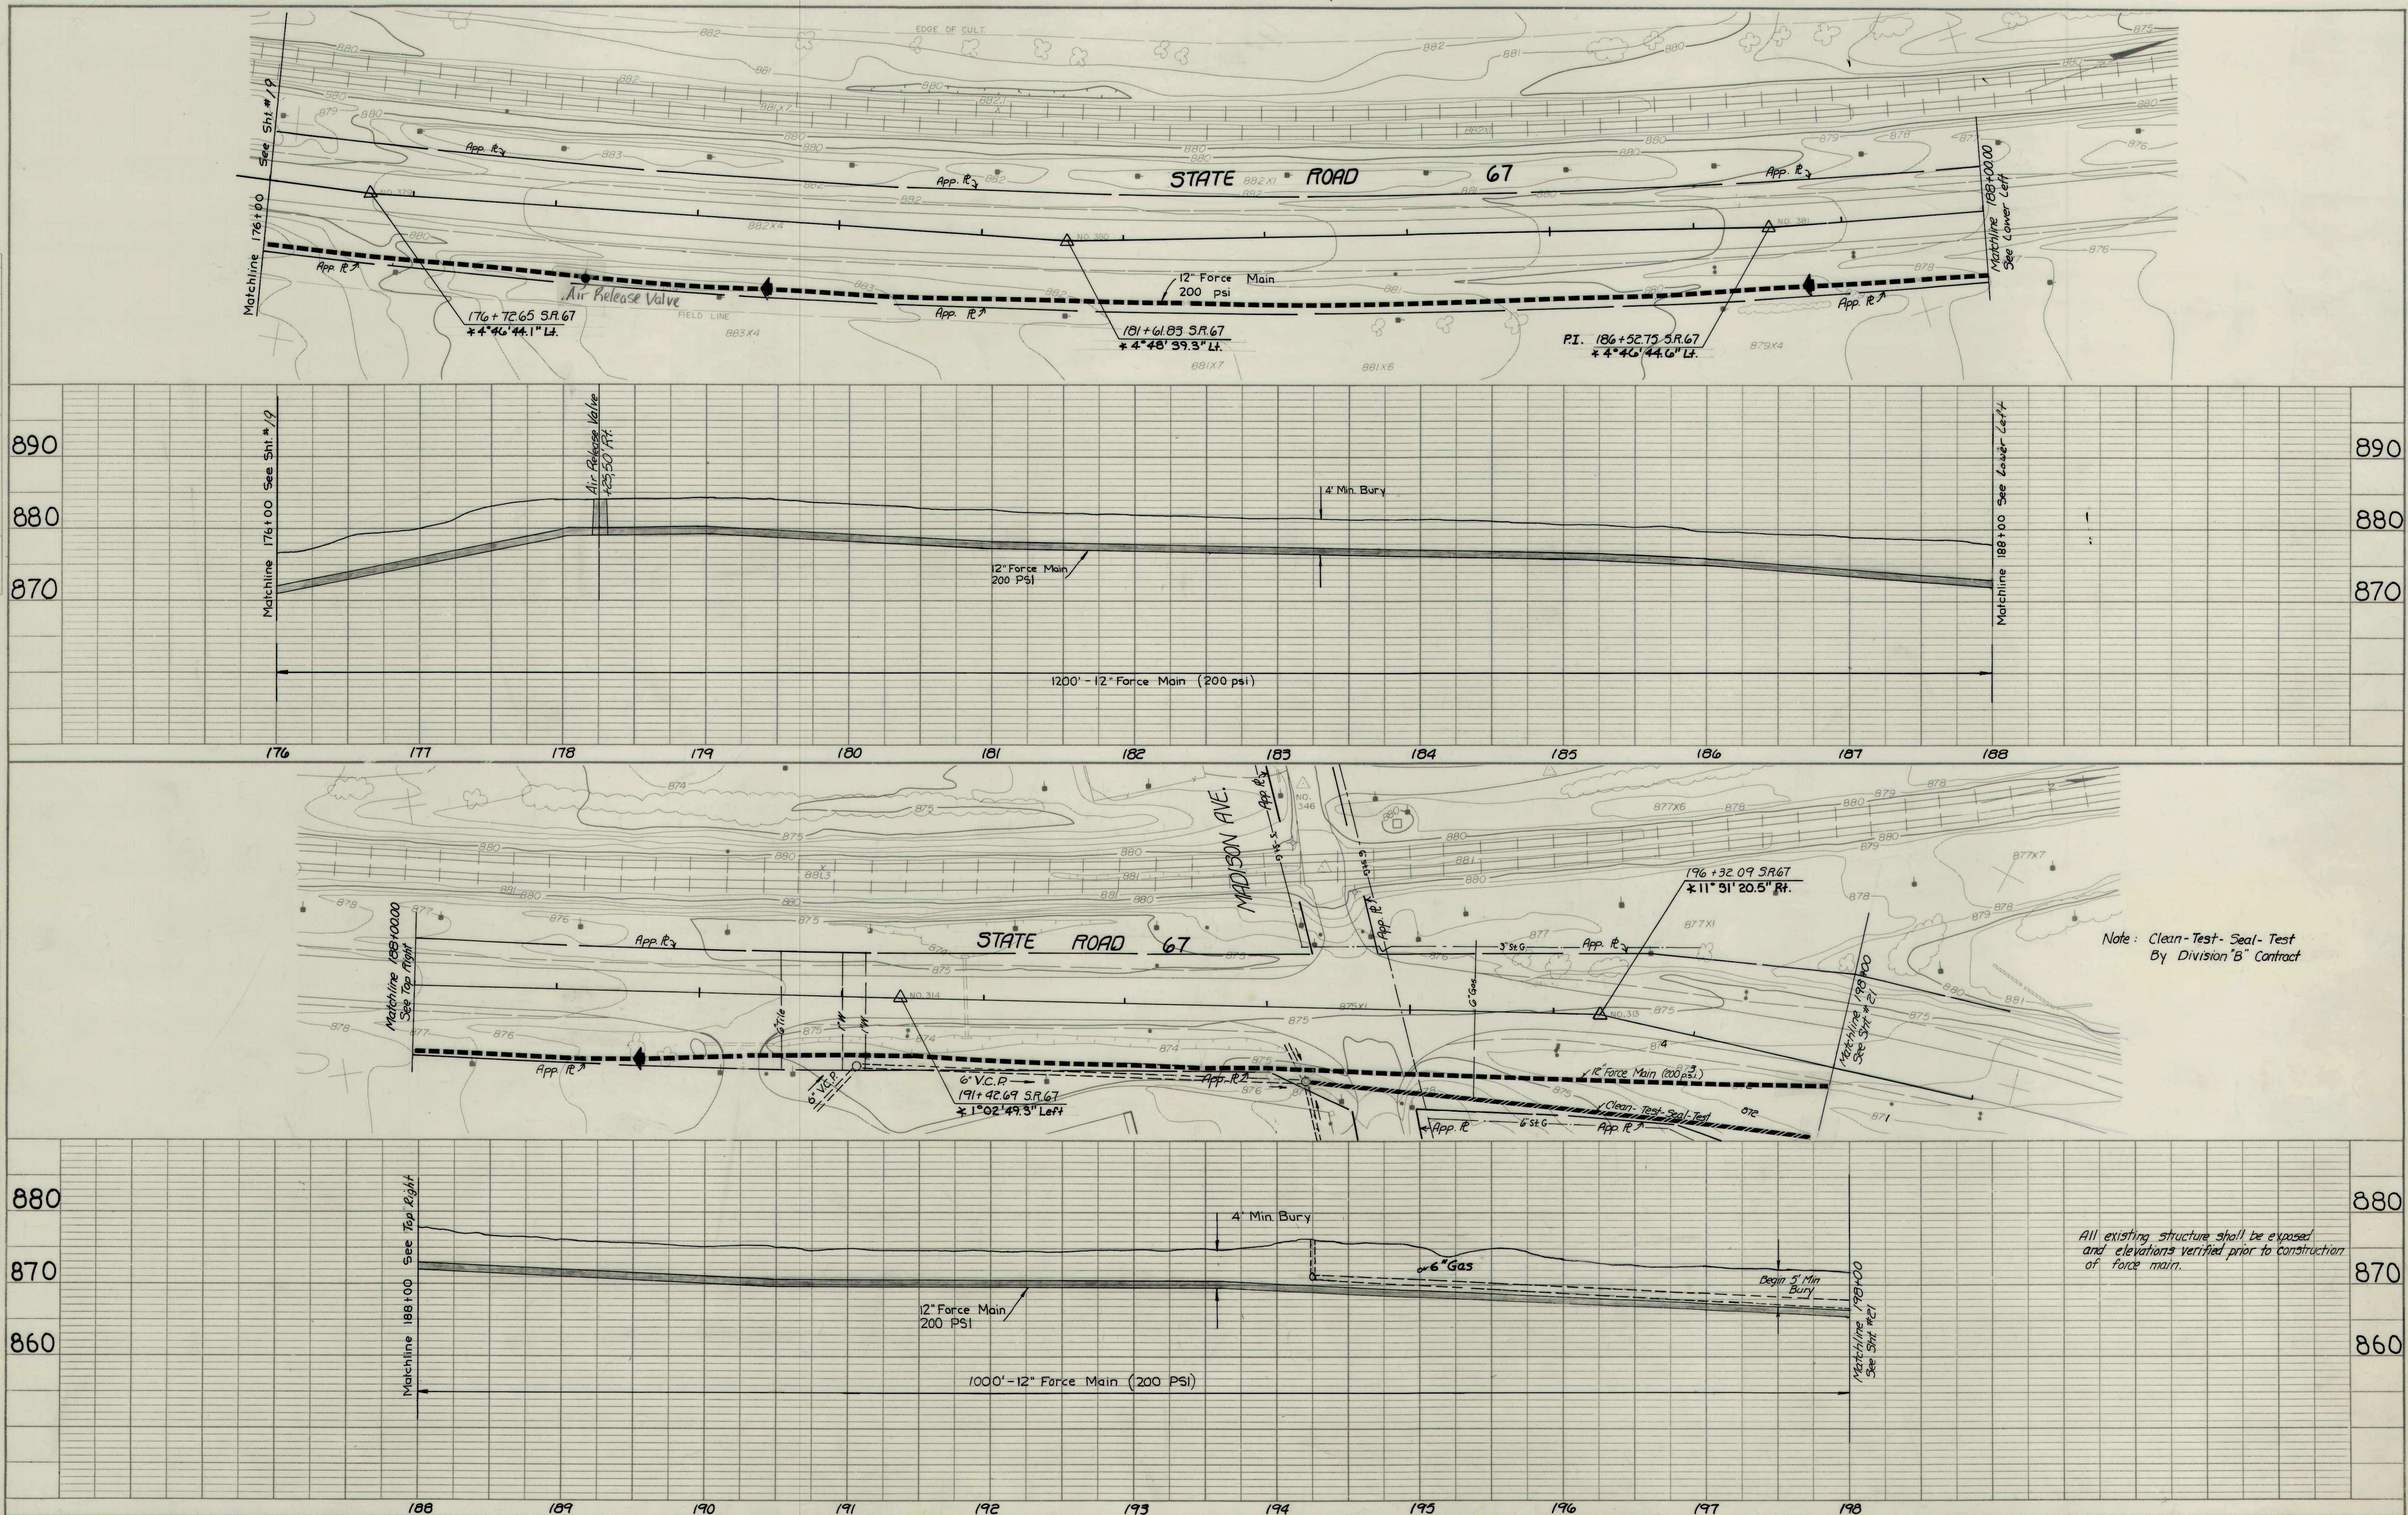

STATE ROAD 67	
FALL CREEK R.W.D. PLAN & PROFILE SHEET	
HORIZ. 1"=50'	BEAM, LONGEST & NEFF, INC.
VERT. 1"=10'	CONSULTING ENGINEERS
	INDIANAPOLIS, INDIANA
	20