


PLAN	SURVEYED	DATE
NO. 1	BY	
NOTE BOOK	ALIGNED CHECKED	
NO. 1	BY	

PROFILE	SURVEYED	DATE
NO. 1	BY	
NOTE BOOK	ALIGNED CHECKED	
NO. 1	BY	



RECORD DRAWING

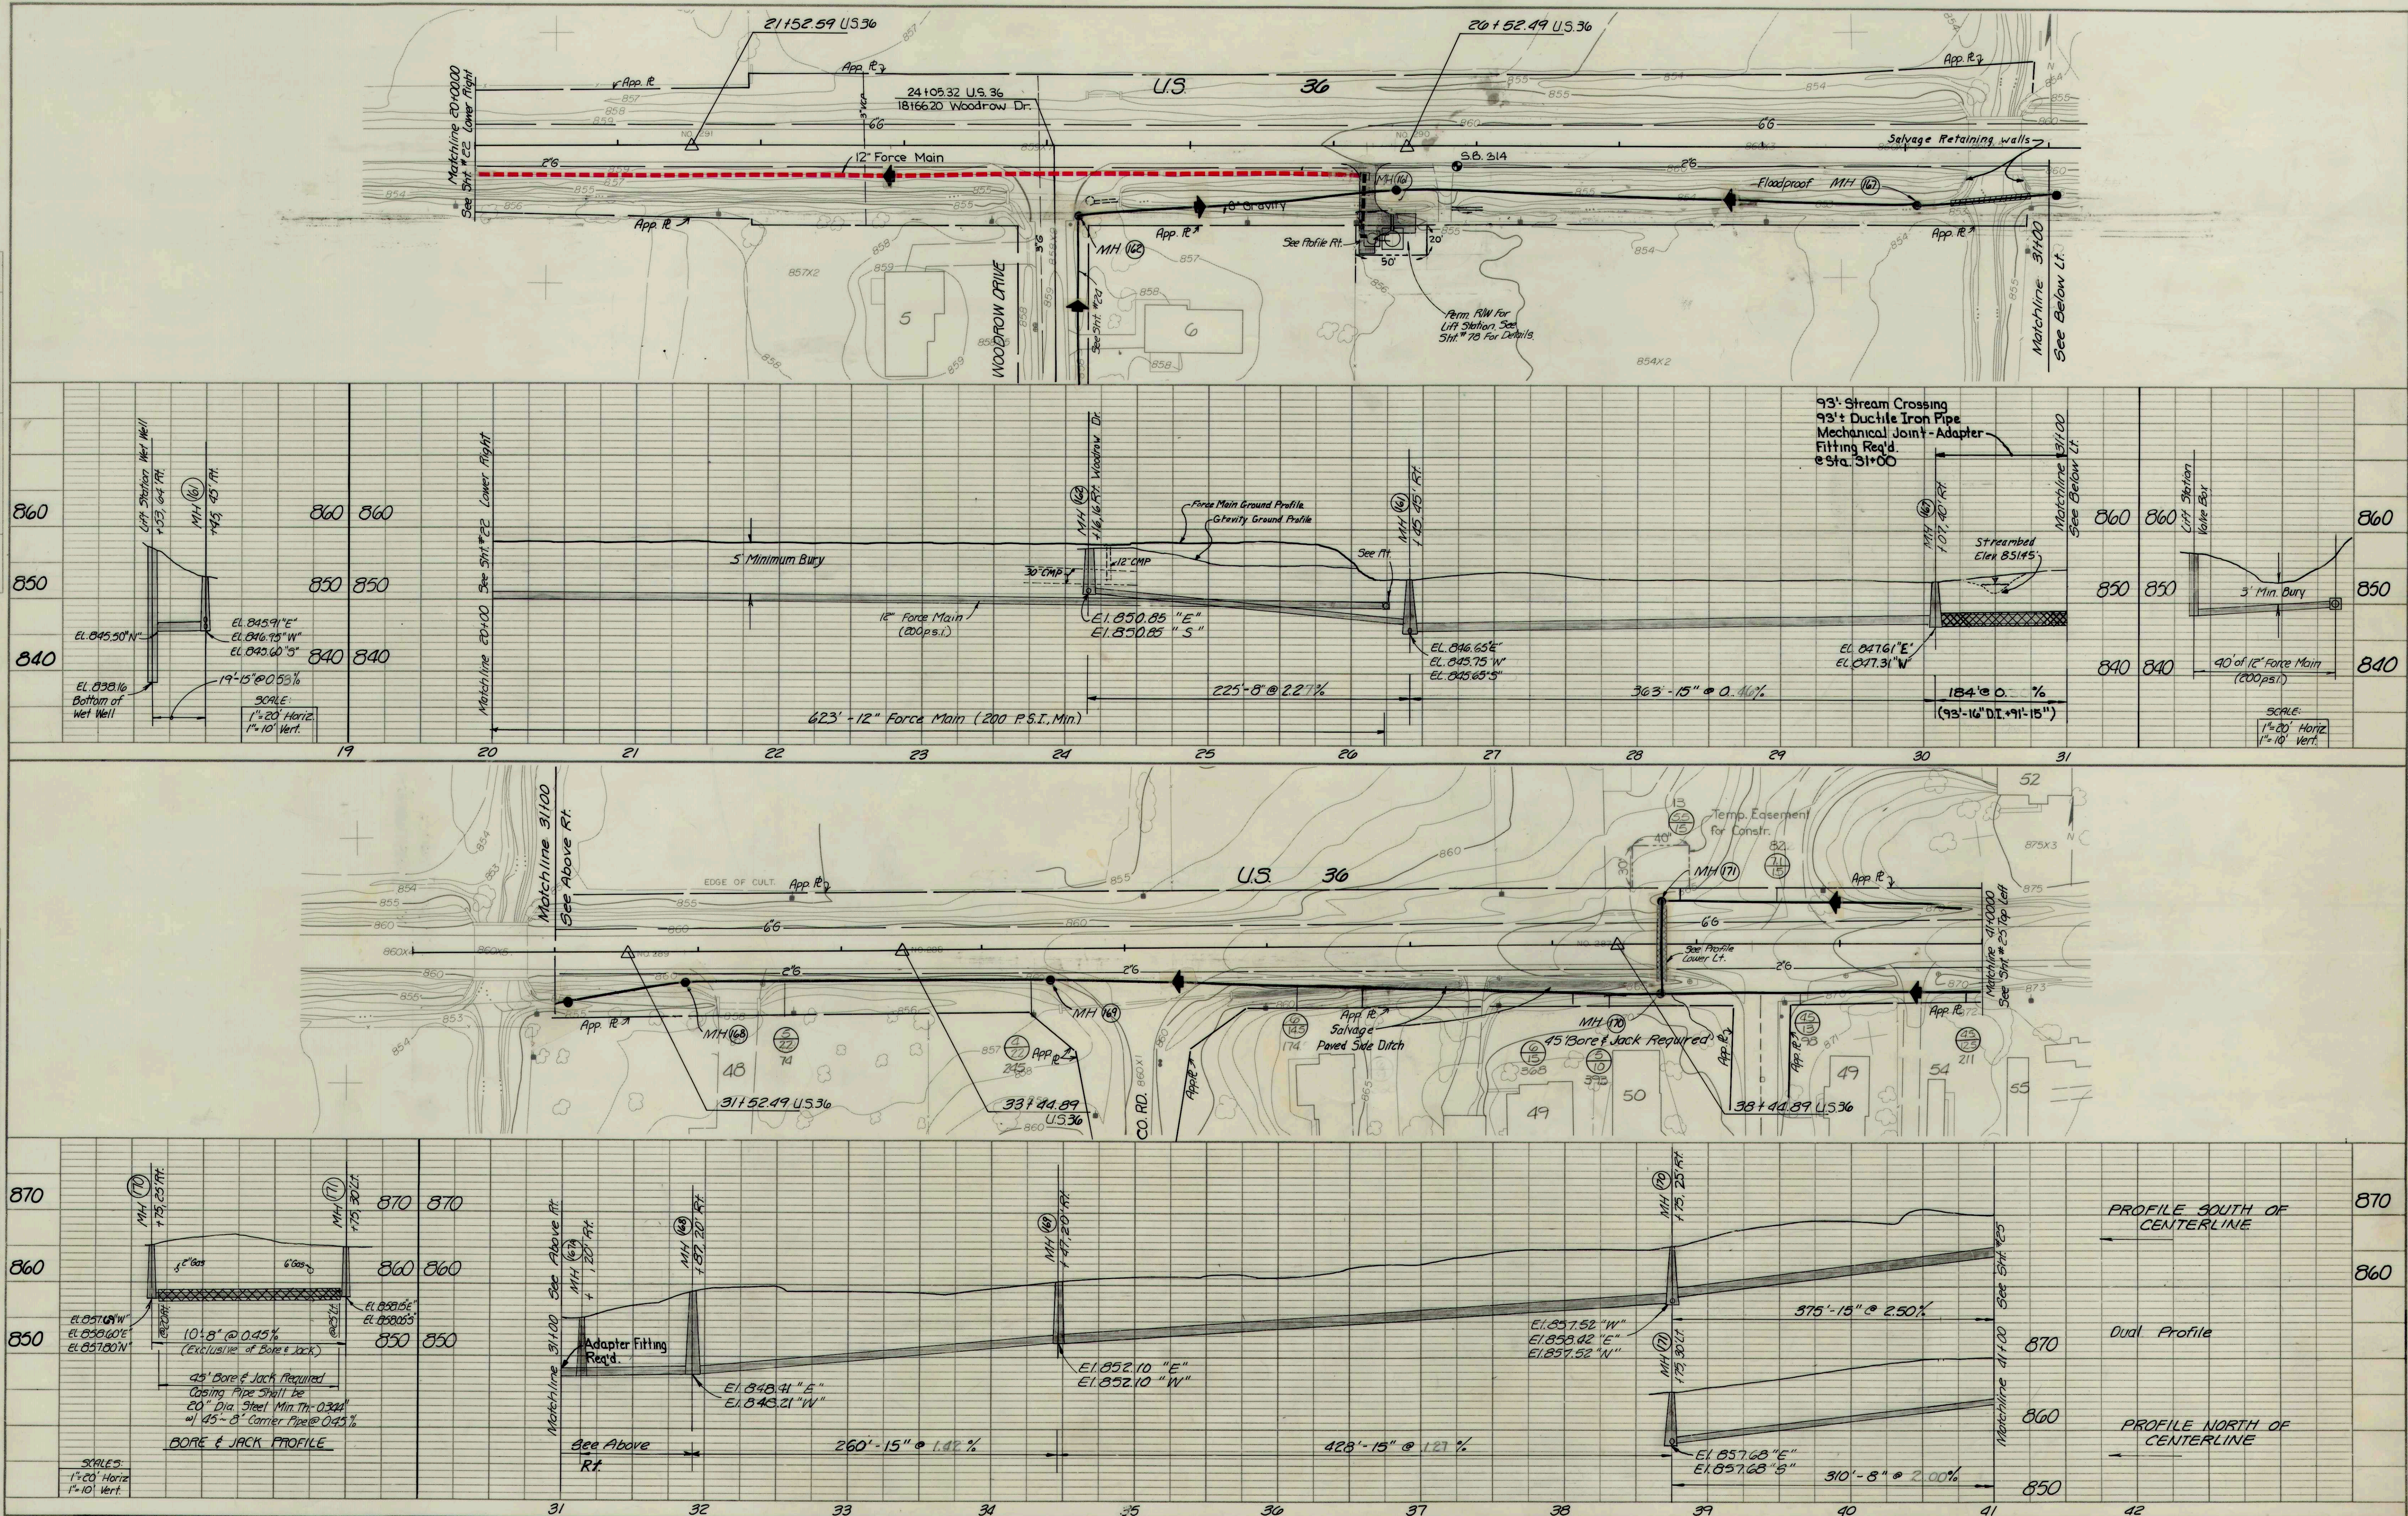

U.S. 36	
FALL CREEK R.W.D. PLAN & PROFILE	SHEET
HORIZ. 1"=50'	BEAM, LONGEST & NEFF, INC.
VERT. 1"=10'	CONSULTING ENGINEERS
	INDIANAPOLIS, INDIANA
	23