

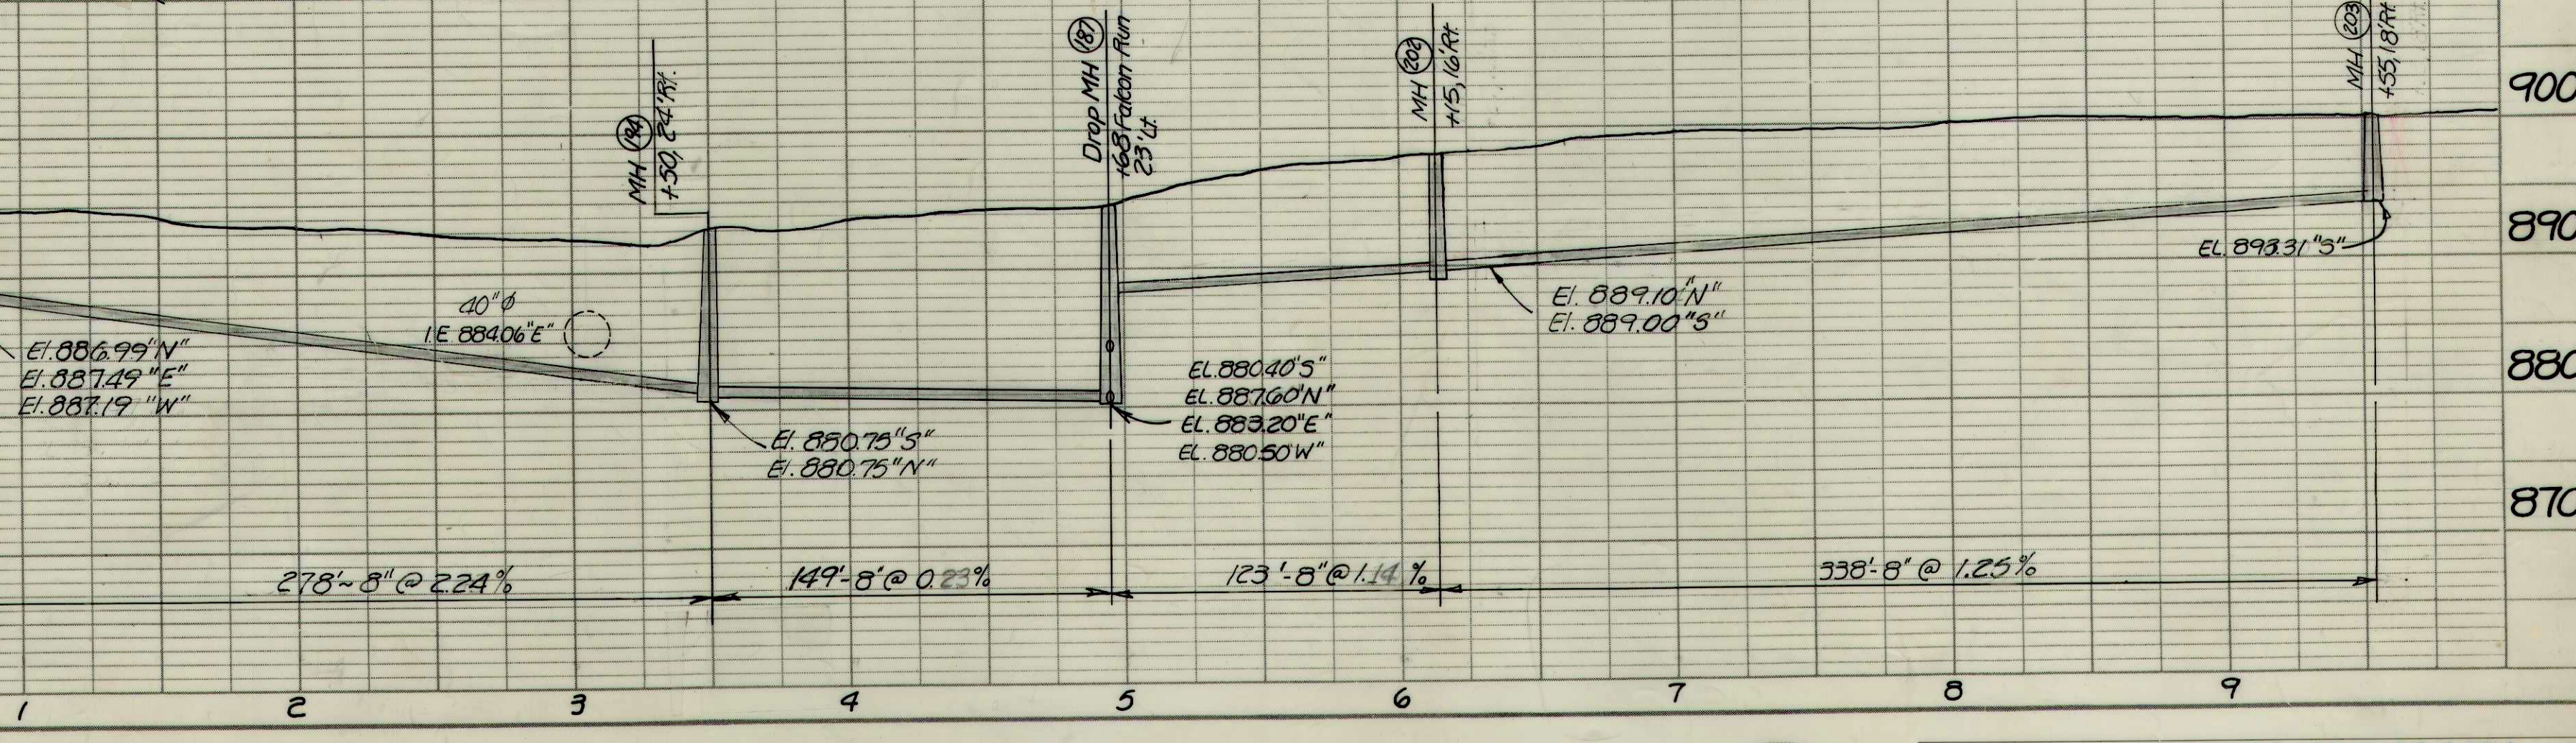
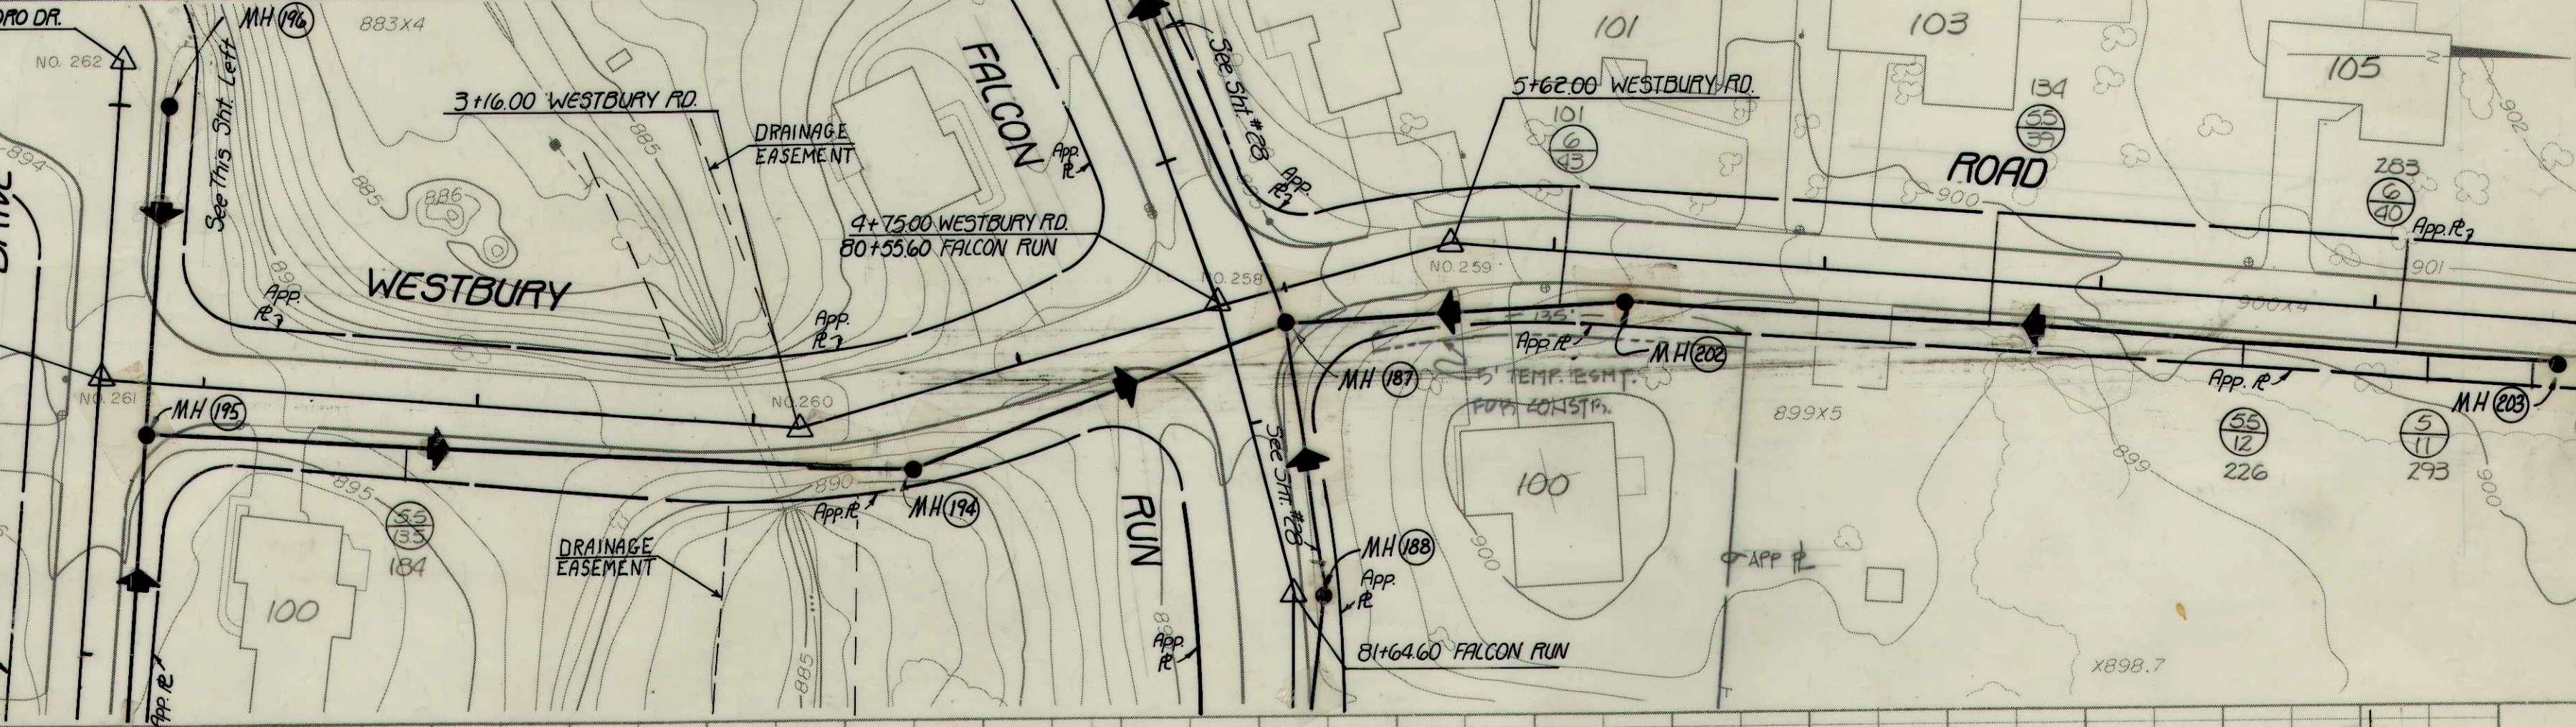
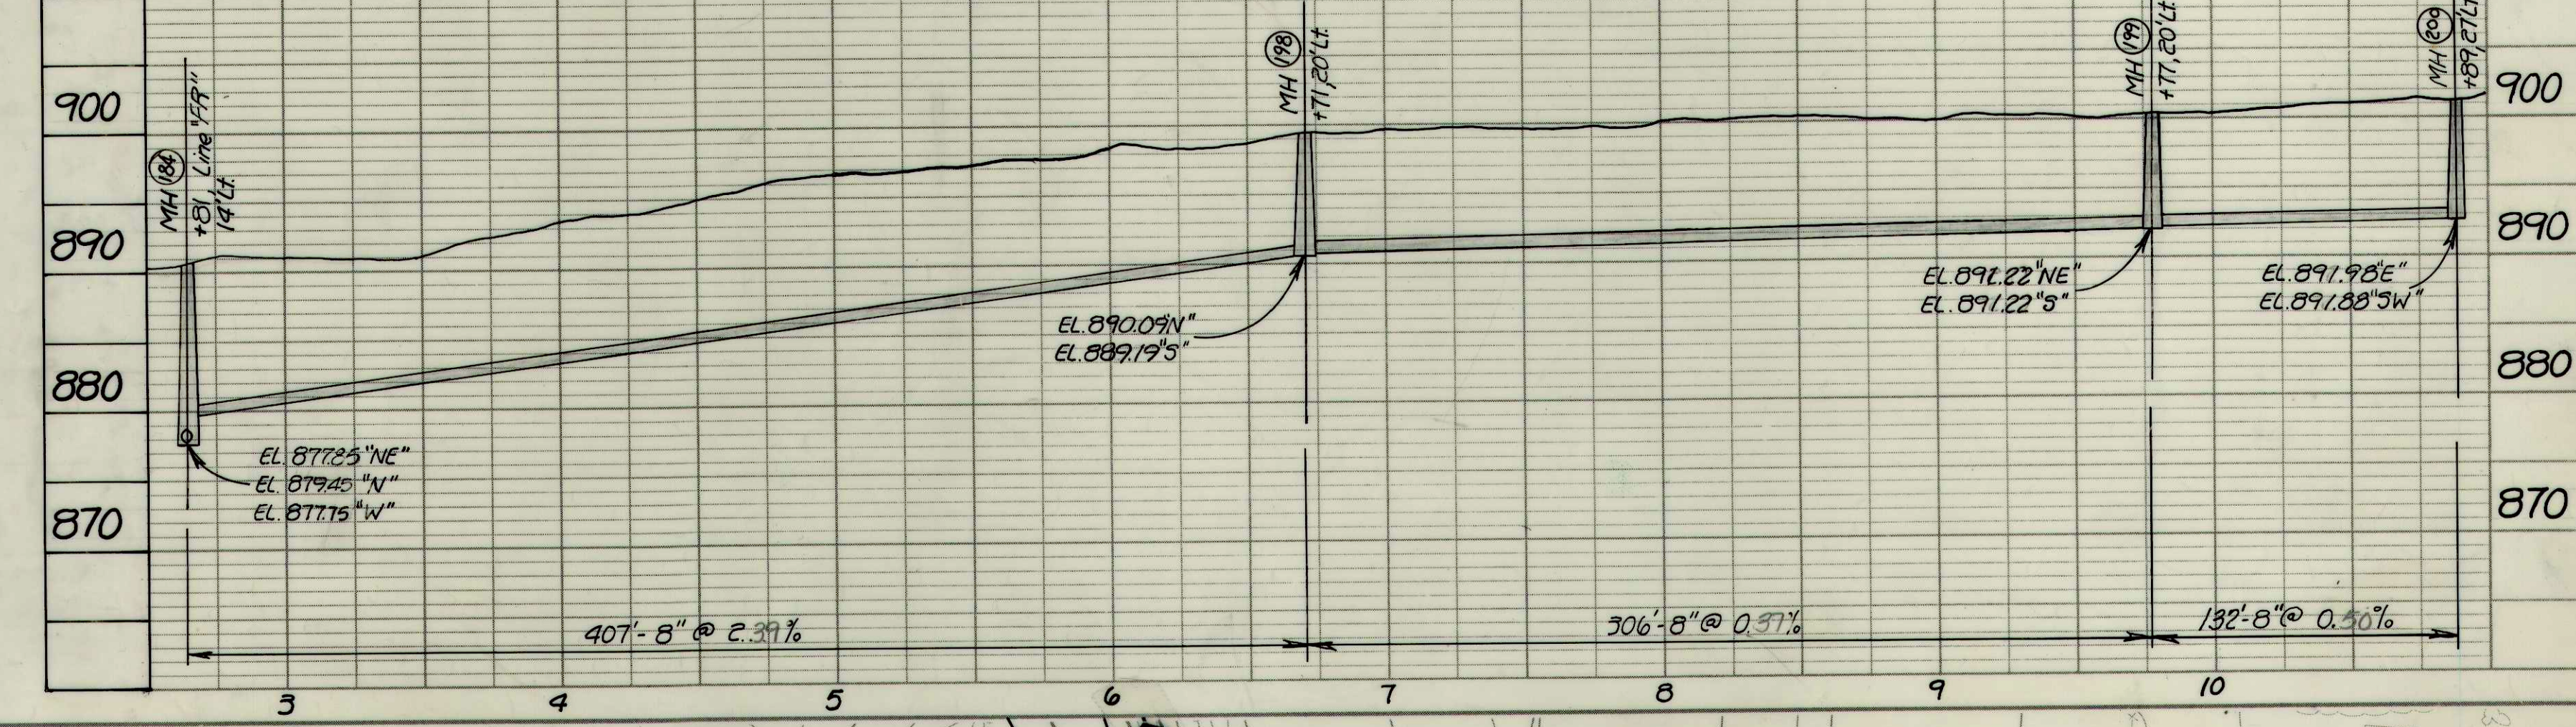
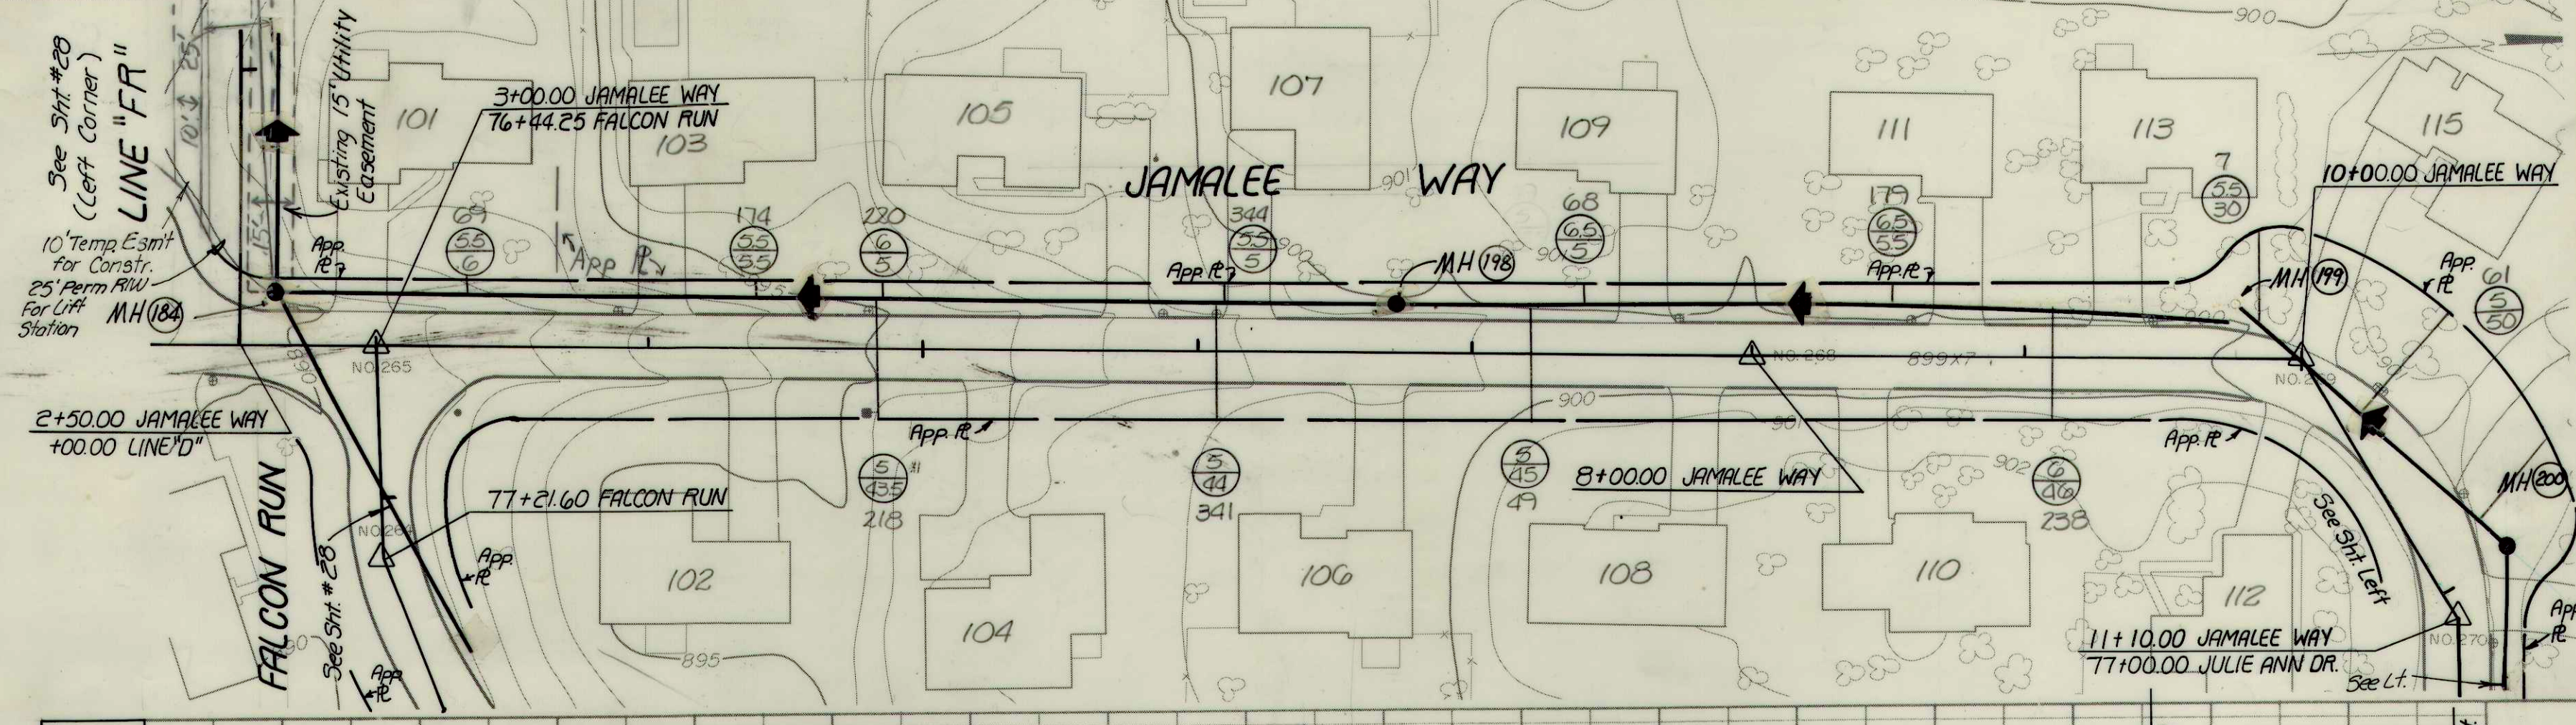
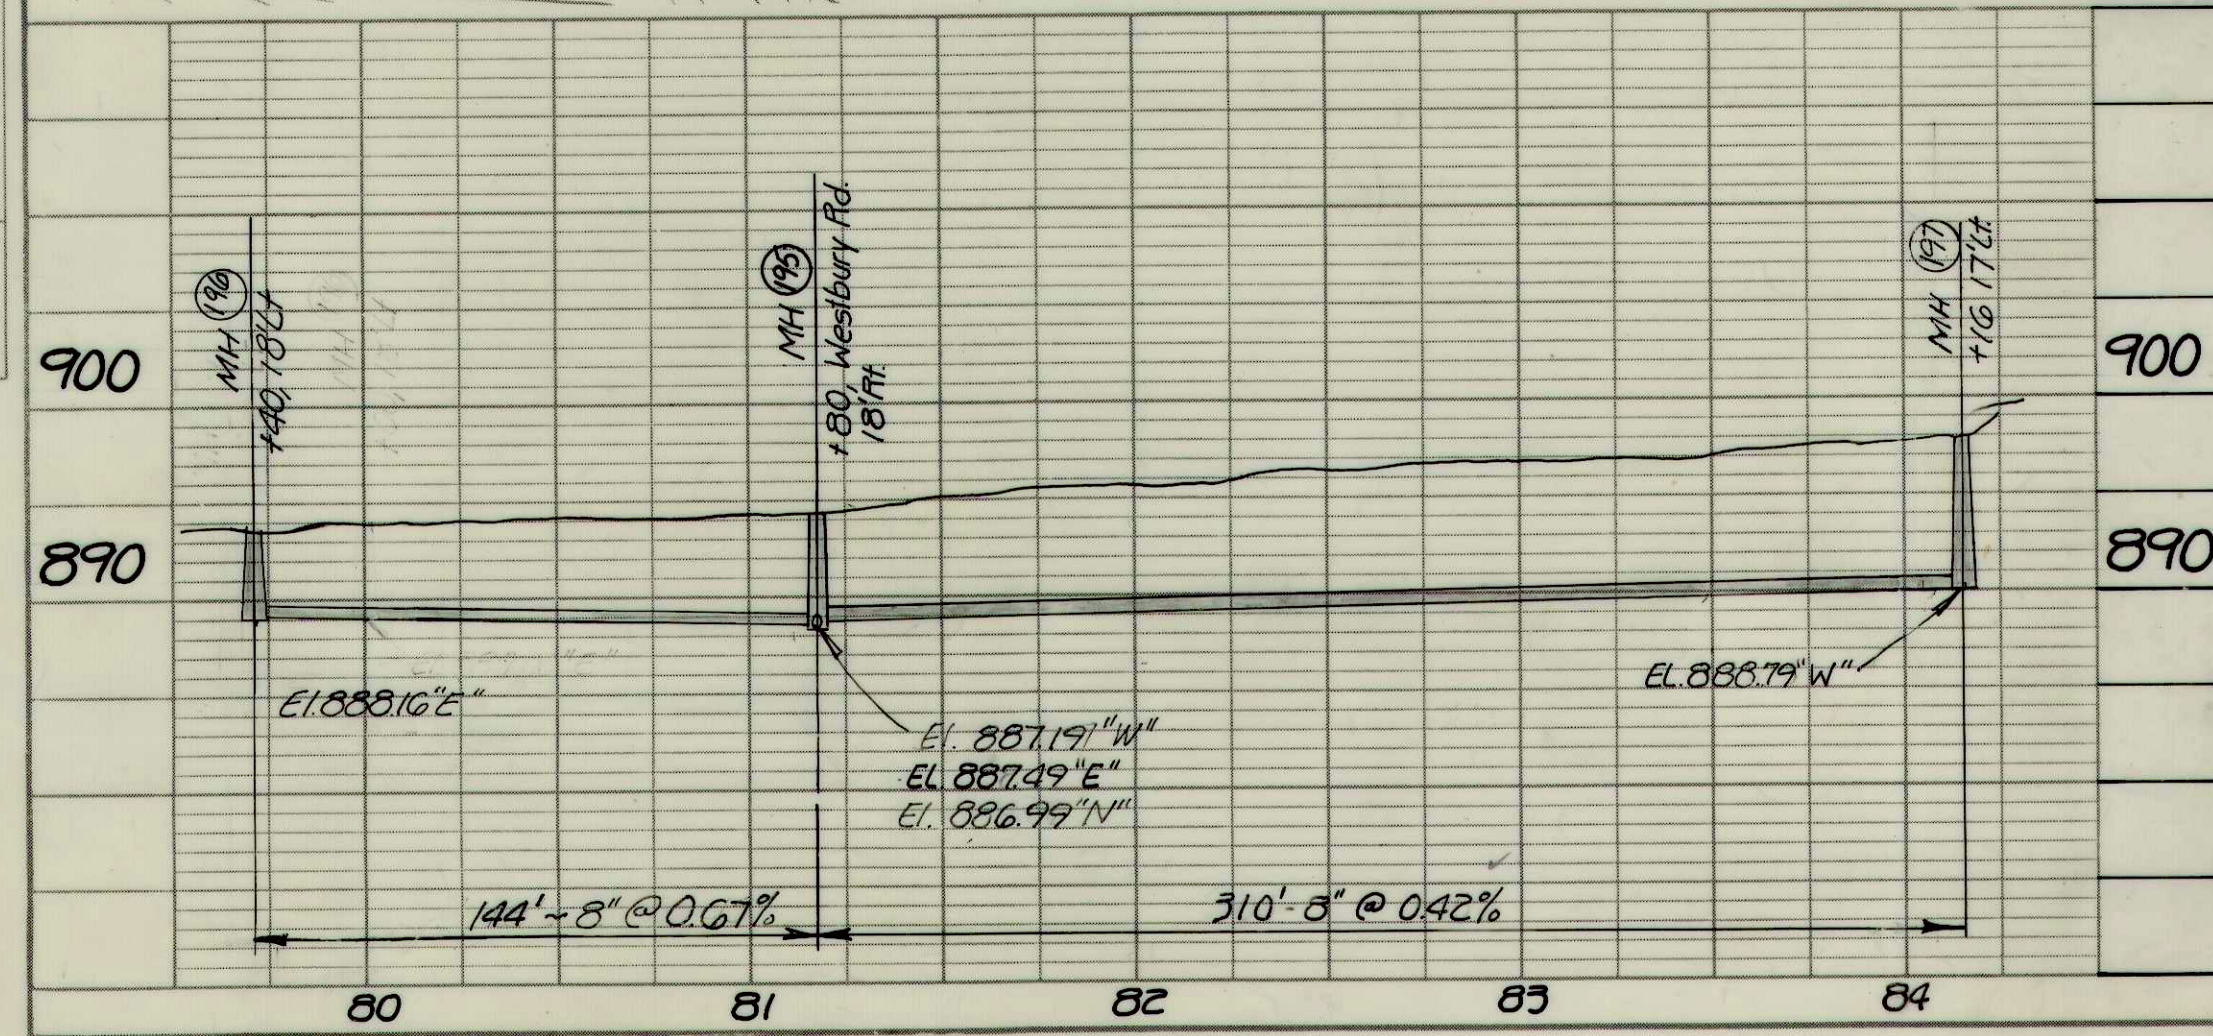
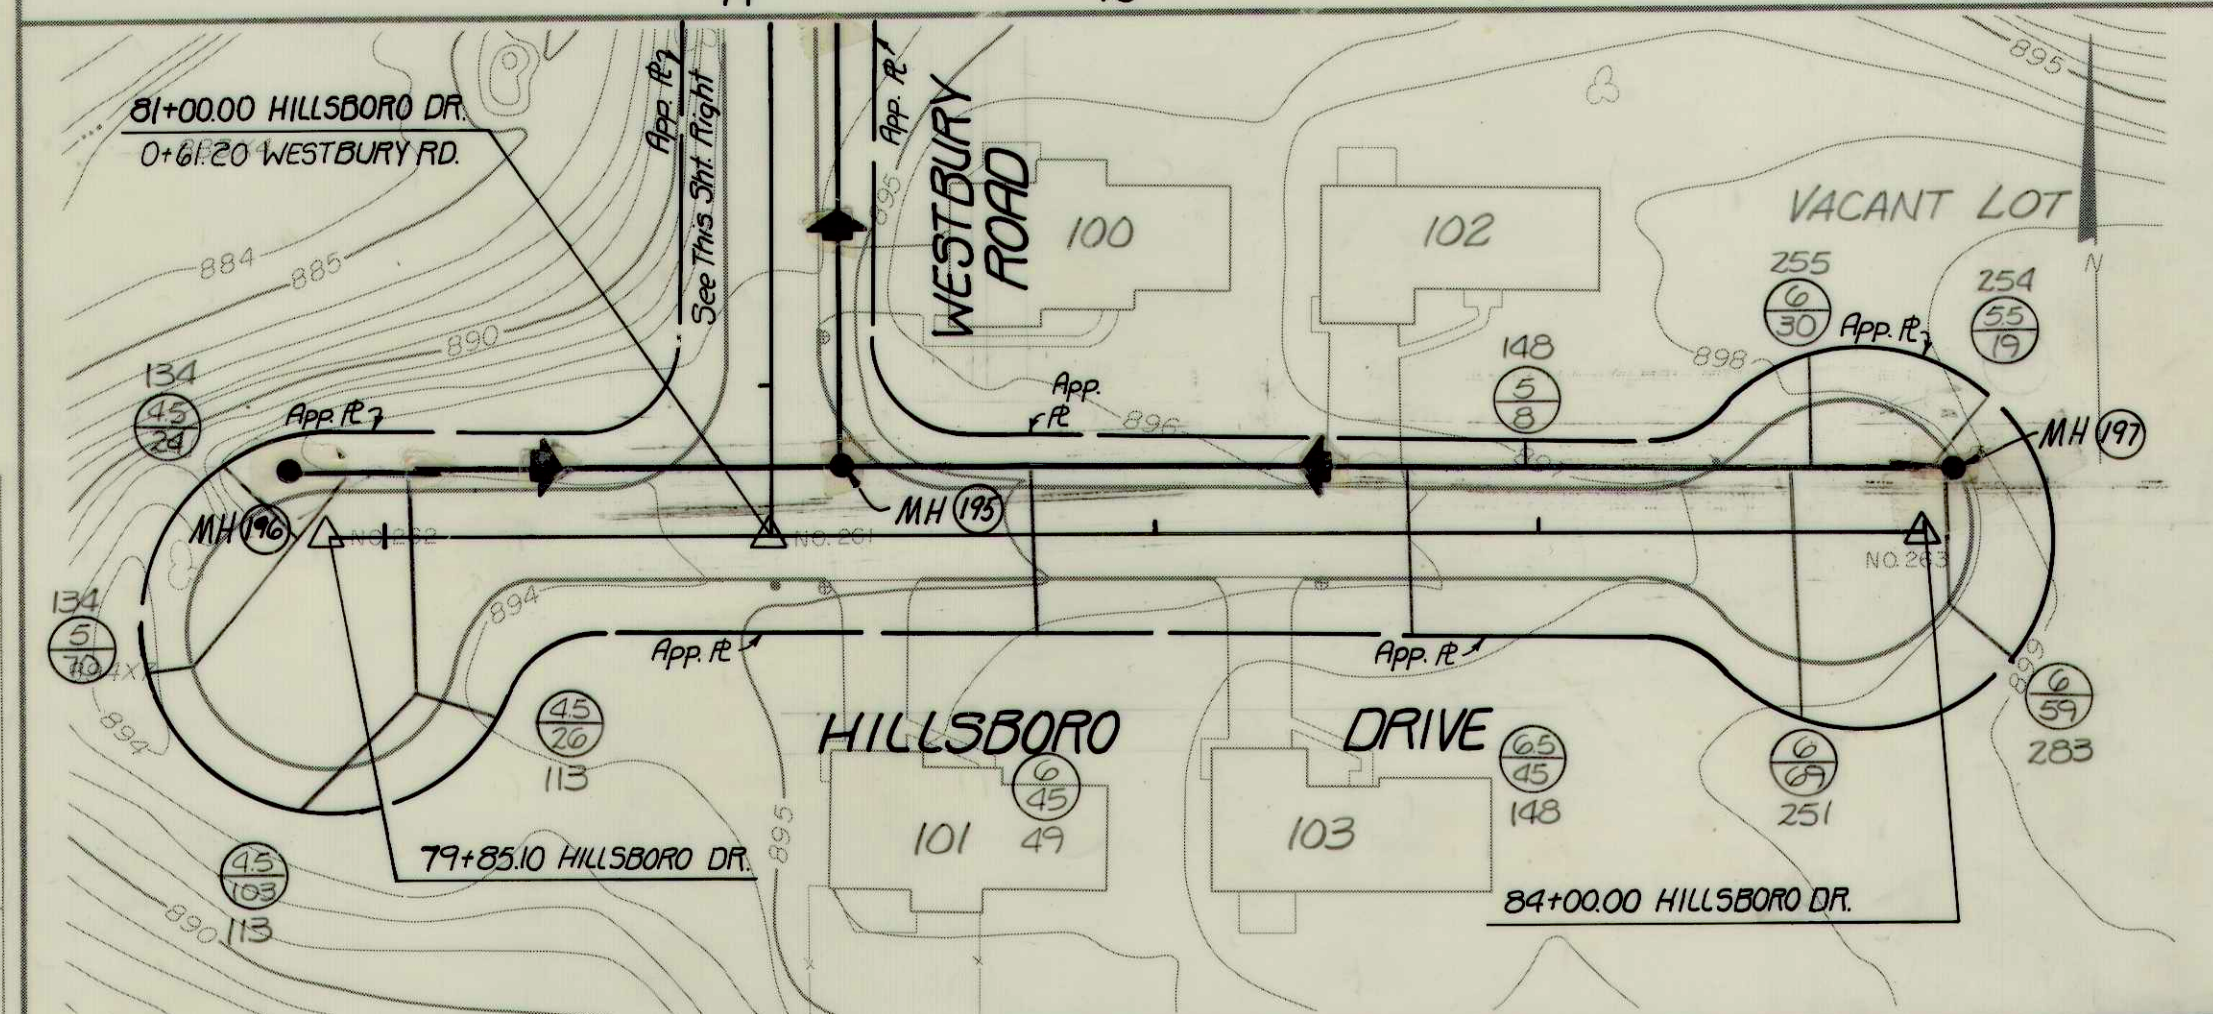


PLAN
 SURVEYED
 ALIGNED
 NOTE BOOK
 NO.

PROFILE
 SURVEYED
 GRADES CHECKED
 NOTE BOOK
 NO.

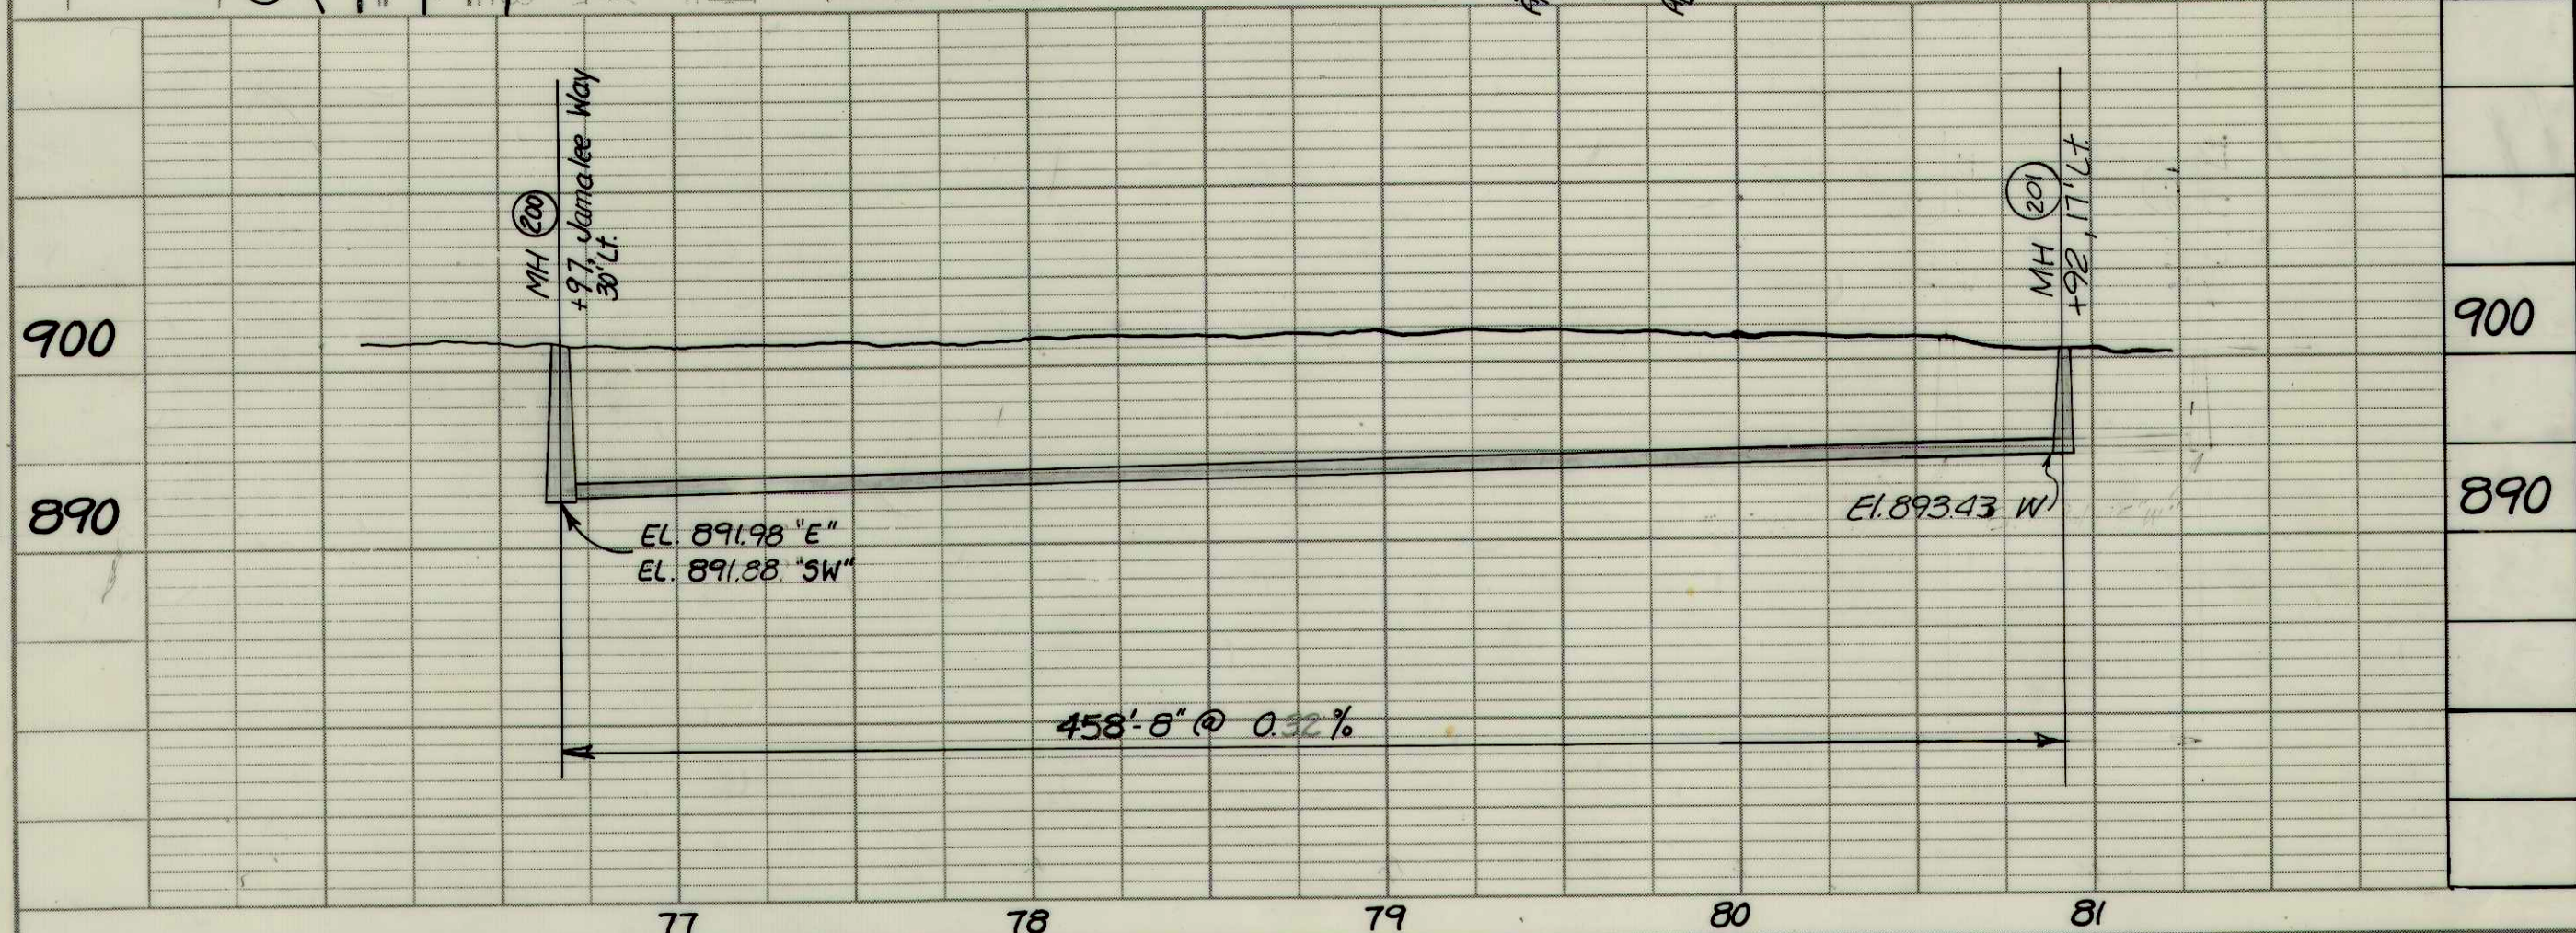

RECORD DRAWING

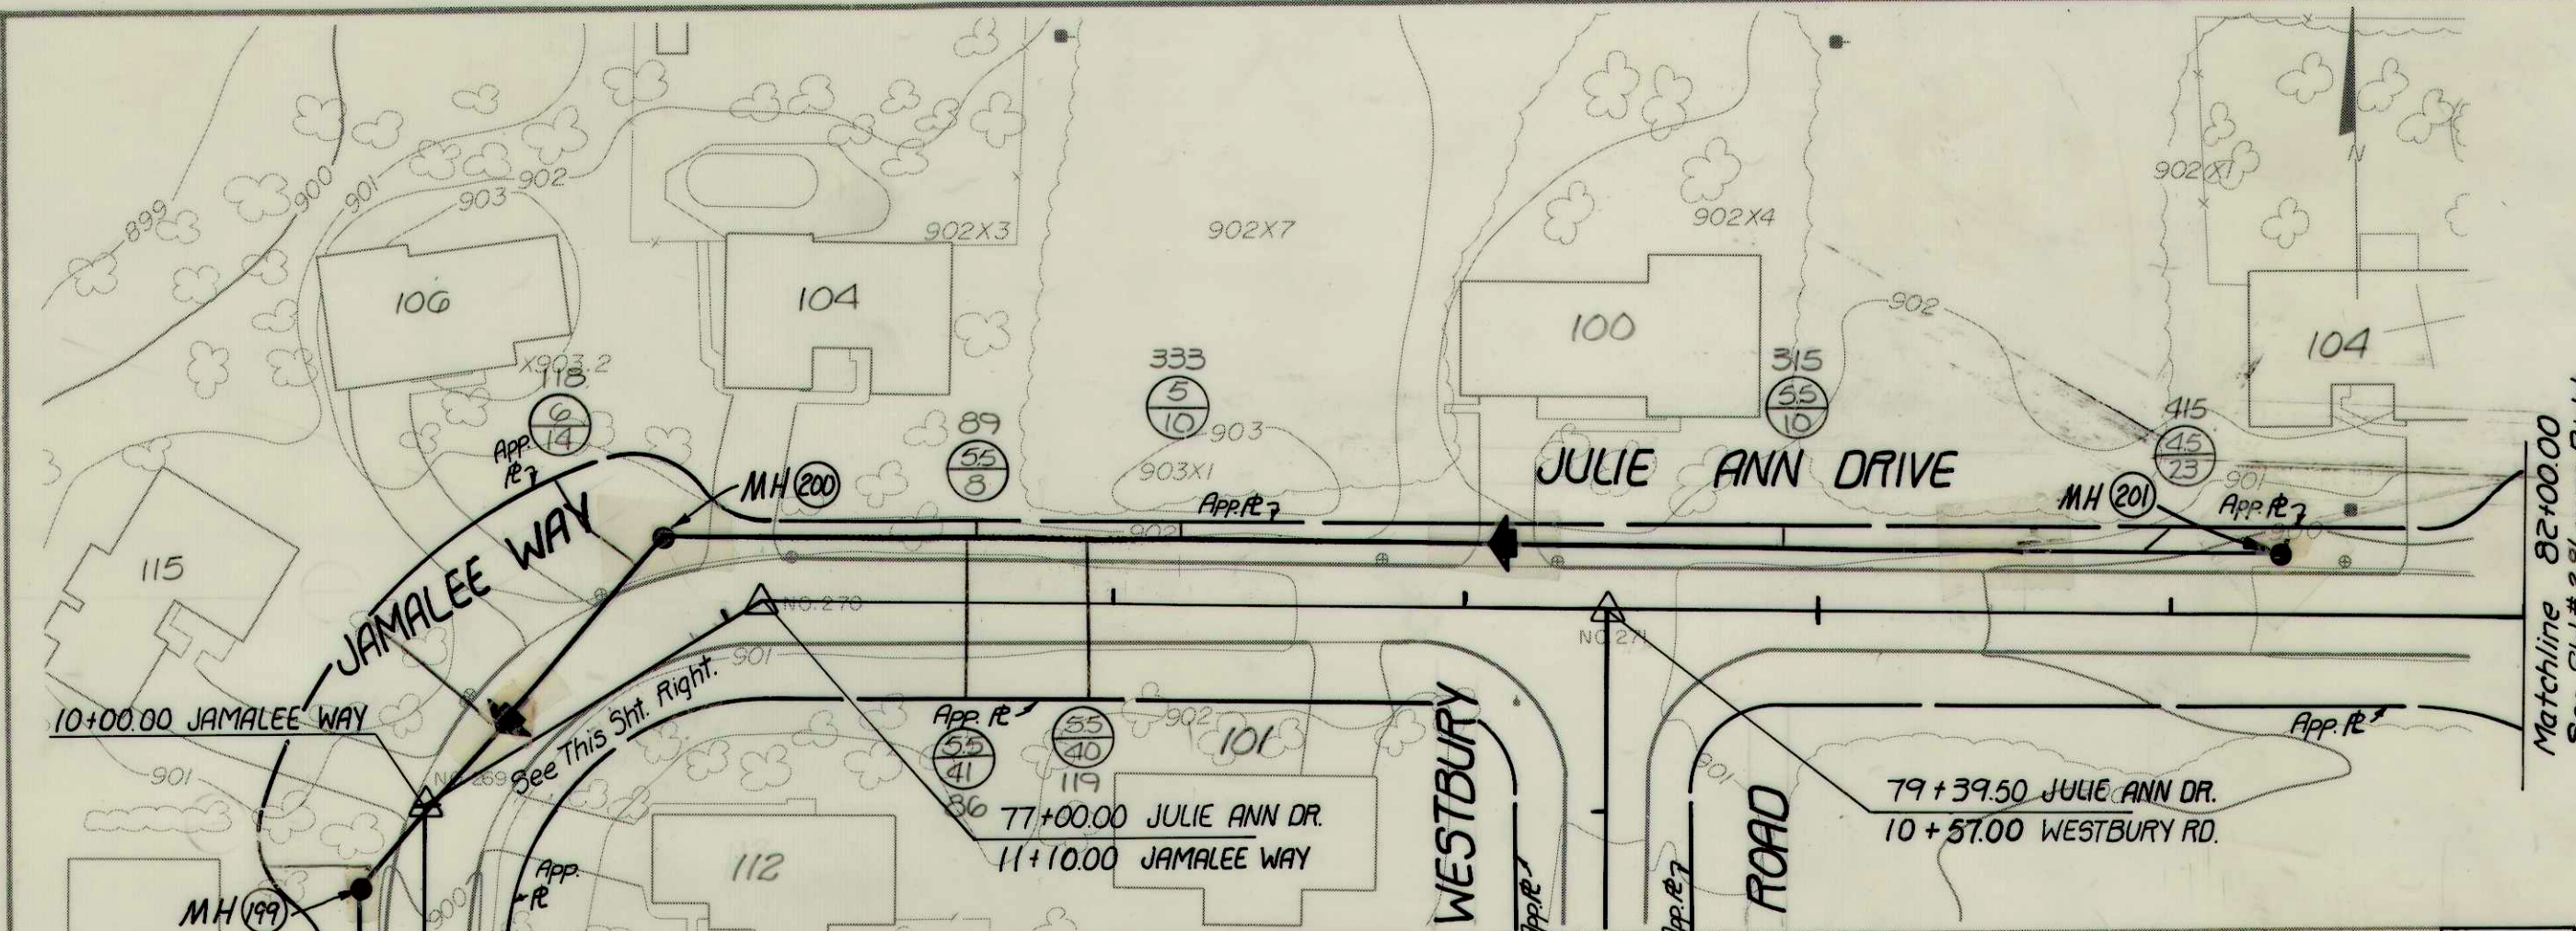

**JULIE ANN DRIVE / JAMALEE WAY
 HILLSBORO DRIVE / WESTBURY ROAD
 FALL CREEK R.W.D. PLAN & PROFILE**
 HORIZ. 1"=50'
 VERT. 1"=10'
 BEAM, LONGEST & NEFF, INC.
 CONSULTING ENGINEERS
 INDIANAPOLIS, INDIANA
 SHEET 27