

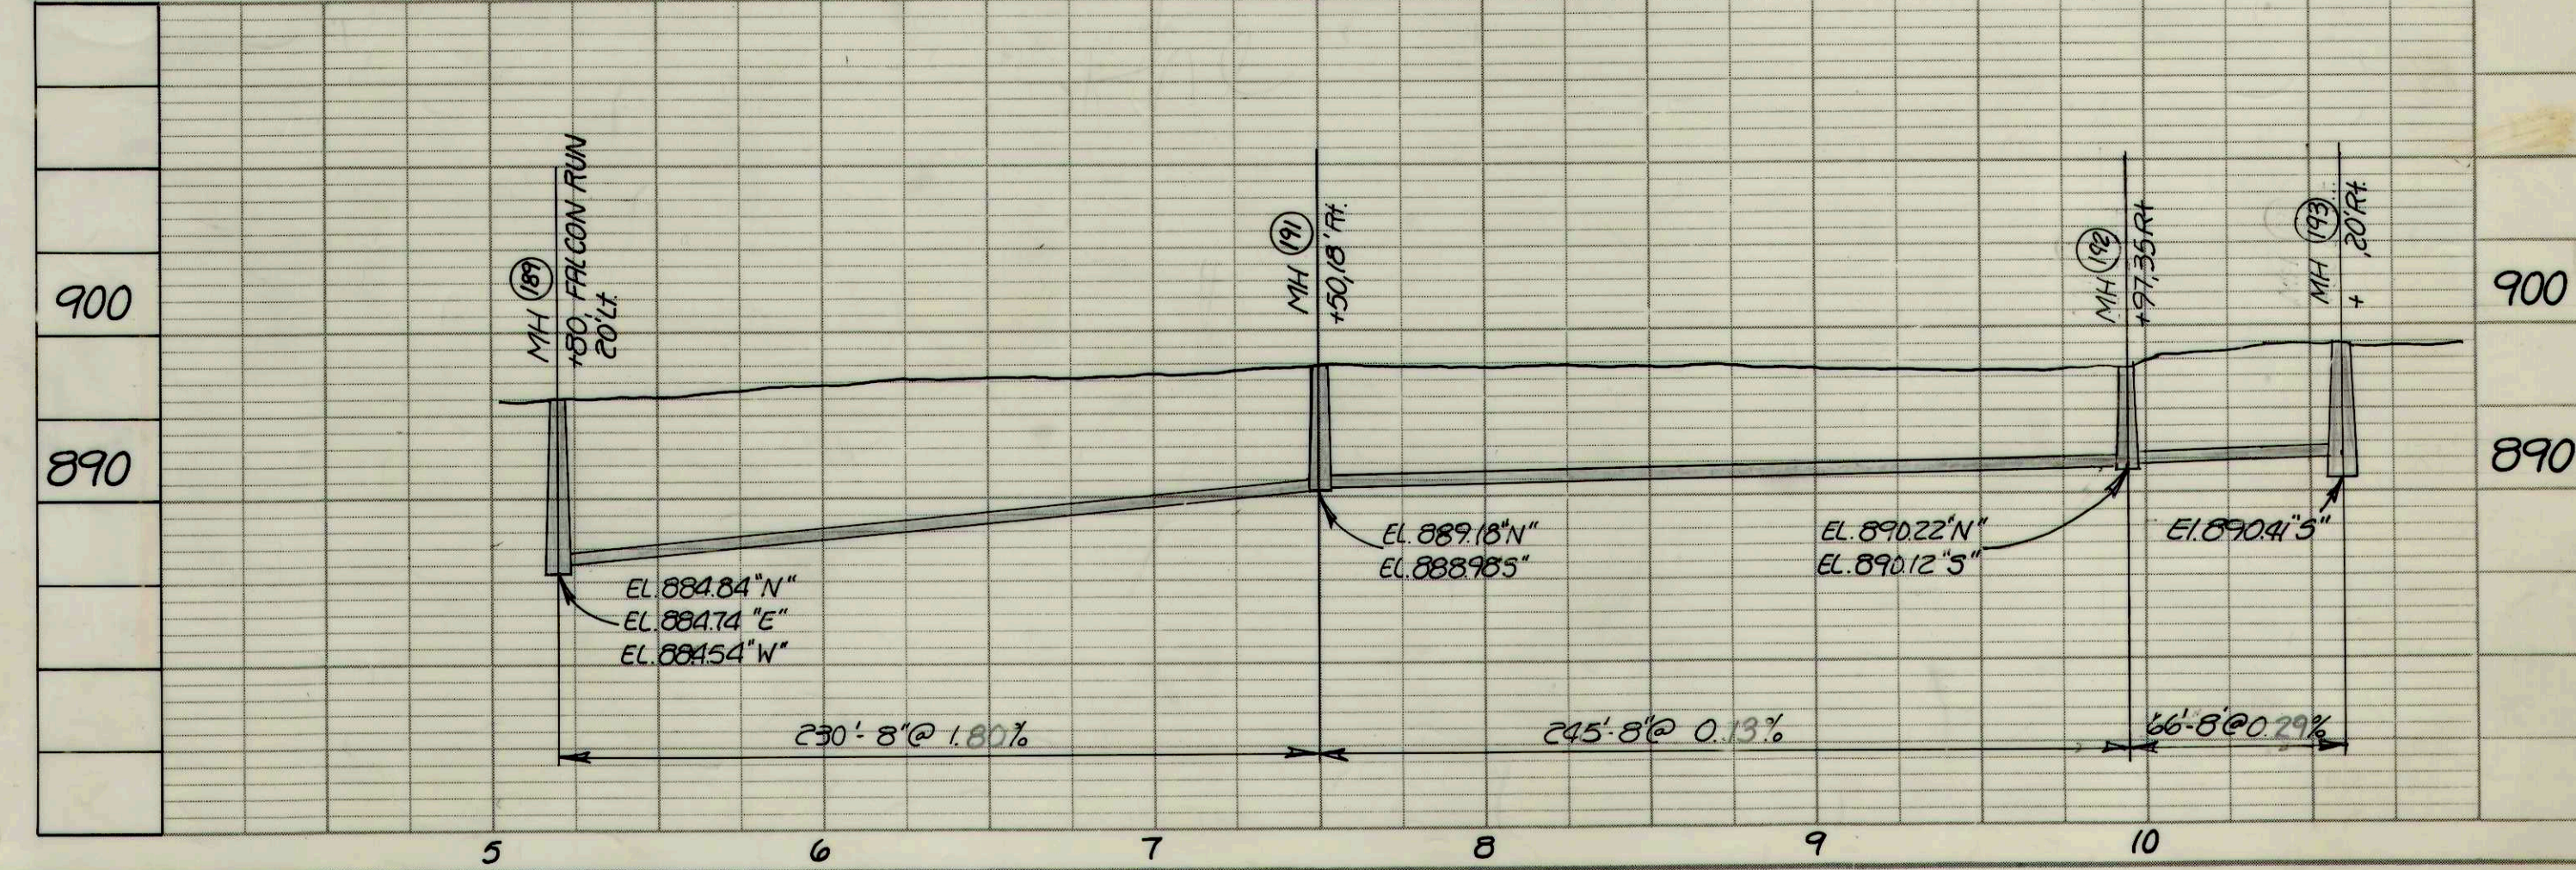
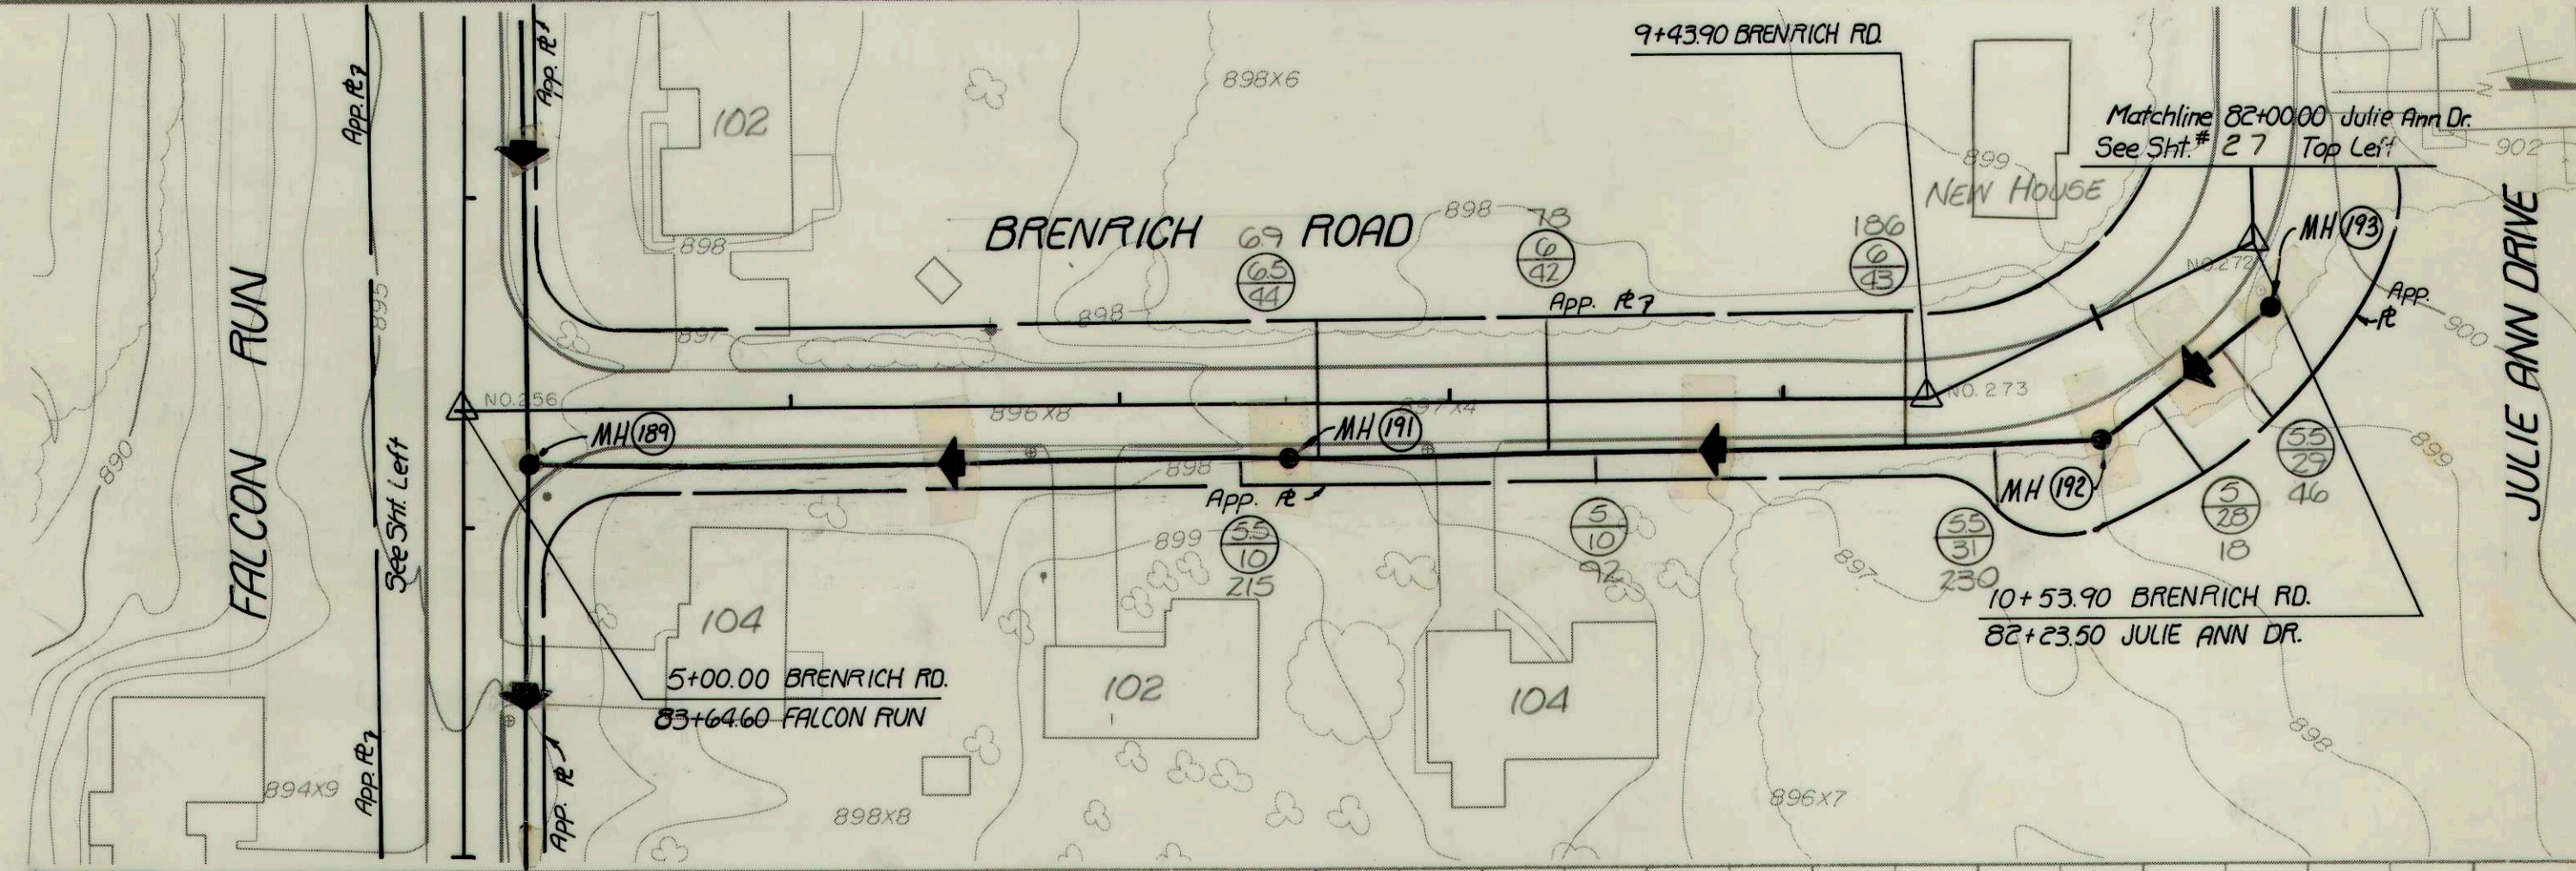
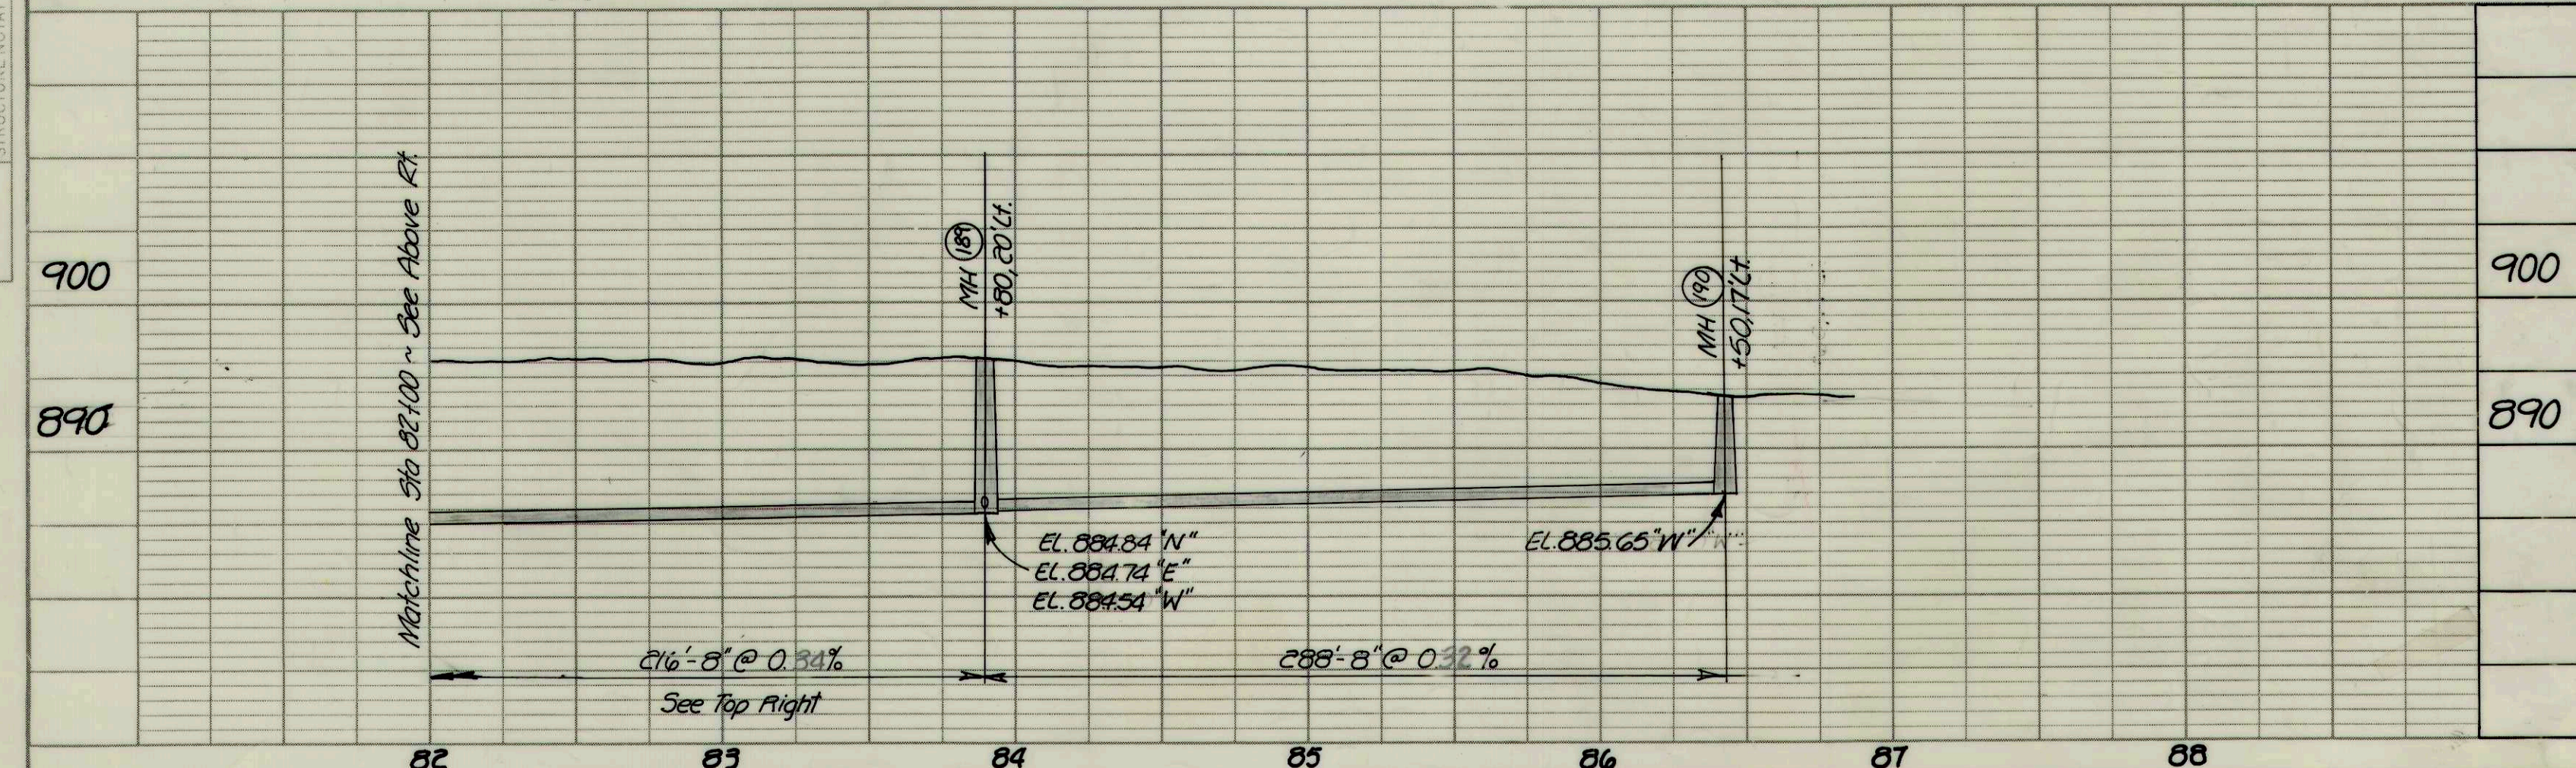
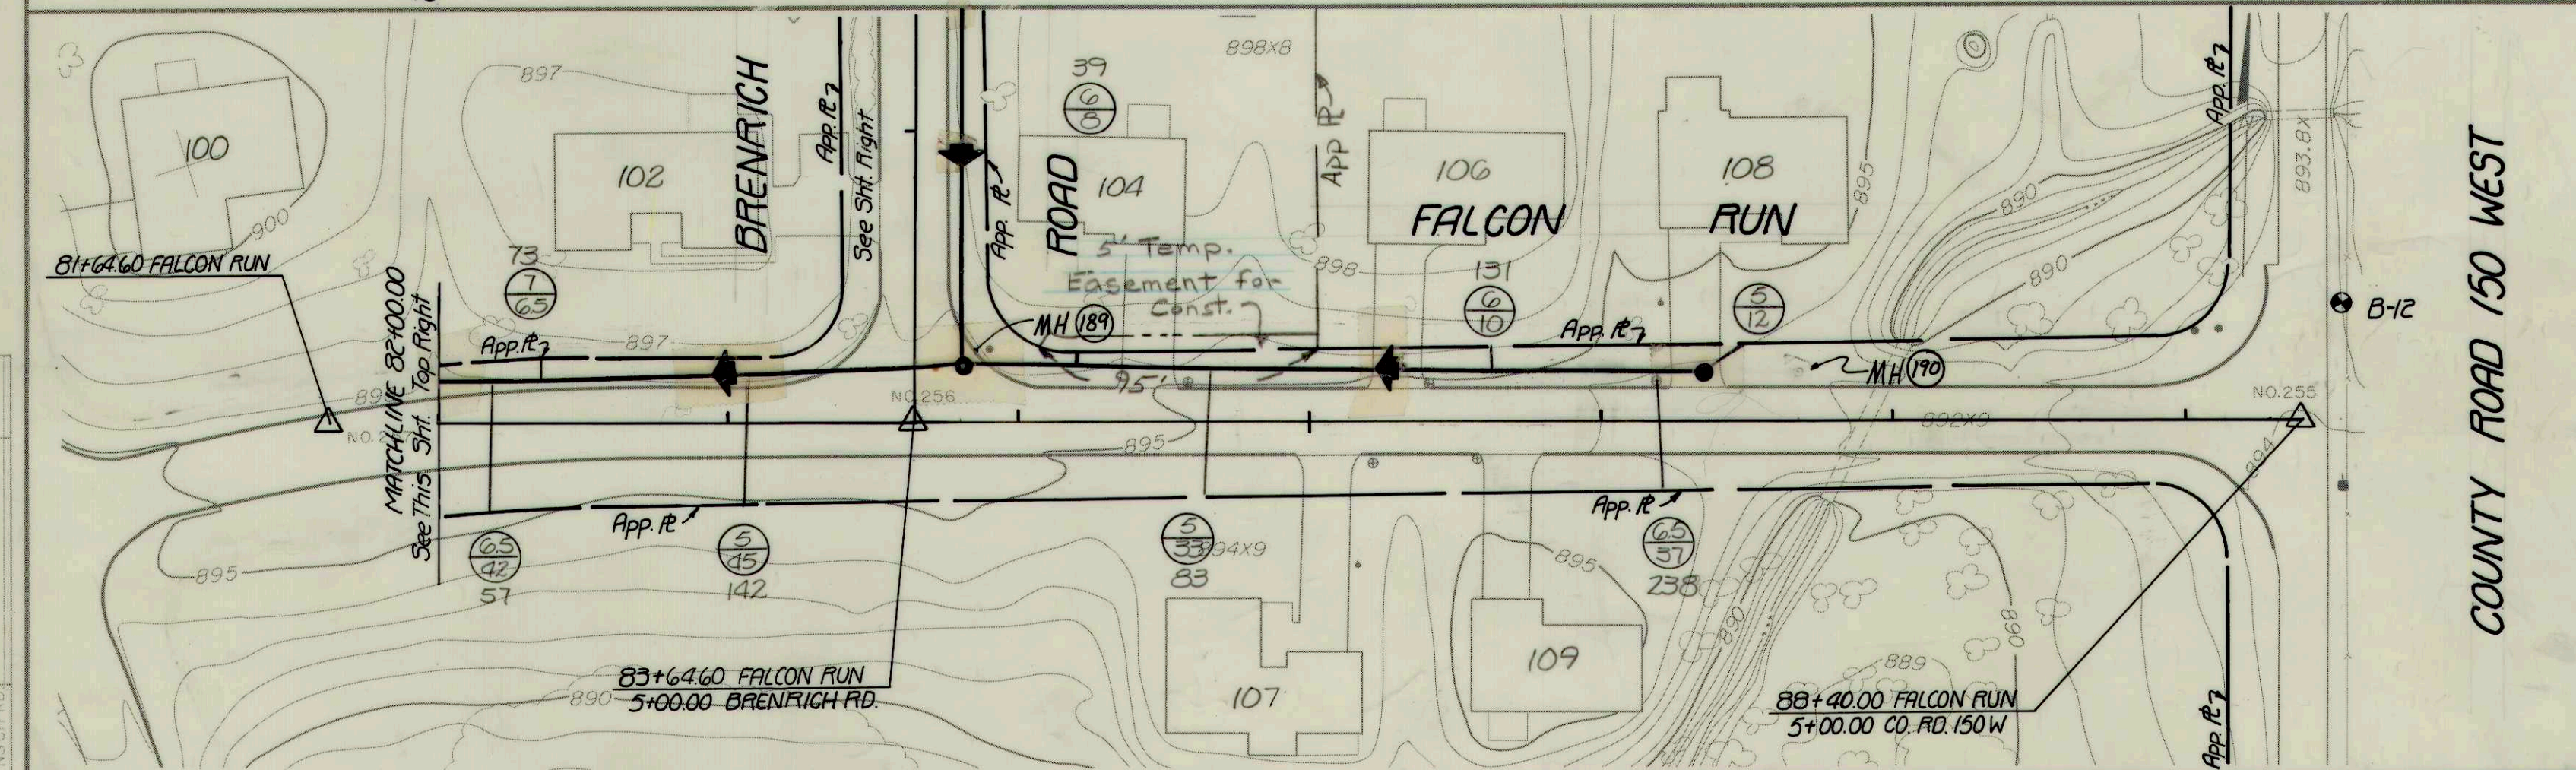
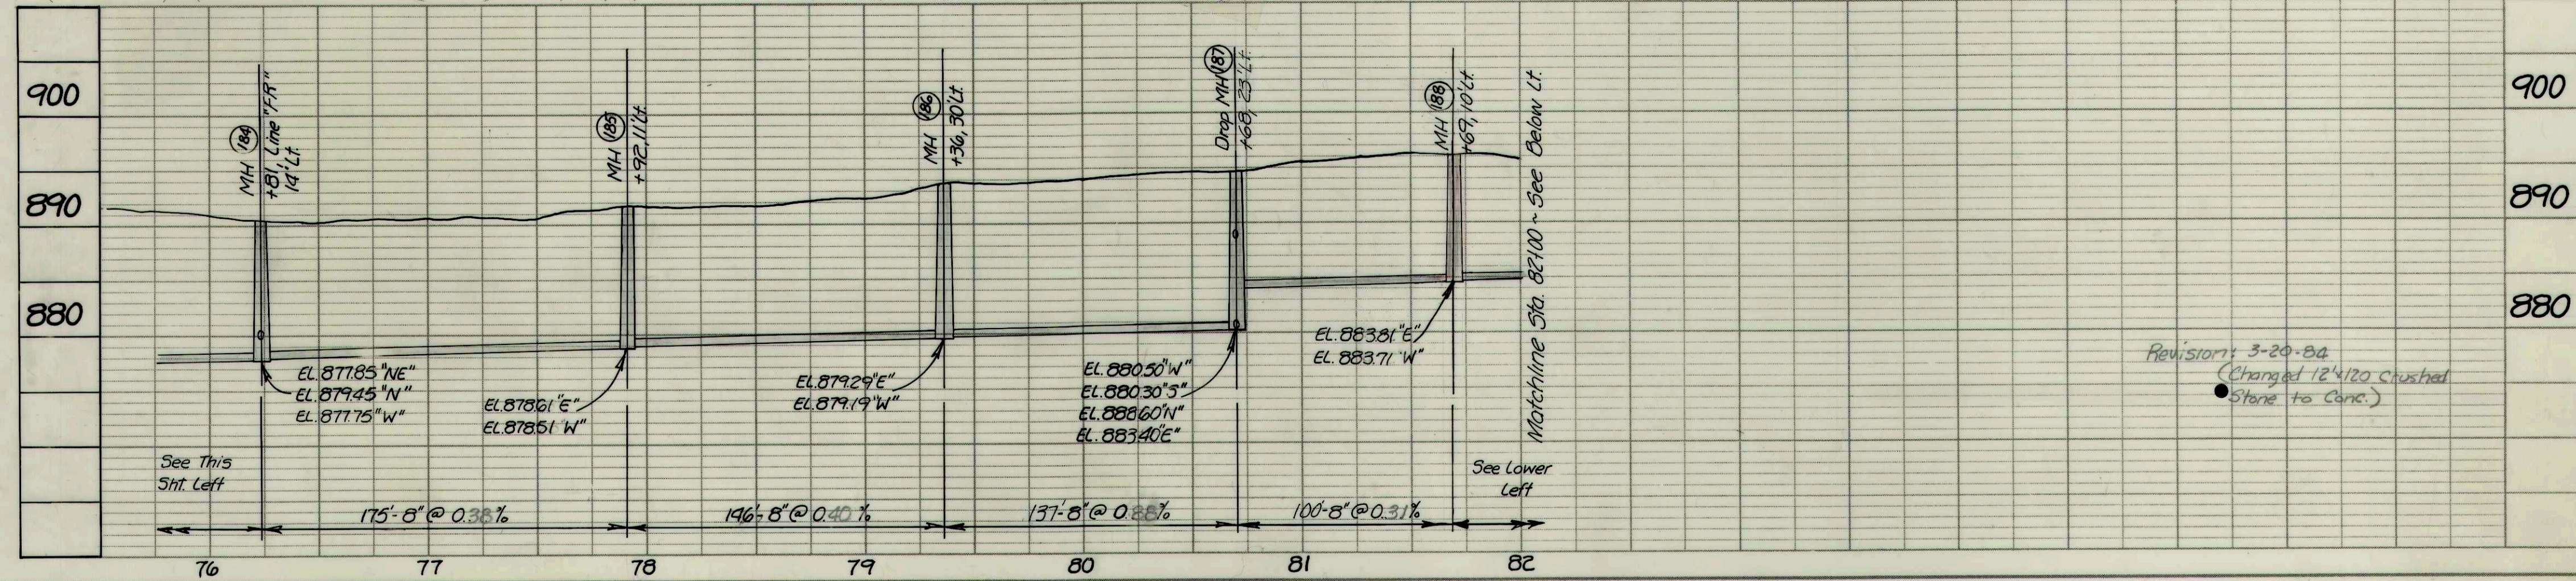
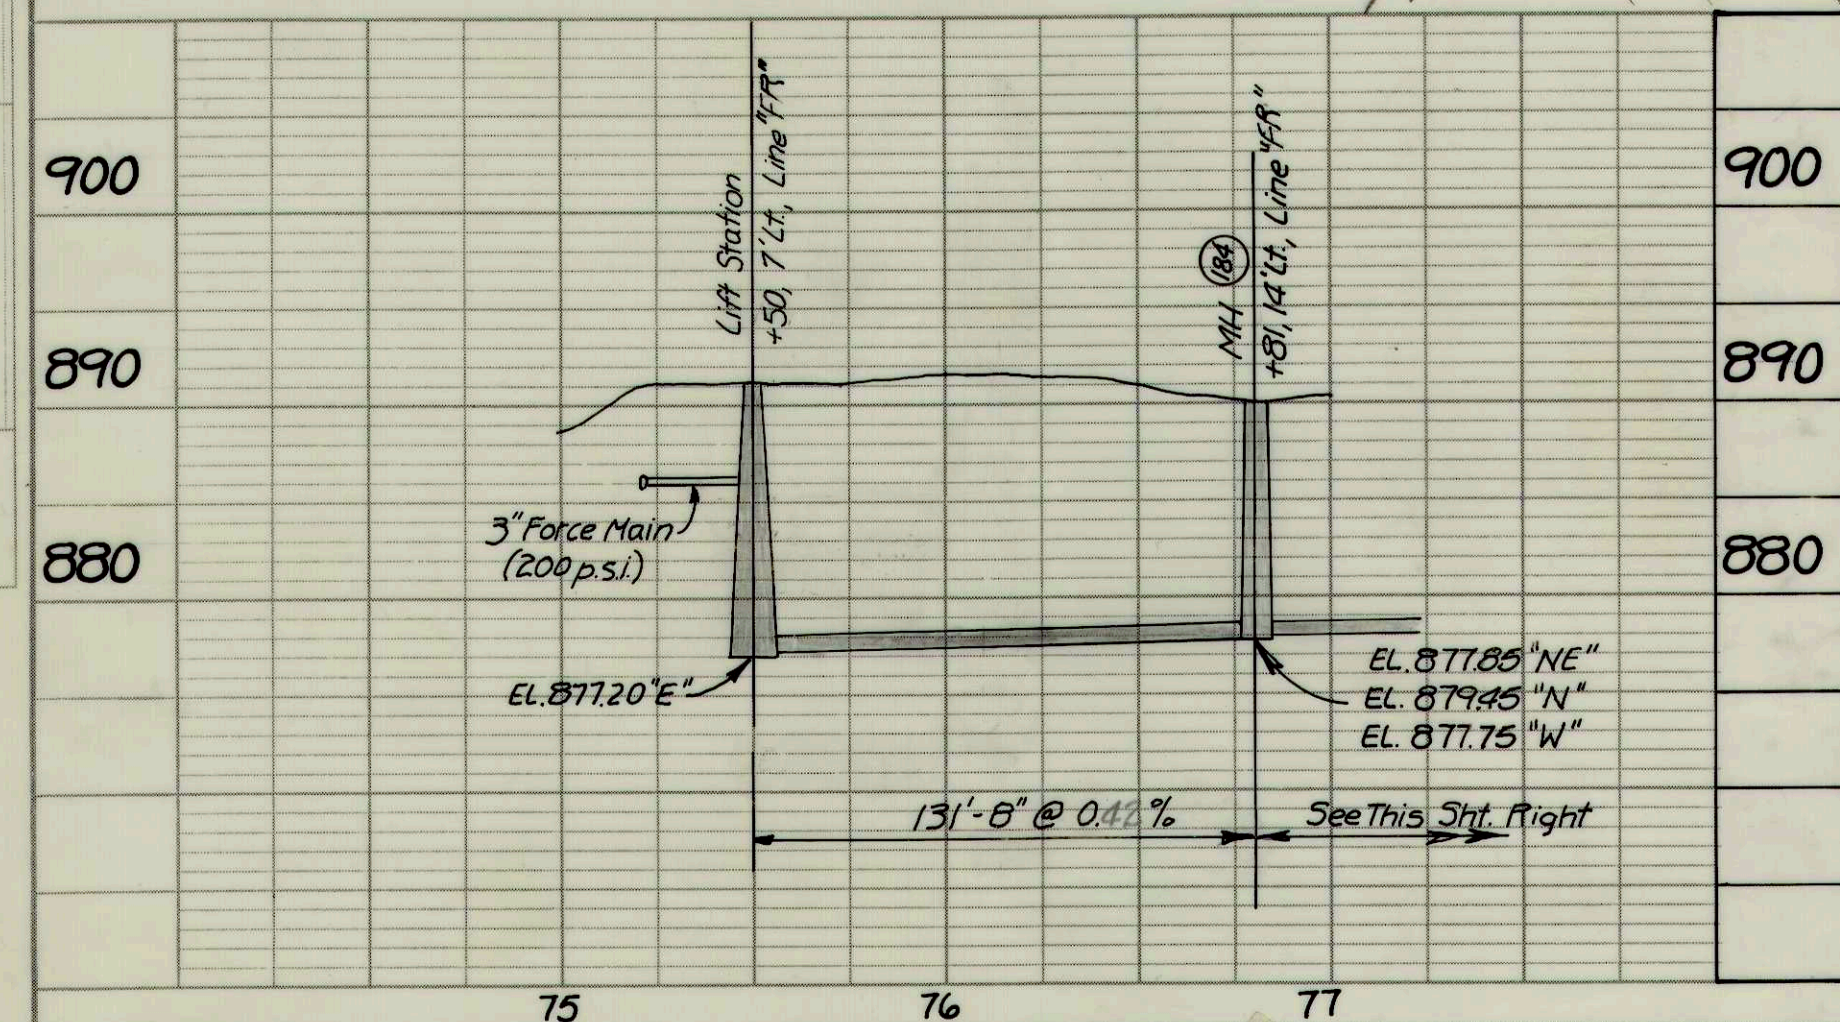


PLAN	SURVEYED	DATE
	PLOTTED	BY
	NOTED	NO.
	CHECKED	

PROFILE	SURVEYED	DATE
	PLOTTED	BY
	NOTED	NO.
	CHECKED	

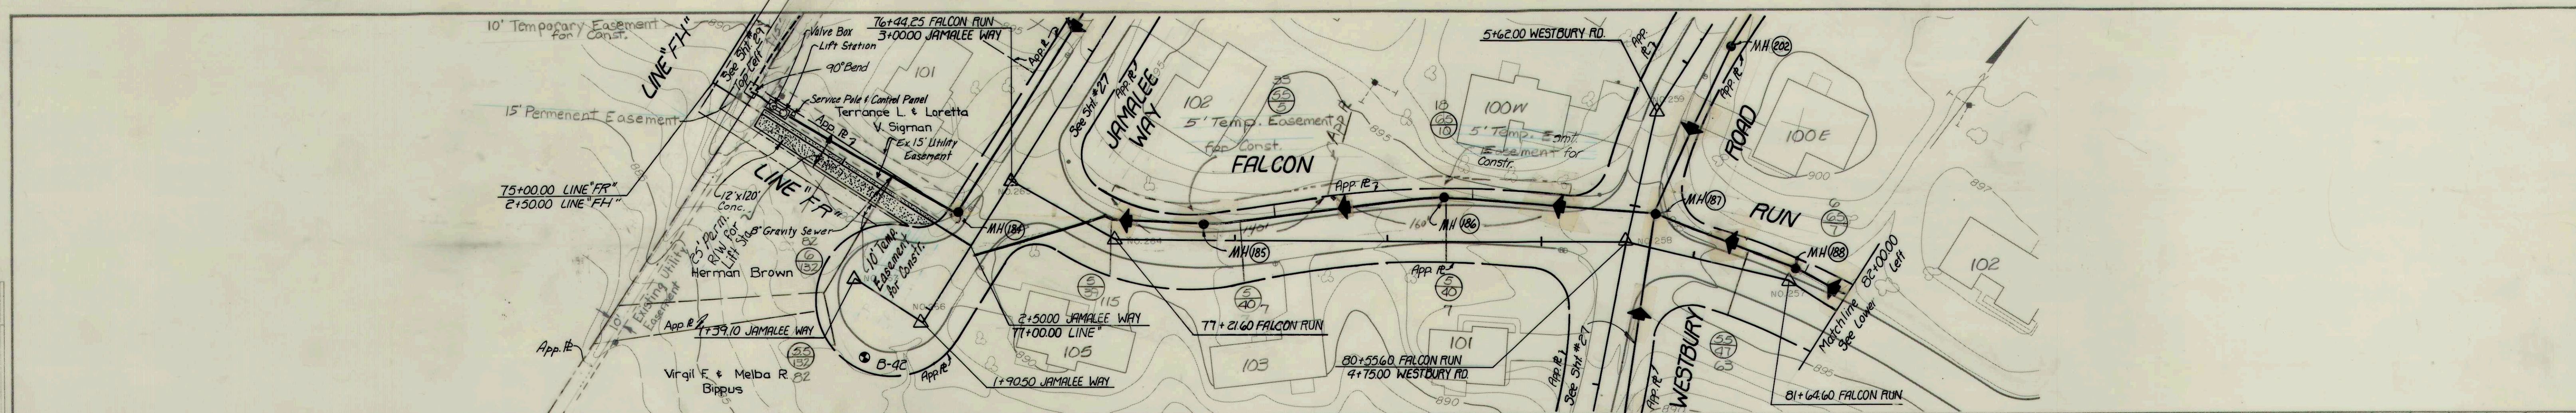

RECORD DRAWING

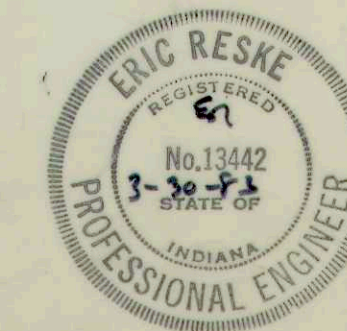

LINE 'FA' / FALCON RUN / BRENRICH RD.
FALL CREEK R.W.D. PLAN & PROFILE SHEET
HORIZ. 1"=50'
VERT. 1"=10'
BEAM, LONGEST & NEFF, INC.
CONSULTING ENGINEERS
INDIANAPOLIS, INDIANA