

|      |          |      |
|------|----------|------|
| PLAN | SURVEYED | DATE |
|      | PLOTTED  | BY   |
|      | NOTED    | NO.  |
|      | NO.      | NO.  |

|         |          |      |
|---------|----------|------|
| PROFILE | SURVEYED | DATE |
|         | PLOTTED  | BY   |
|         | NOTED    | NO.  |
|         | NO.      | NO.  |

2150.00 Line "FH"  
75100.00 Line "FR"

10' Temp Esmnt For Const  
15' Perm Esmnt  
25' Perm. R/W For Lift Sta.  
10' Temp Esmnt. for Const




LINE "FR"

Reconhurst Lift Station  
See Site Plan

LINE "FH"

10' TEMP ESMT FOR CONSTR.

Matchline 12150  
See Below Left

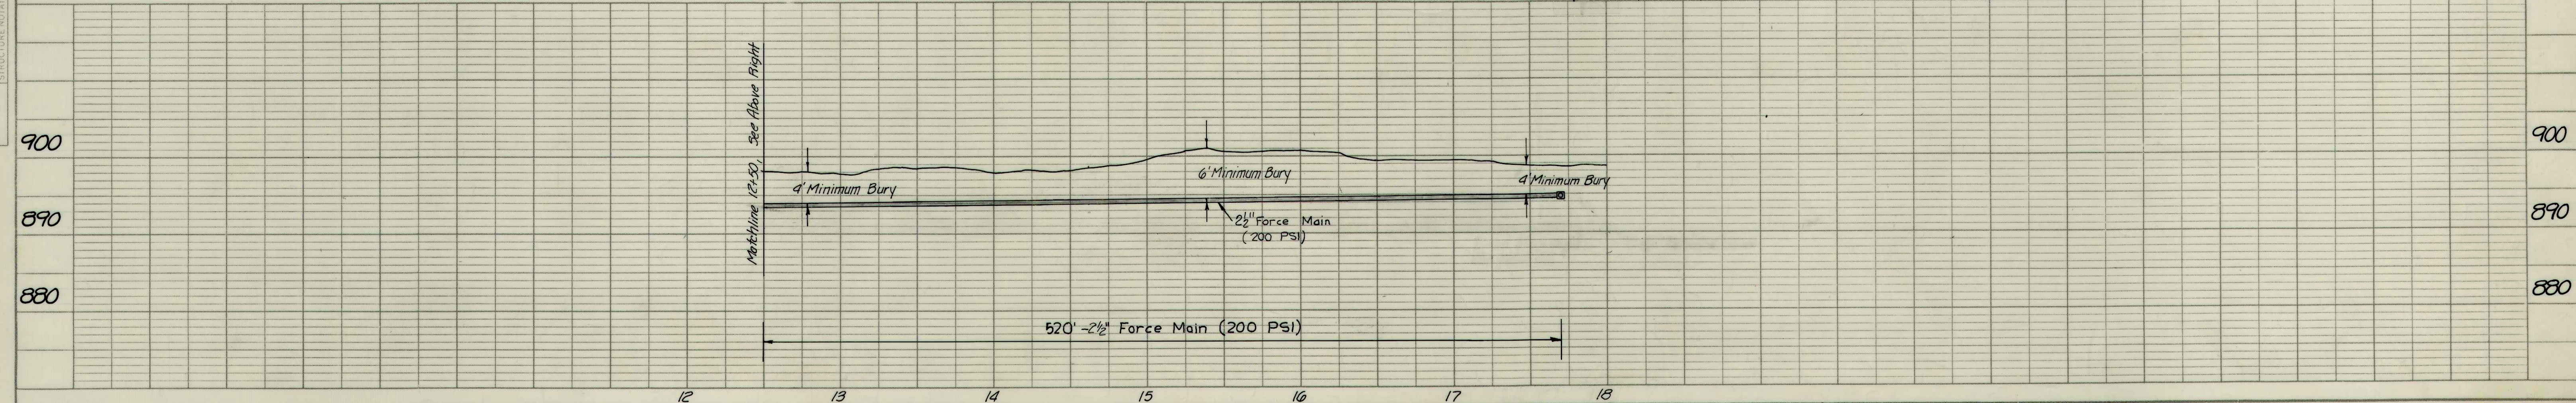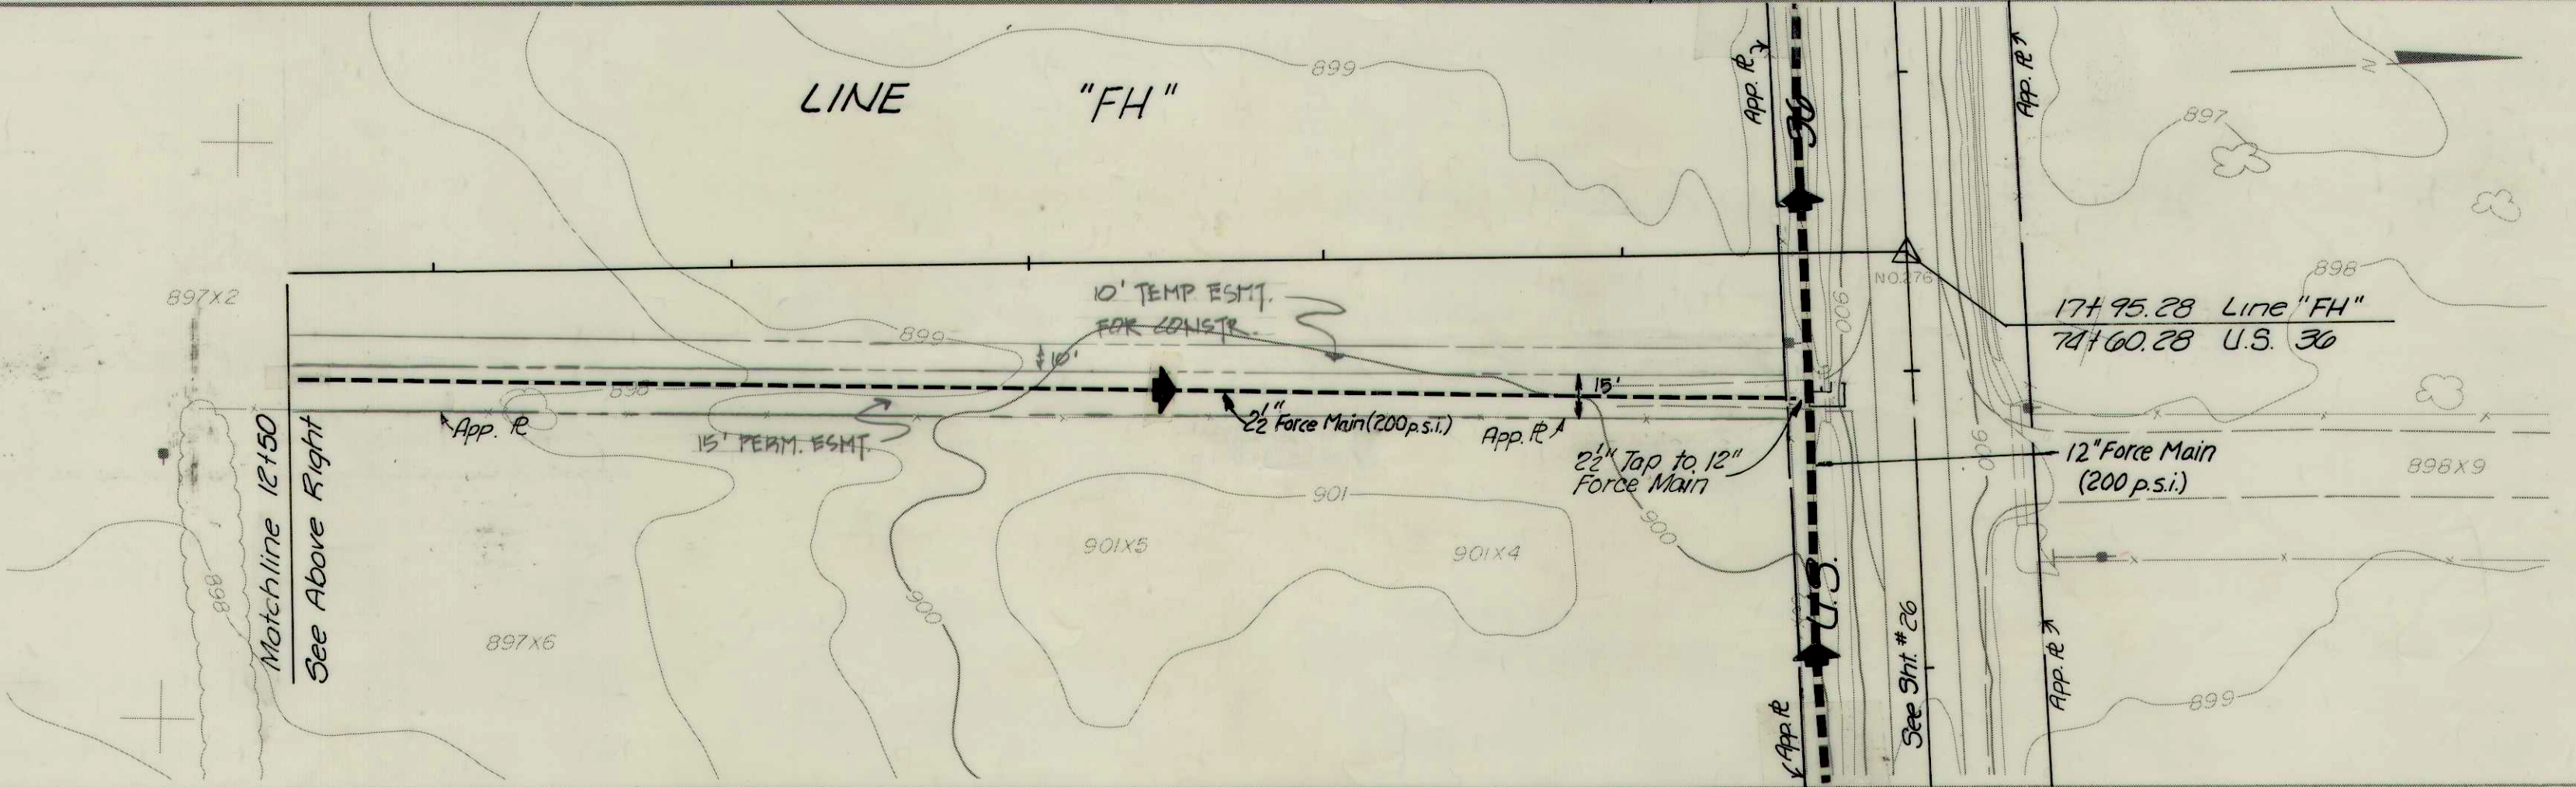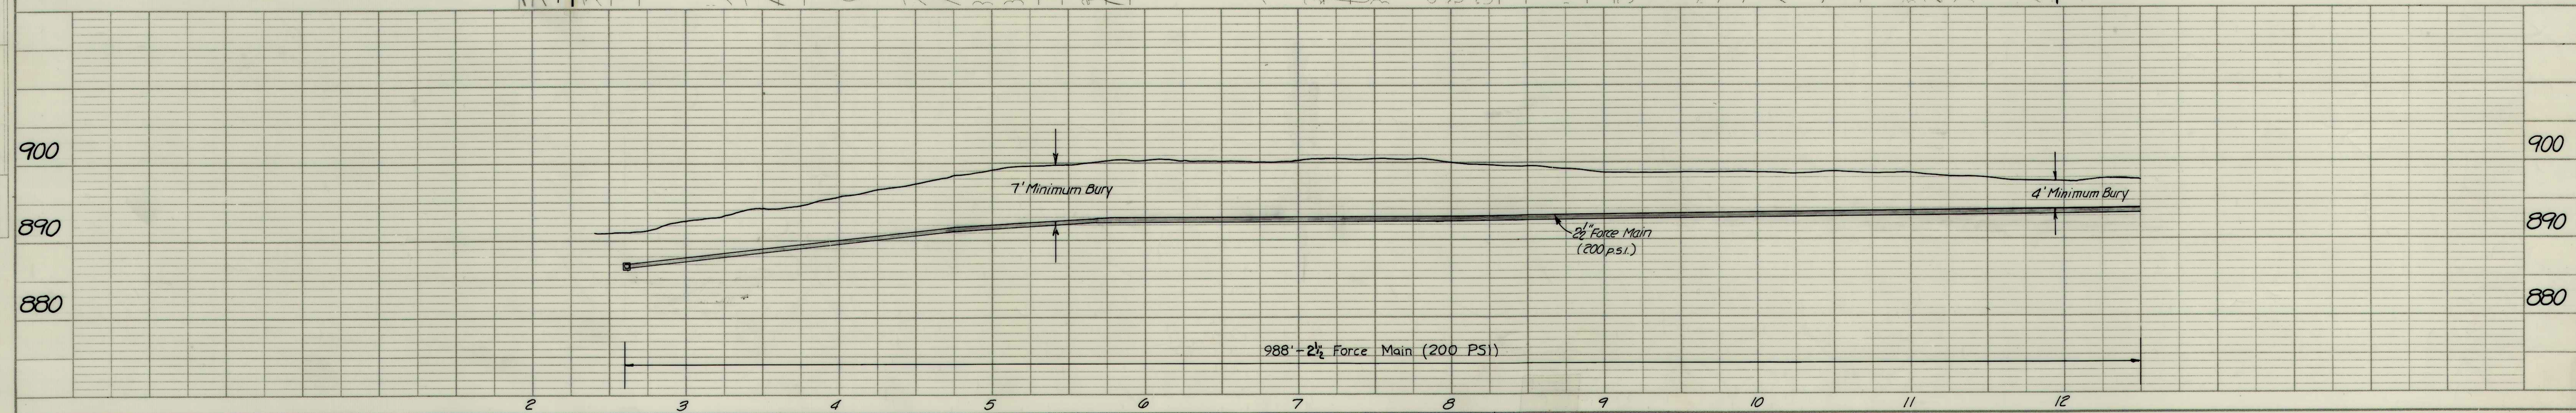

**RECORD DRAWING**



|                                  |                                                                             |             |
|----------------------------------|-----------------------------------------------------------------------------|-------------|
| LINE "FH"                        |                                                                             | SHEET<br>29 |
| FALL CREEK R.W.D. PLAN & PROFILE |                                                                             |             |
| HORIZ. 1"=50'                    | BEAM, LONGEST & NEFF, INC.<br>CONSULTING ENGINEERS<br>INDIANAPOLIS, INDIANA |             |
| VERT. 1"=10'                     |                                                                             |             |