



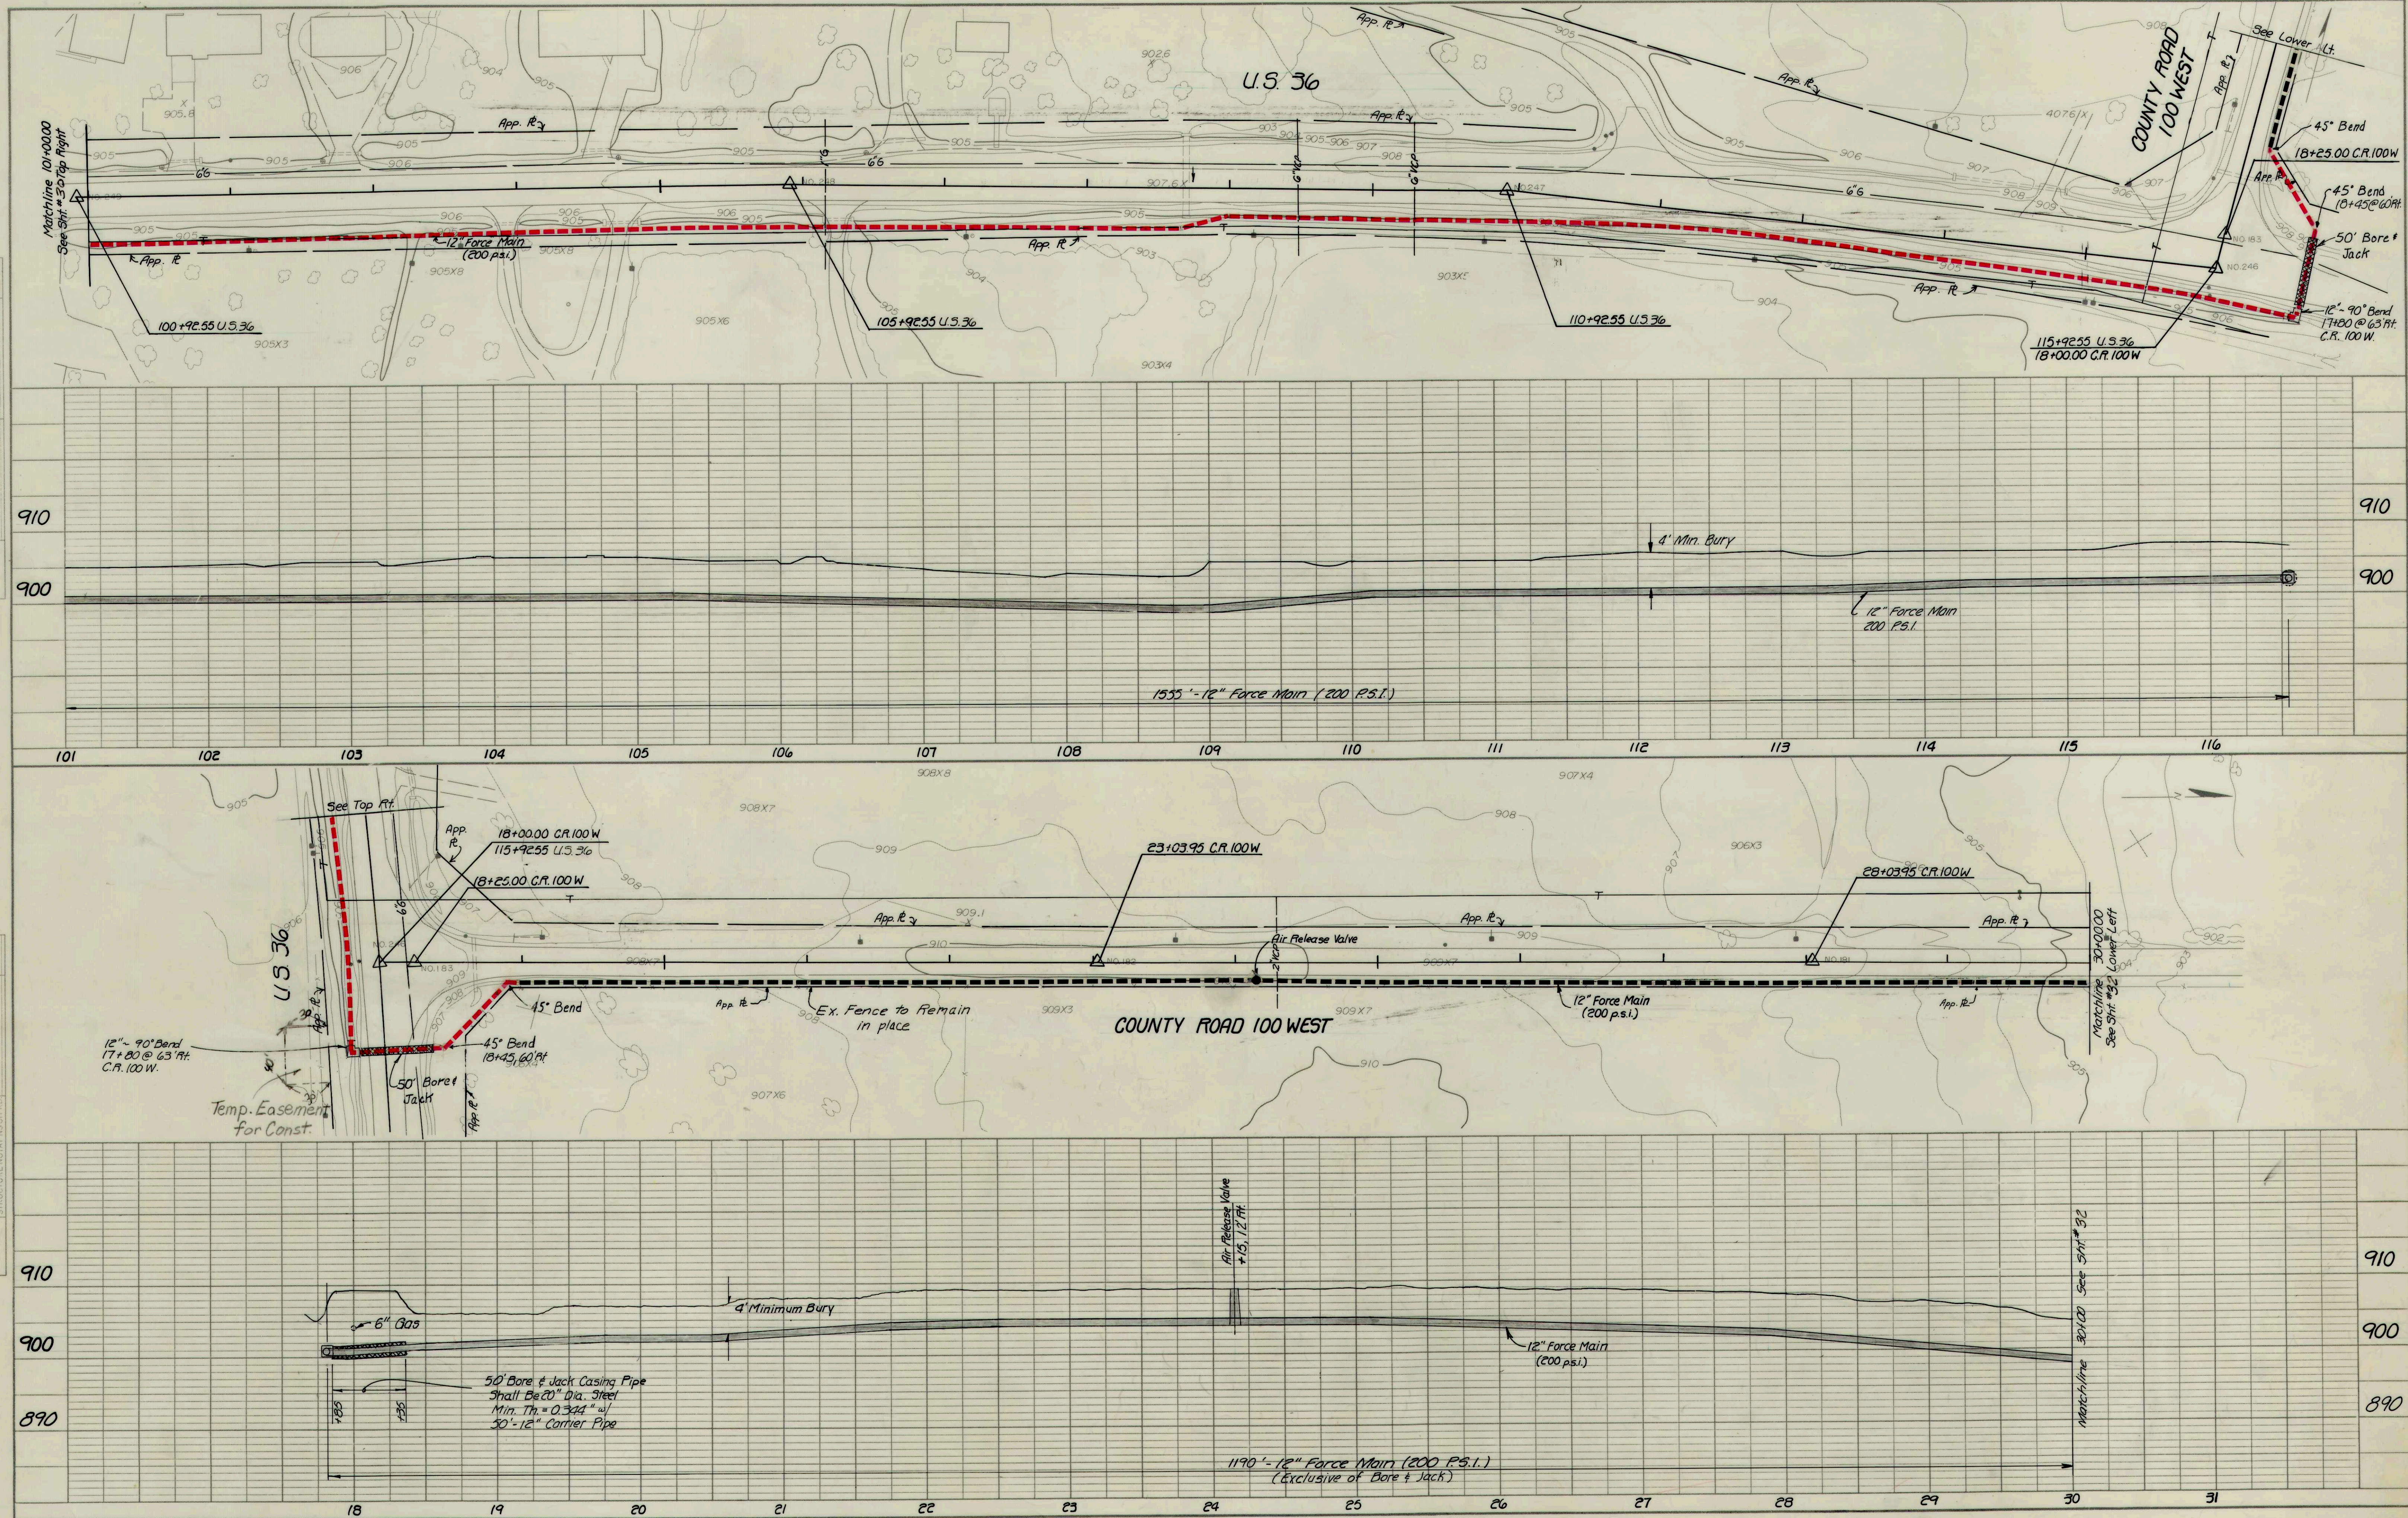

RECORD DRAWING

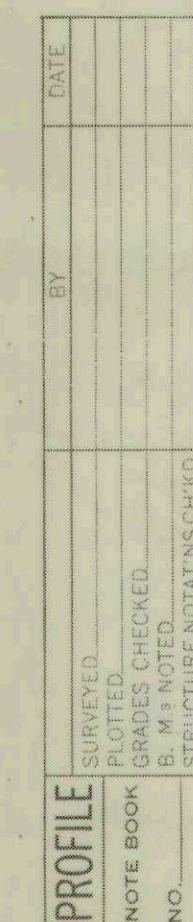

U.S. 36 / Co. Rd. 100 WEST	
FALL CREEK R.W.D. PLAN & PROFILE	SHEET
HORIZ. 1"=50'	BEAM, LONGEST & NEFF, INC.
	CONSULTING ENGINEERS
VERT. 1"=10'	INDIANAPOLIS, INDIANA

[illegible]