

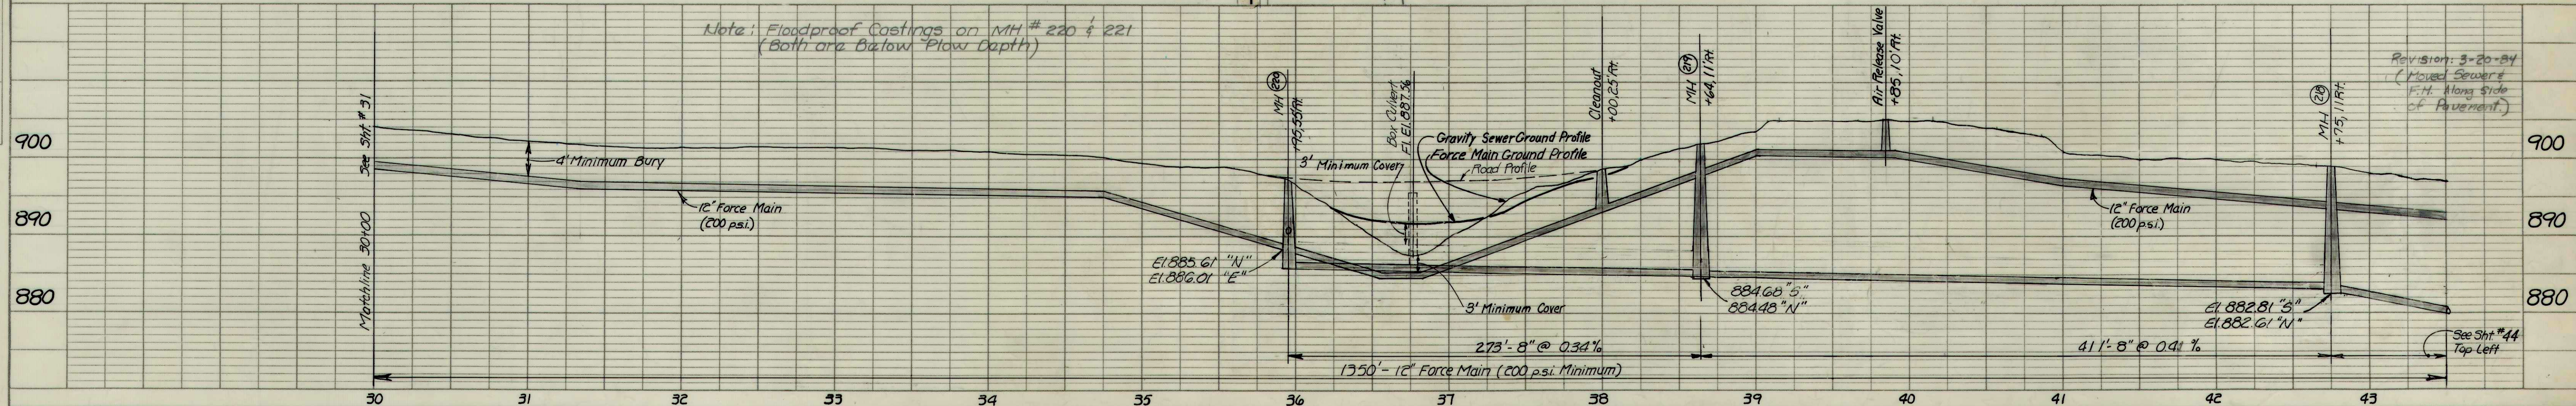
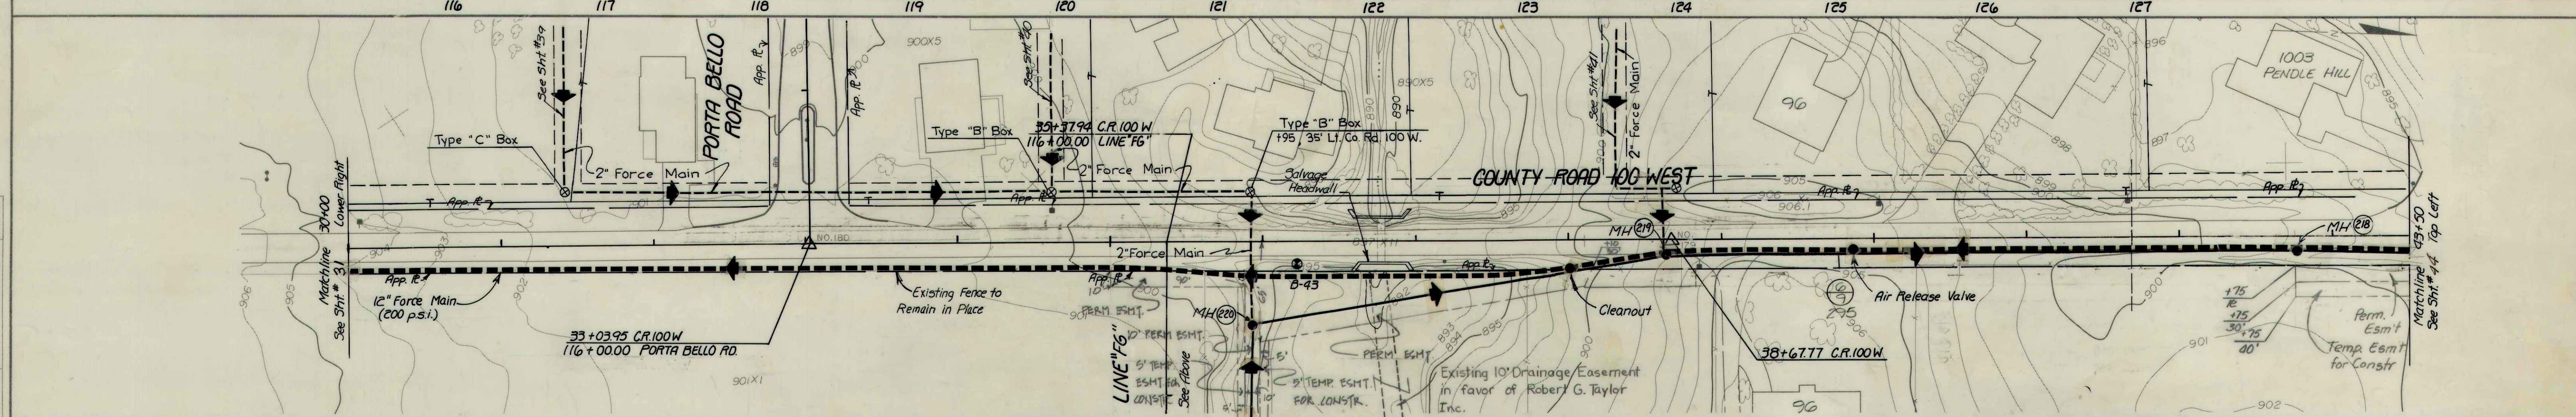


PLAN	SURVEYED	DATE
	PLOTTED	BY
NOTE BOOK	NOTES CHECKED	DATE
	NO. OF PAGES	BY

PROFILE	SURVEYED	DATE
	PLOTTED	BY
NOTE BOOK	NOTES CHECKED	DATE
	NO. OF PAGES	BY

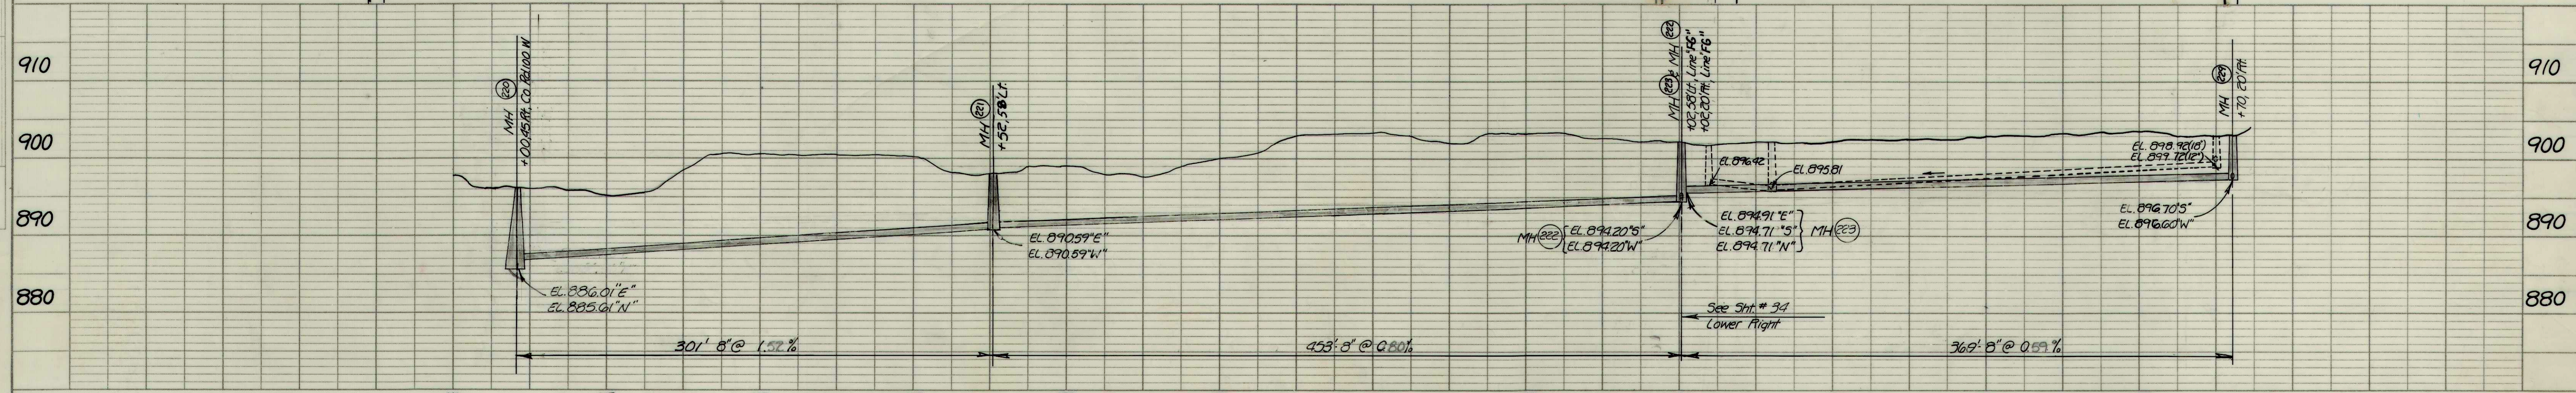

RECORD DRAWING

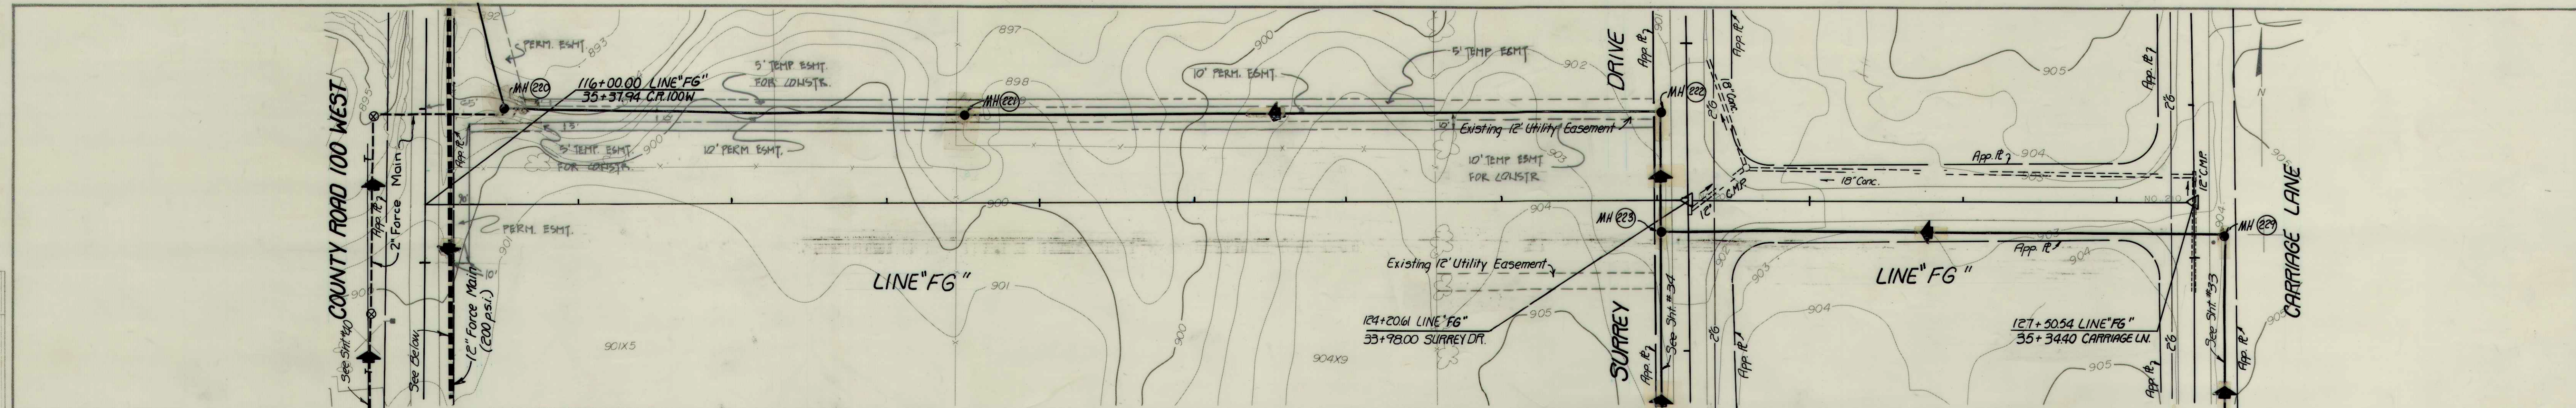

LINE 'FG' Co Rd 100 WEST	
FALL CREEK R.W.D. PLAN & PROFILE SHEET	
HORIZ. 1"=50'	BEAM, LONGST & NEFF, INC.
VERT. 1"=10'	CONSULTING ENGINEERS
	INDIANAPOLIS, INDIANA
	32