

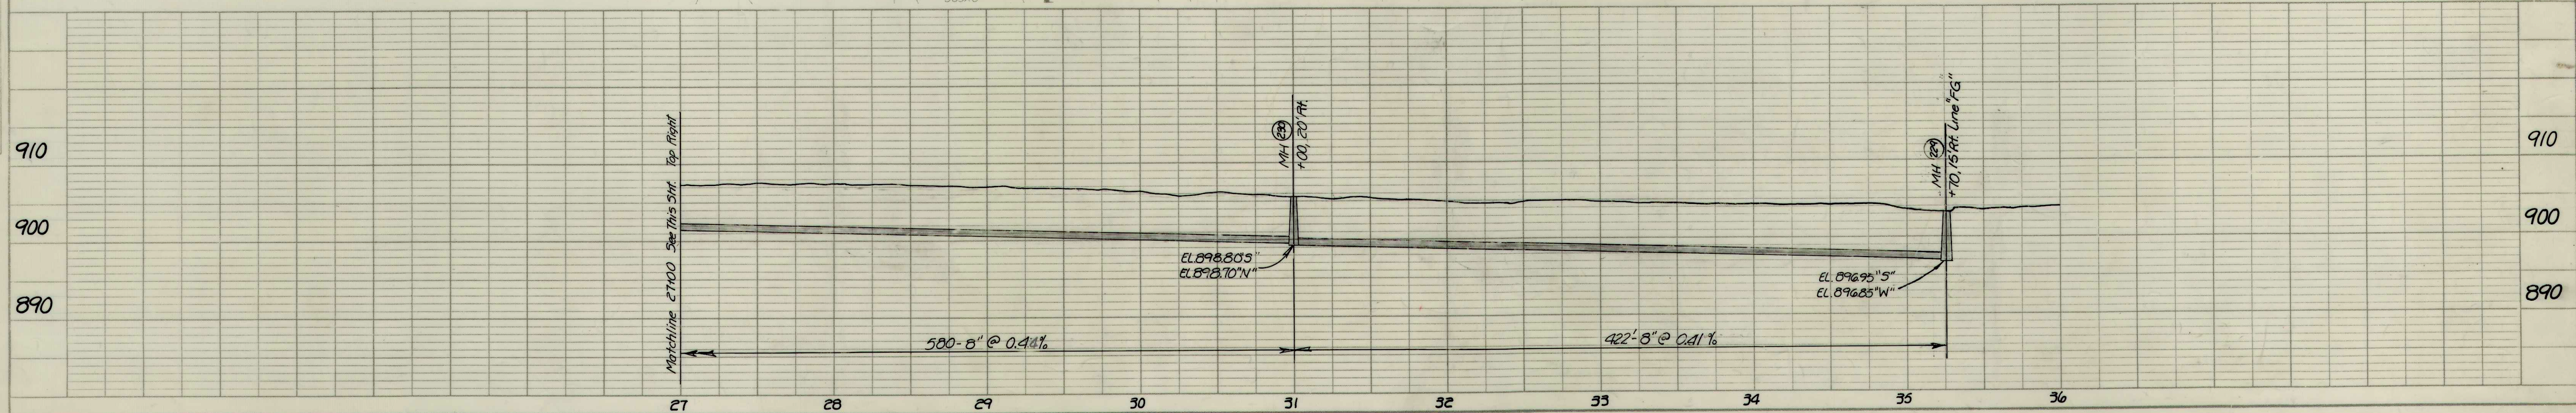
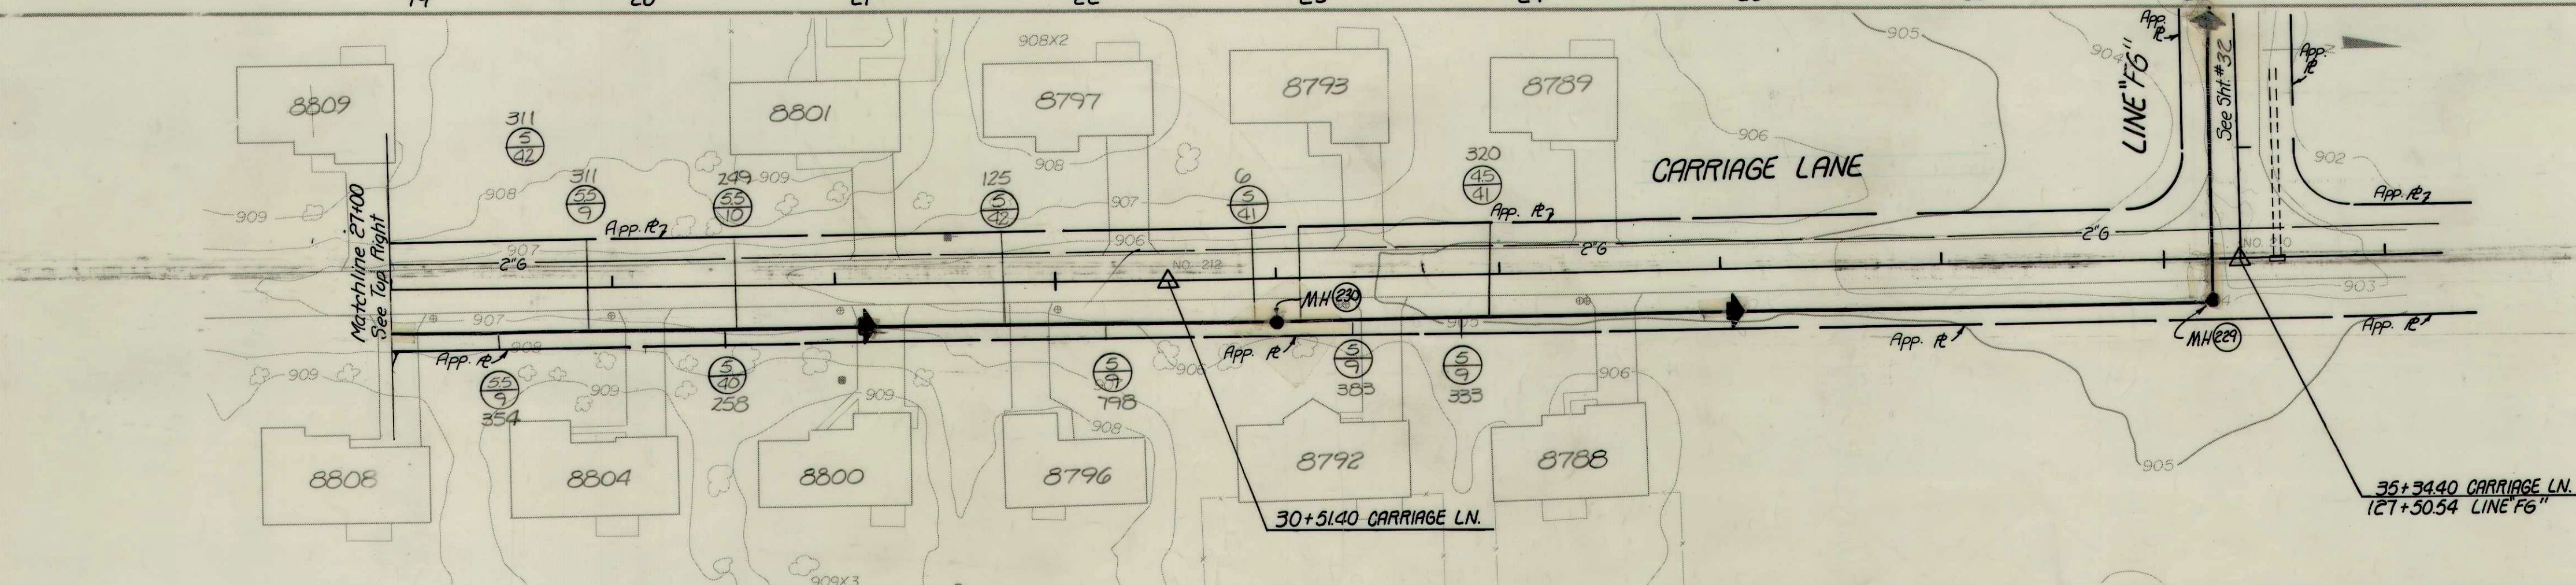


|      |         |  |
|------|---------|--|
| PLAN | DATE    |  |
|      | BY      |  |
|      | CHECKED |  |
|      | NOTED   |  |

|         |         |  |
|---------|---------|--|
| PROFILE | DATE    |  |
|         | BY      |  |
|         | CHECKED |  |
|         | NOTED   |  |

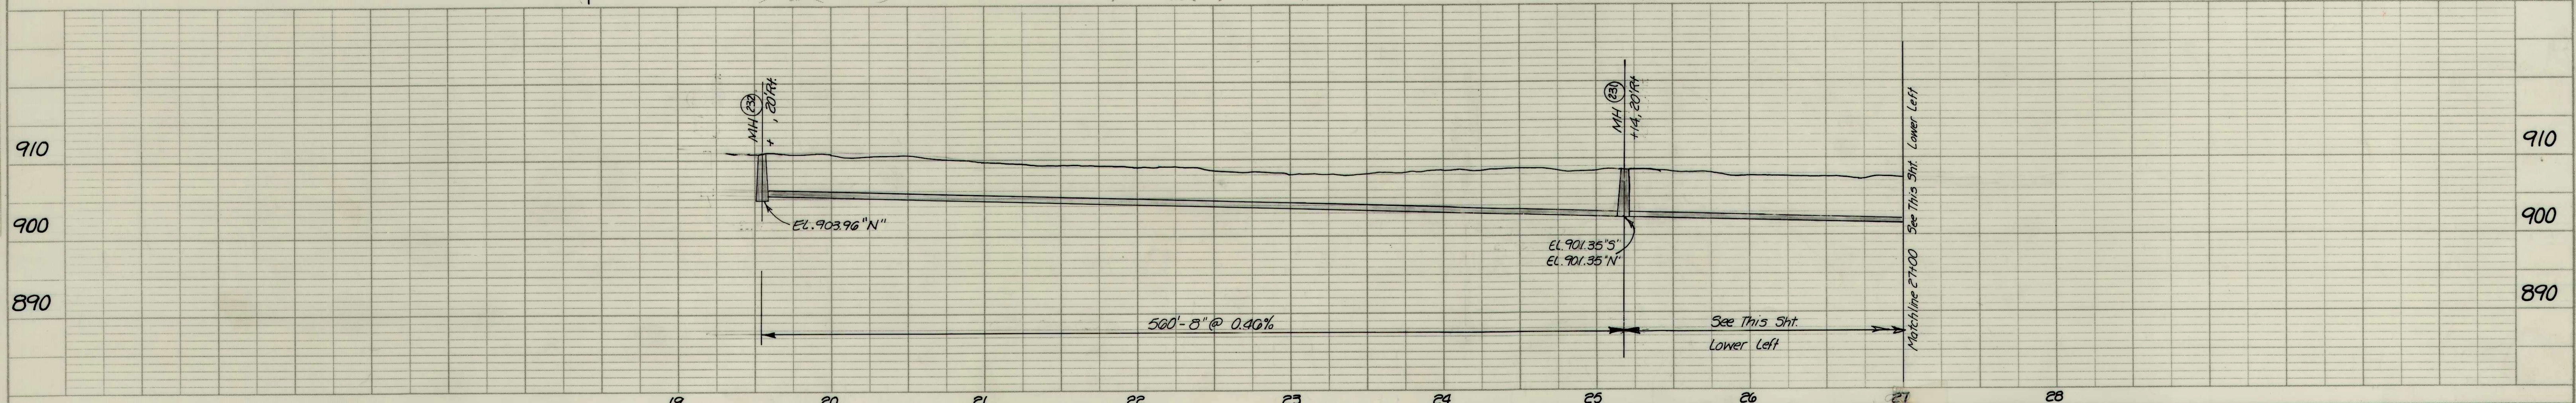

**RECORD DRAWING**

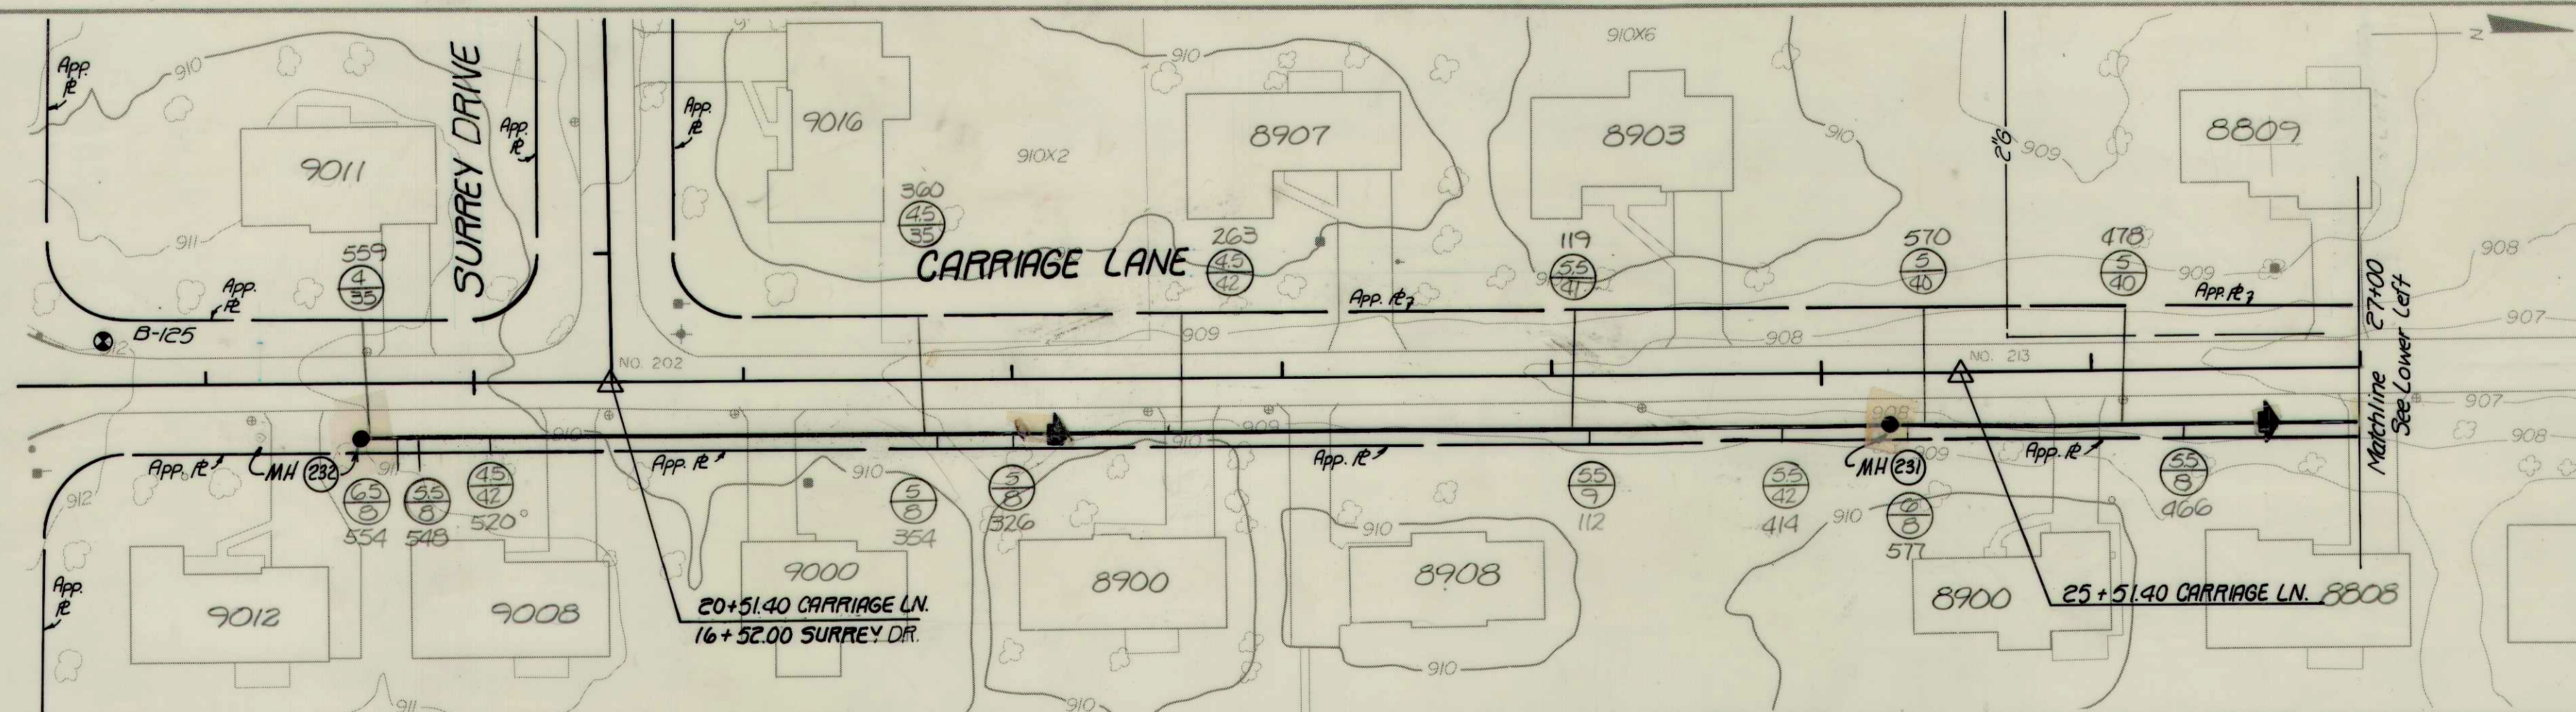

|                                        |                            |
|----------------------------------------|----------------------------|
| CARRIAGE LANE                          |                            |
| FALL CREEK R.W.D. PLAN & PROFILE SHEET |                            |
| HORIZ. 1"=50'                          | BEAM, LONGEST & NEFF, INC. |
| VERT. 1"=10'                           | CONSULTING ENGINEERS       |
|                                        | INDIANAPOLIS, INDIANA      |