


PLAN	DATE	
	BY	
	CHECKED	
	NO.	

PROFILE	DATE	
	BY	
	CHECKED	
	NO.	

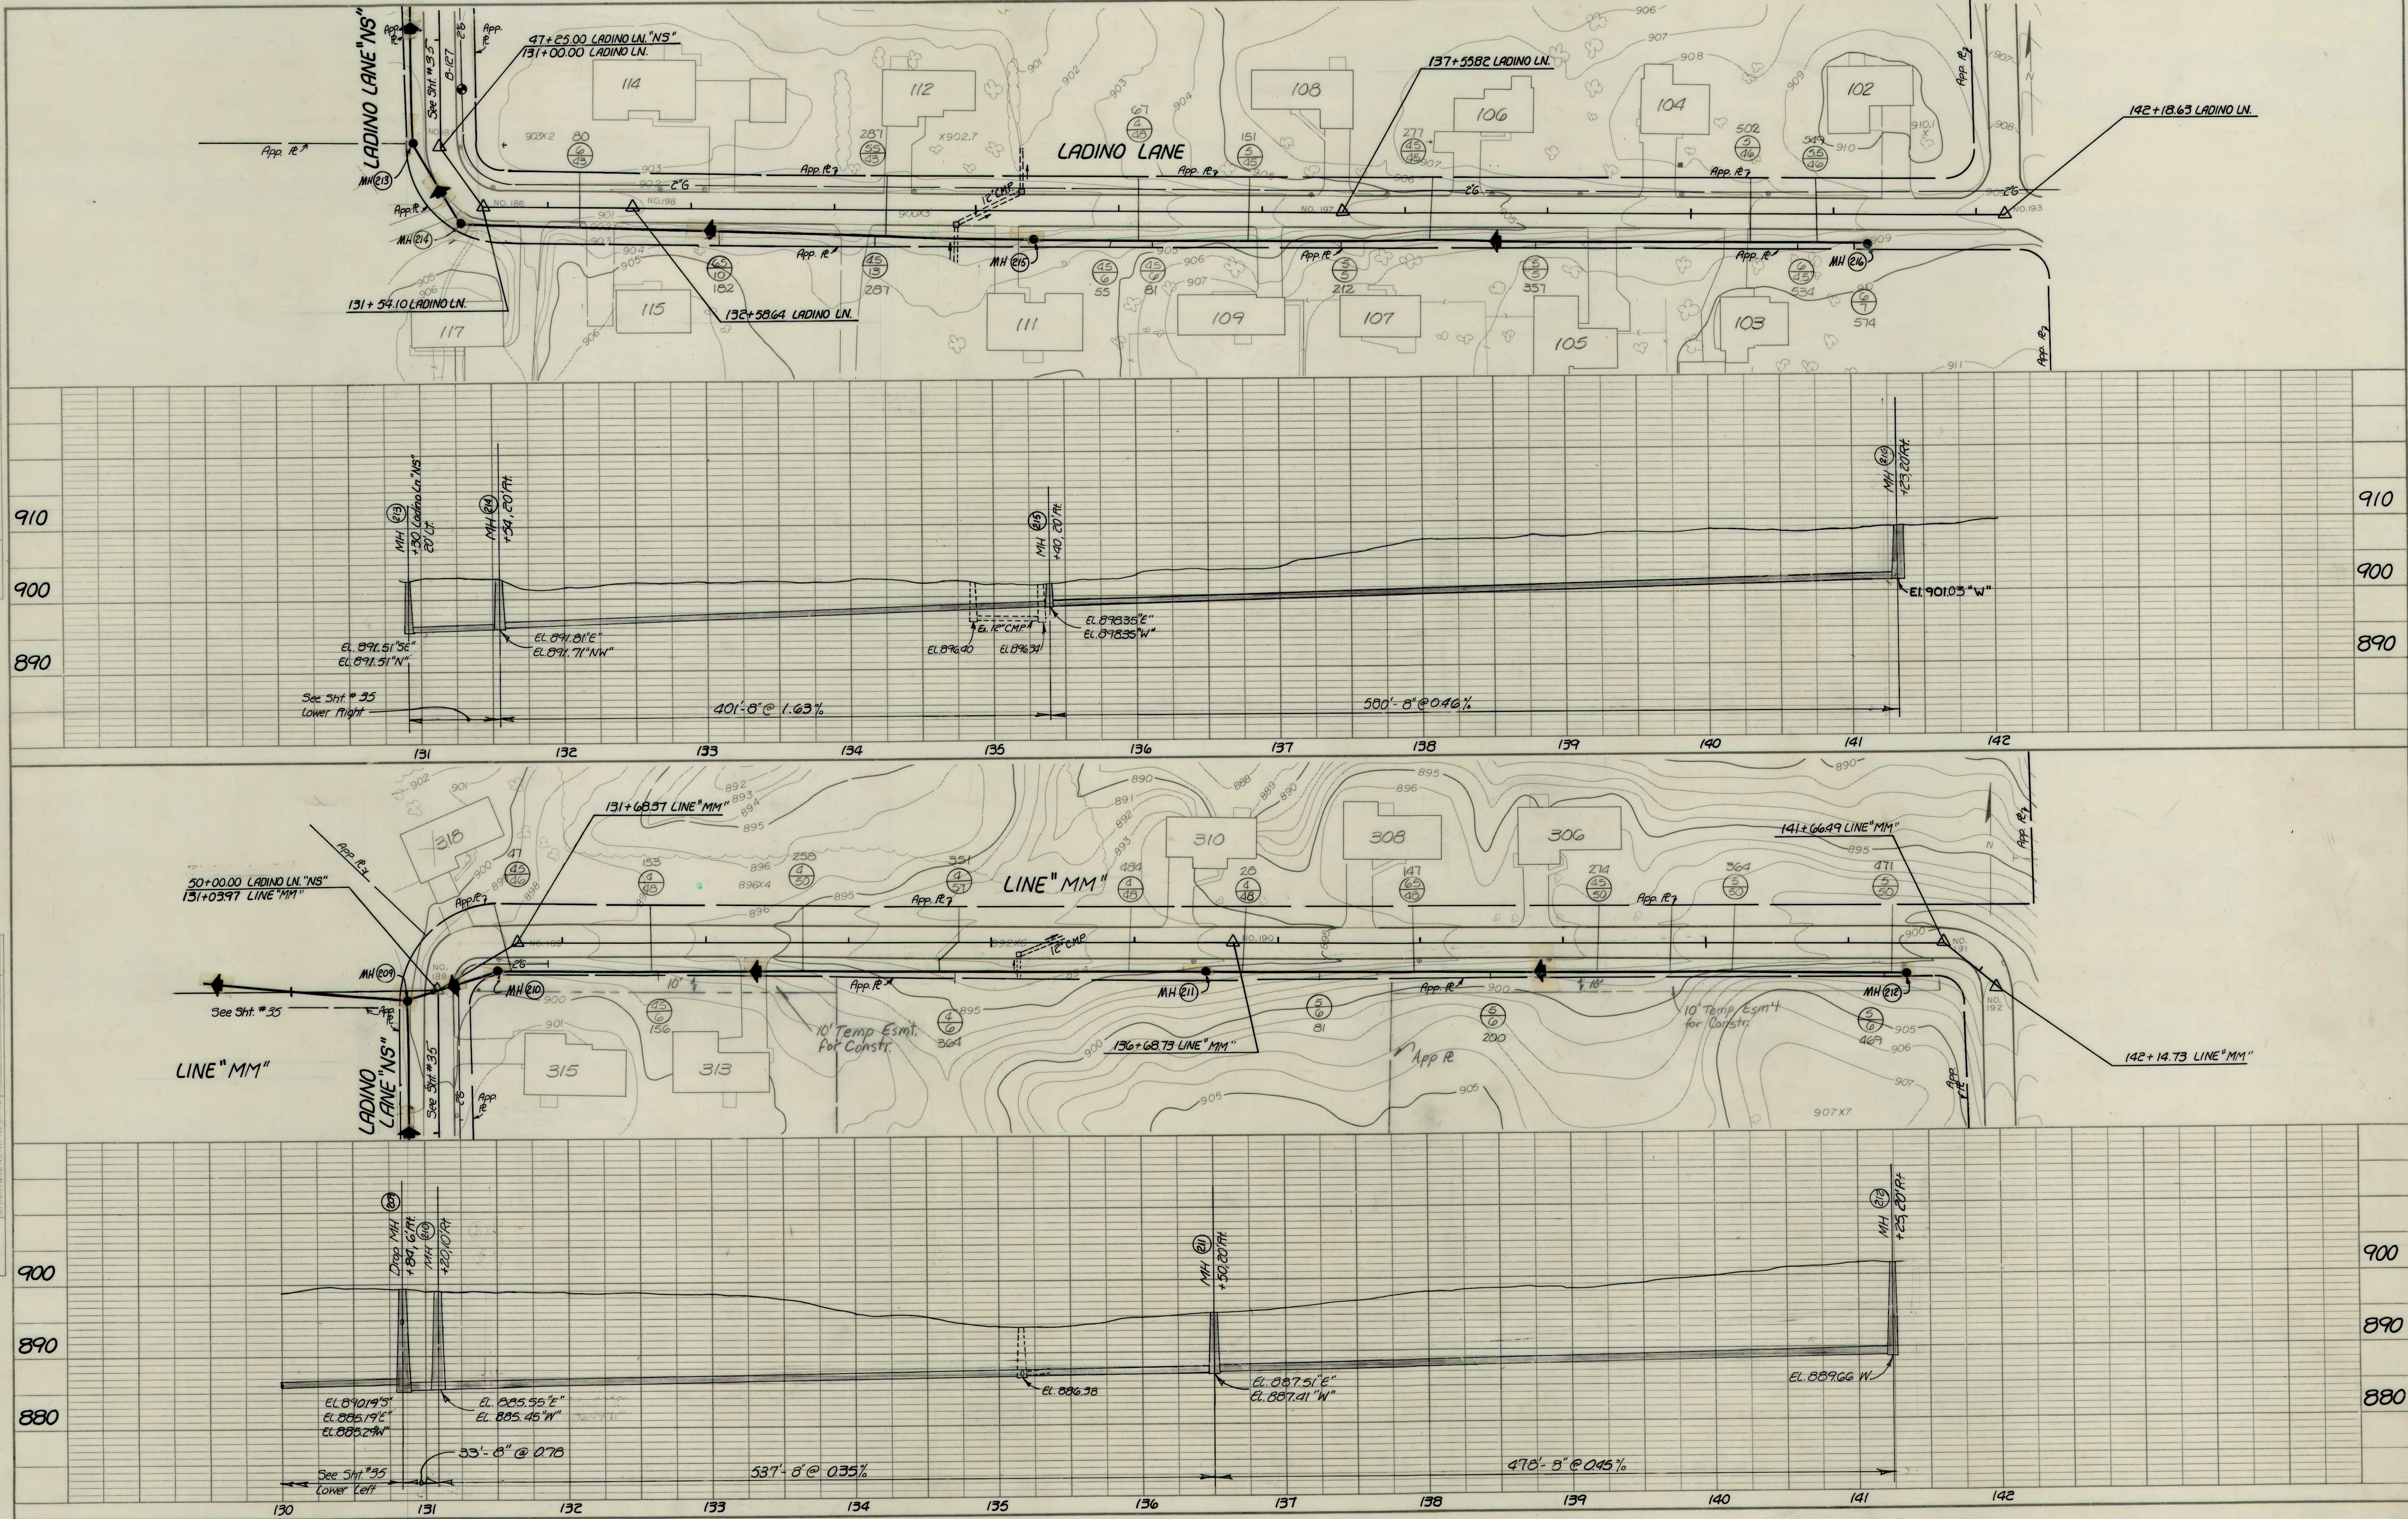

LADINO LANE/ LINE "MM"	
FALL CREEK R.W.D. PLAN & PROFILE	
HORIZ. 1"=50'	BEAM, LONGEST & NEFF, INC.
VERT. 1"=10'	CONSULTING ENGINEERS
	INDIANAPOLIS, INDIANA
	SHEET 36