

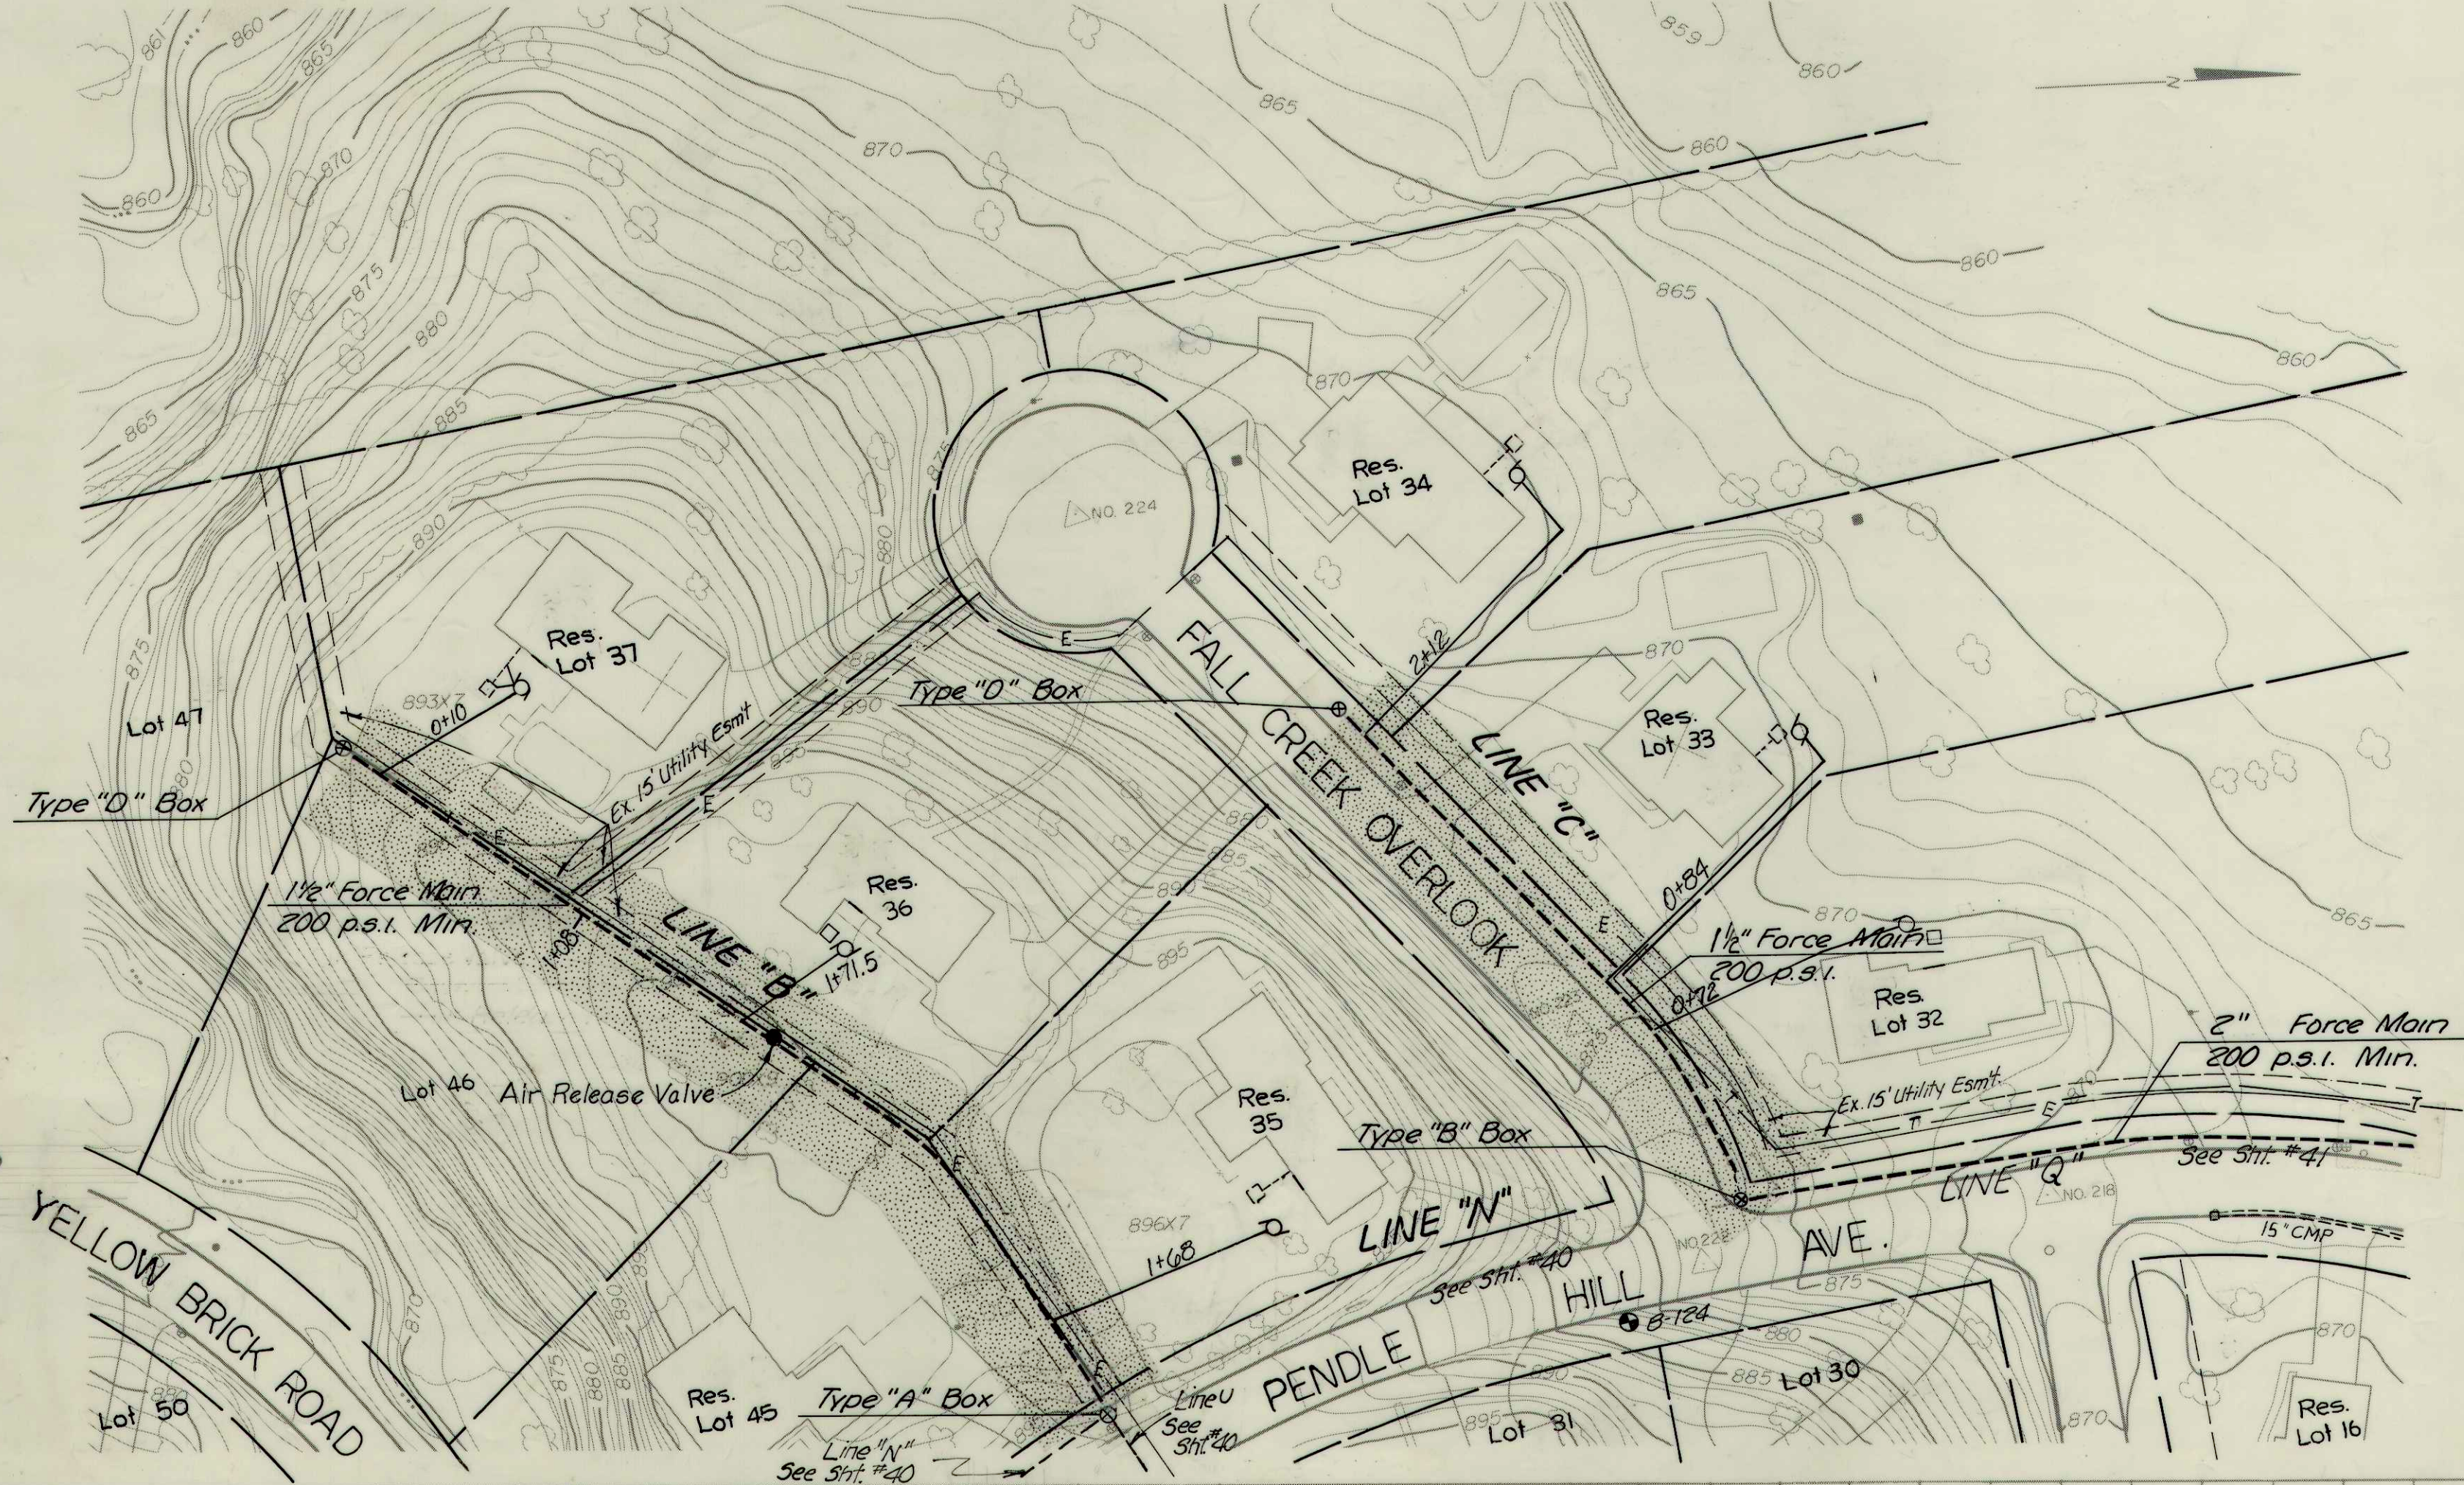
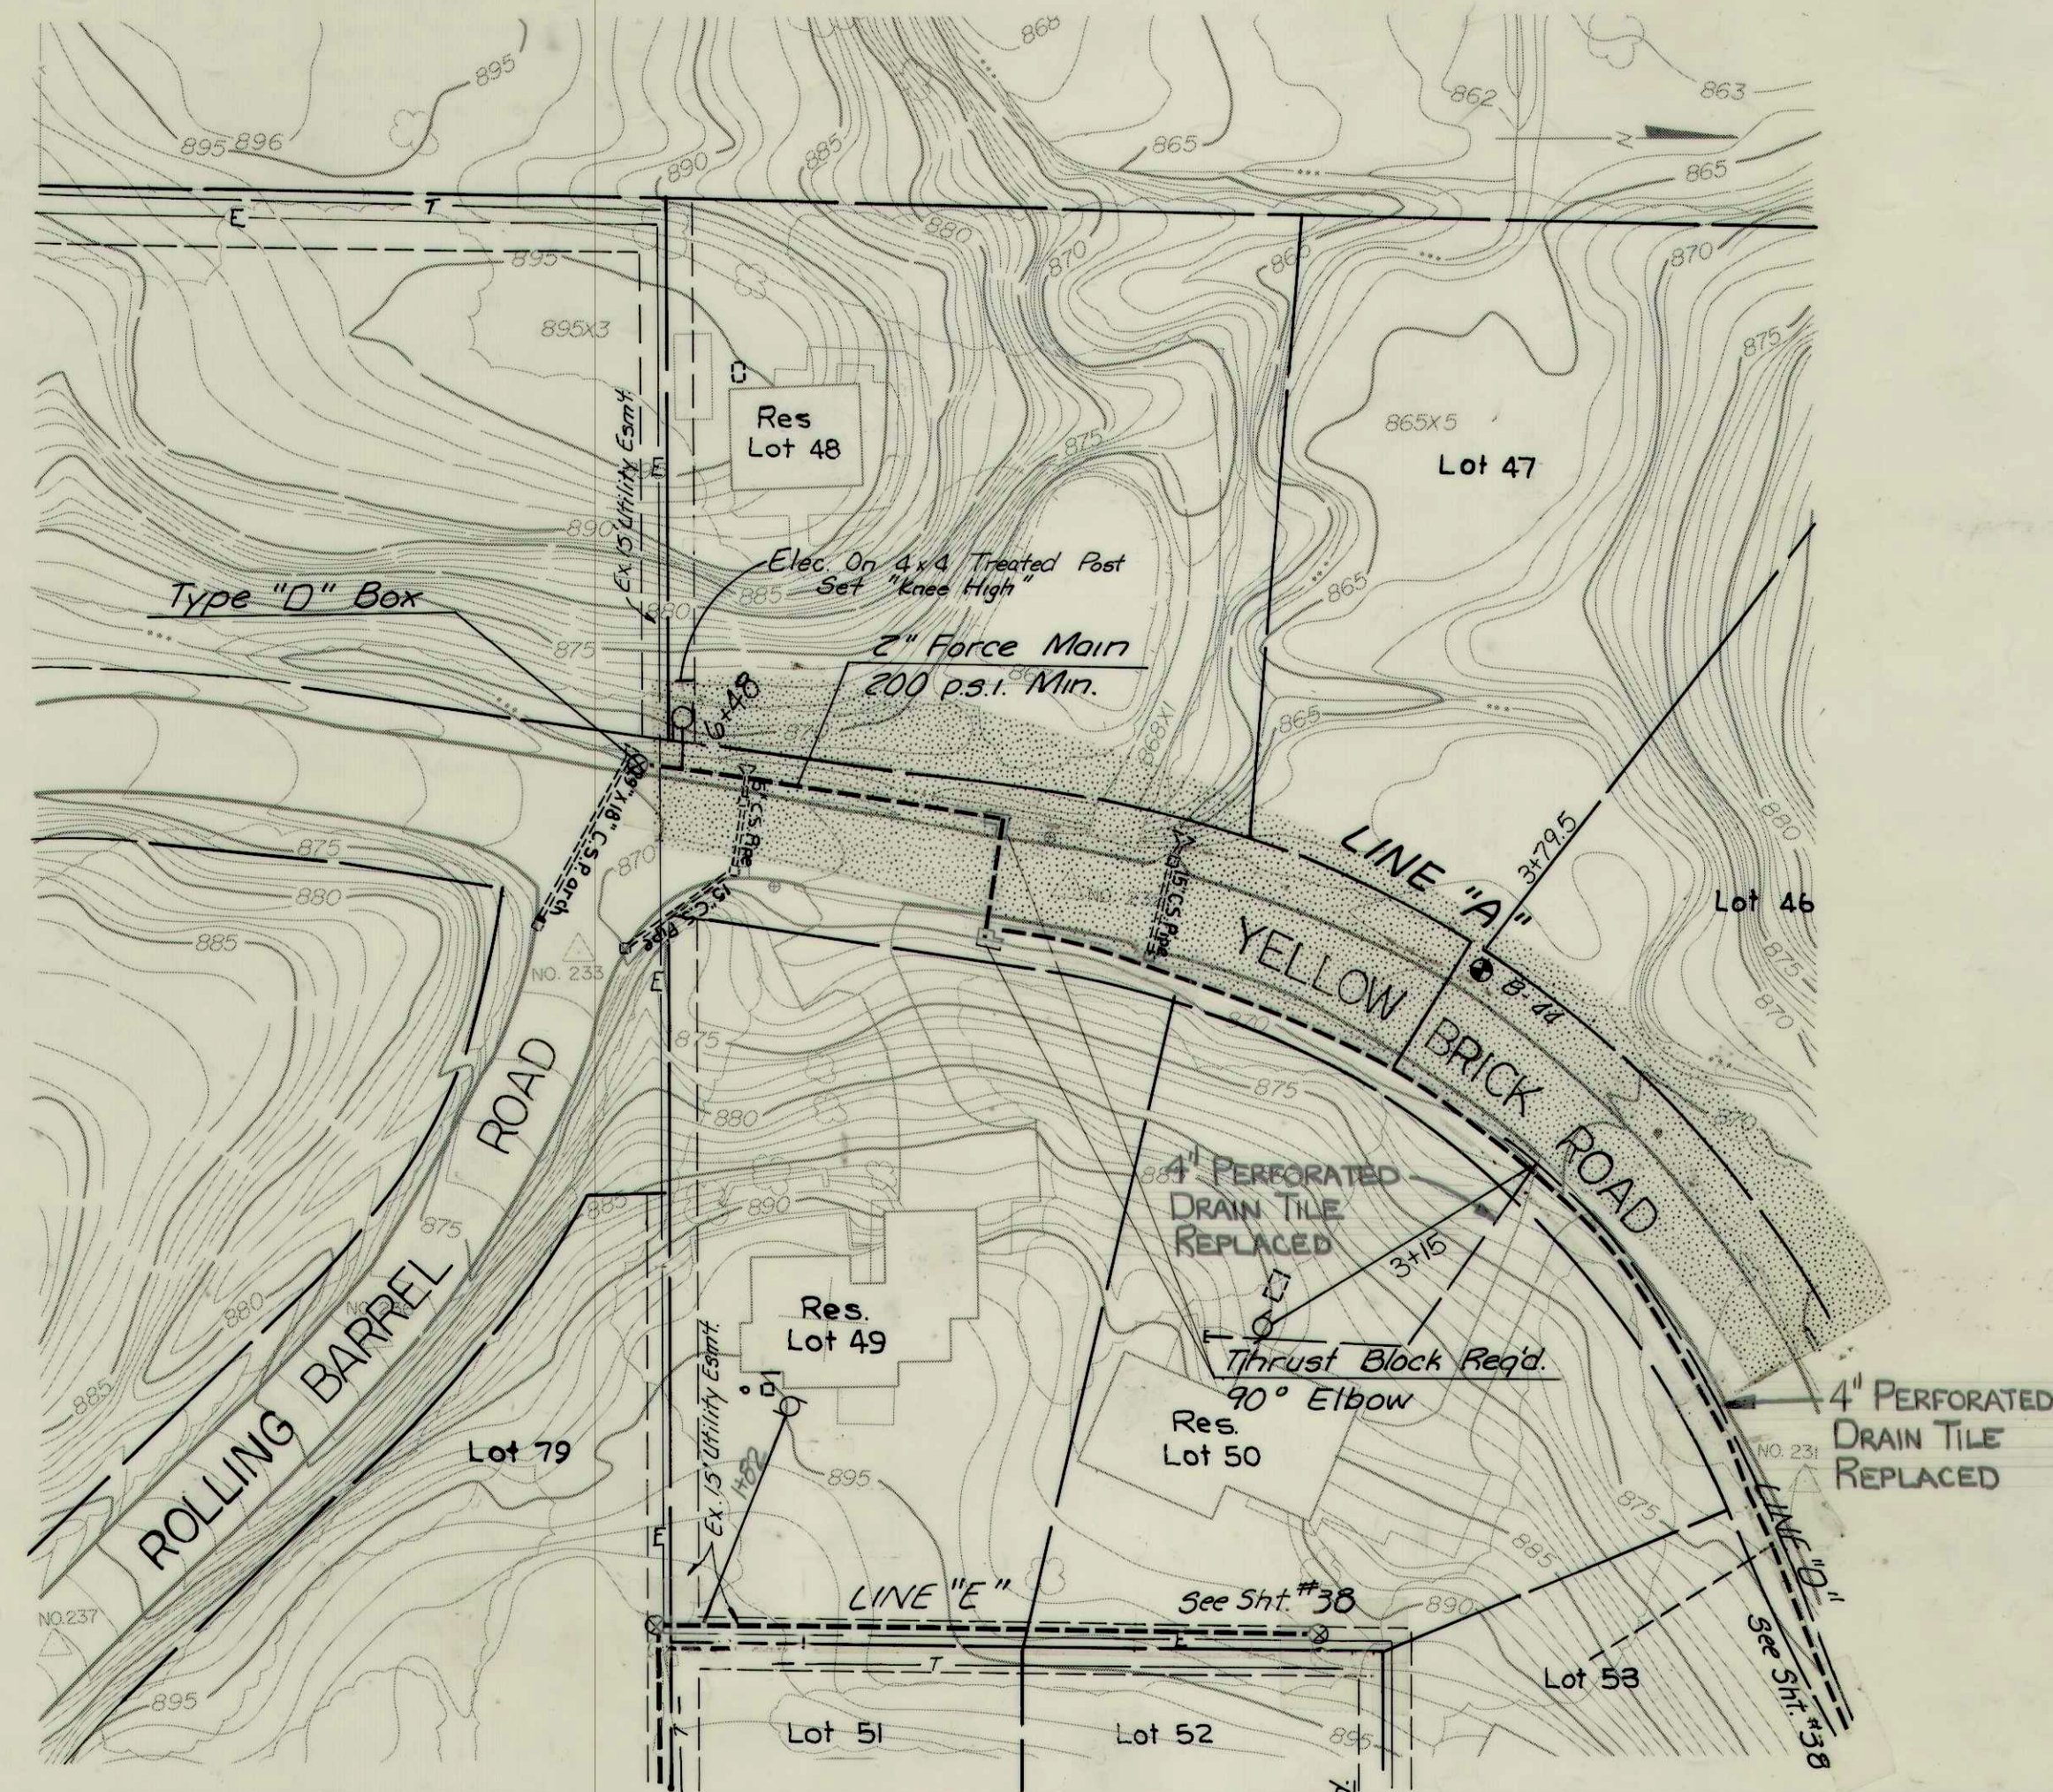
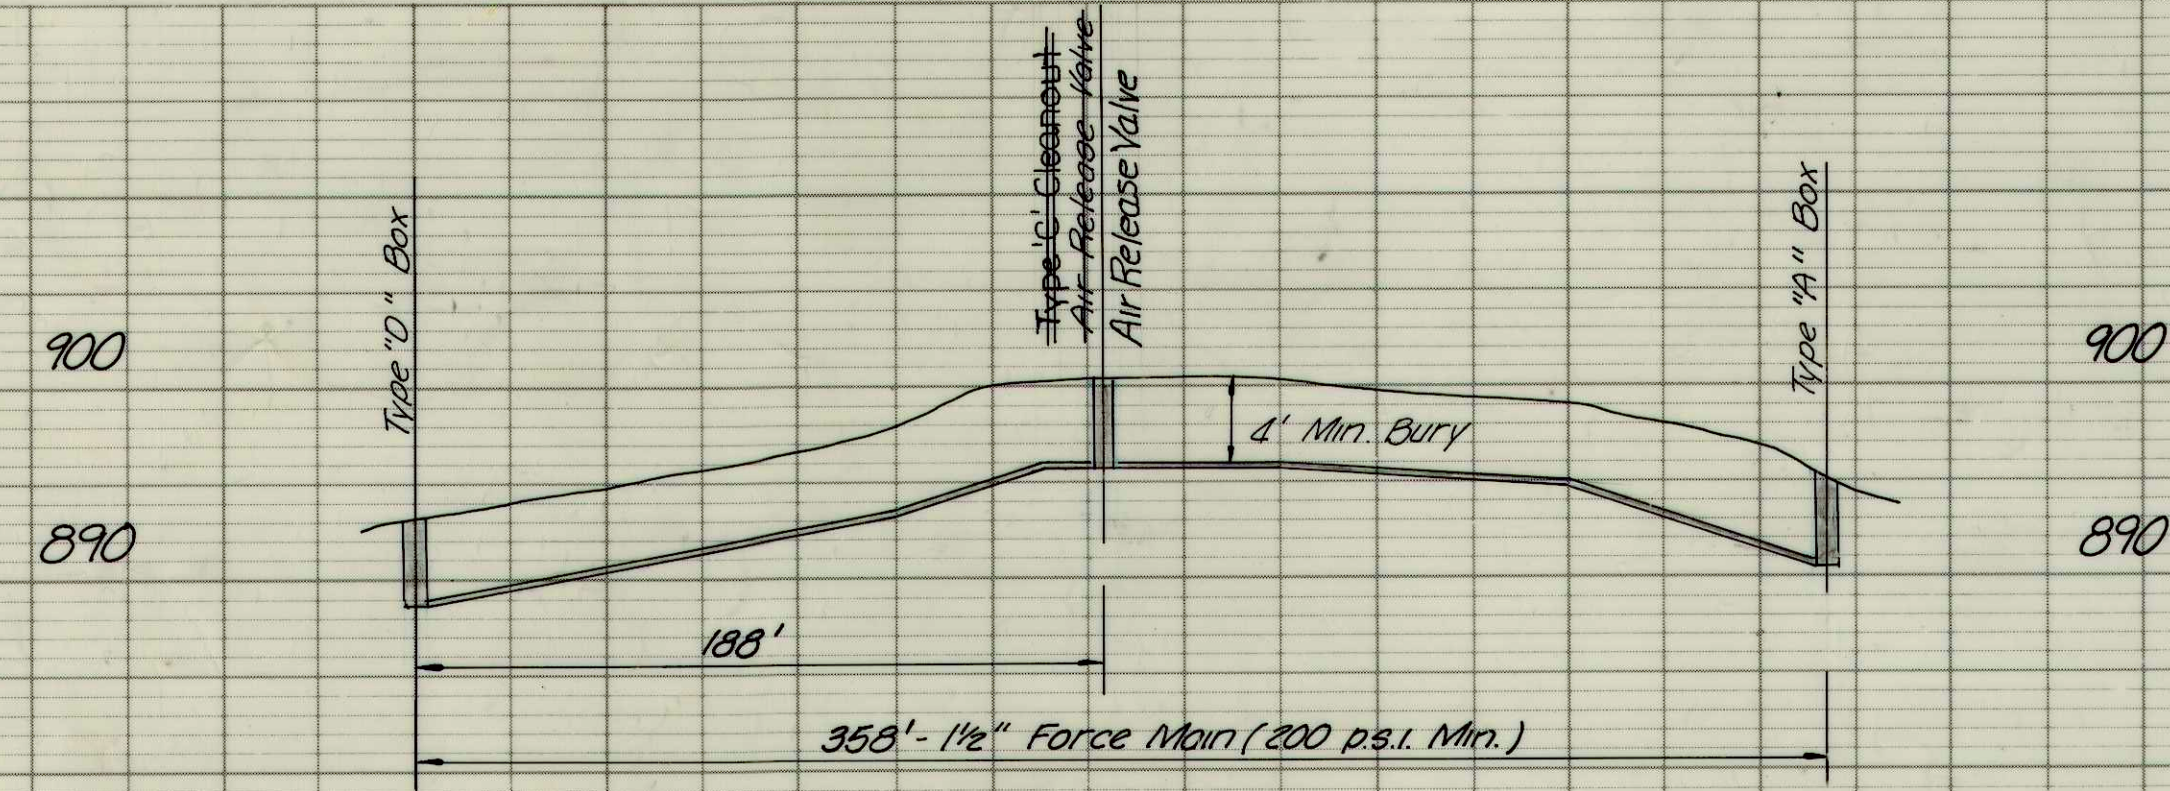


PLAN	DATE	BY
	SURVEYED	
	NOTED	
	NO. OF WAY CHECKED	

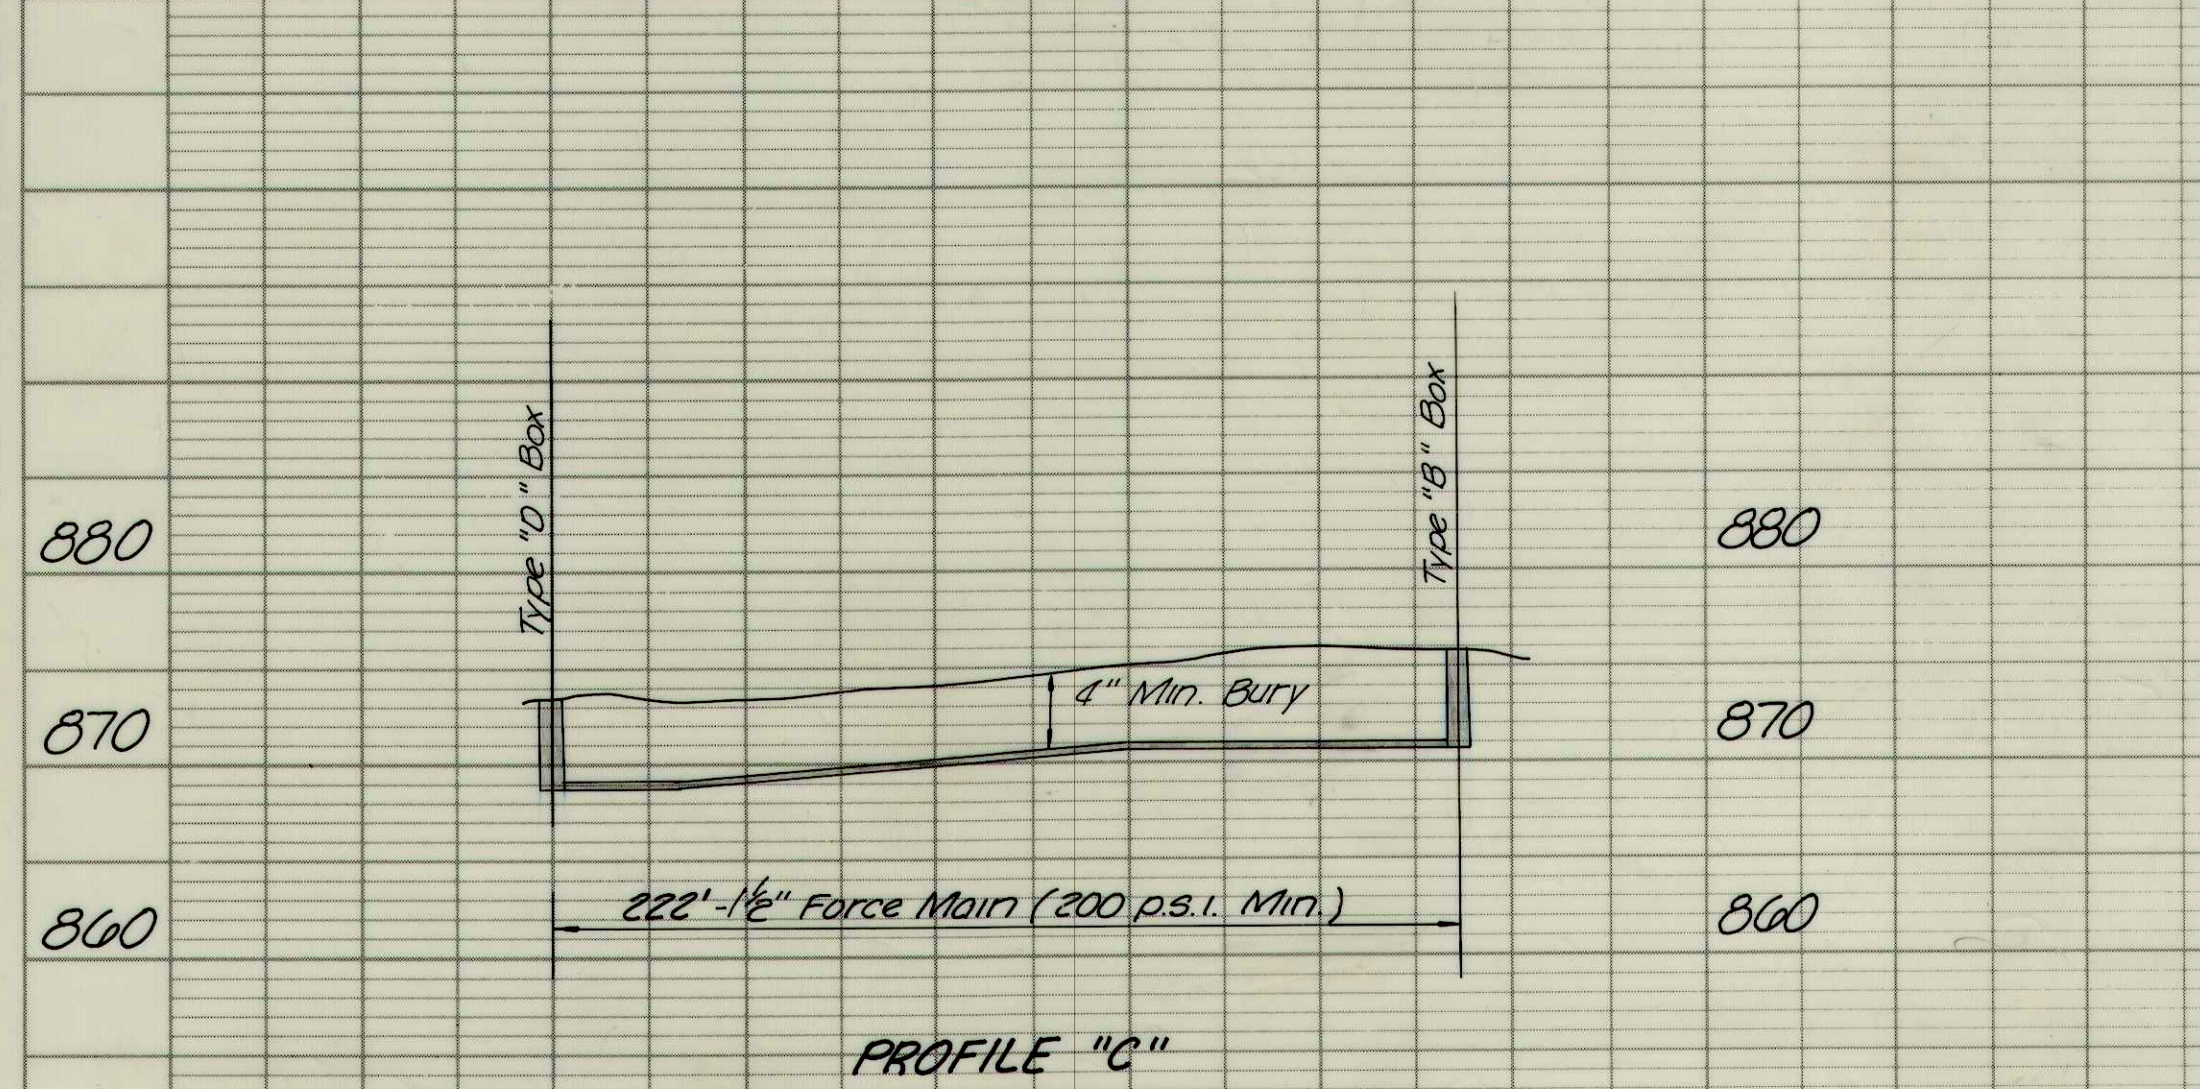

PROFILE	DATE	BY
	SURVEYED	
	NOTED	
	NO. OF WAY CHECKED	

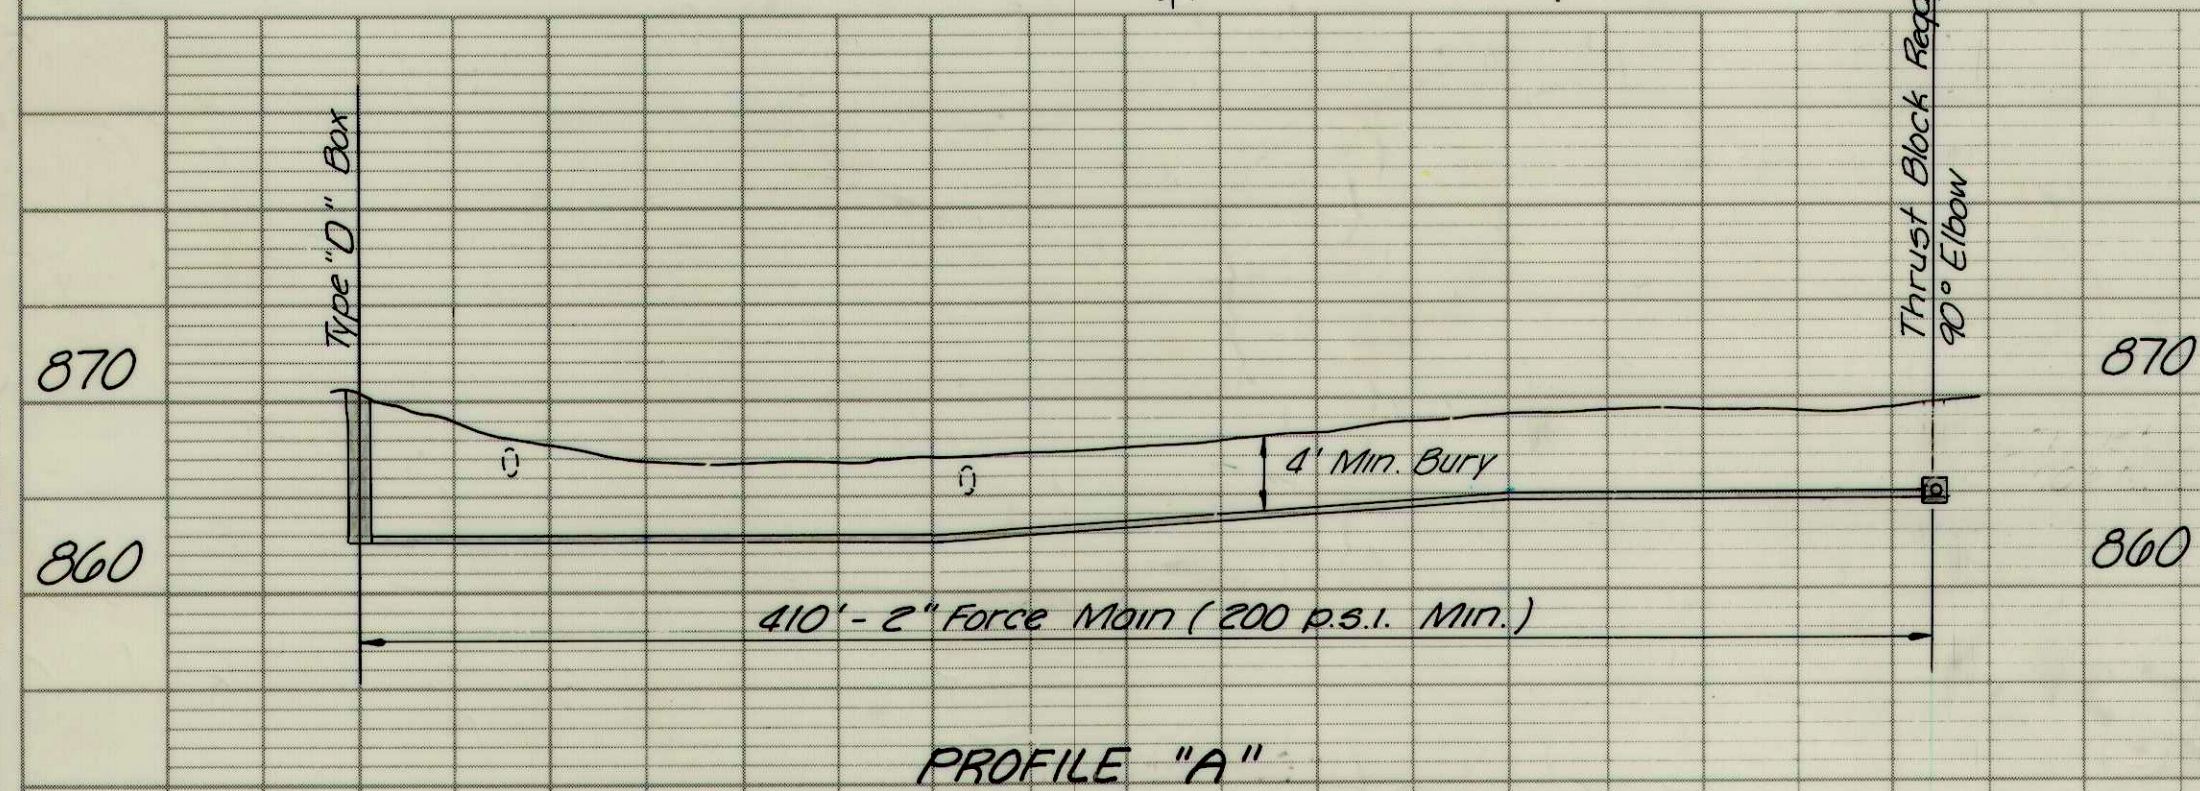

Rev. 4-9-84
Move 2" Force Main (Line A)
across the Street.
Rev. 9-5-85
Air Release Valve on Line "B"

Note: All Vacant lots Have Shut-off
Valve Installed, & Tag

RECORD DRAWING



**YELLOW BRICK RD - ROLLING BARREL RD
FALL CREEK OVERLOOK - PENDLE HILL AVE.**
FALL CREEK R.W.D. PLAN & PROFILE SHEET
HORIZ. 1"=50'
VERT. 1"=10'
BEAM, LONGEST & NEFF, INC.
CONSULTING ENGINEERS
INDIANAPOLIS, INDIANA