
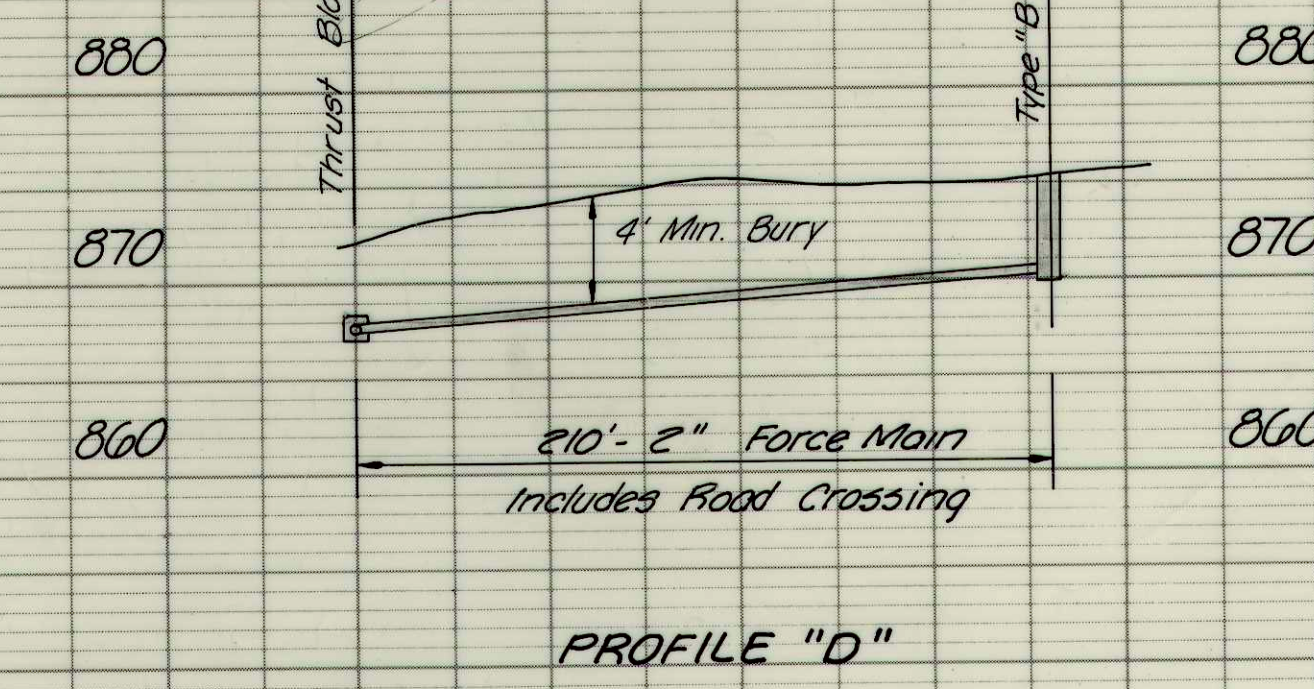
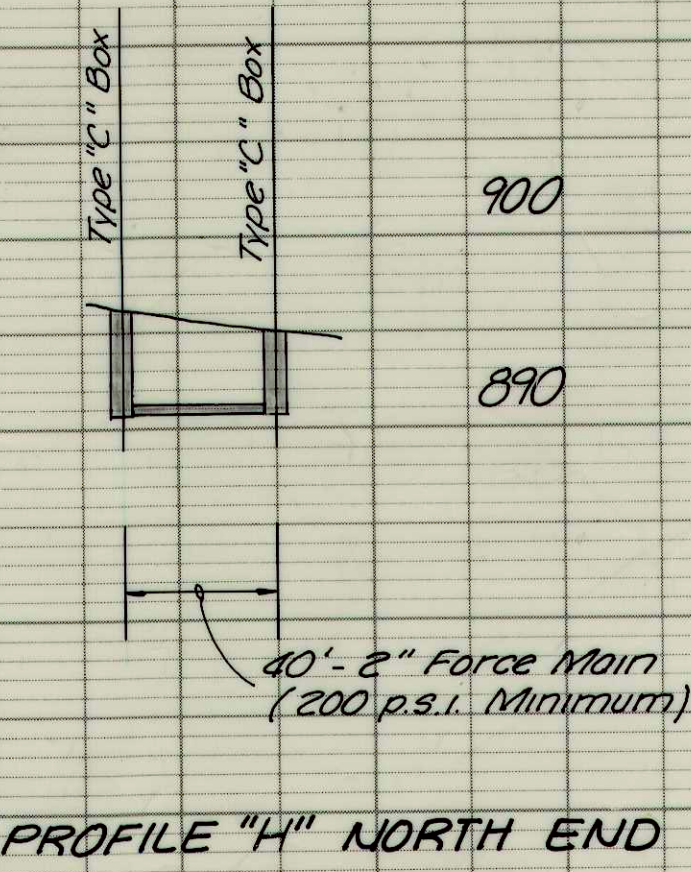
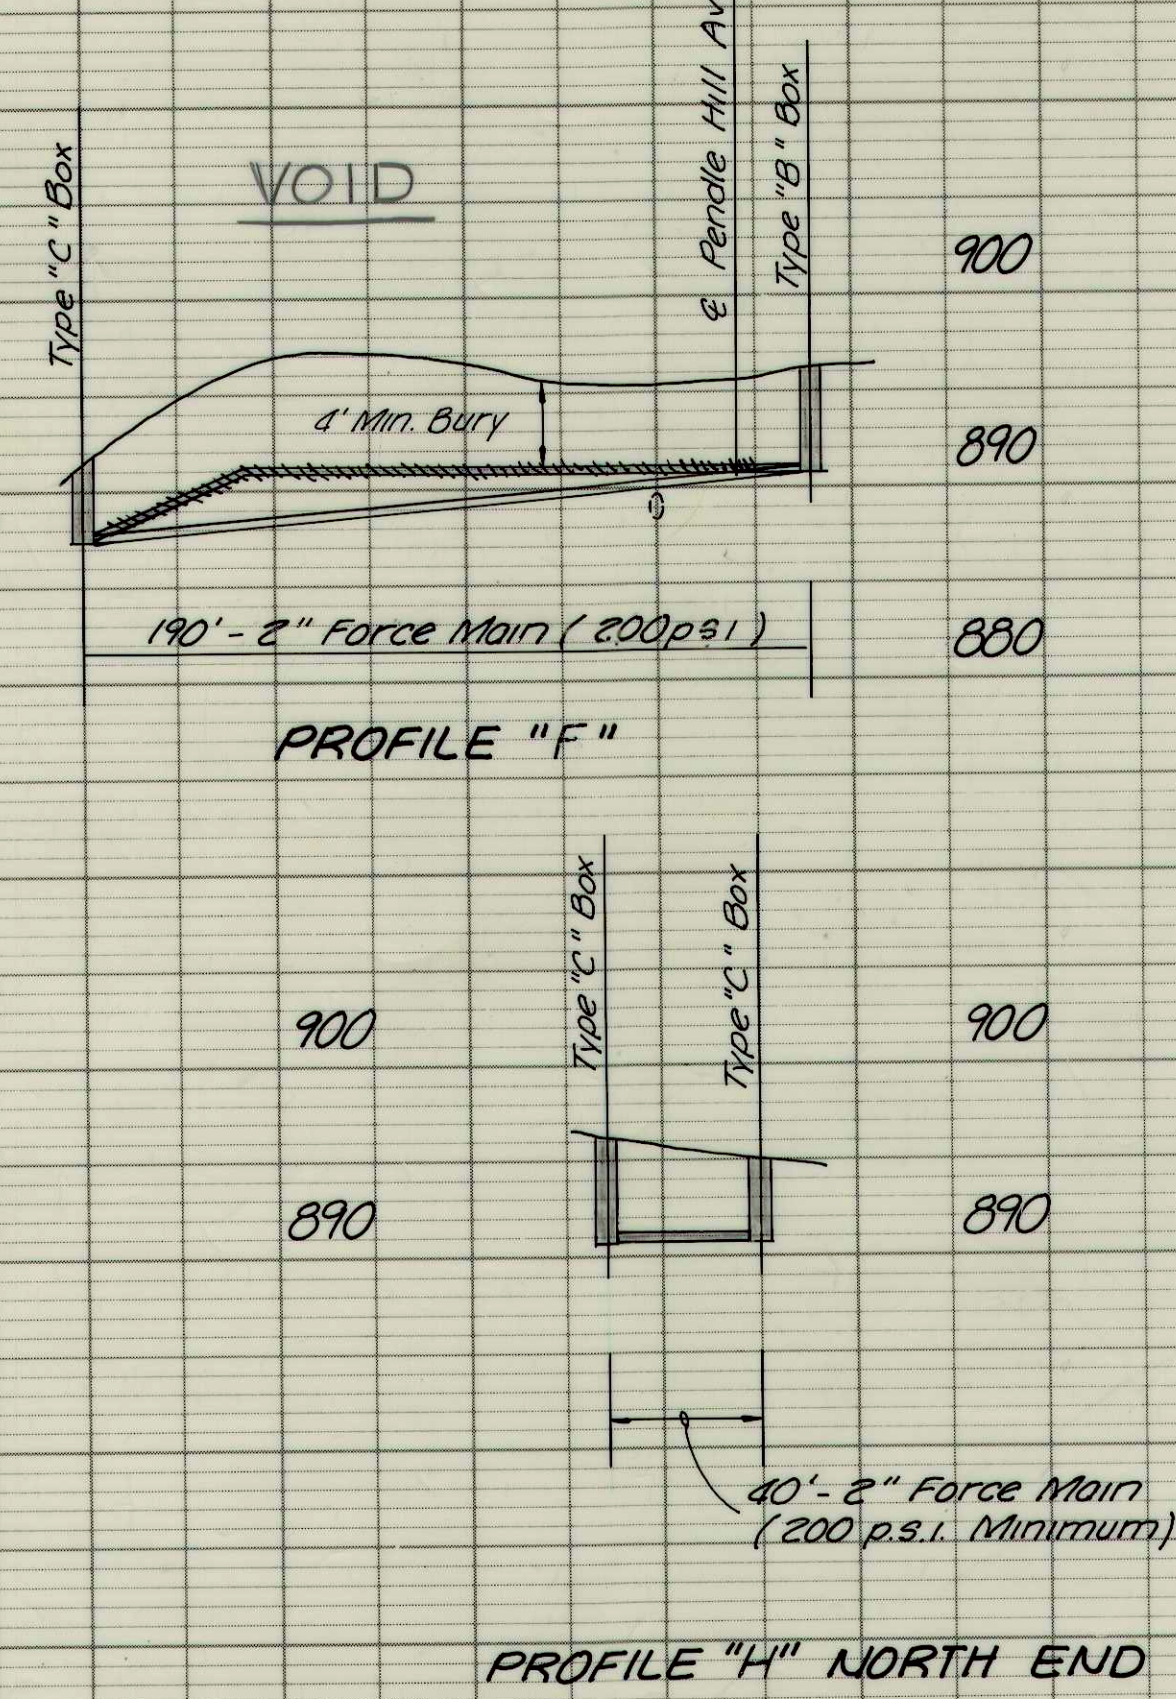
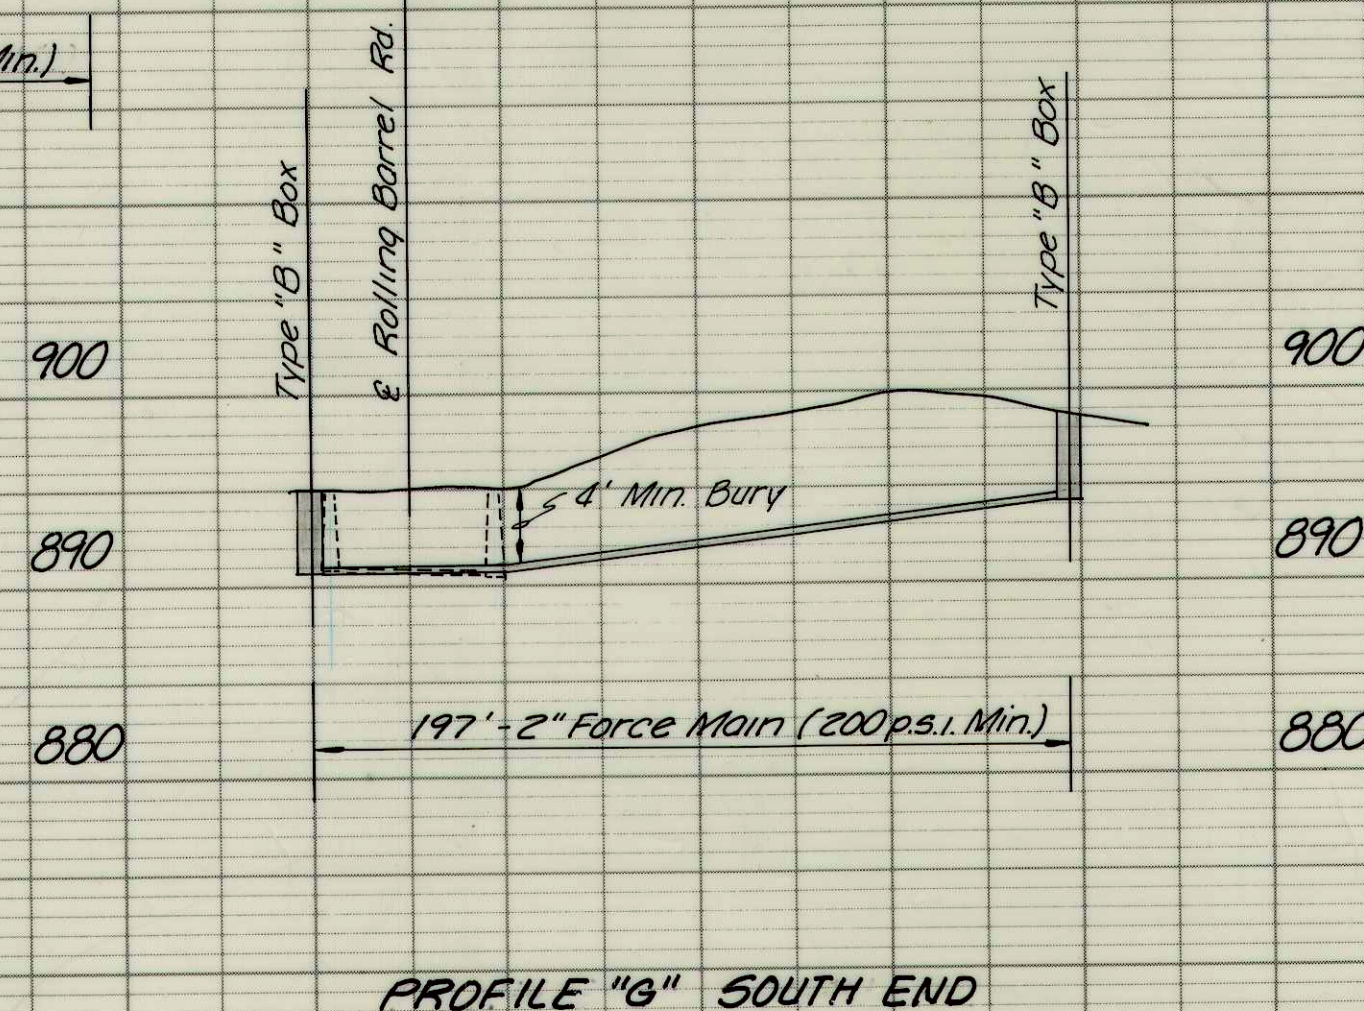
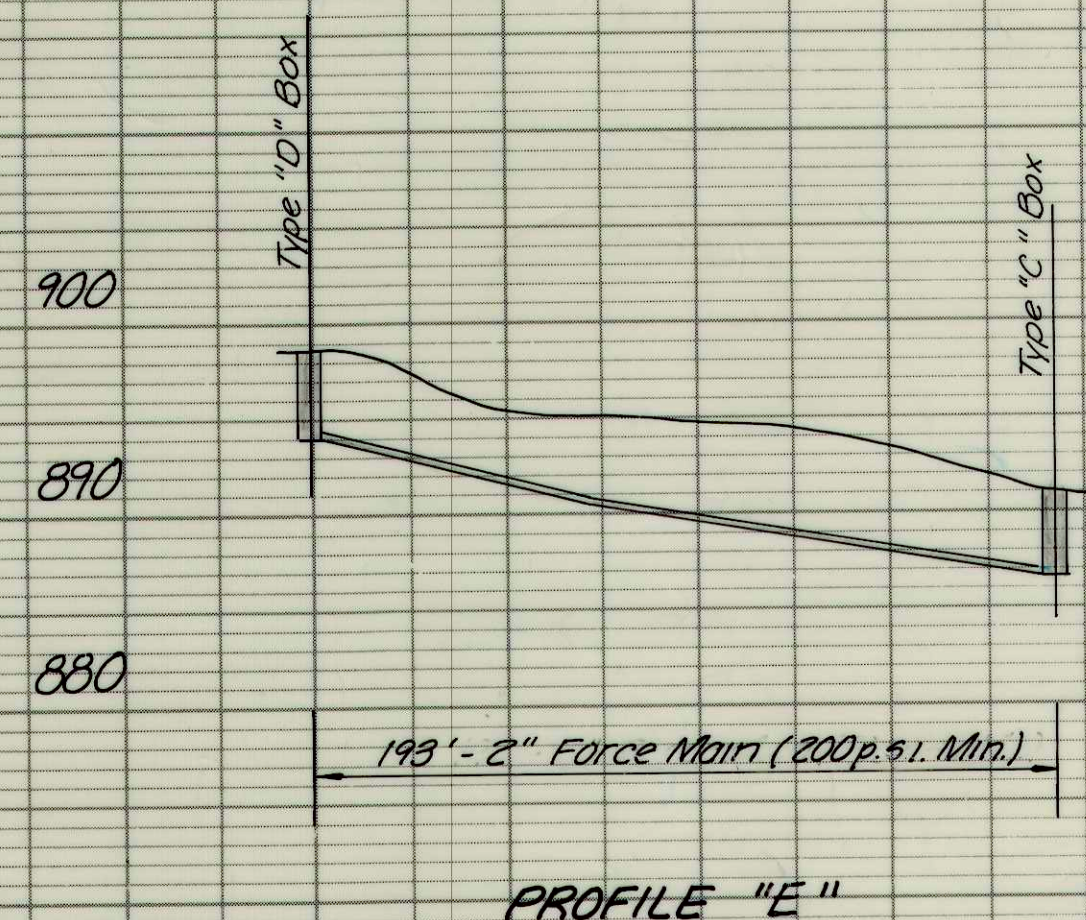


PLAN	DATE	BY
	SURVEYED	
	NOTED	
	NOTE BOOK	

PROFILE	DATE	BY
	SURVEYED	
	NOTED	
	NOTE BOOK	

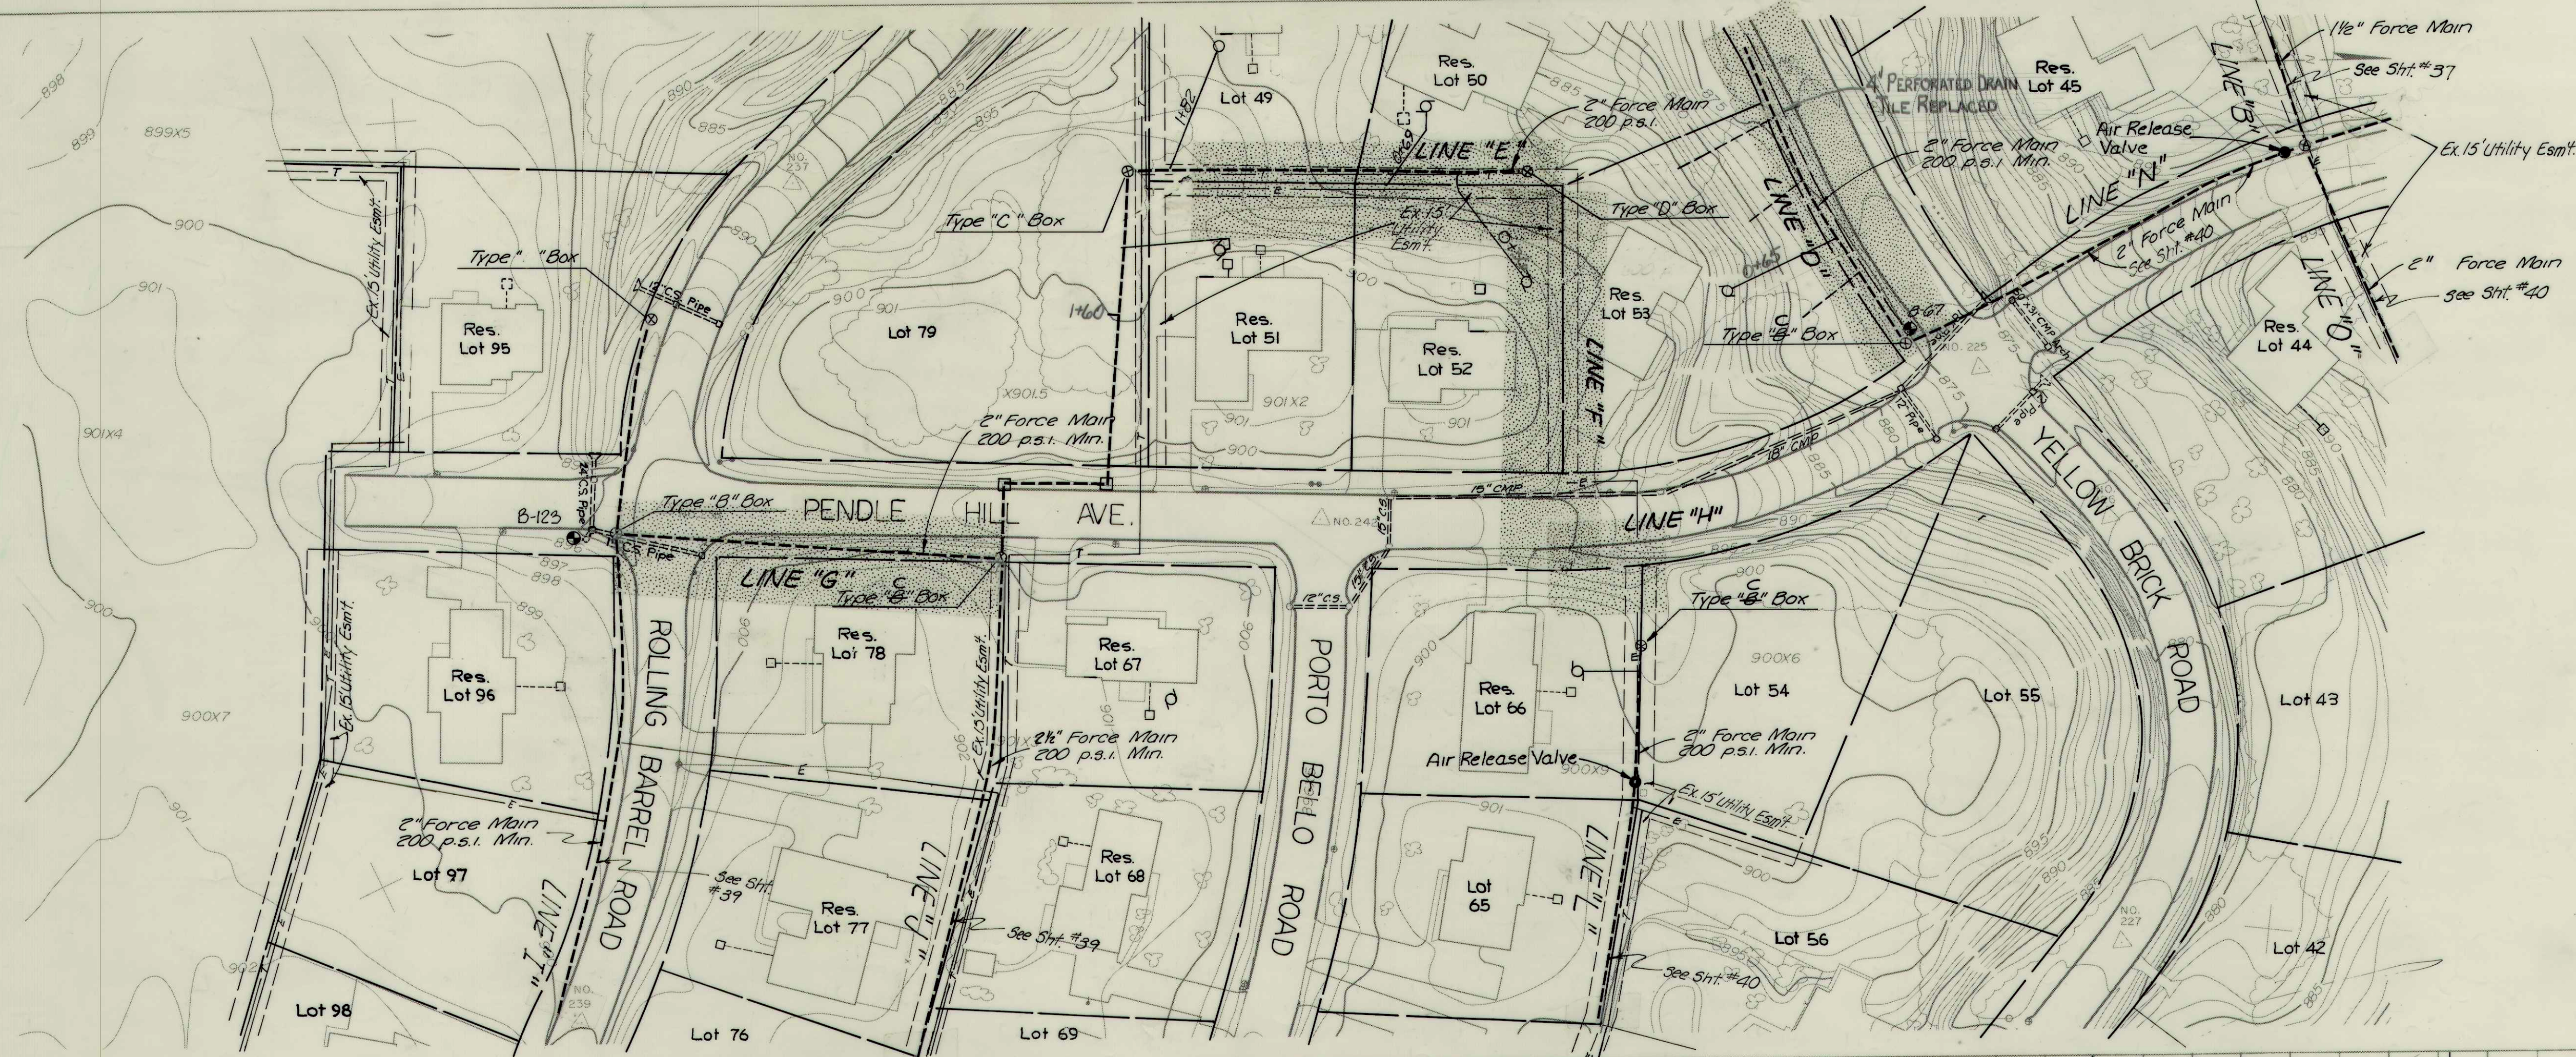

Rev. 9-5-85
Air Release Valve Line "N"
3 Line "L"

Note: All Vacant Lots Have Shut-off Valve Installed @ Top

RECORD DRAWING



PENDLE HILL AVE - ROLLING BARREL RD.
YELLOW BRICK RD - PORTE BELLO RD.
FALL CREEK R.W.D. PLAN & PROFILE SHEET
HORIZ. 1"=50'
VERT. 1"=10'
BEAM, LONGEST & NEFF, INC.
CONSULTING ENGINEERS
INDIANAPOLIS, INDIANA
38