
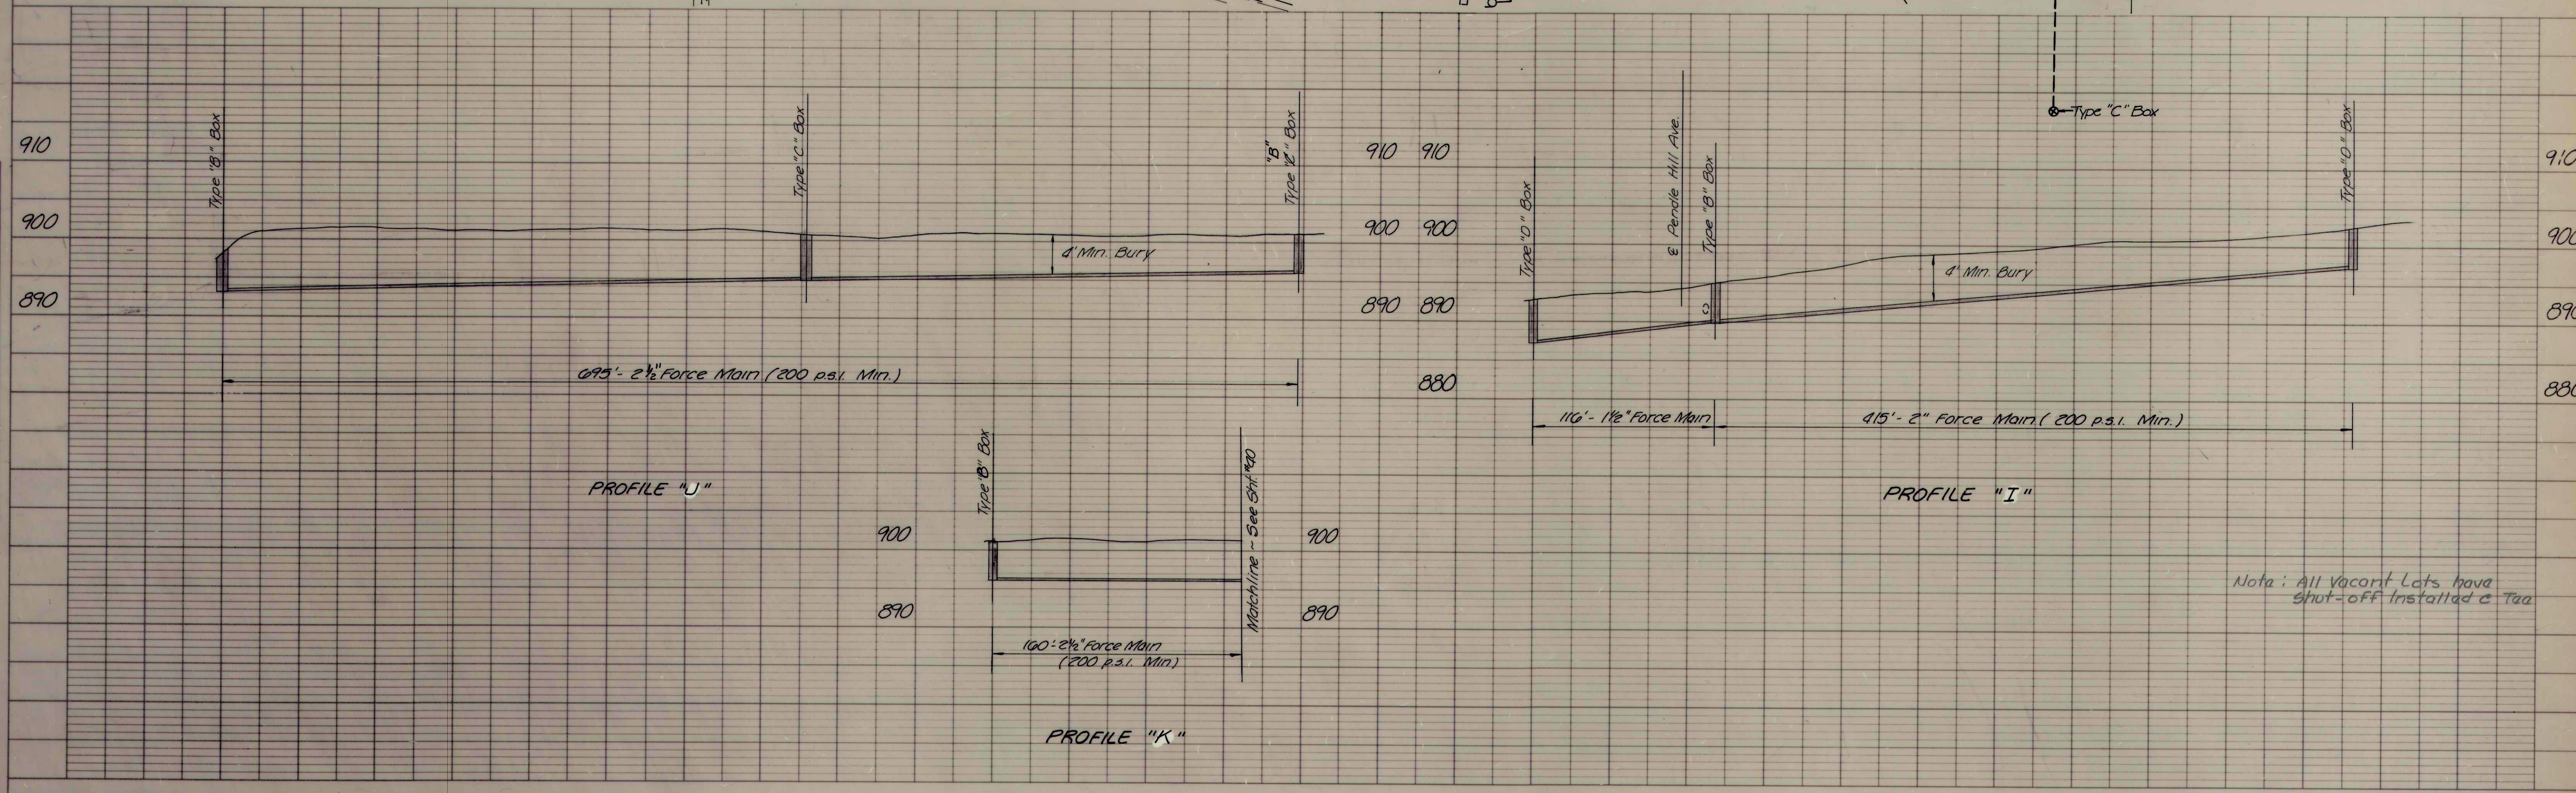


PLAN	DATE	
	BY	
	SURVEYED	
	NOTED	

PROFILE	DATE	
	BY	
	SURVEYED	
	NOTED	

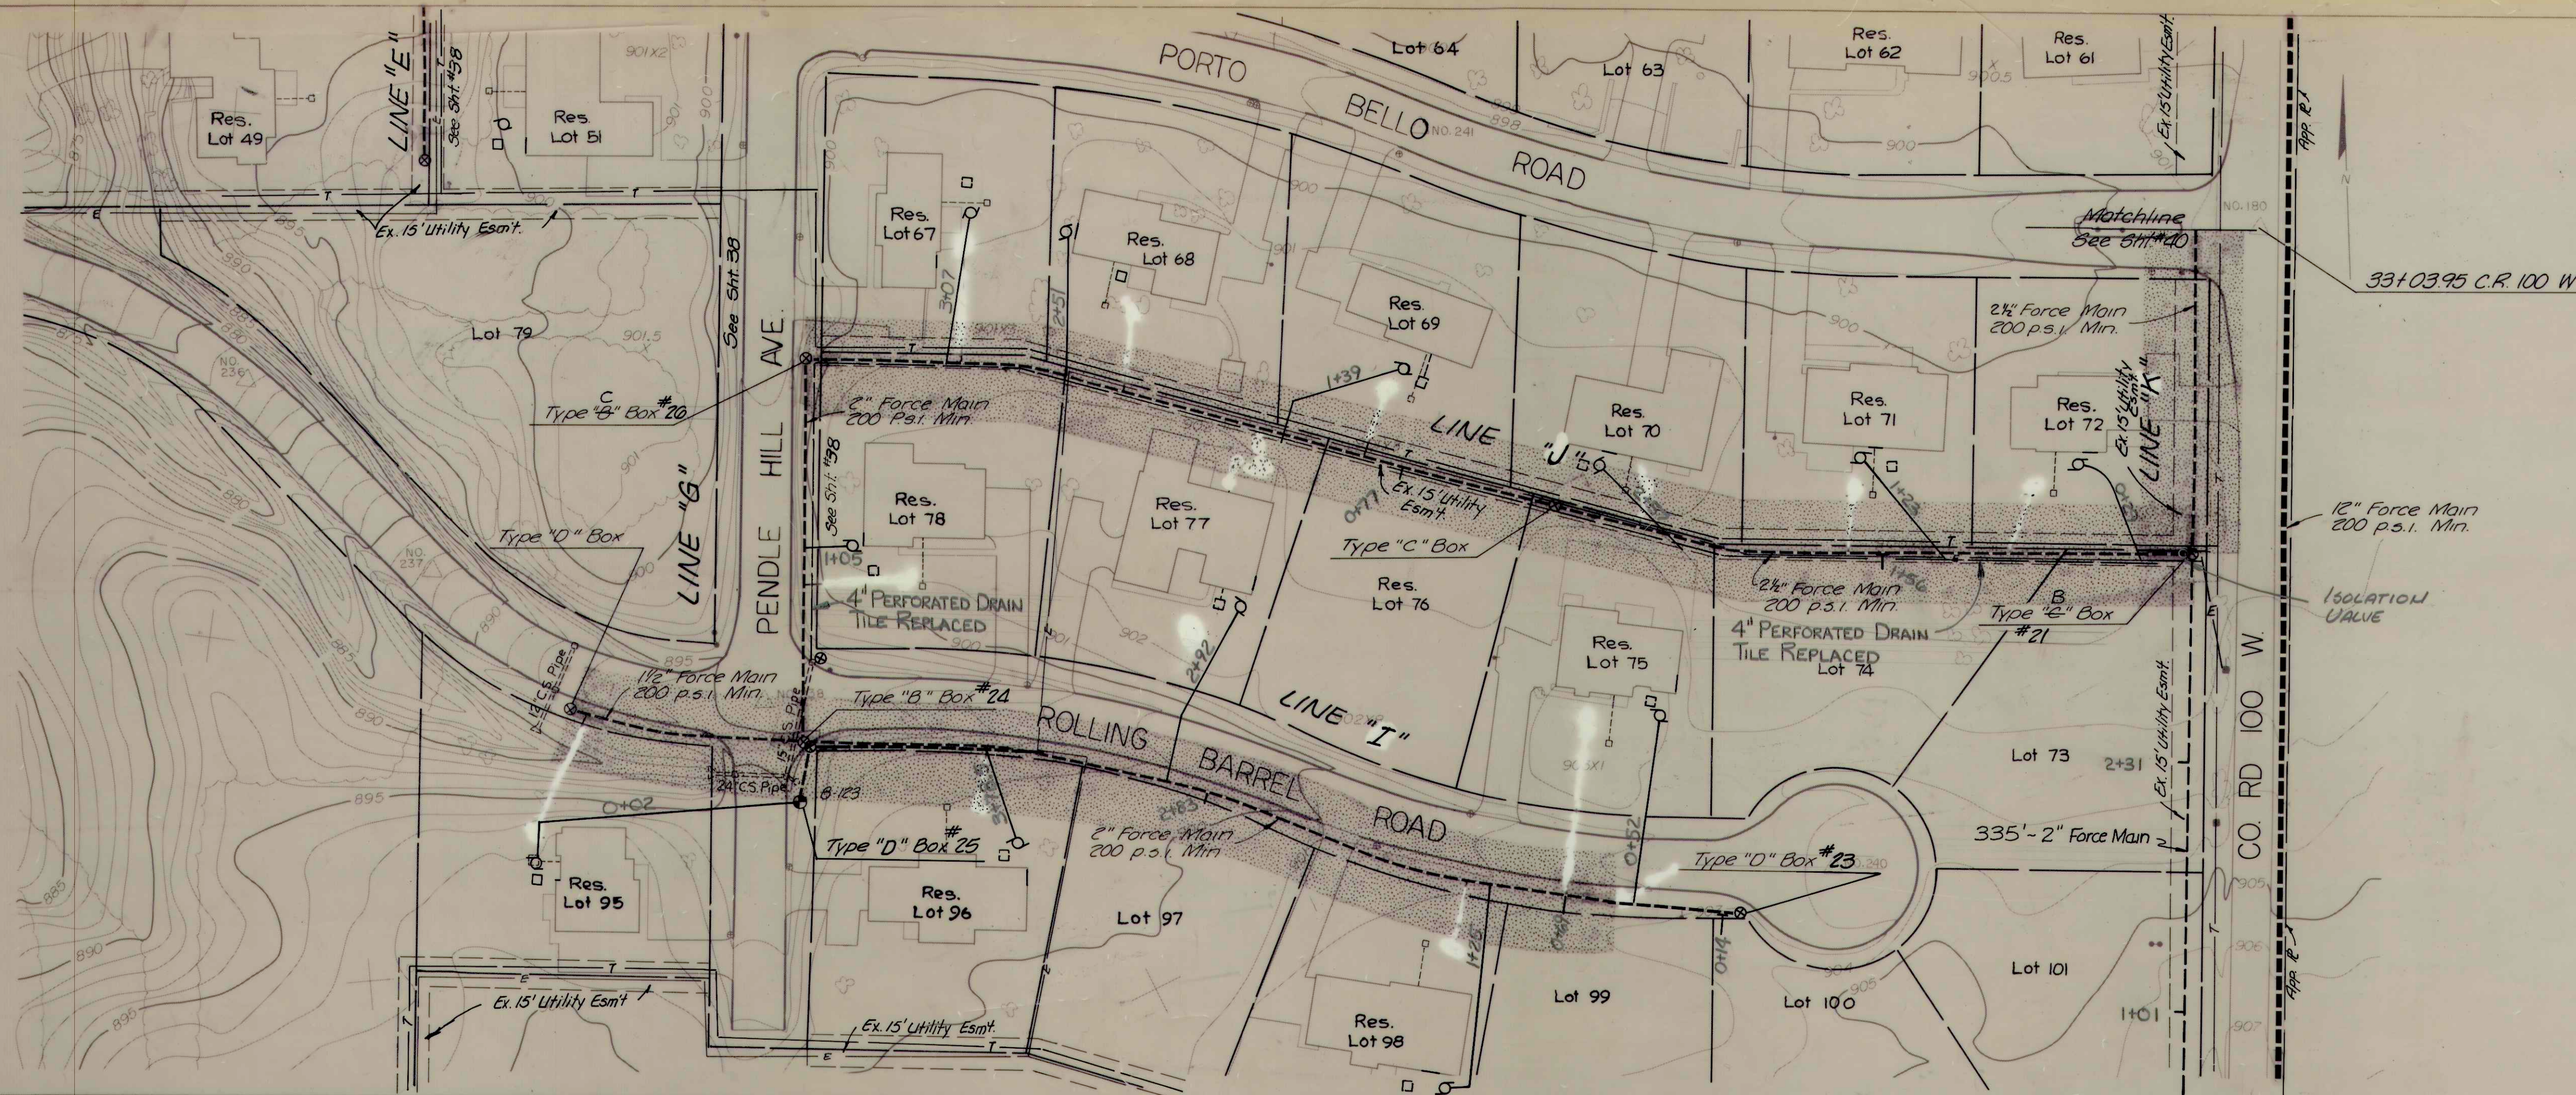

Note: All Vacant Lots have shut-off installed & Tag

RECORD DRAWING



PORTO-BELLO RD - ROLLING BARREL RD
PENDLE HILL AVE.
FALL CREEK R.W.D. PLAN & PROFILE SHEET
HORIZ. 1"=50'
VERT. 1"=10'
BEAM, LONGEST & NEFF, INC.
CONSULTING ENGINEERS
INDIANAPOLIS, INDIANA
39