



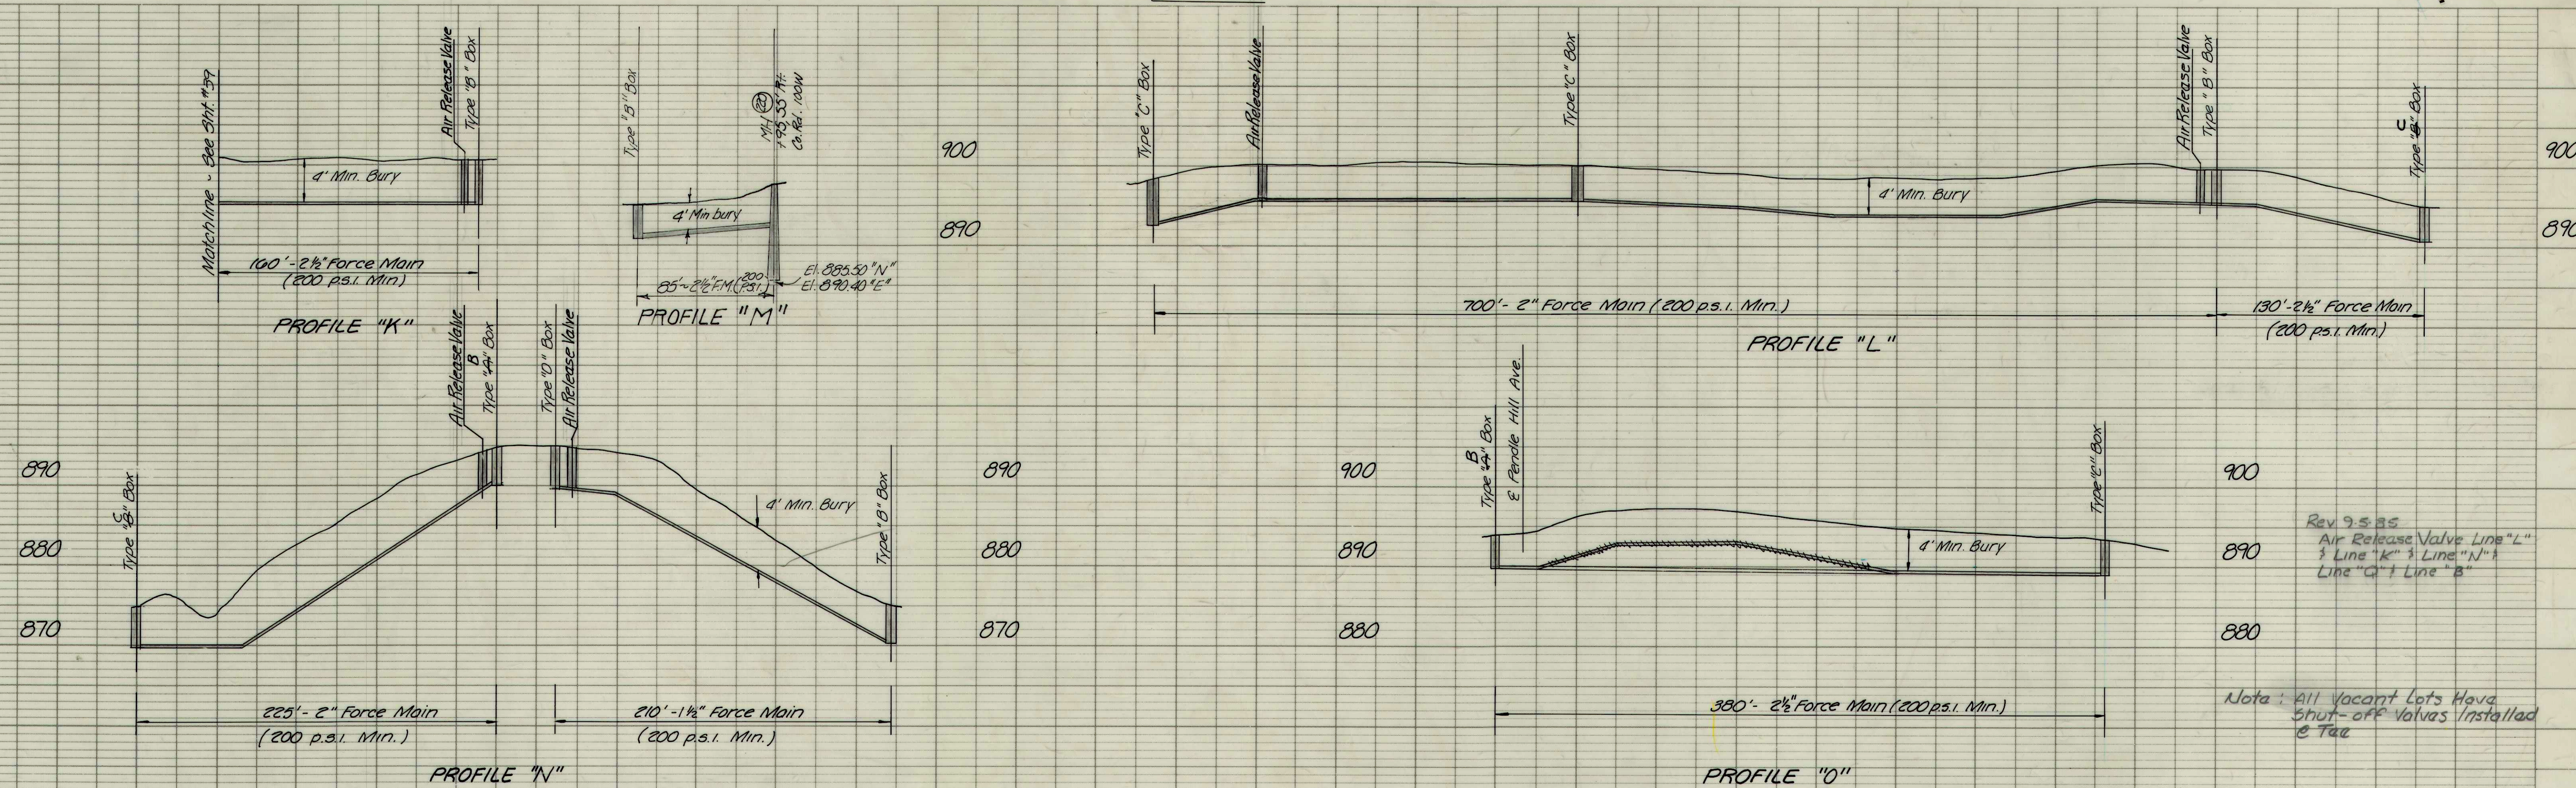

Rev 9-5-85
Air Release Valve Line "L"
1/2 Line "K" 1/2 Line "N"
Line "G" + Line "B"

All Vacant Lots Have
Shut-off Valves Installed
@ Tag

RECORD DRAWING

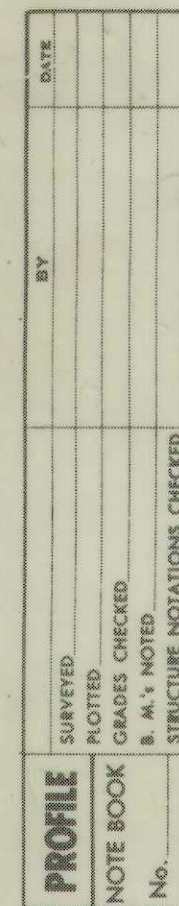

<i>FALL CREEK OVERLOOK~ PENDLE HILL AVE YELLOW BRICK RD. ~ PORTO BELLO RD.</i>		<i>SHEET</i>
<i>FALL CREEK R.W.D. PLAN & PROFILE</i>		
HORIZ. 1"=50'	BEAM, LONGEST & NEFF, INC. CONSULTING ENGINEERS	<i>40</i>
VERT. 1"=10'	INDIANAPOLIS, INDIANA	