


PLAN	SURVEYED	DATE
	NOTED	BY
	NOTE BOOK	ALIGNED CHECKED
	No.	RE. OF WAY CHECKED

PROFILE	SURVEYED	DATE
	NOTED	BY
	NOTE BOOK	GRADES CHECKED
	No.	STRUCTURE LOCATIONS CHECKED



RECORD DRAWING

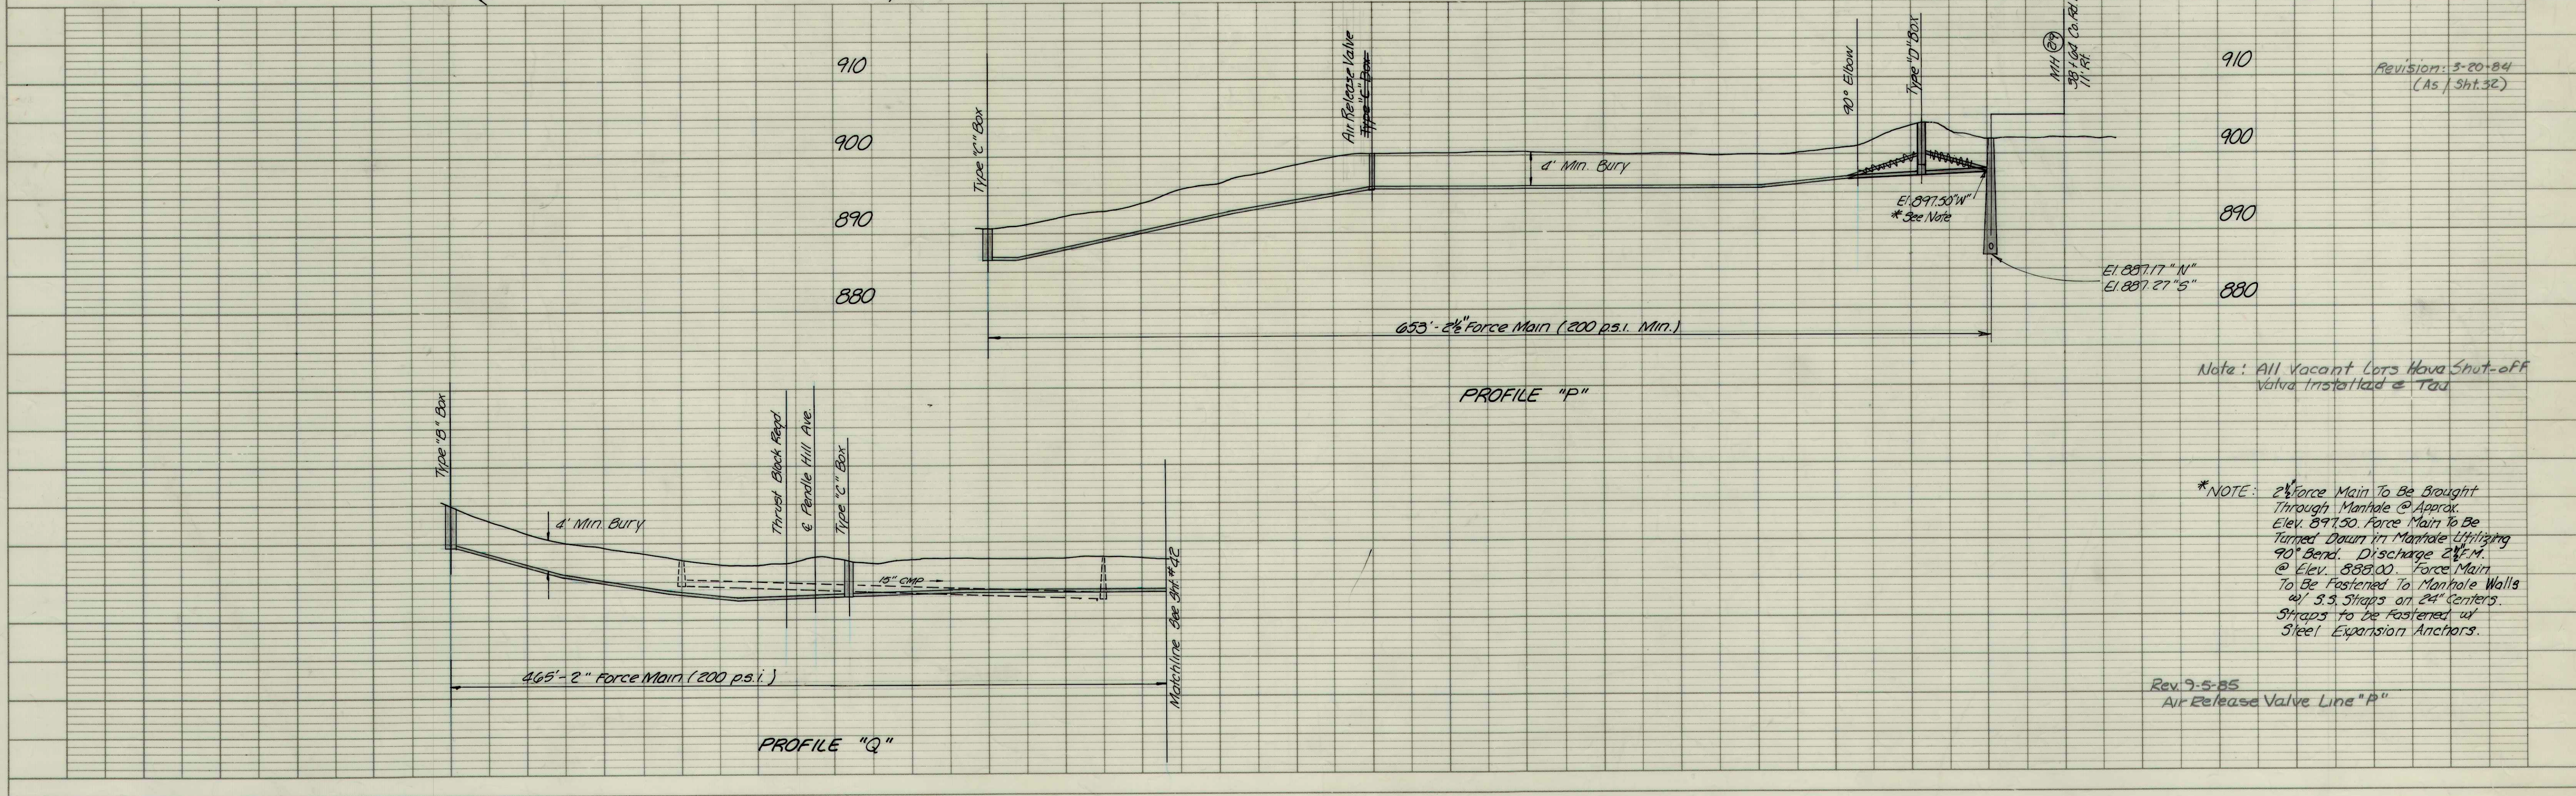

PENDLE HILL AVE.
LANCASHIRE LN. - CO. RD. 100 W.
FALL CREEK R.W.D. PLAN & PROFILE SHEET
HORIZ. 1"=50'
VERT. 1"=10'
BEAM, LONGEST & NEFF, INC.
CONSULTING ENGINEERS
INDIANAPOLIS, INDIANA
41