

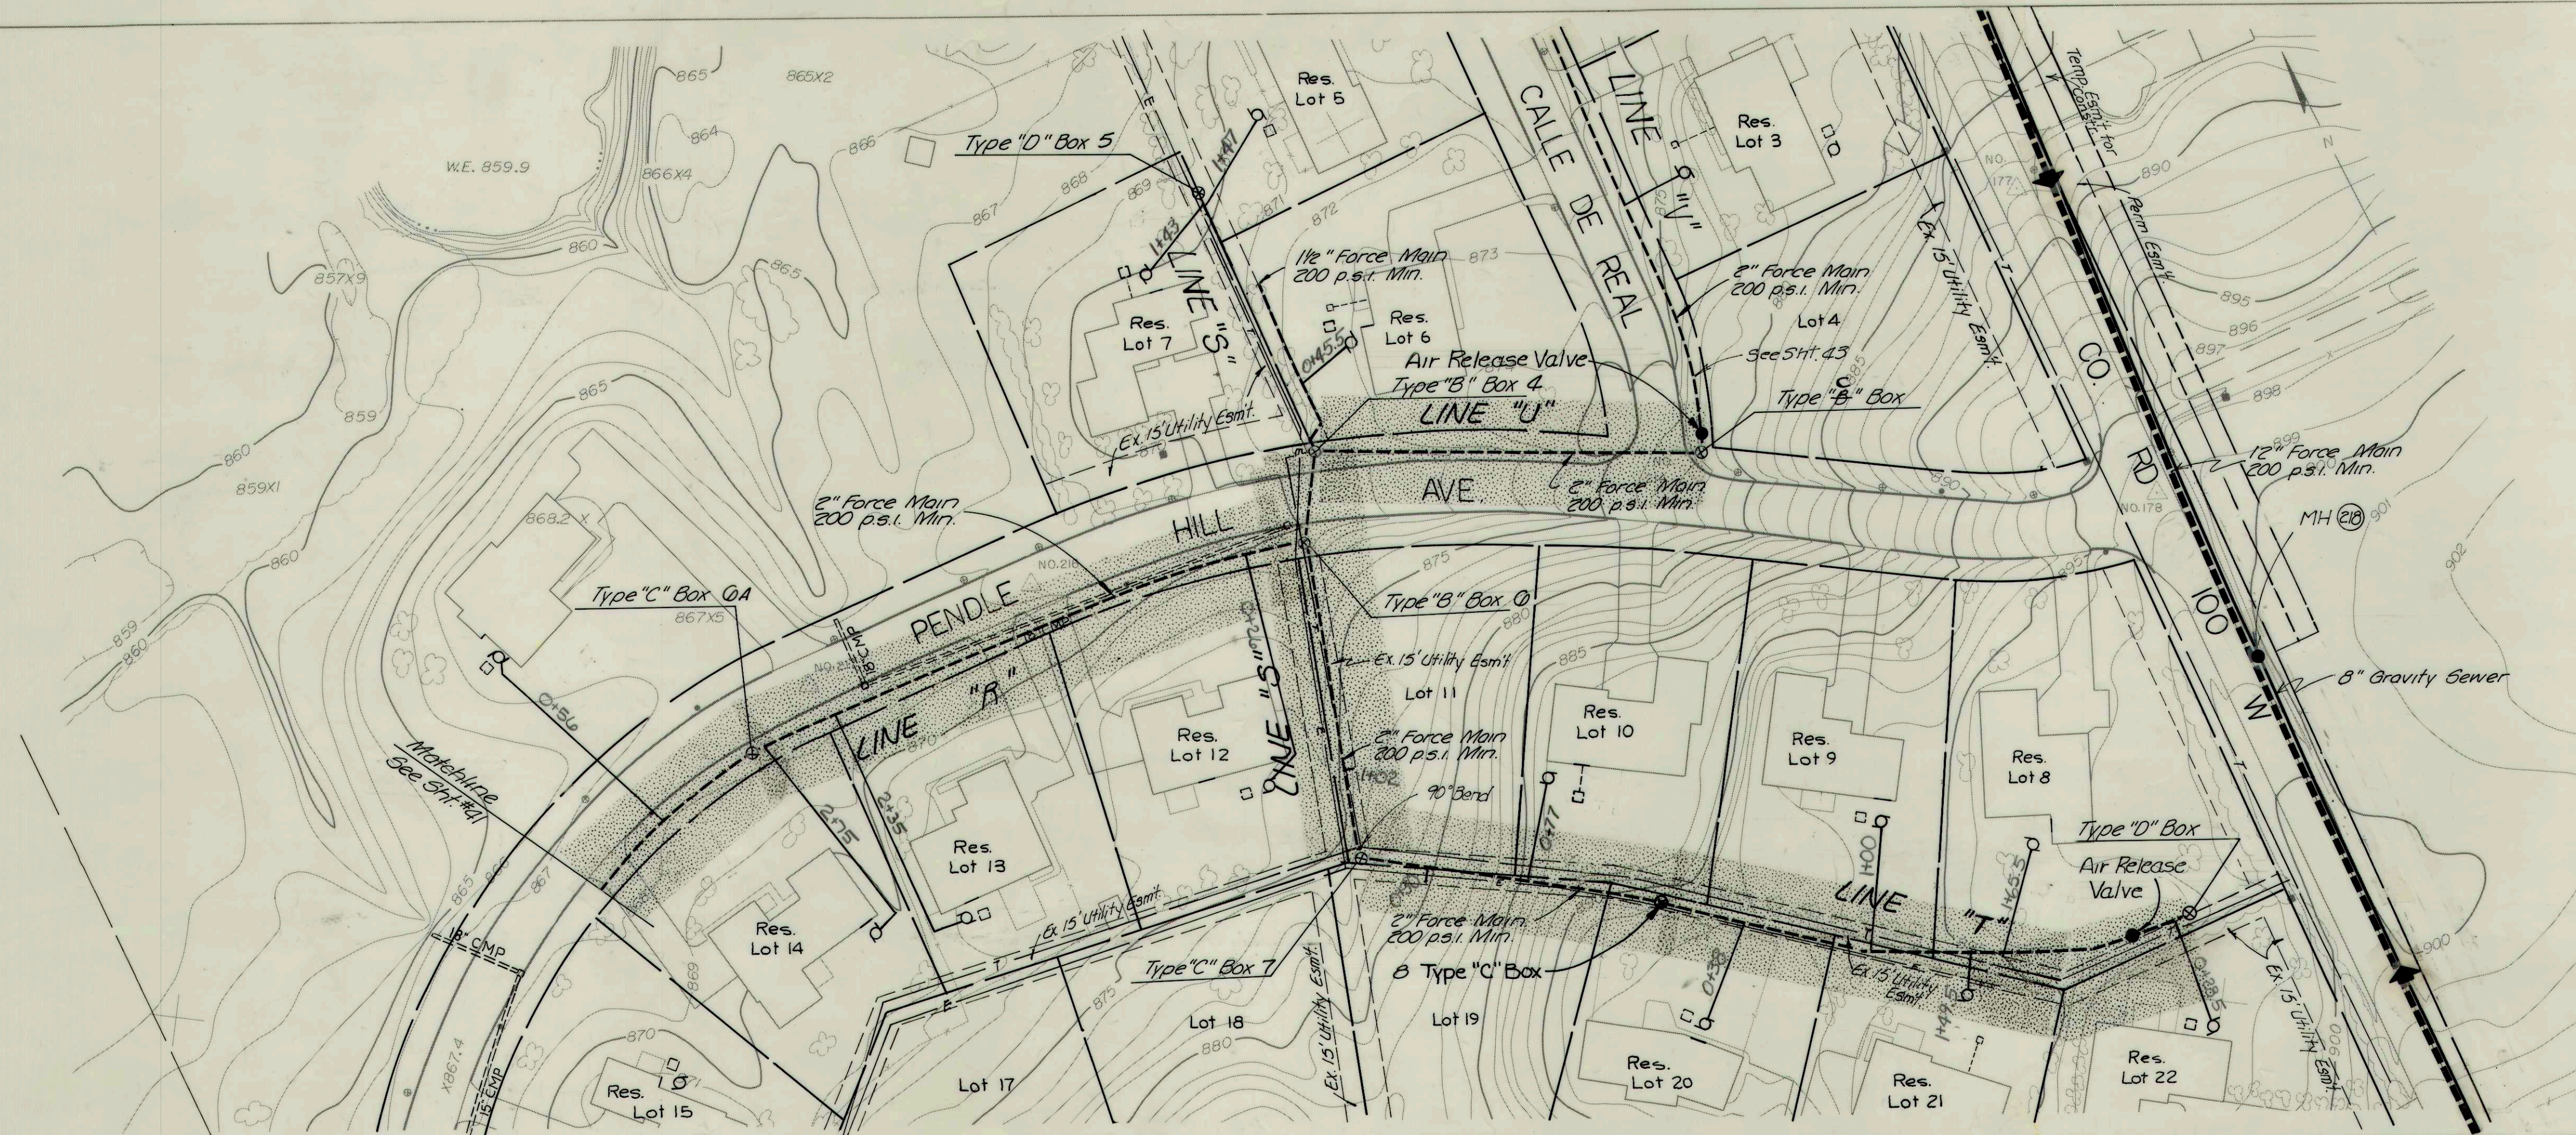


PLAN	DATE
	BY
	SURVEYED
	NOTED
NOTE BOOK	
ALIGNMENT CHECKED	
ST. OF WAY CHECKED	
No.	

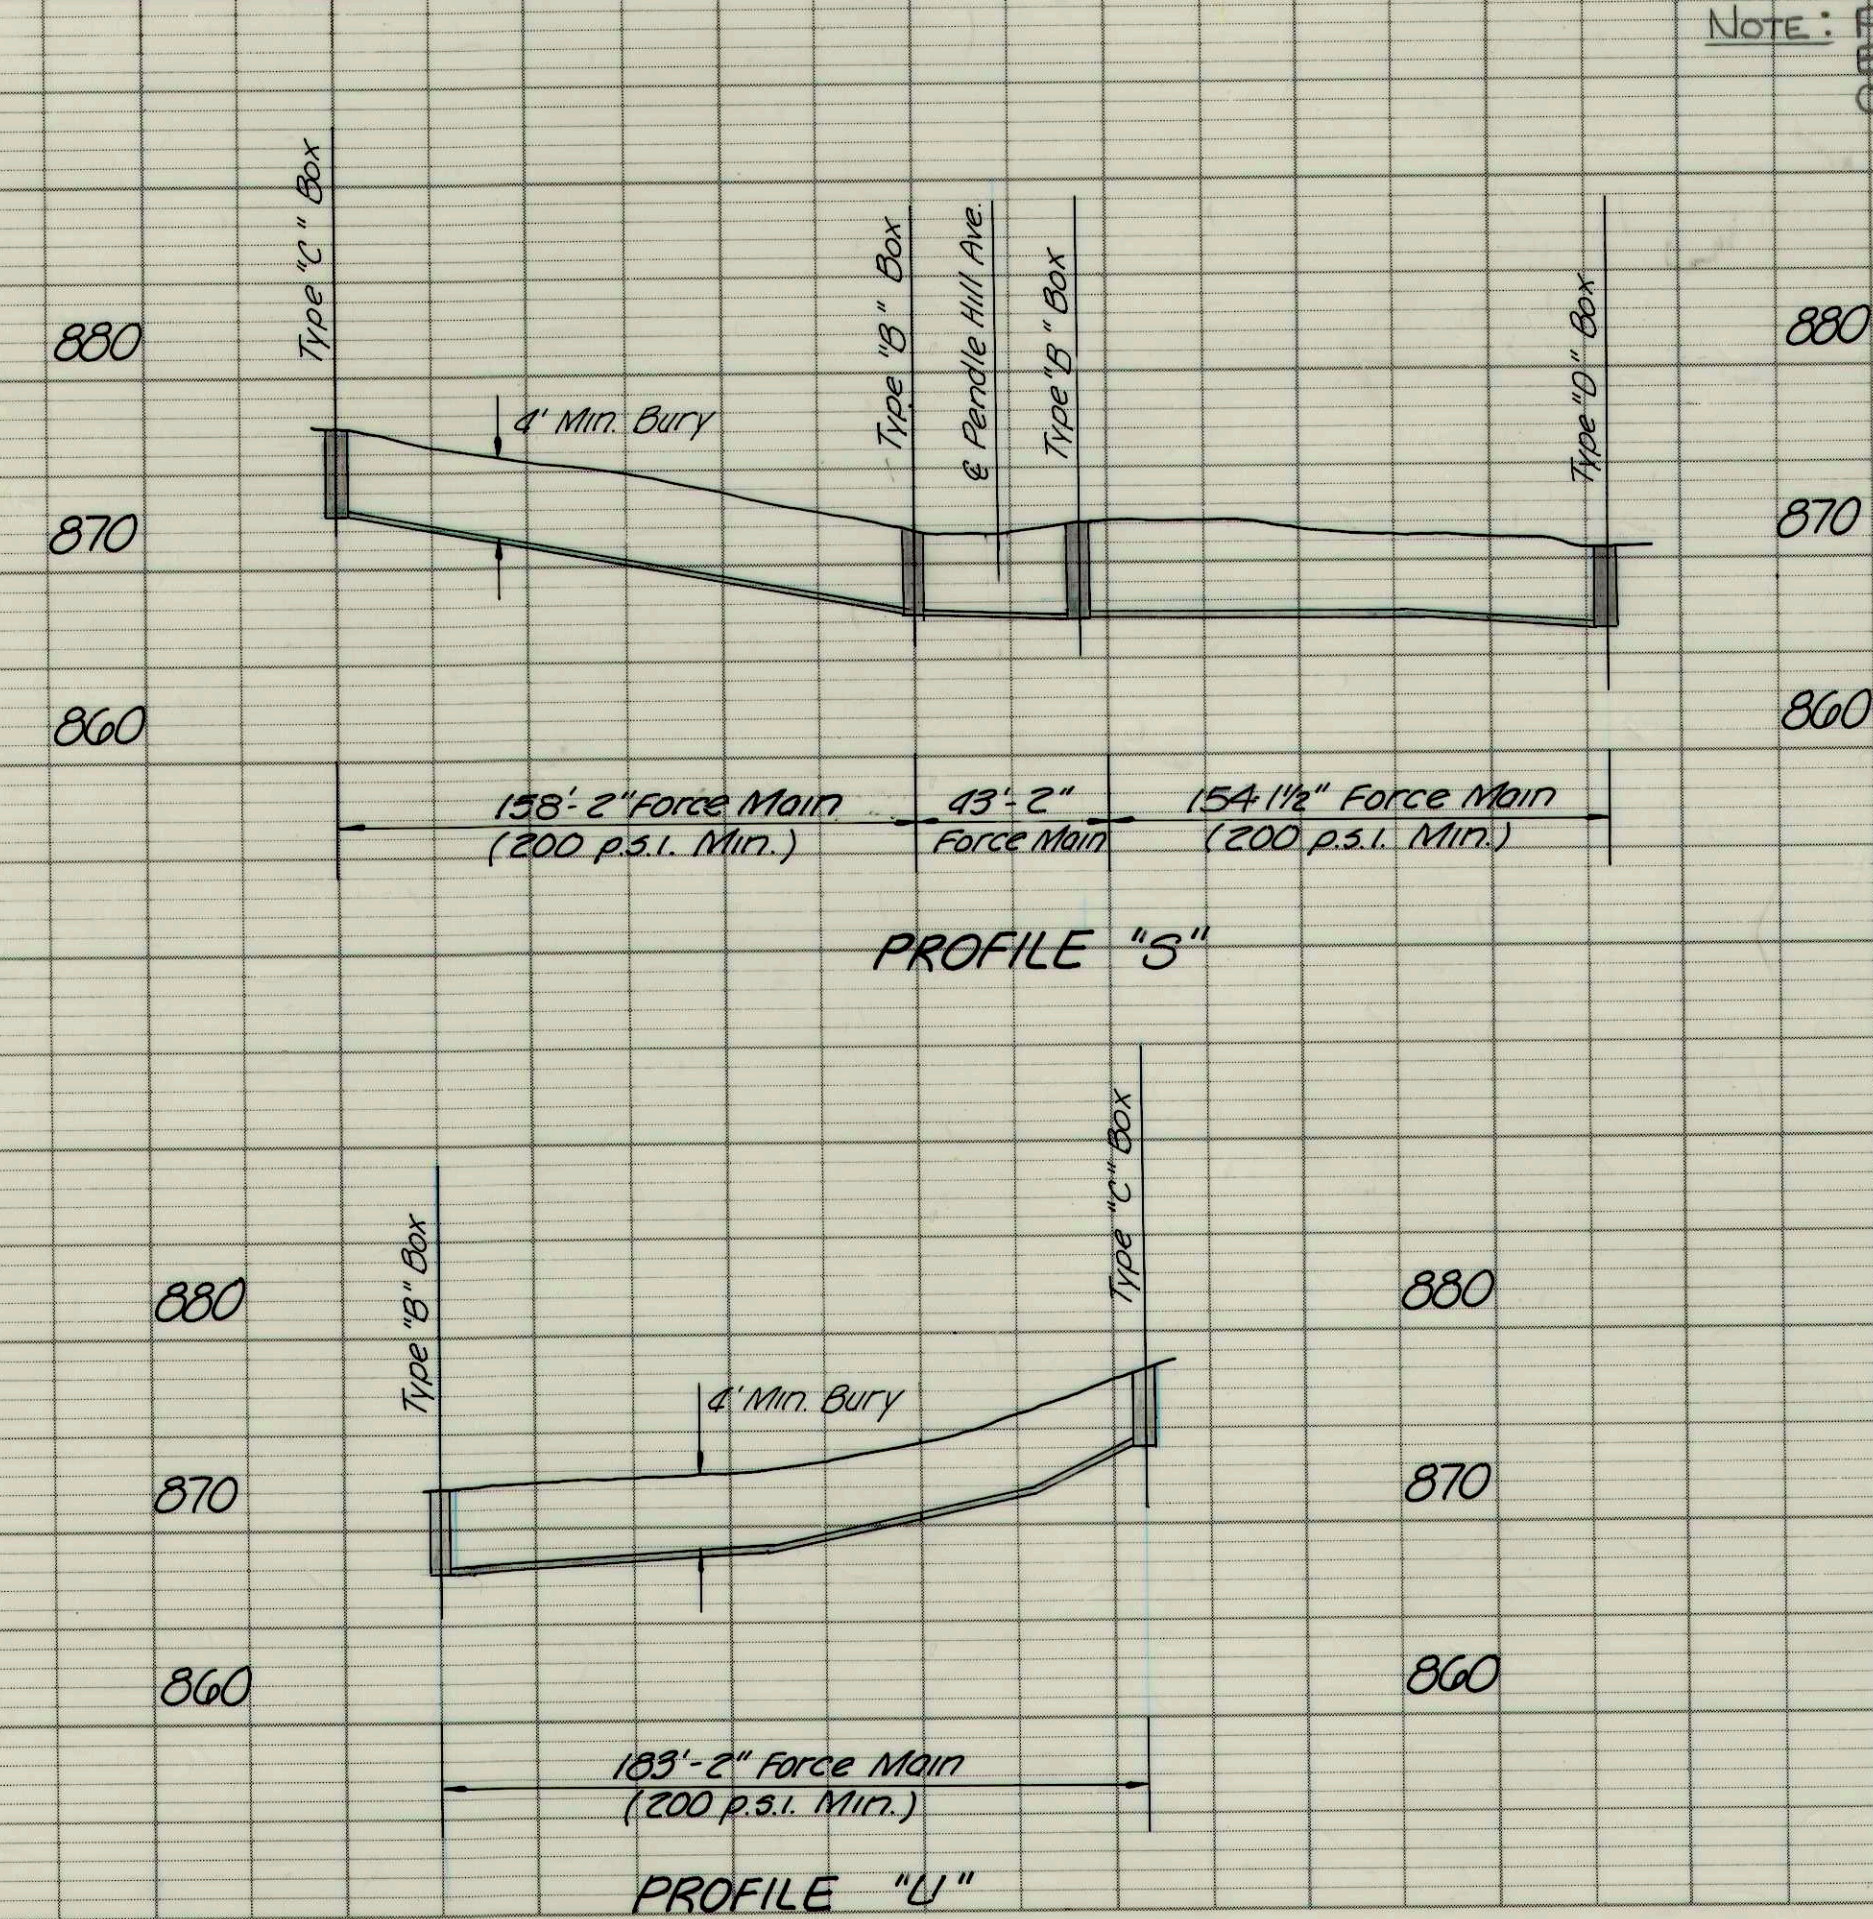

PROFILE	DATE
	BY
	SURVEYED
	NOTED
NOTE BOOK	
GRADES CHECKED	
S. M. 1. NOTED	
STRUCTURE NOTATIONS CHECKED	
No.	

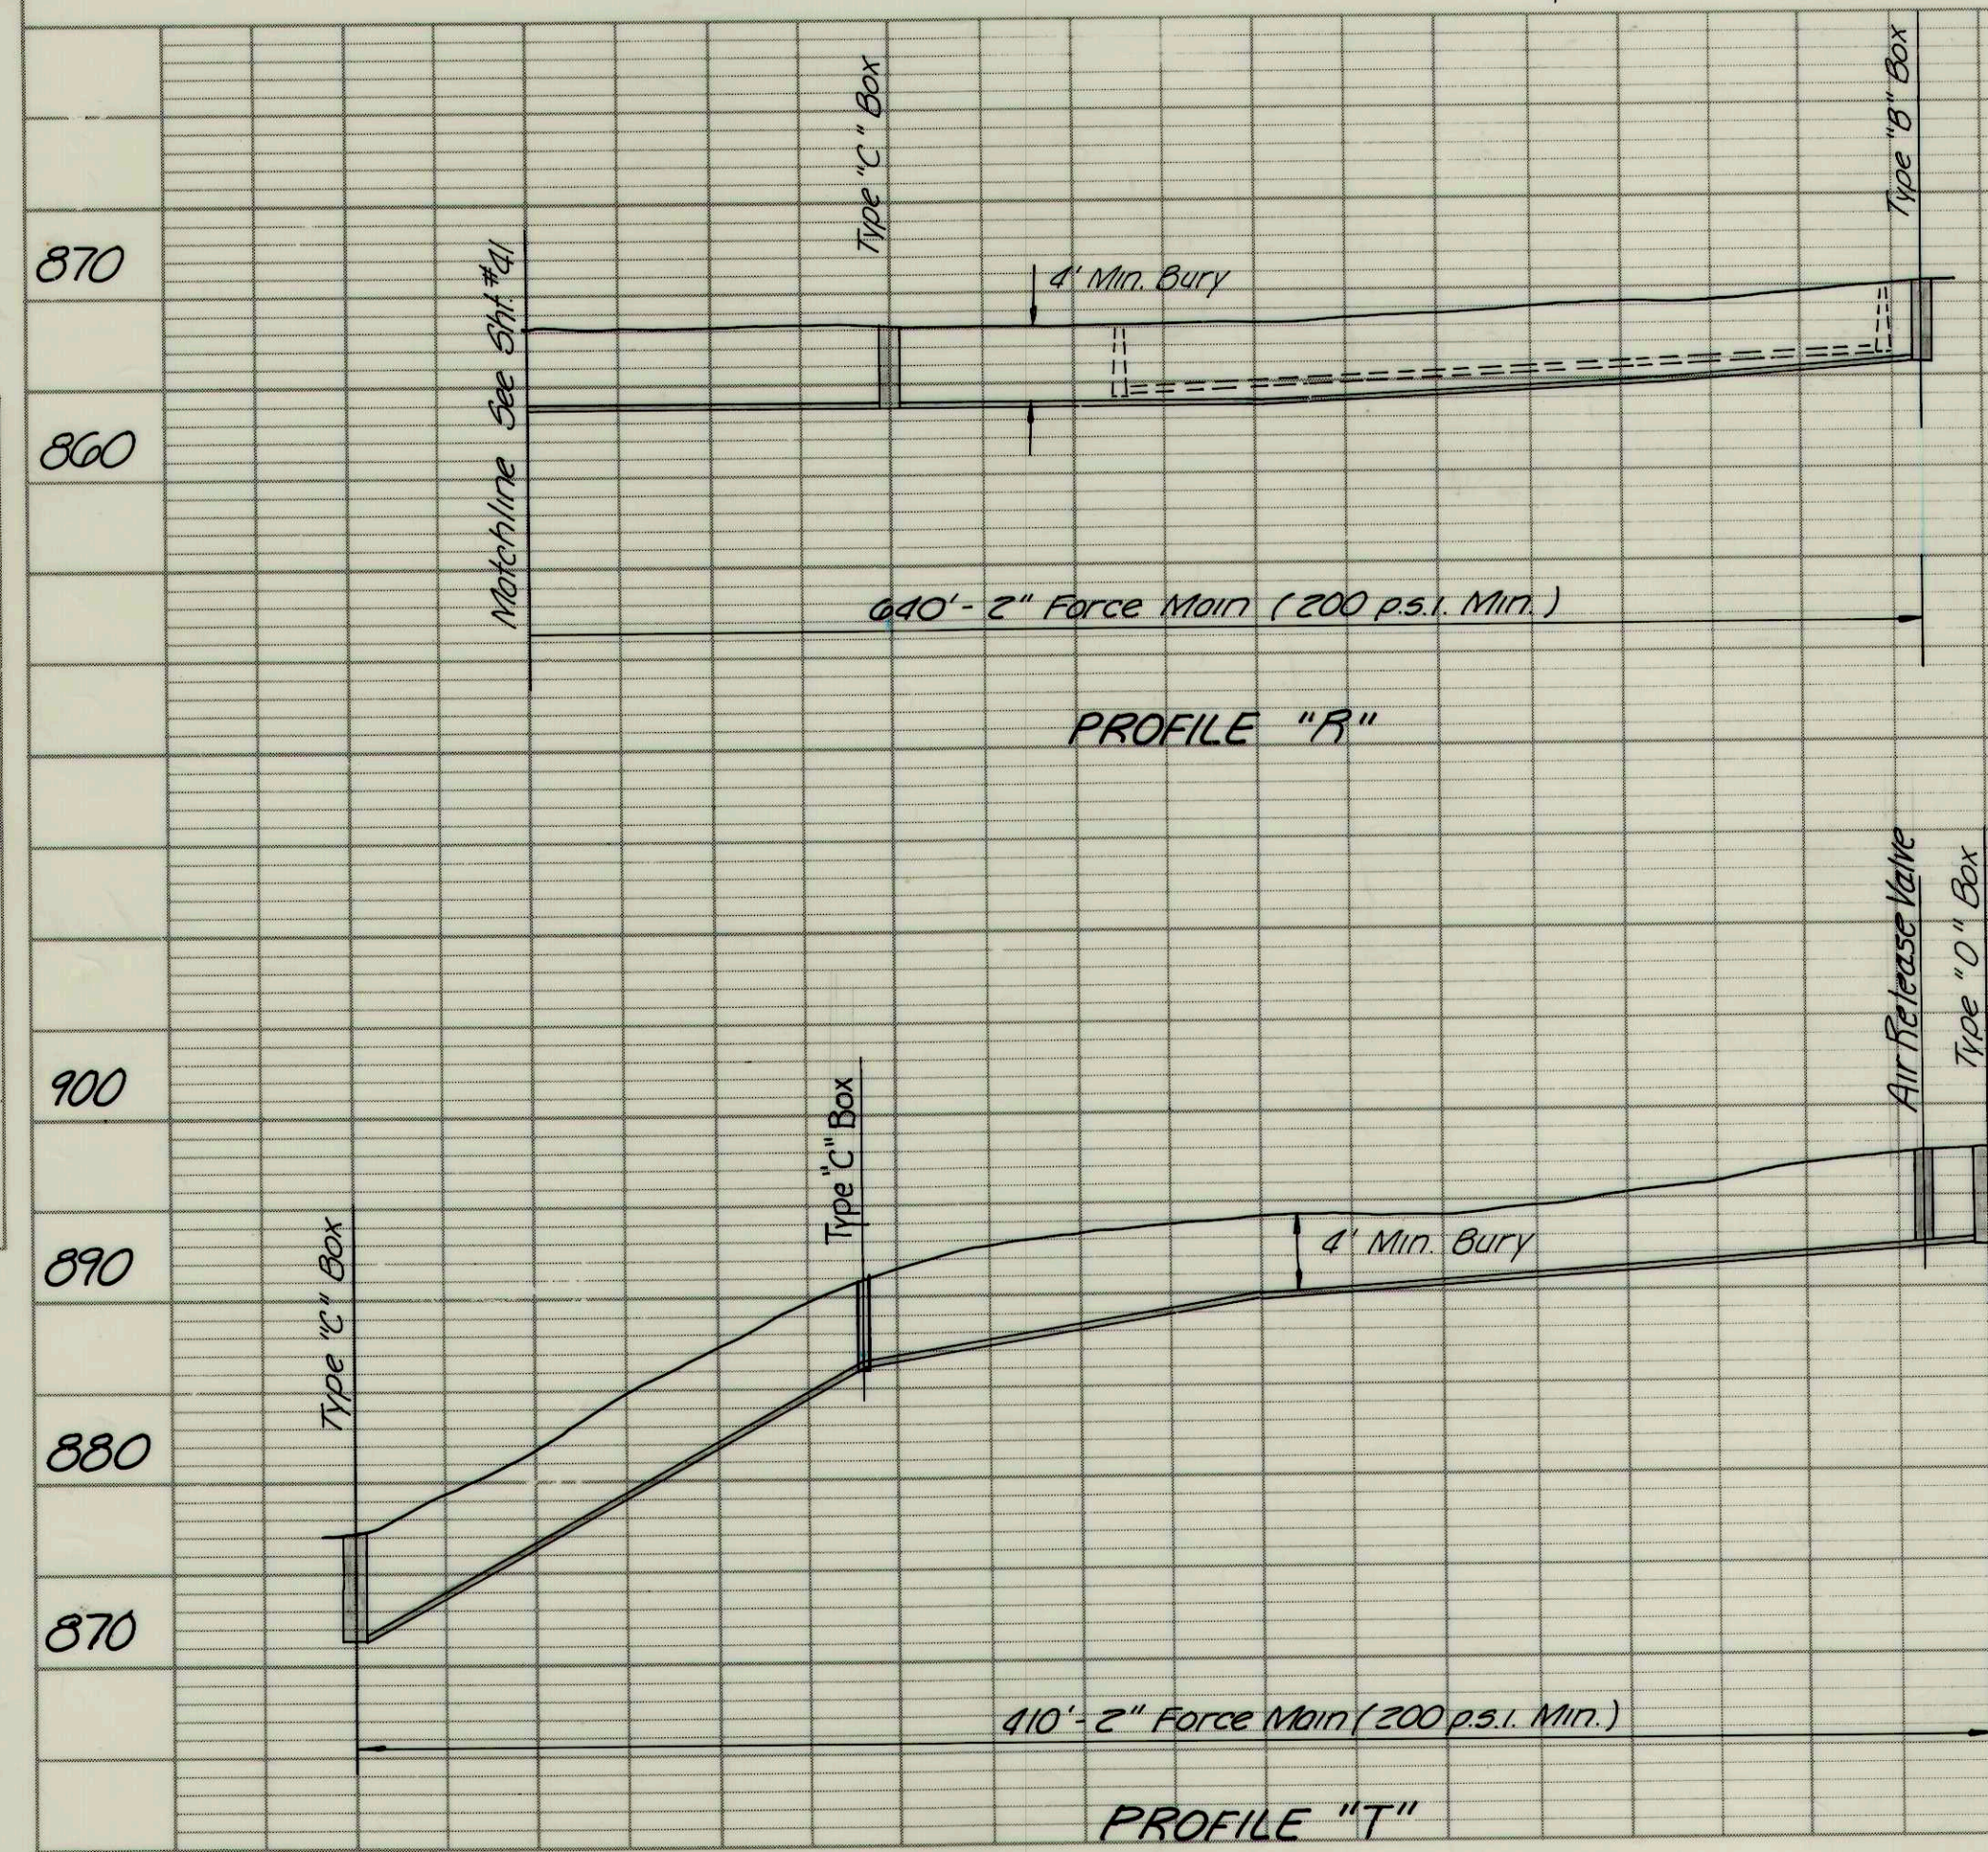

NOTE: PROFILE "S" SHIFTED TO FAR EAST SIDE OF EASEMENT IN ORDER TO SAVE EVERGREENS.

Revision: 3-20-84
(As per Sht. 32)

Note: All Vacant Lots have shut-off valves installed & Tag.

Rev 9-5-85
Air Release Valve Line "T"
* Line "V"

RECORD DRAWING



PENDLE HILL AVE - Co. RD. 100 W
CALLE DE REAL
FALL CREEK R.W.D. PLAN & PROFILE SHEET
HORIZ. 1"=50'
VERT. 1"=10'
BEAM, LONGST & NEFF, INC.
CONSULTING ENGINEERS
INDIANAPOLIS, INDIANA
42