

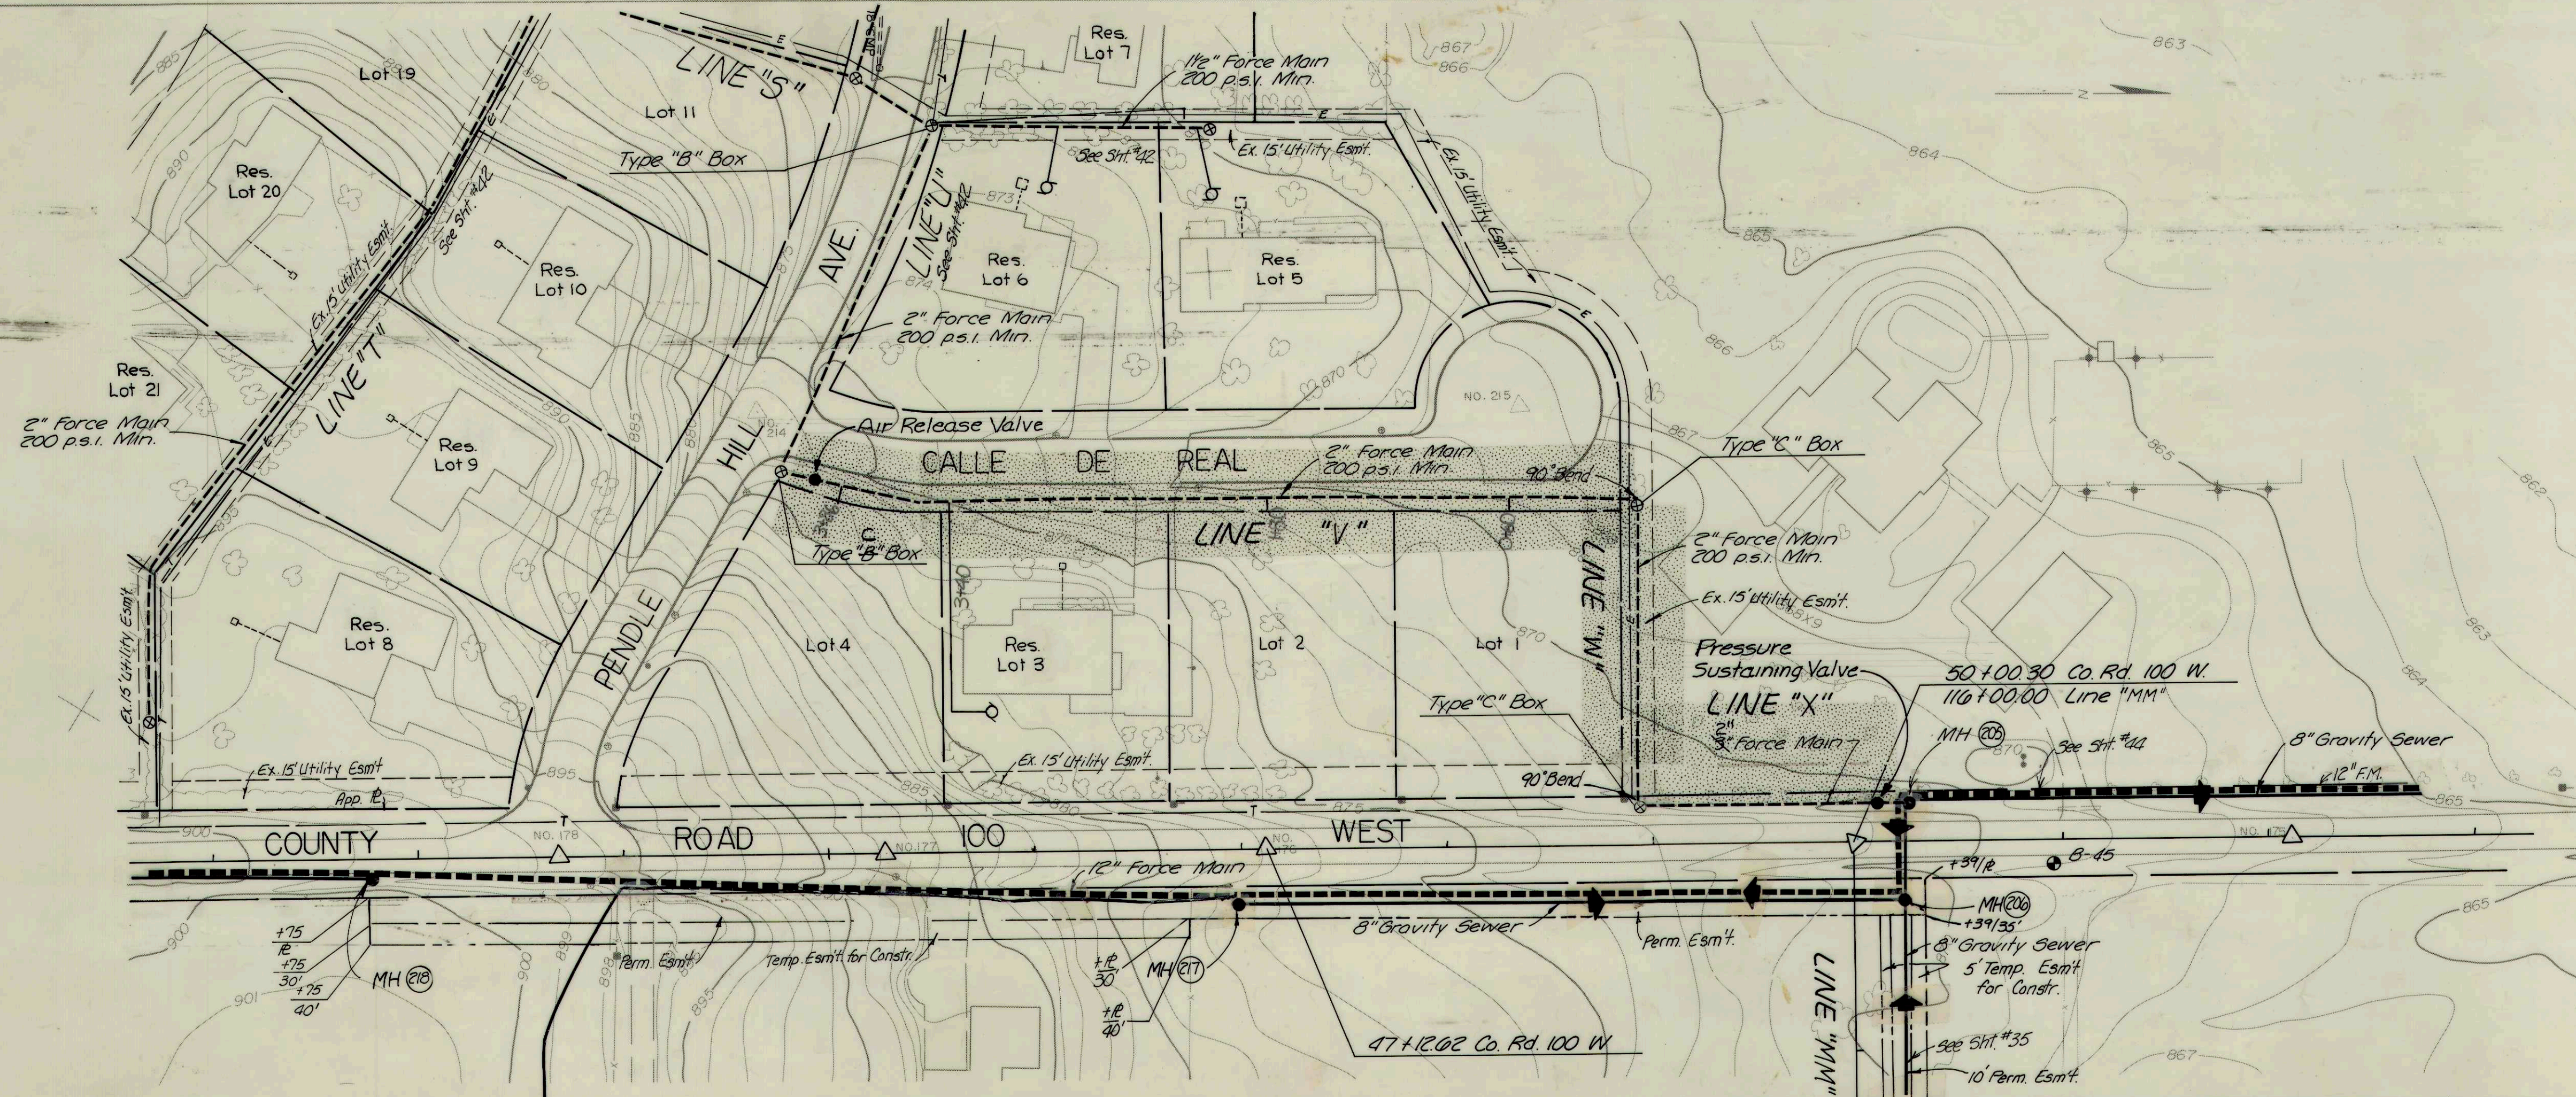


PLAN	DATE	
	BY	
	SUPERVISOR	
	NOTED	
NOTE BOOK		
ALIGNMENT CHECKED		
BT OF WAY CHECKED		
No.		

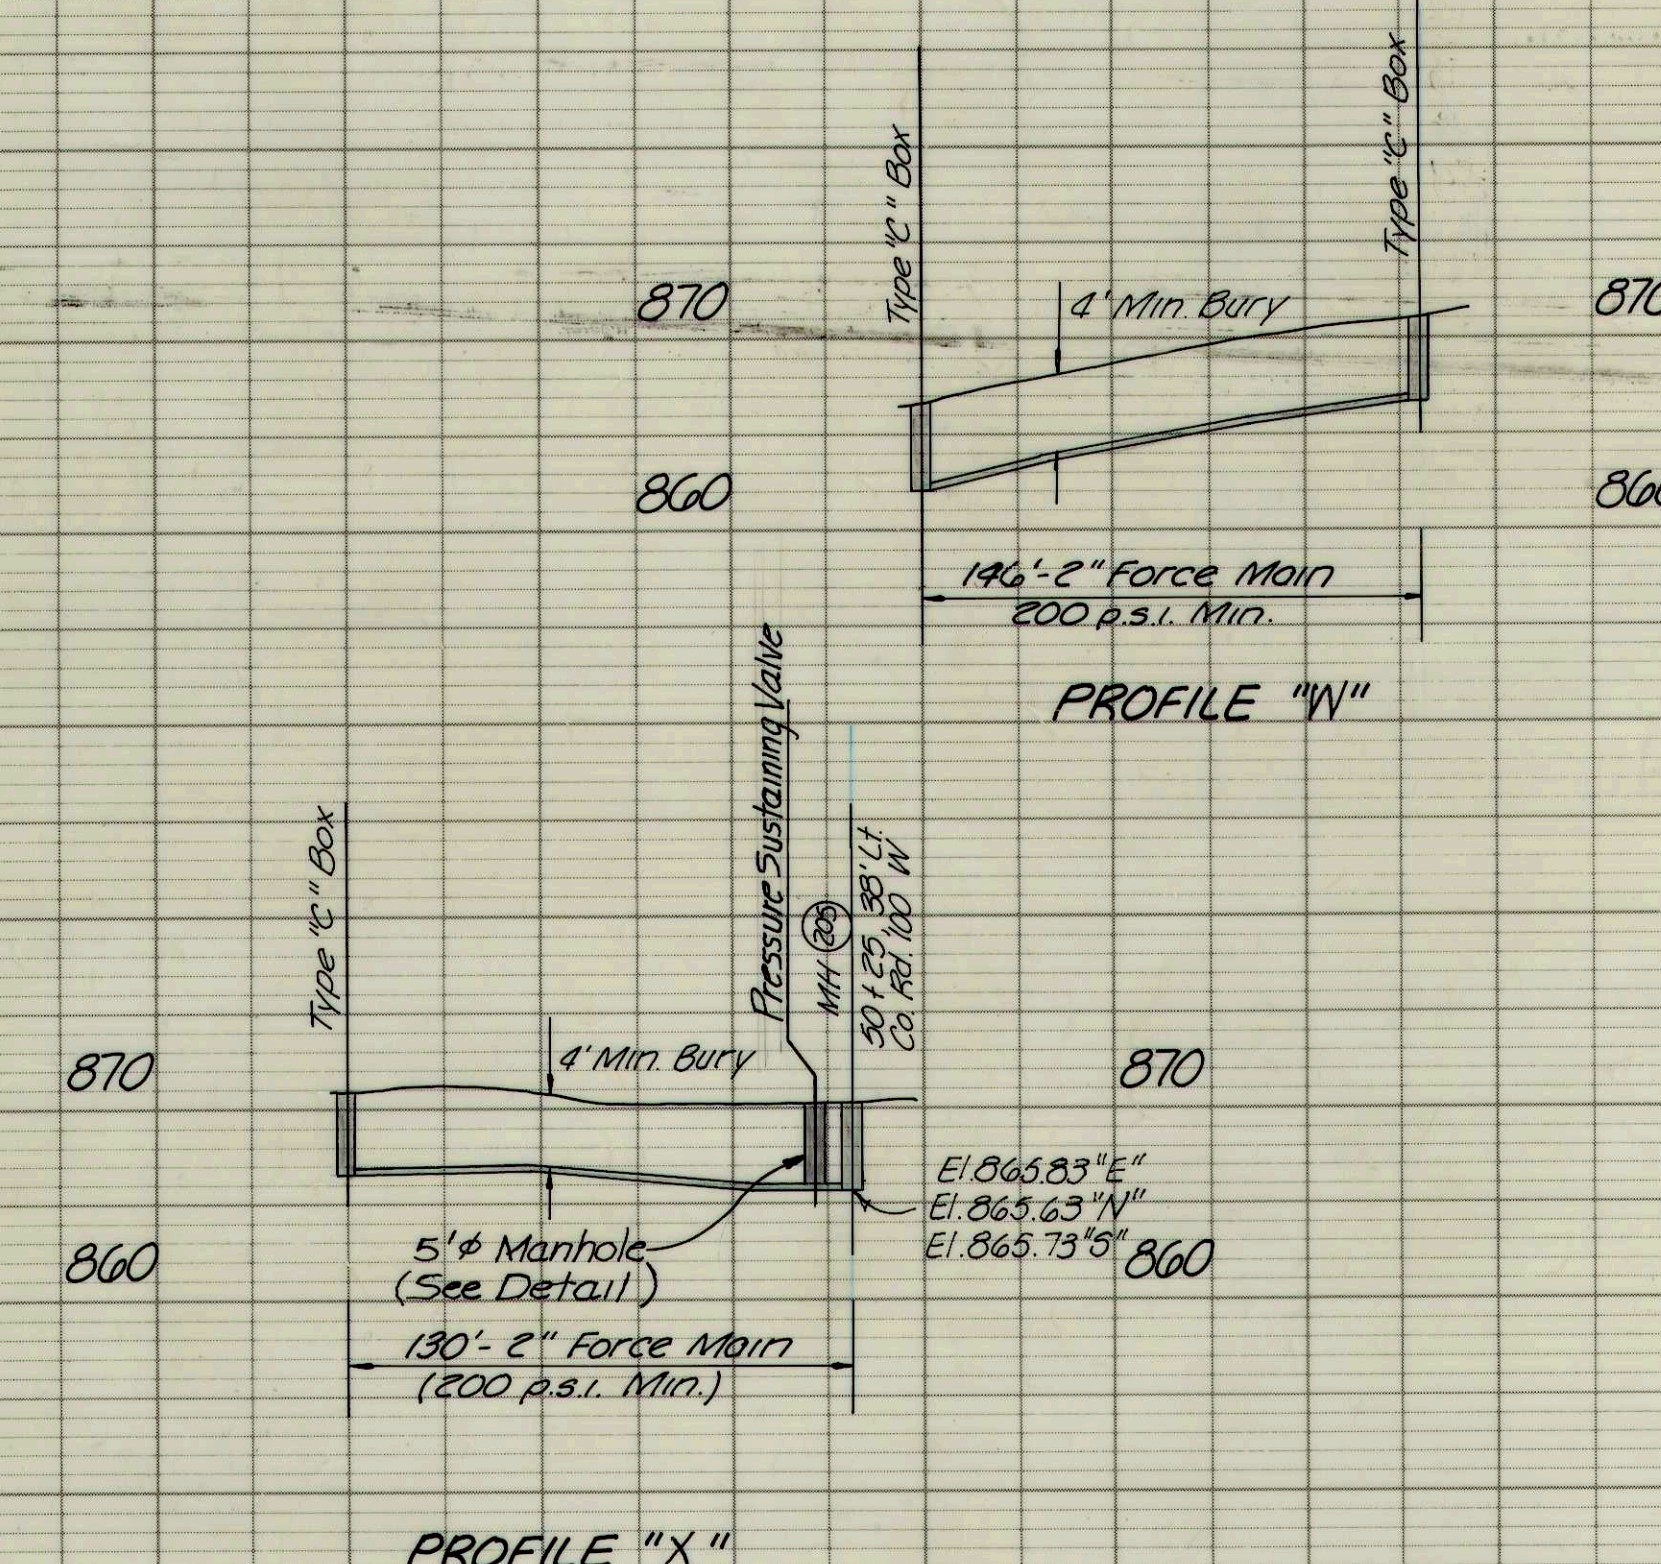

PROFILE	DATE	
	BY	
	SUPERVISOR	
	NOTED	
NOTE BOOK		
GRADES CHECKED		
E. A. NOTED		
STRUCTURE NOTATIONS CHECKED		
No.		

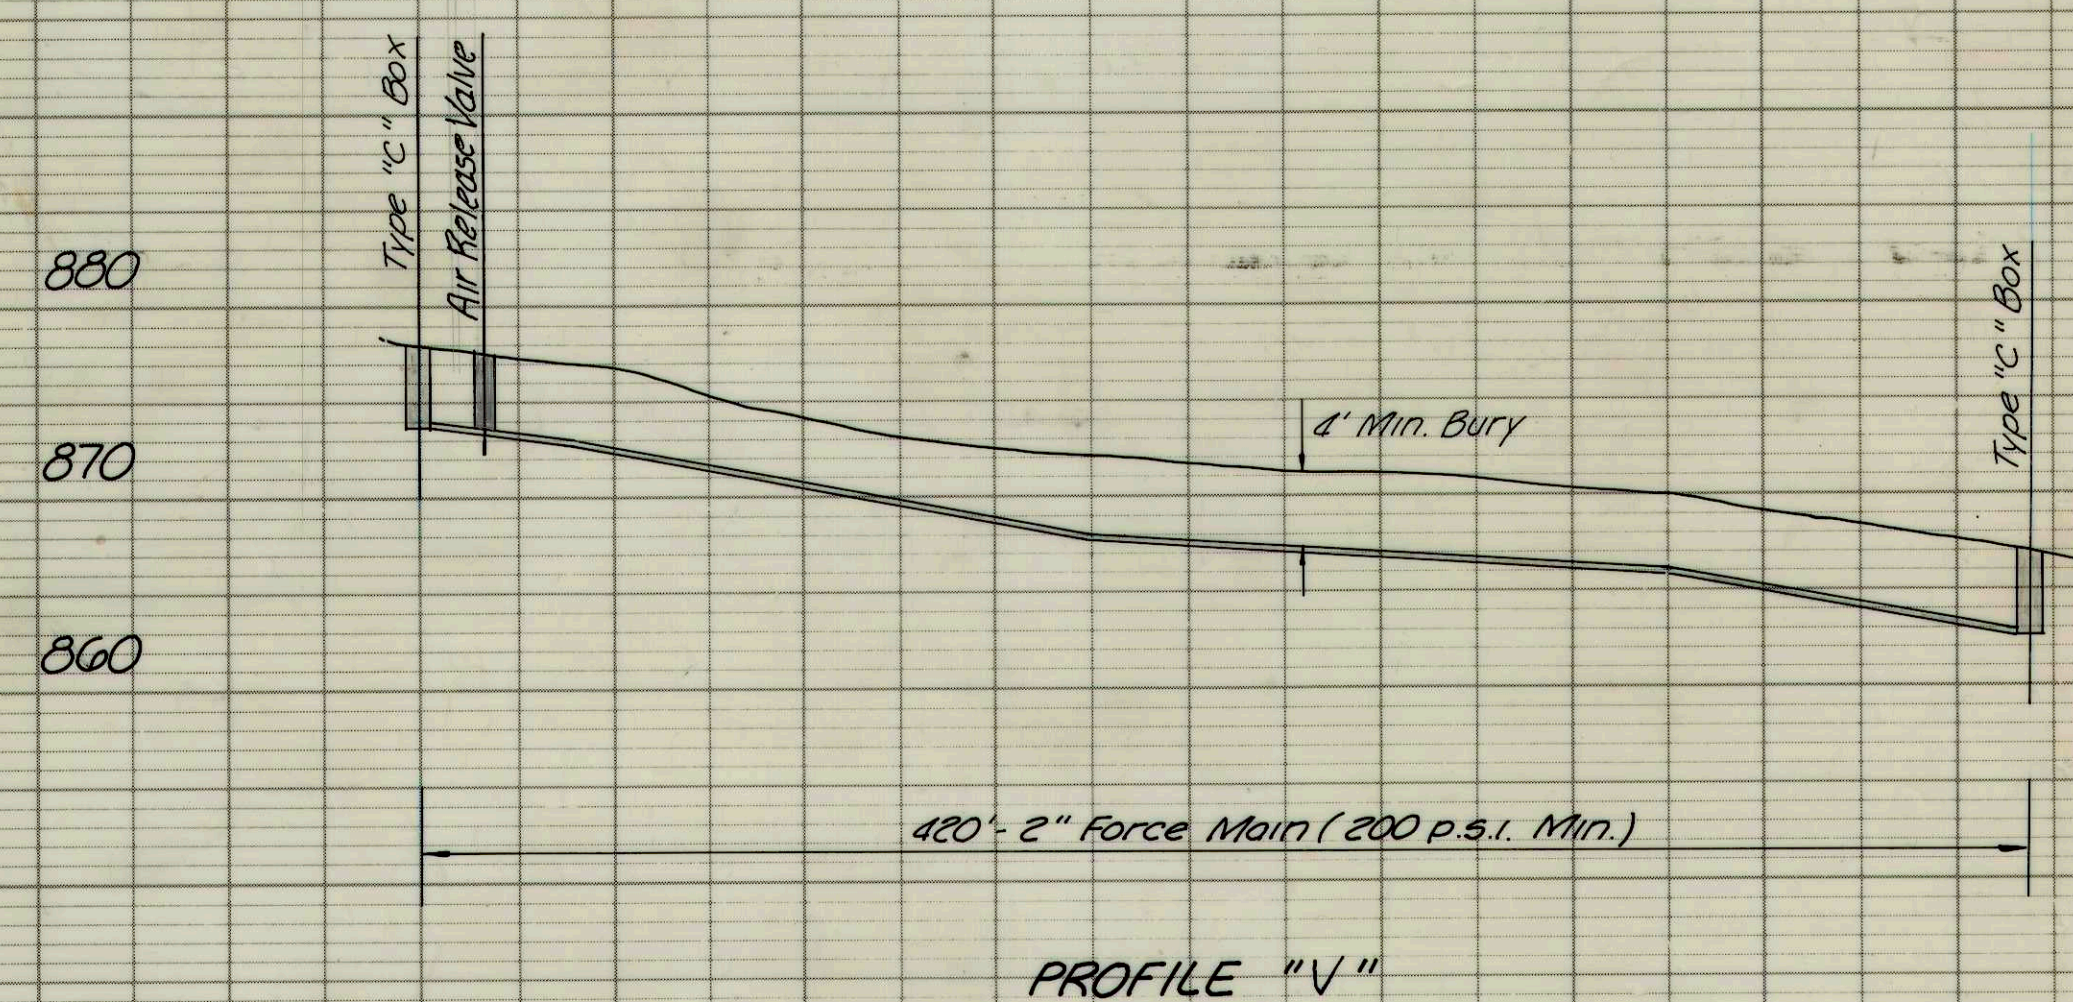

Revision: 3-21-84
(Change Distance of Line "W" & Revised as/ Sht. 32)

Rev. 9-5-85
Air Release Valve Line "V"
Pressure Sustaining Valve Line "X"

Note: All Vacant Lots Have shut-off Valve Installed @ Tee

RECORD DRAWING



PENDLE HILL AVE. - CO. RD 100 W		SHEET
CALLE DE REAL		
FALL CREEK R.W.D. PLAN & PROFILE		
HORIZ. 1"=50'	BEAM, LONGEST & NEFF, INC.	
VERT. 1"=10'	CONSULTING ENGINEERS	43
INDIANAPOLIS, INDIANA		