


PLAN
 SURVEYED
 PLOTTED
 NOTE BOOK
 NO. OF MAY CHECKED

PROFILE
 SURVEYED
 GRADES CHECKED
 NOTE BOOK
 NO. OF MAY CHECKED



RECORD DRAWING

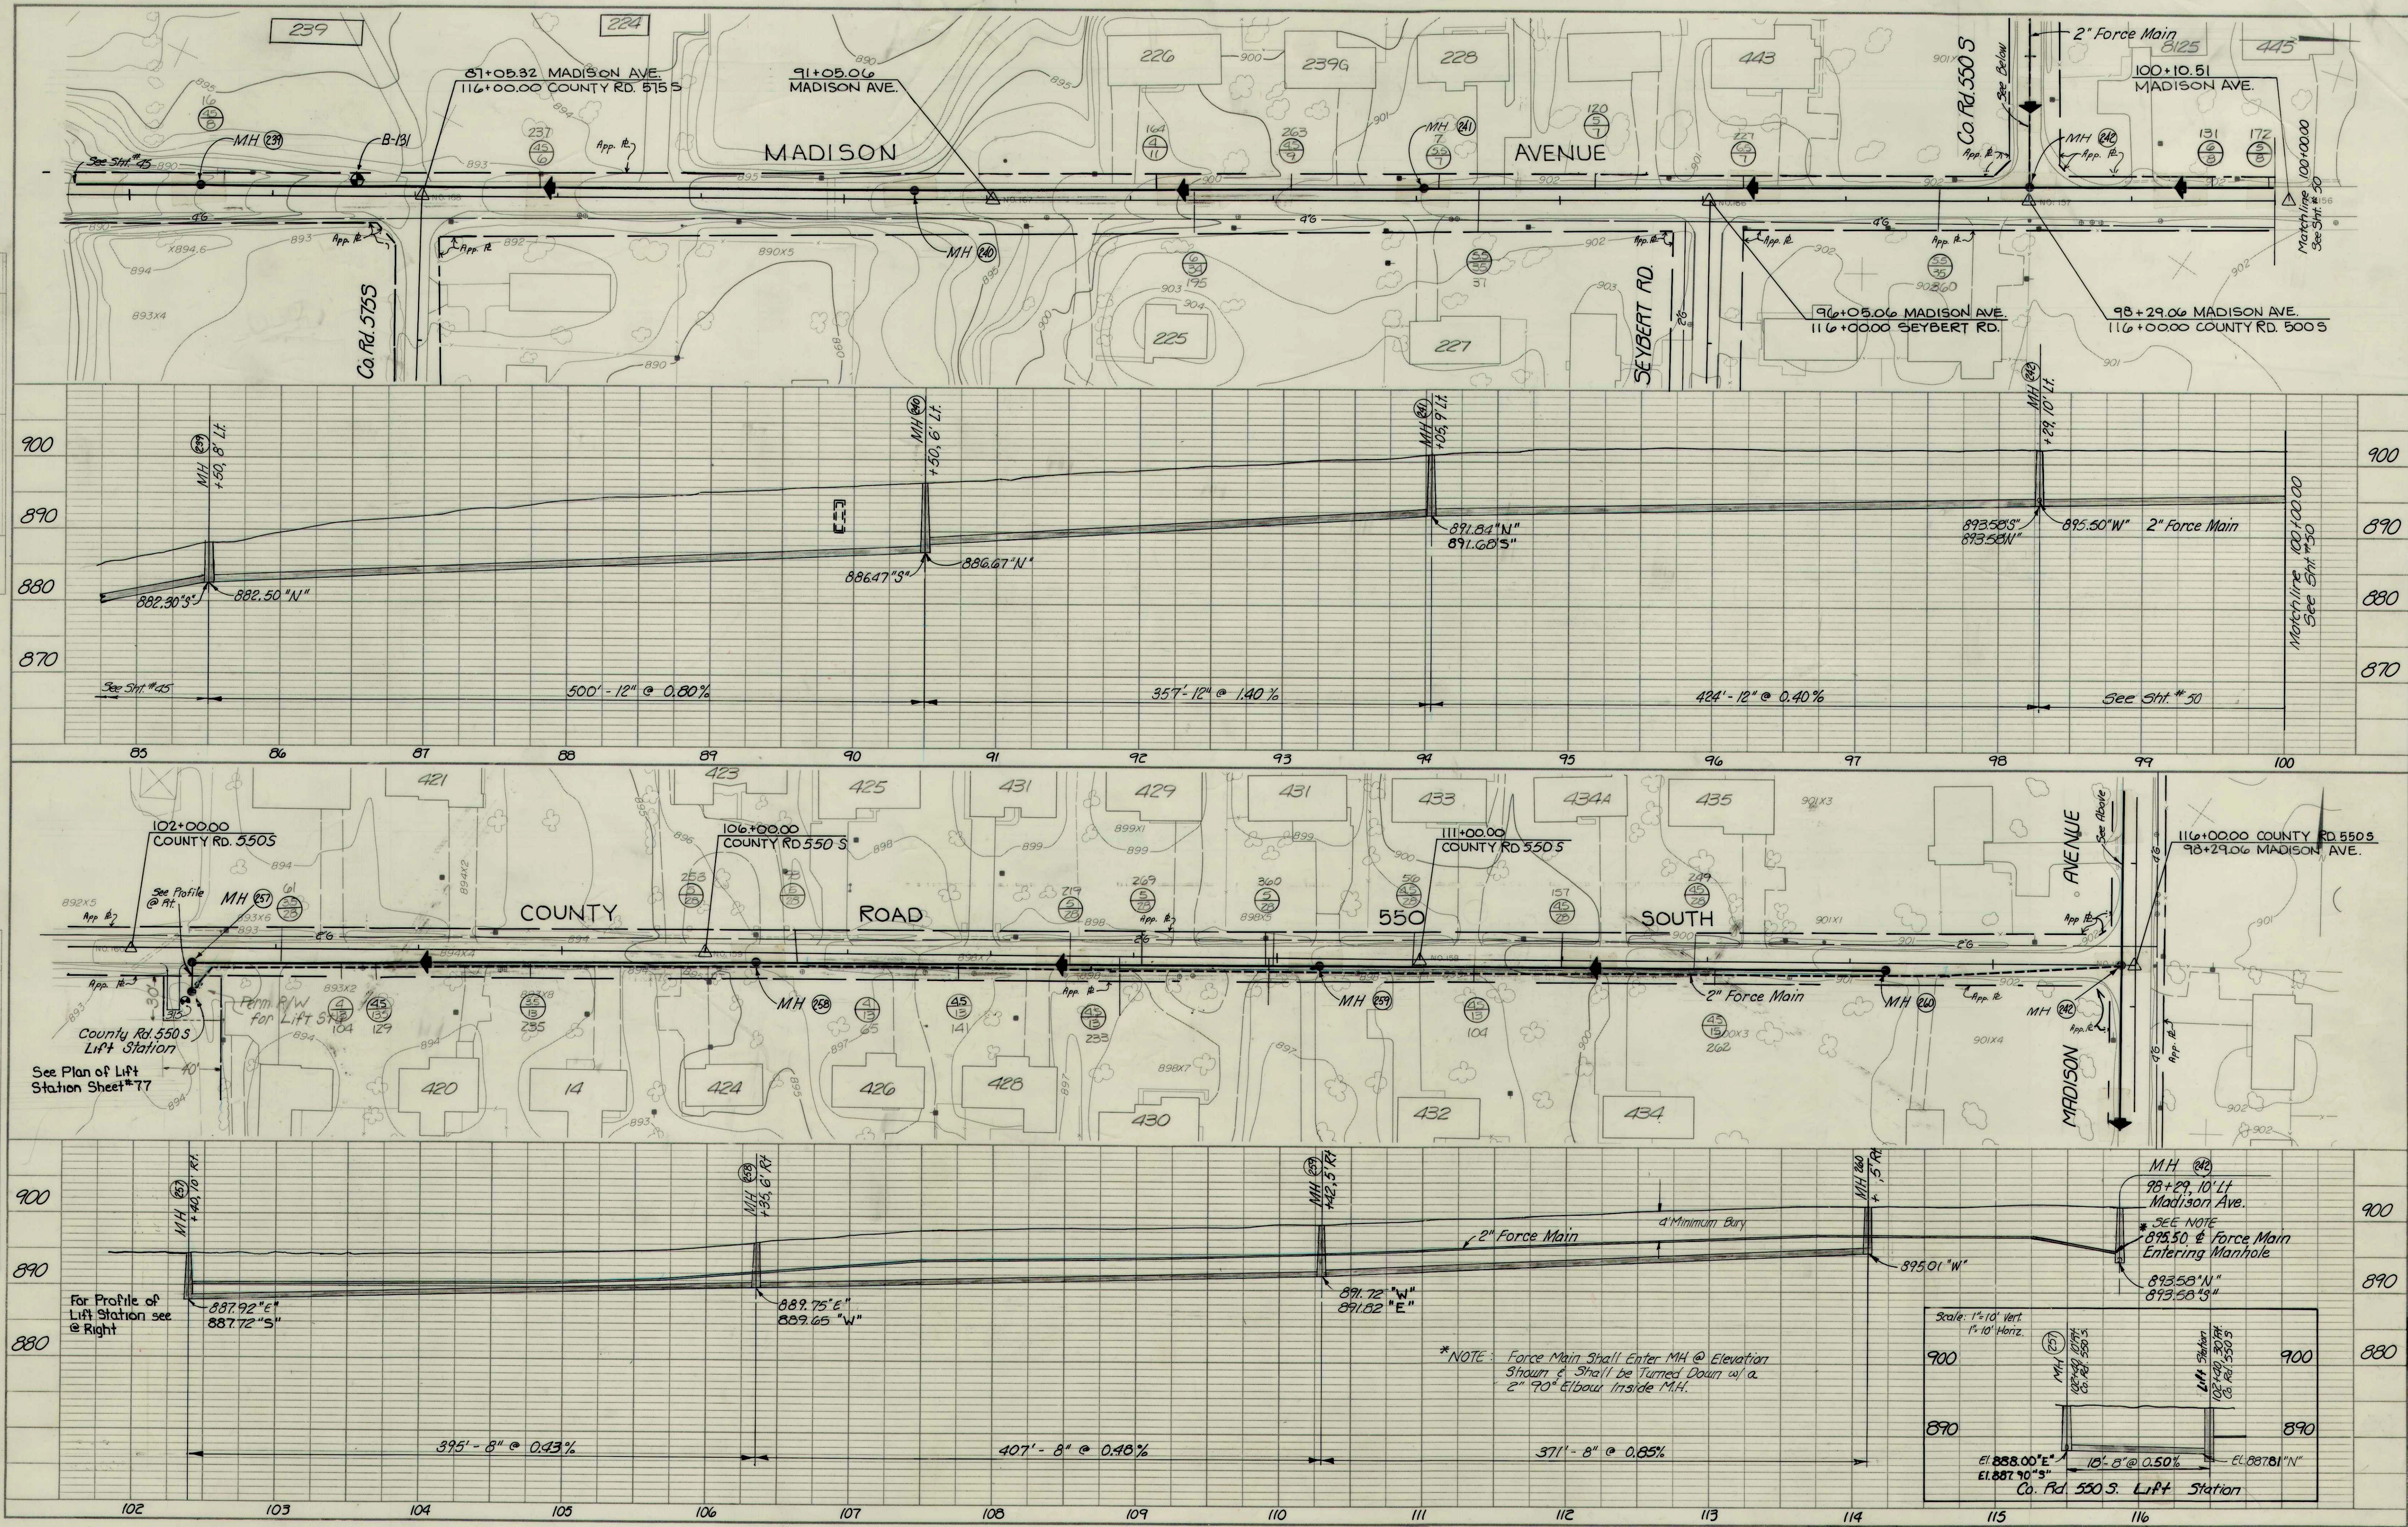

MADISON AVE/ Co. Rd. 550 S
 FALL CREEK R.W.D. PLAN & PROFILE SHEET
 HORIZ. 1"=50'
 VERT. 1"=10'
 BEAM, LONGEST & NEFF, INC.
 CONSULTING ENGINEERS
 INDIANAPOLIS, INDIANA
46