



PLAN	DATE	BY
	NO.	NO.
	NO.	NO.
	NO.	NO.

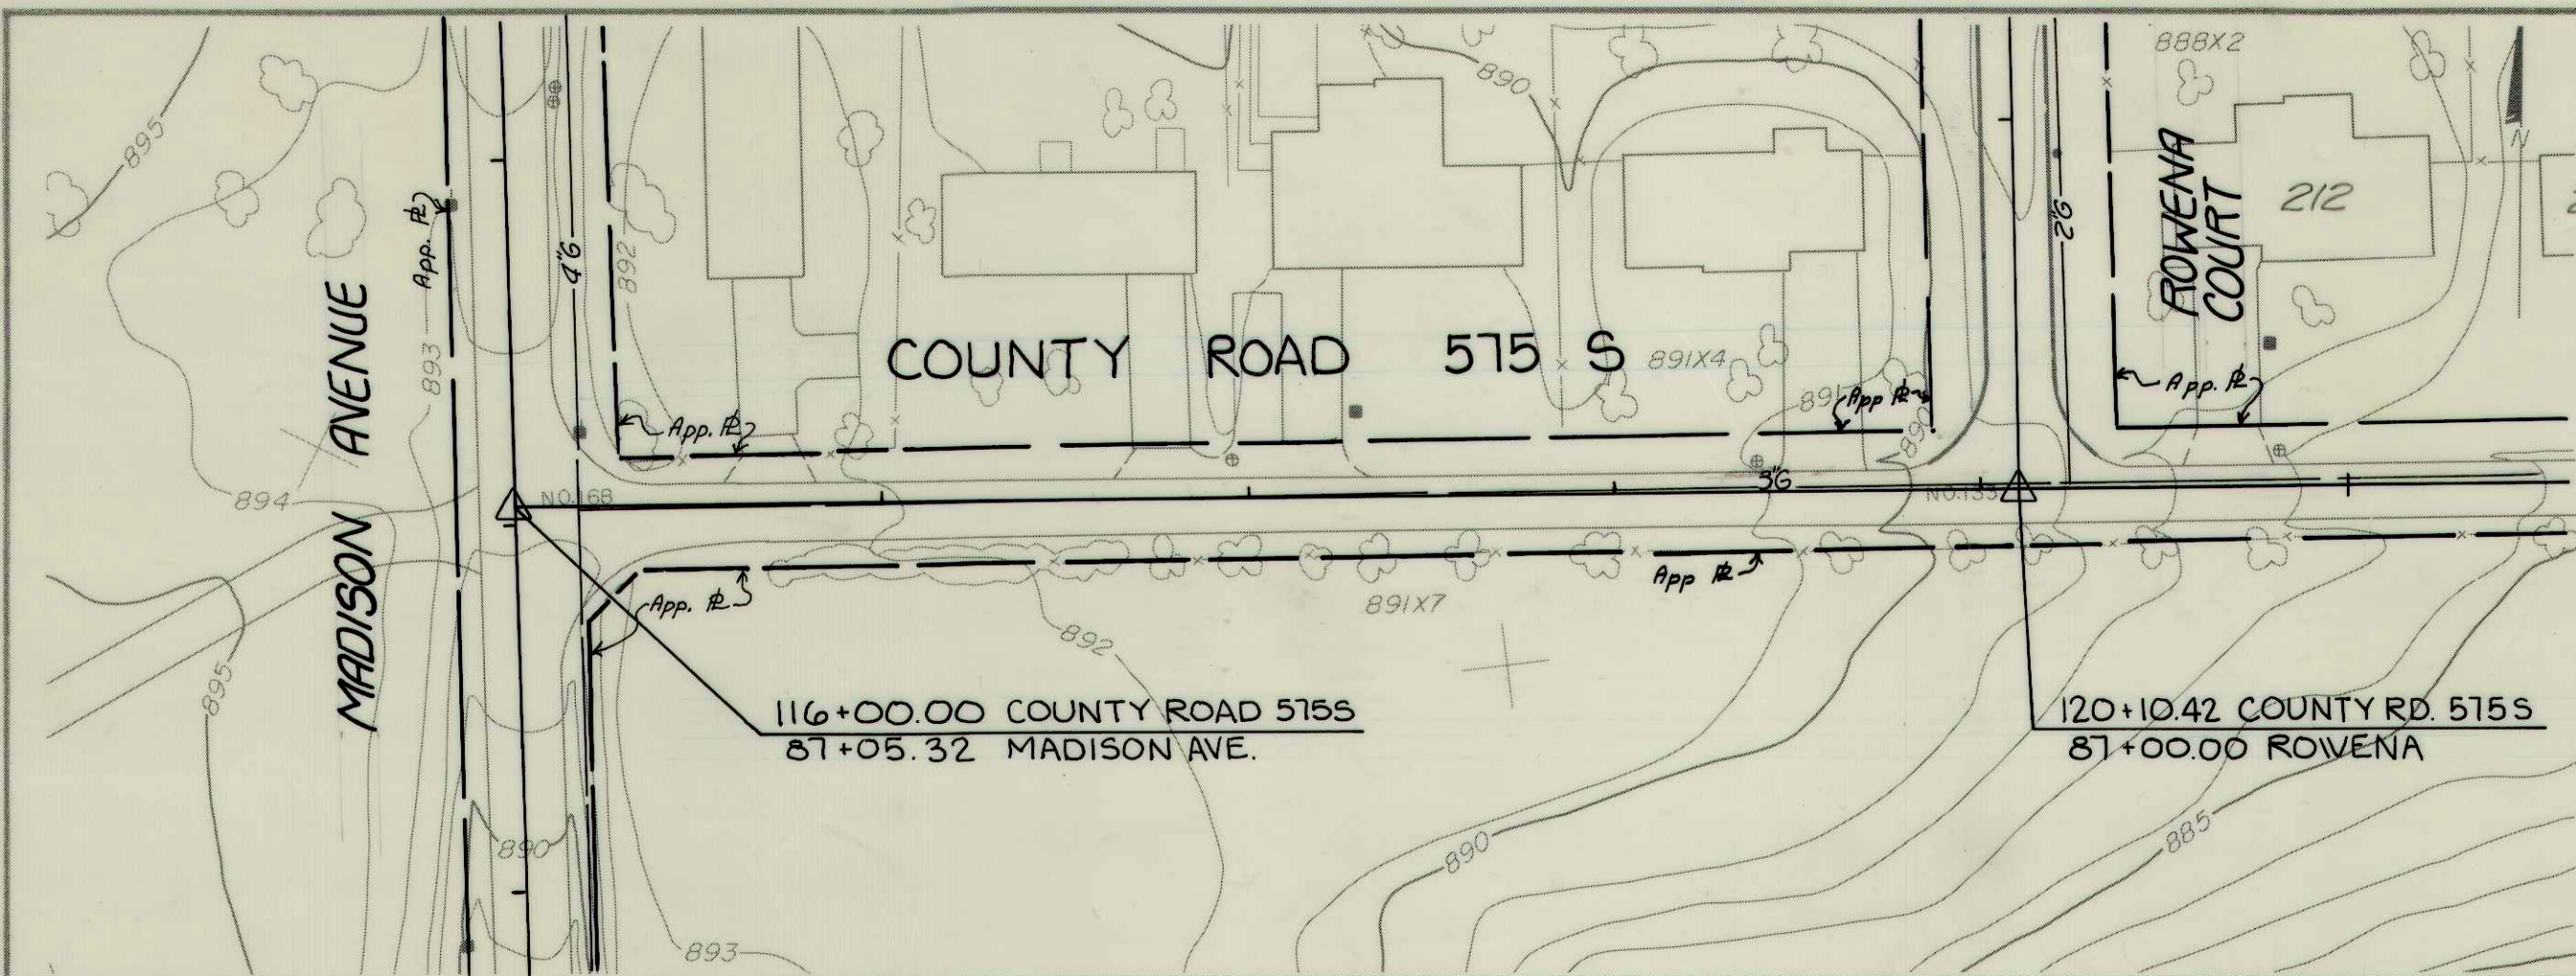


87+00.00 ROWENA CT
120+10.42 COUNTY RD 575 S

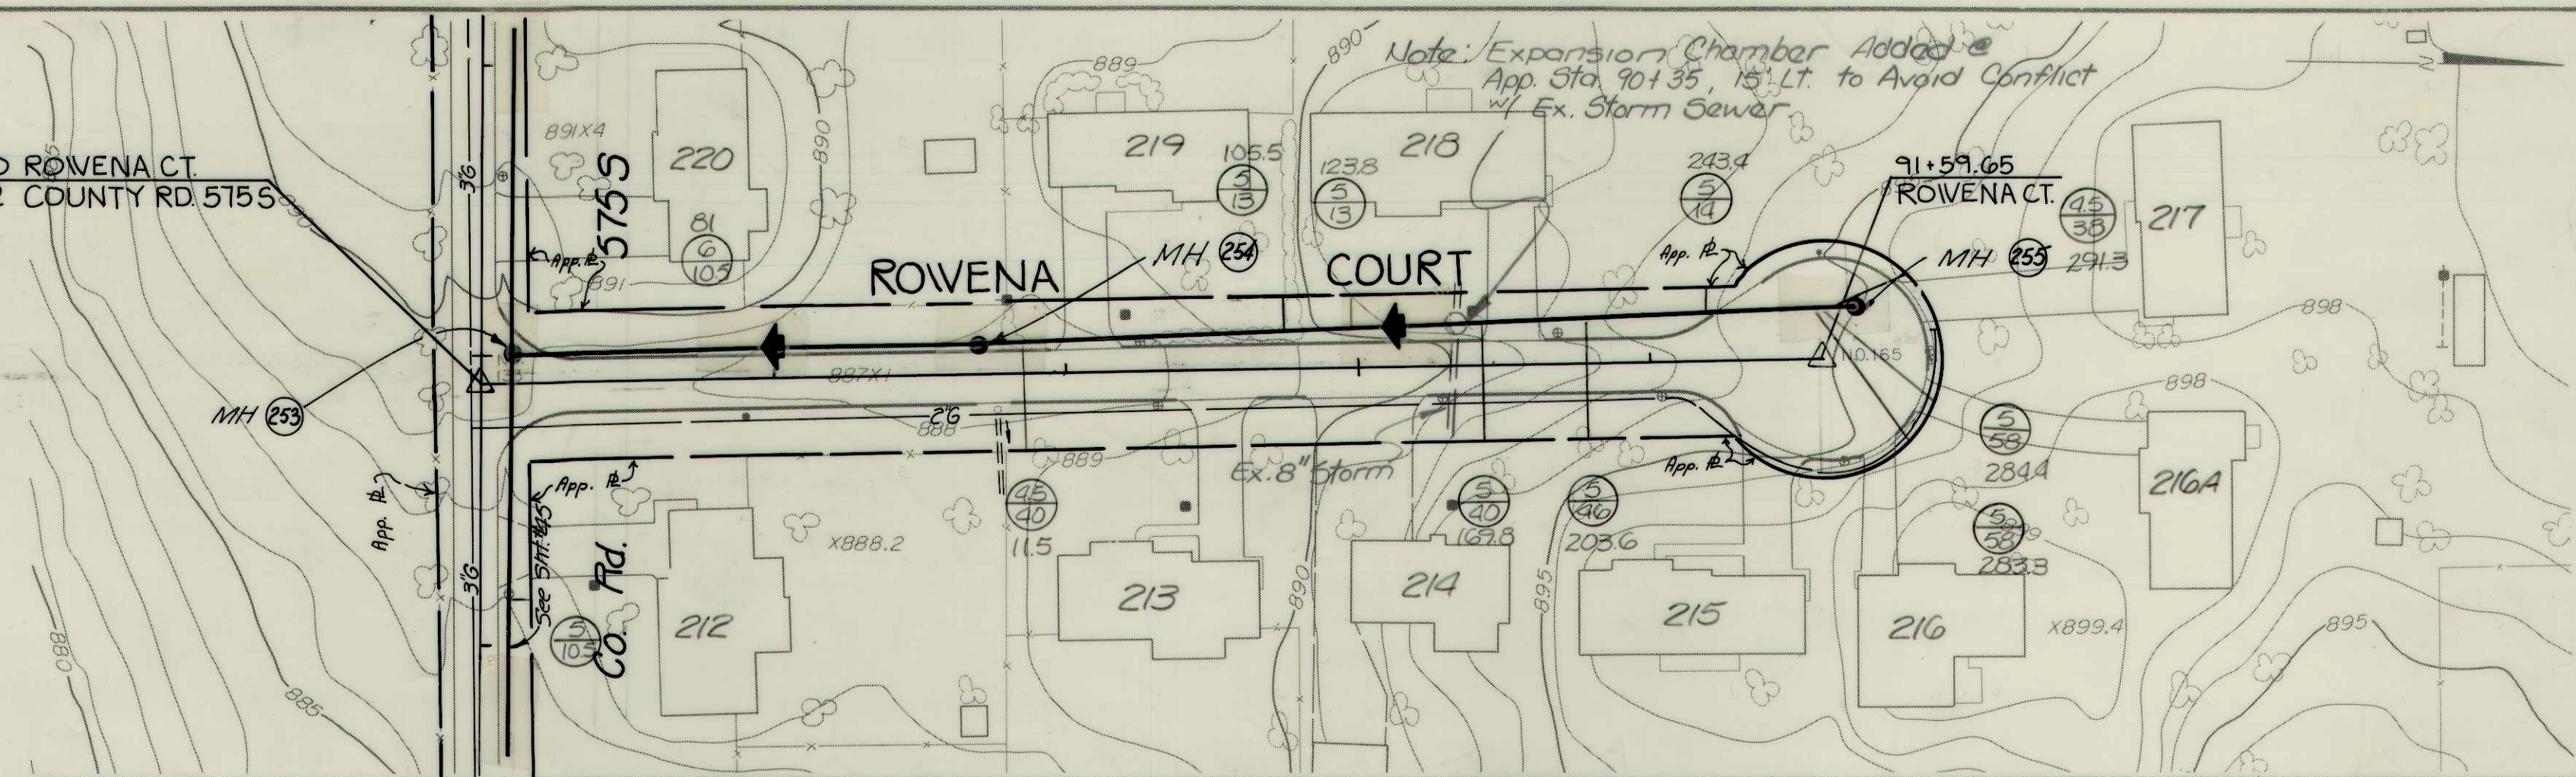


Note: Expansion Chamber Added @
App Sta. 90+35, 15' Lt. to Avoid Conflict
w/ Ex. Storm Sewer

VOID

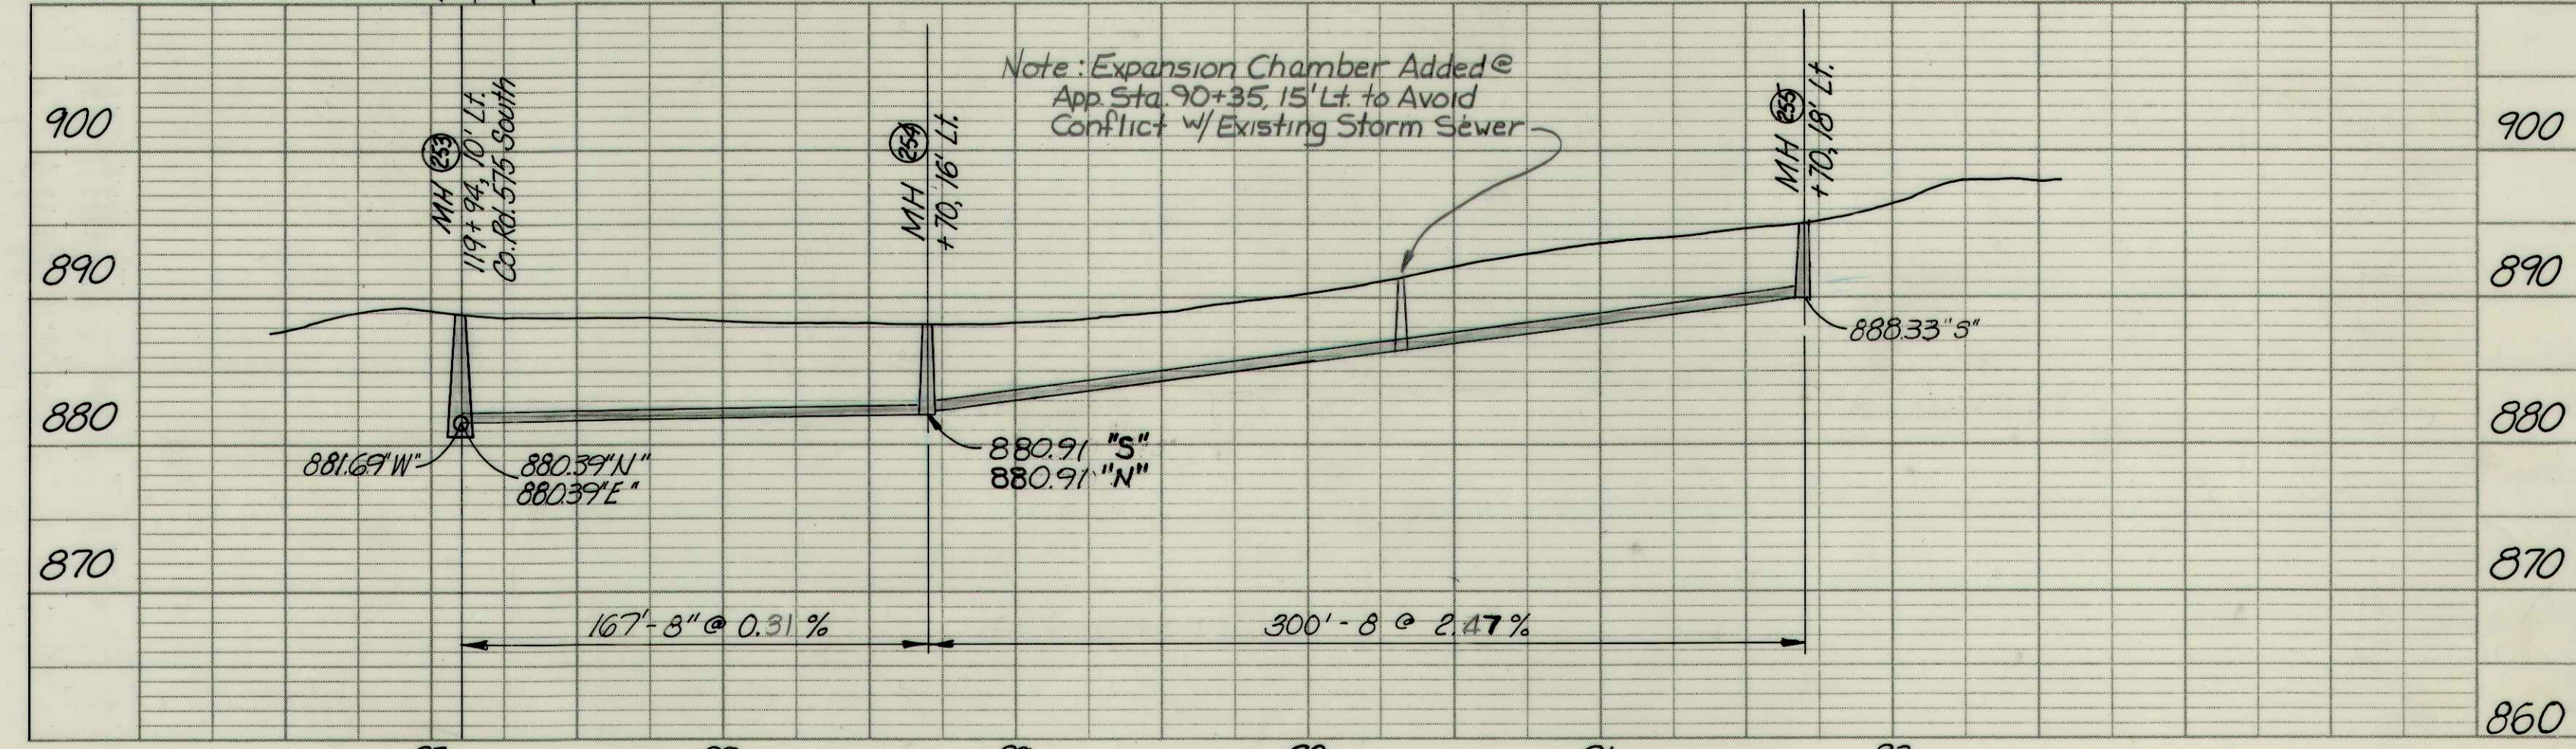


PROFILE	DATE	BY
	NO.	NO.
	NO.	NO.
	NO.	NO.

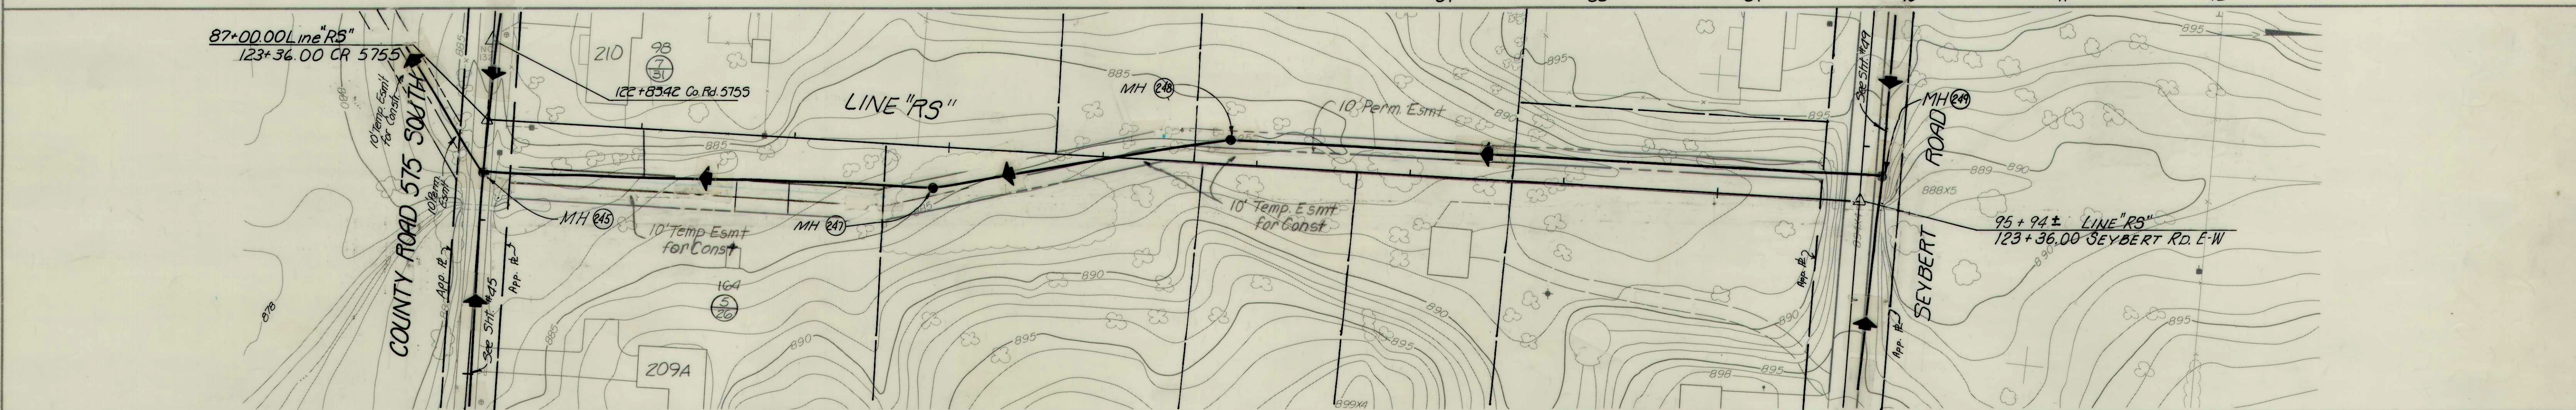

87+00.00 Line "RS"
123+36.00 CR 575 S

95+94 ± LINE "RS"
123+36.00 SEYBERT RD. E-W

Note: Remove & Replace 43' of Ex. 15" Sewer
e 96' Upstream from MH # 245 in direct Conflict
Remove & Replace 33' of Ex. 15" Sewer e 105'
Upstream from MH # 247 in direct Conflict.

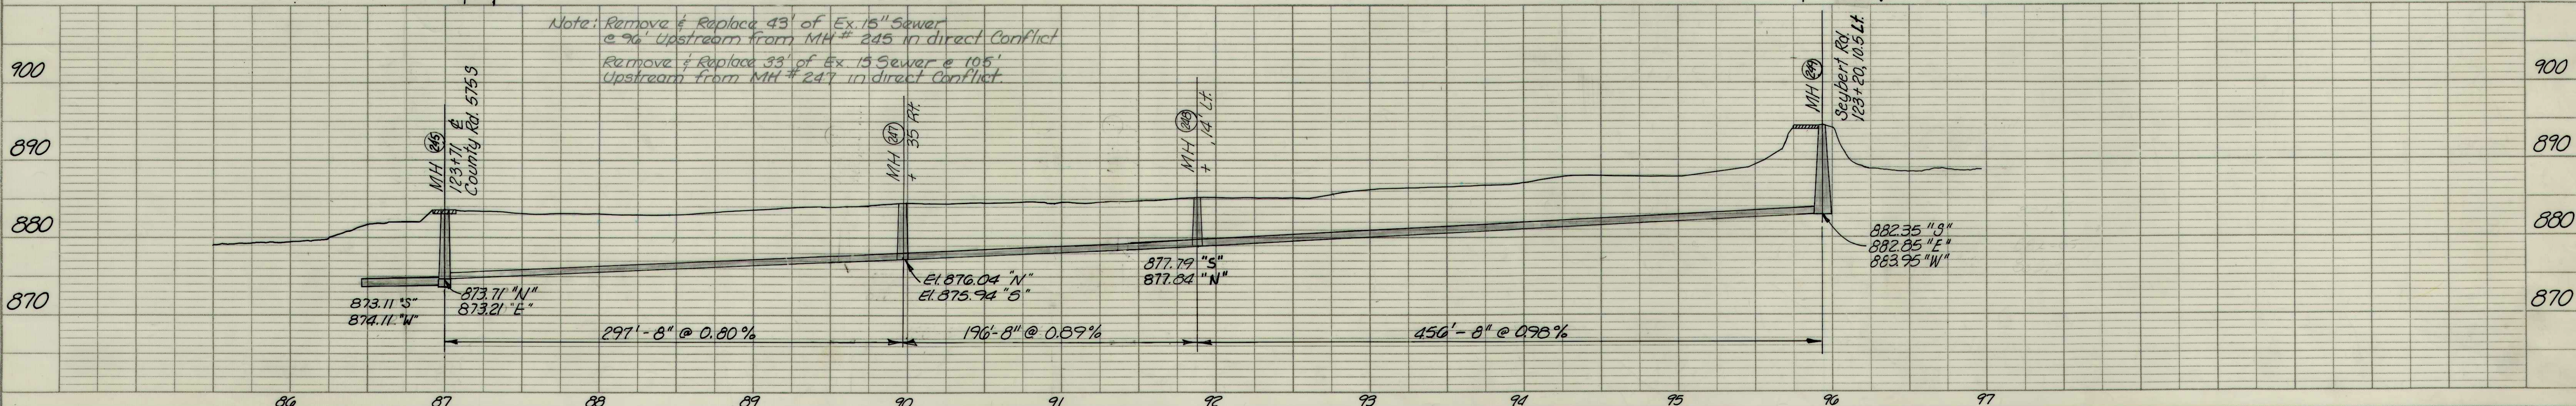

RECORD DRAWING



Co. Rd. 575 S / ROWENA CT. LINE "RS"	
FALL CREEK R.W.D. PLAN & PROFILE SHEET	
HORIZ. 1"=50'	BEAM, LONGEST & NEFF, INC. CONSULTING ENGINEERS INDIANAPOLIS, INDIANA
VERT. 1"=10'	48