

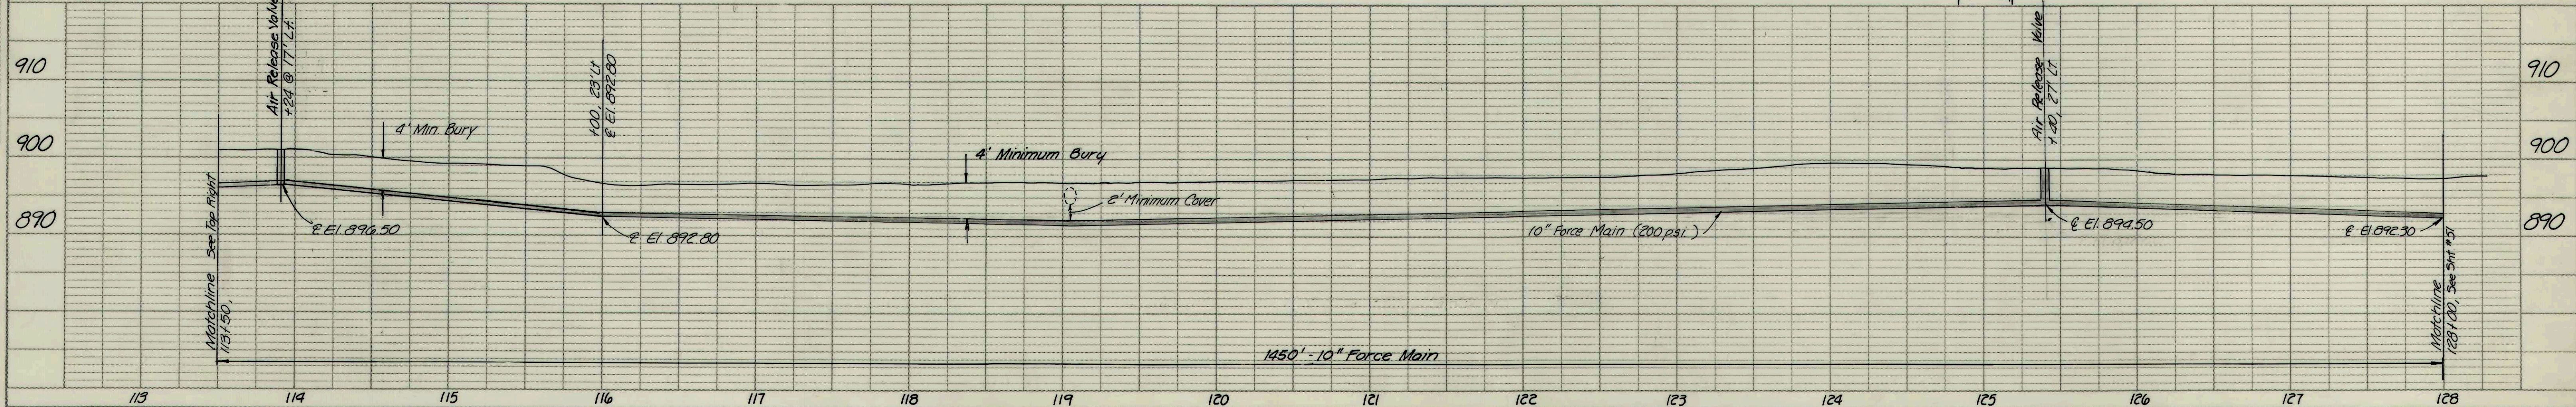
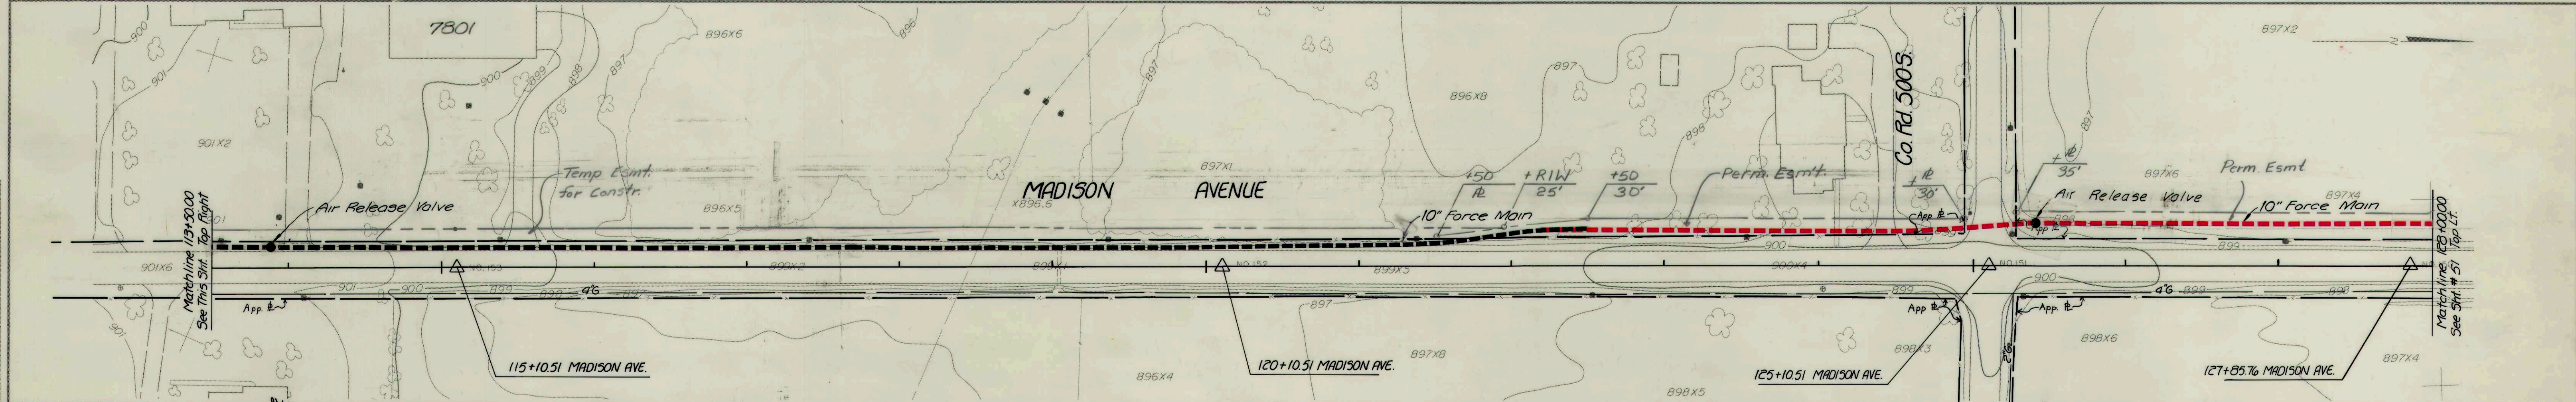


PLAN	SURVEYED	DATE
	PLOTTED	BY
	NOTES CHECKED	
	NO.	

PROFILE	SURVEYED	DATE
	PLOTTED	BY
	NOTES CHECKED	
	NO.	

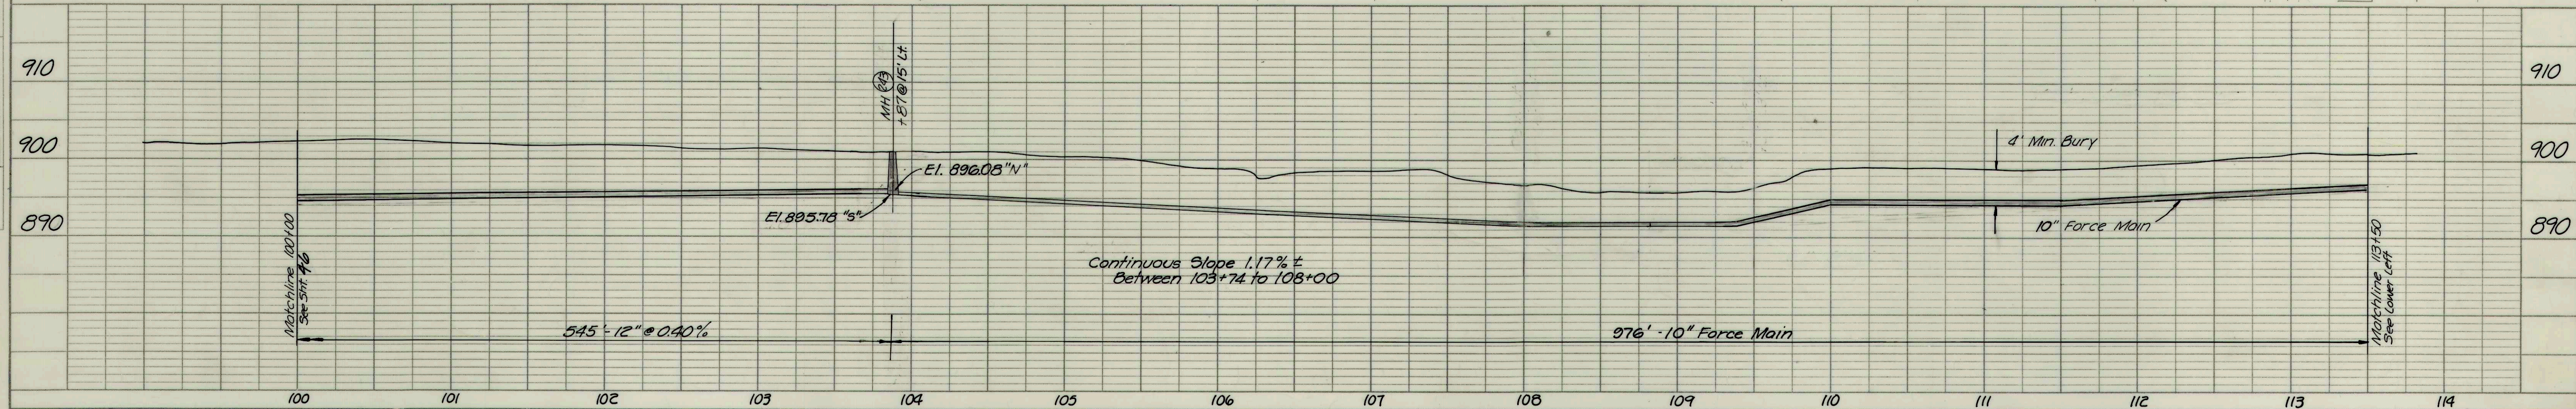

RECORD DRAWING

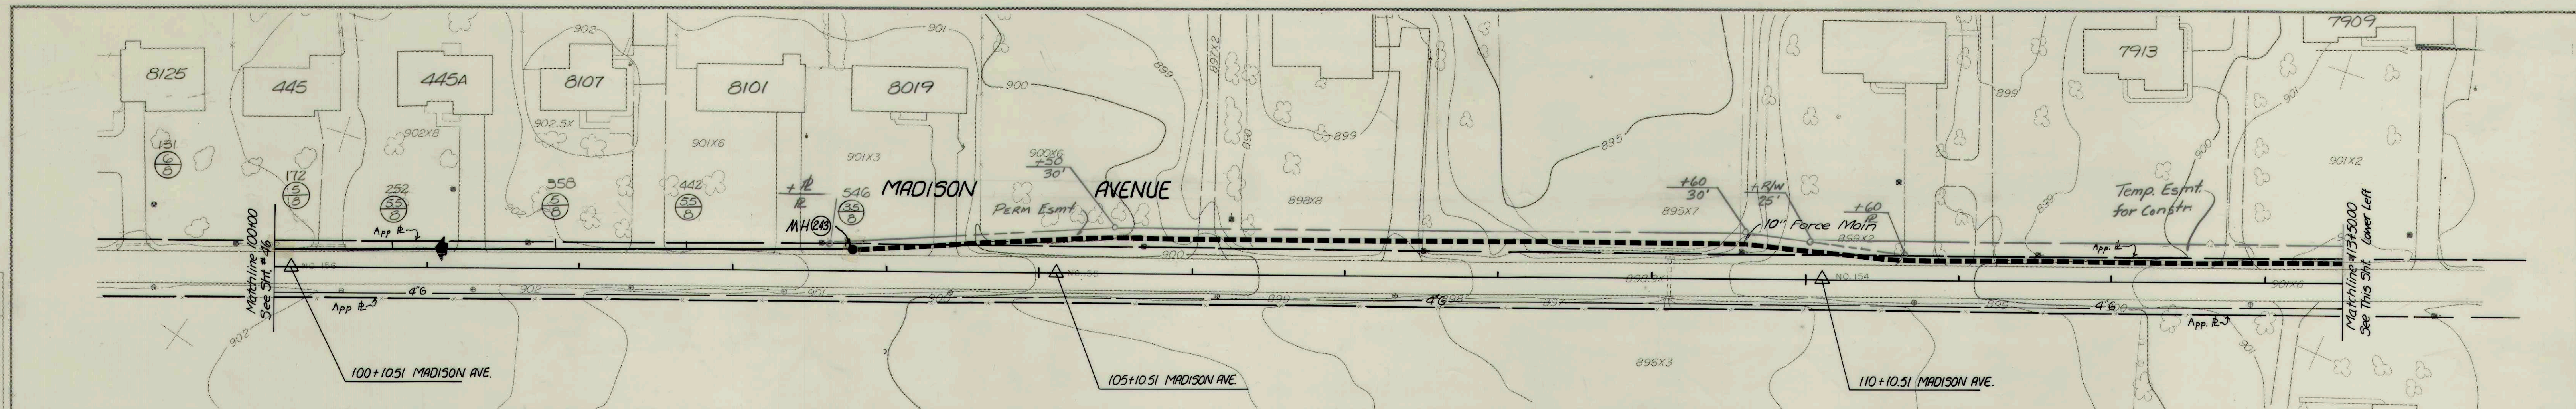

MADISON AVENUE	
FALL CREEK R.W.D. PLAN & PROFILE SHEET	
HORIZ. 1"=50'	BEAM, LONGST & NEFF, INC.
VERT. 1"=10'	CONSULTING ENGINEERS
	INDIANAPOLIS, INDIANA
	50