



PLAN	SUBMITTED	DATE
NO.	DATE	DATE
NO.	DATE	DATE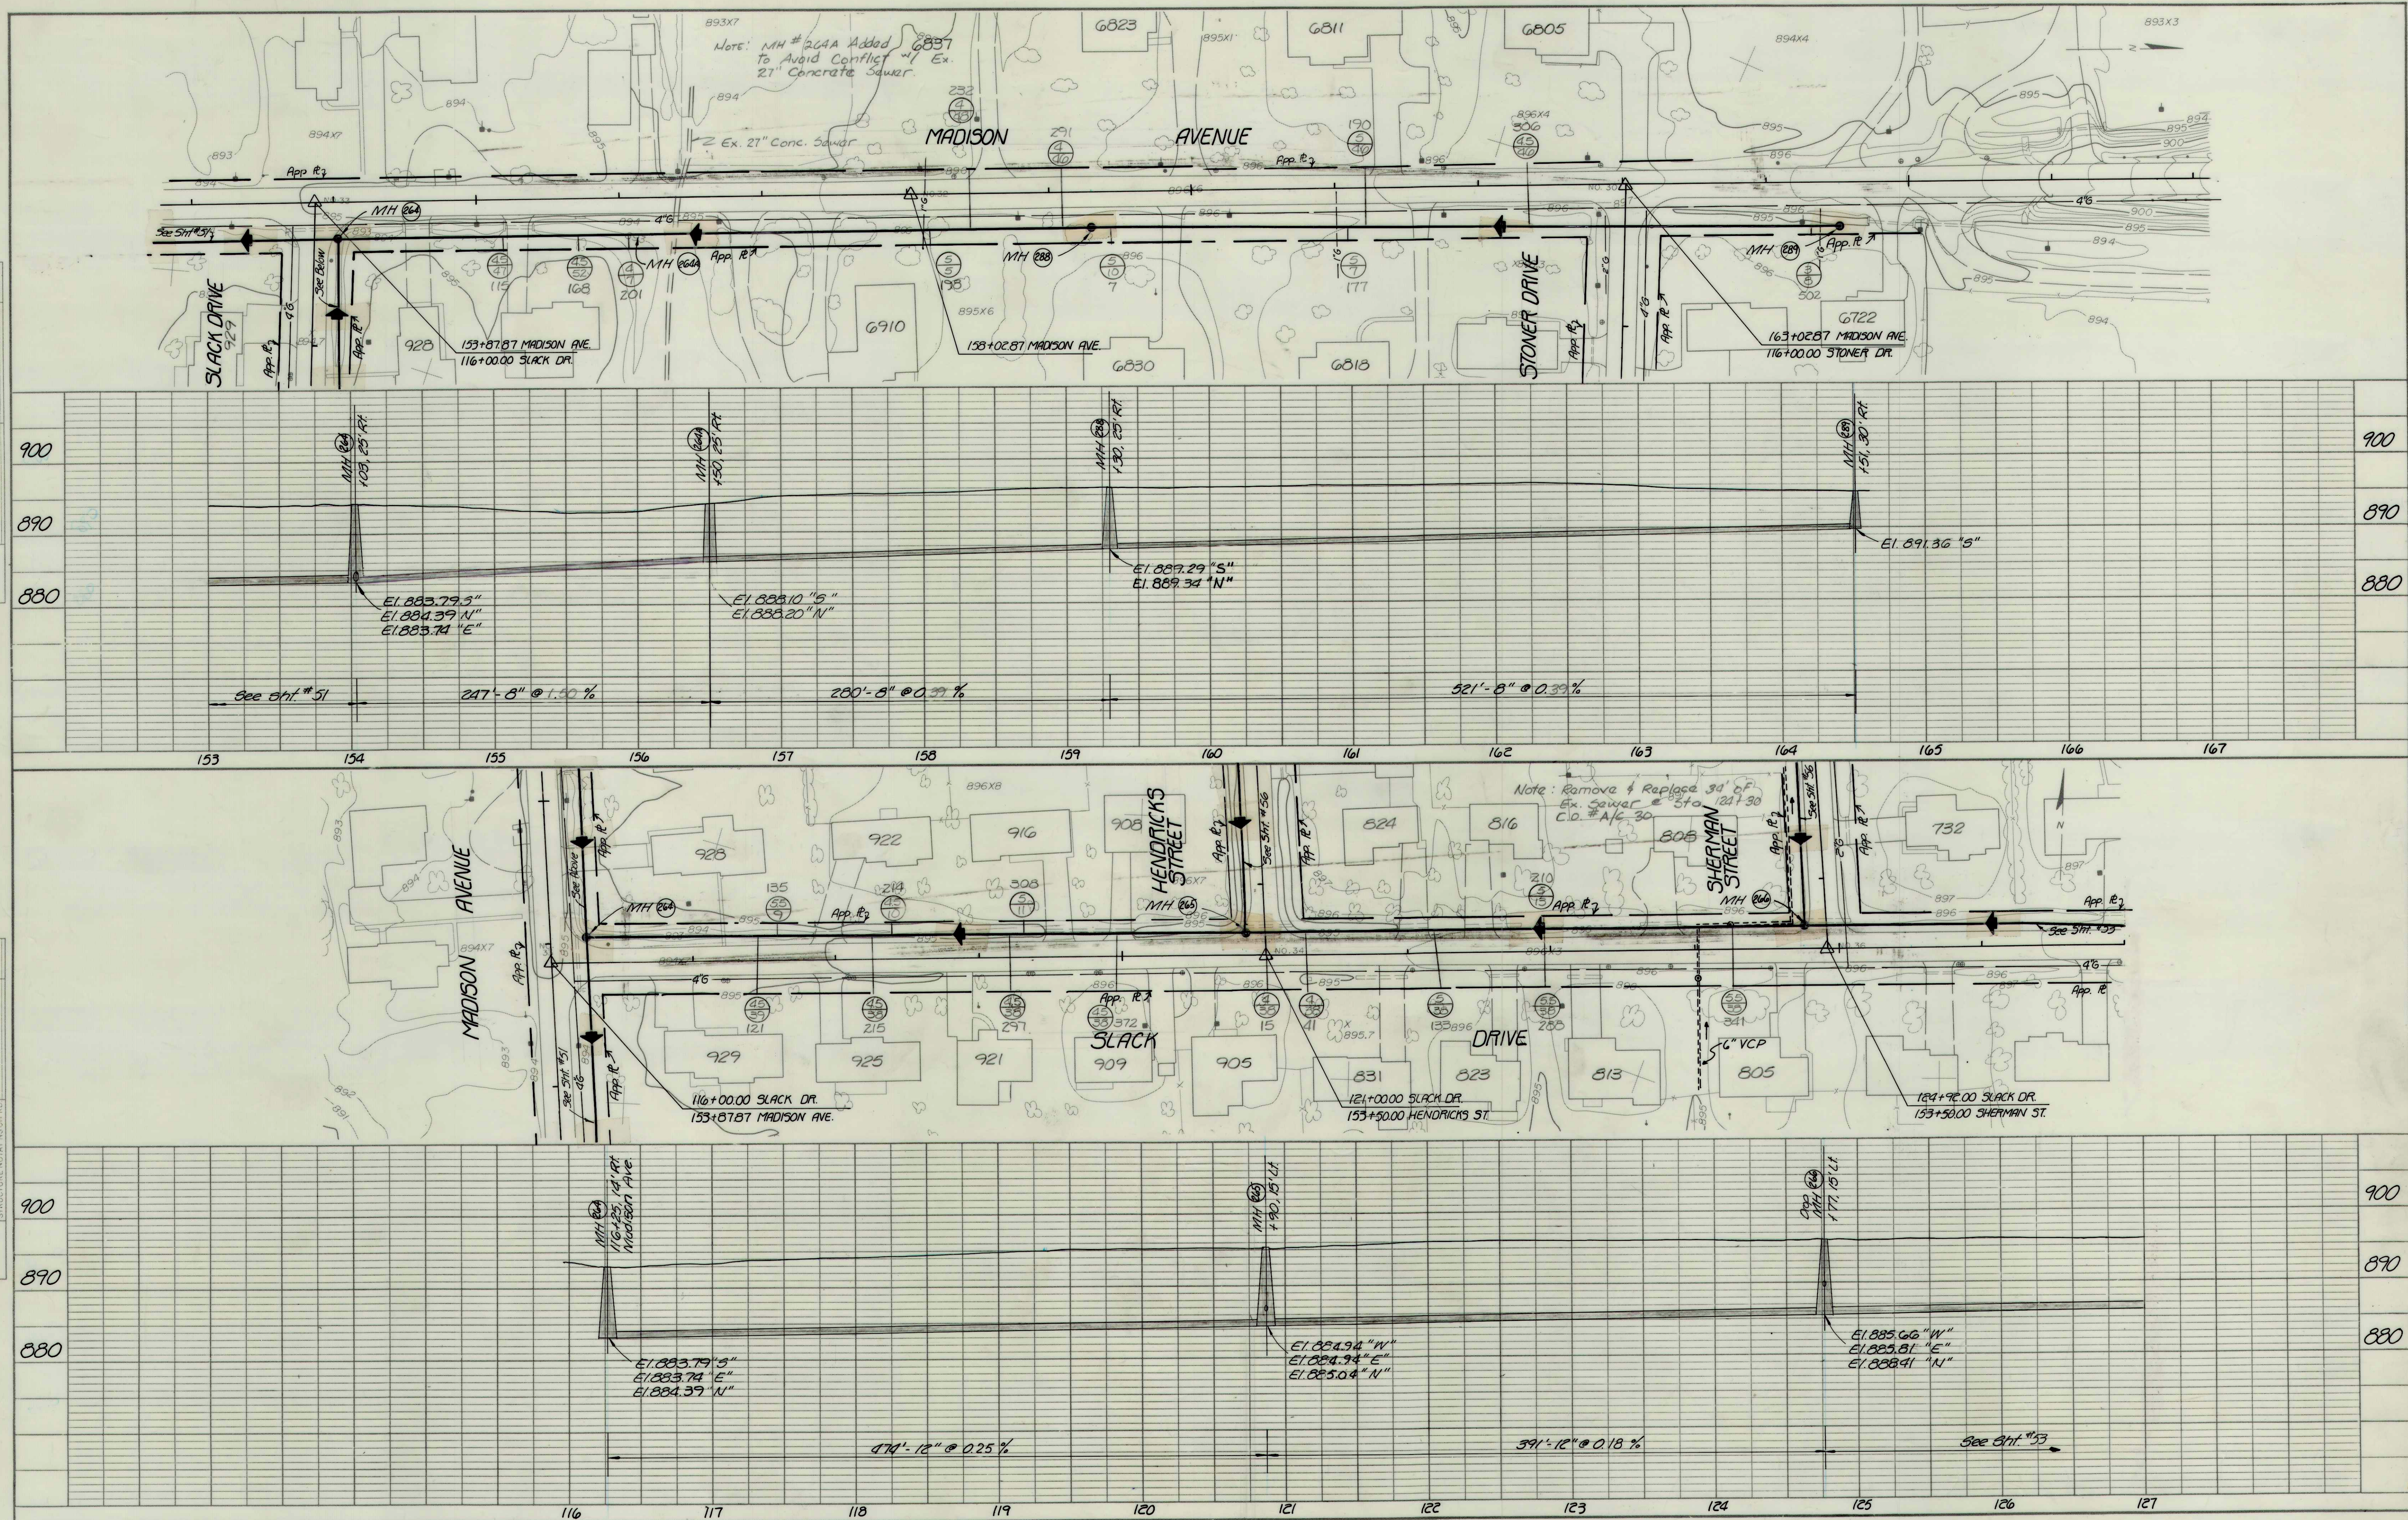
RECORD DRAWING

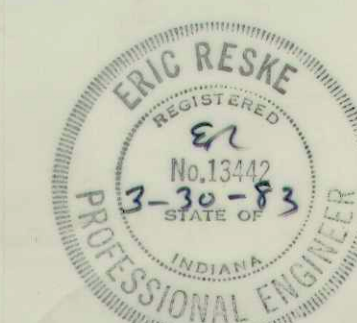

MADISON AVE / SLACK DR.	
FALL CREEK R.W.D. PLAN & PROFILE	SHEET
HORIZ. 1"=50'	BEAM, LONGEST & NEFF, INC.
VERT. 1"=10'	CONSULTING ENGINEERS
	INDIANAPOLIS, INDIANA
	52