



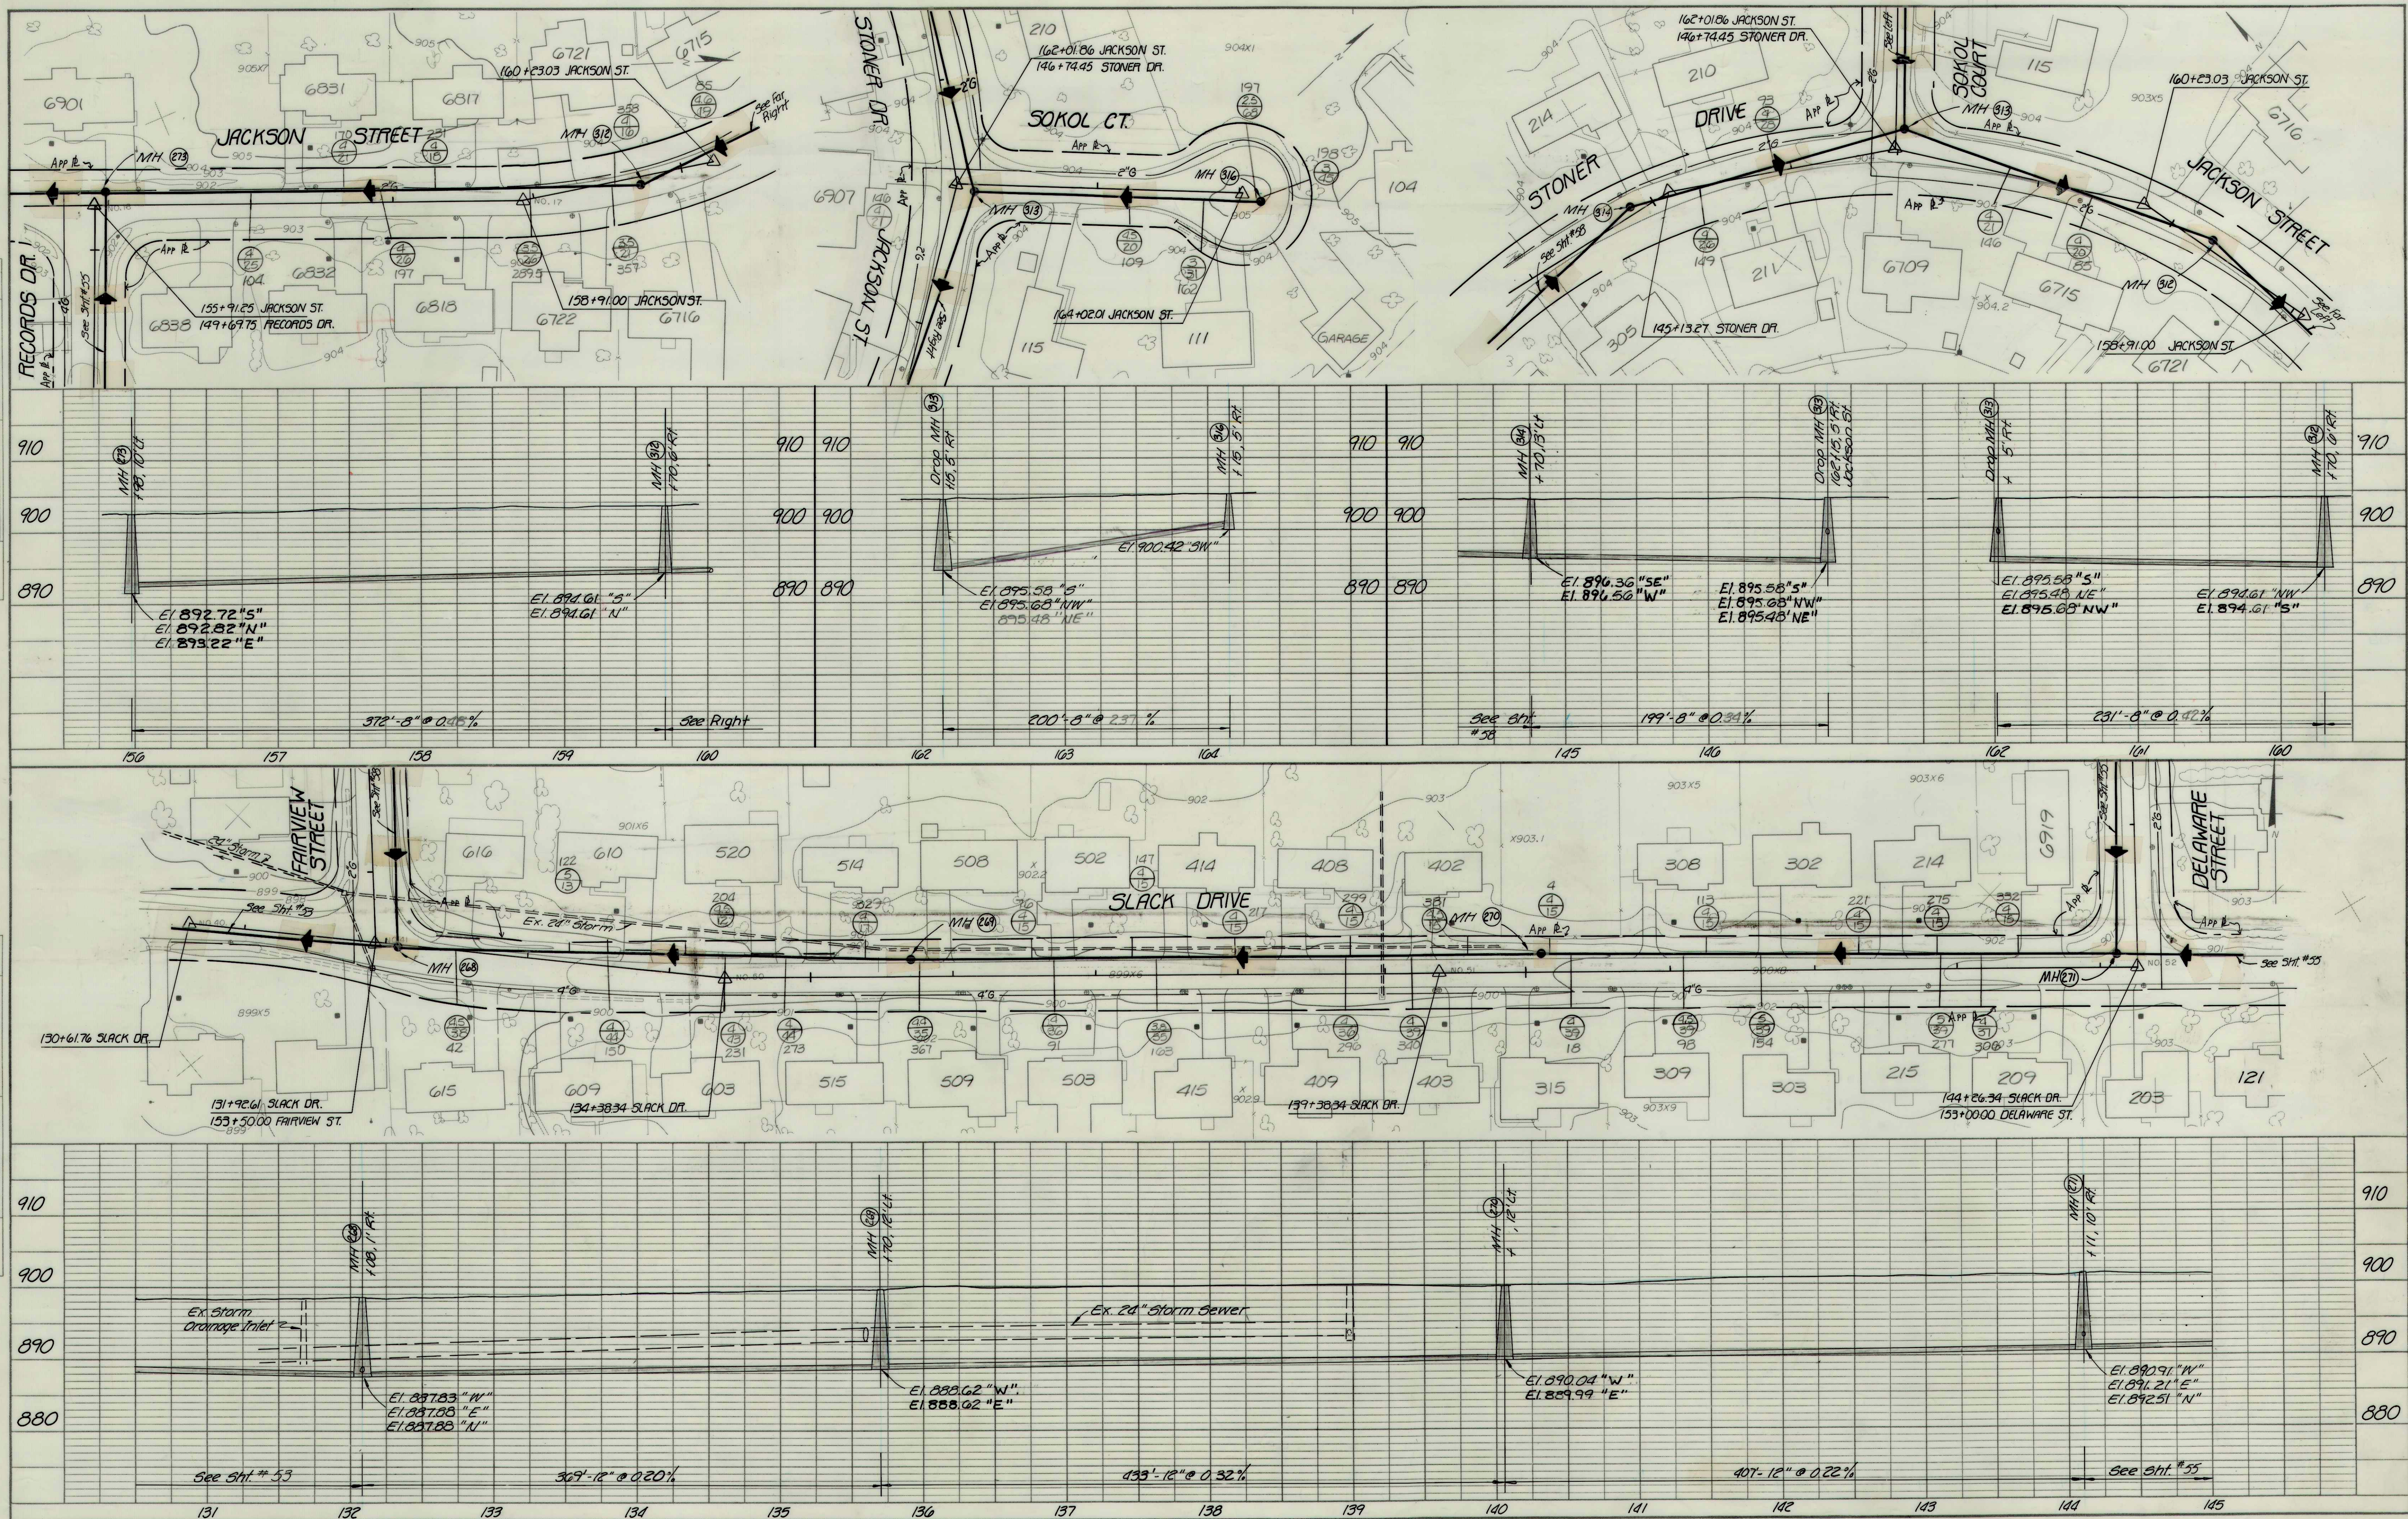

RECORD DRAWING

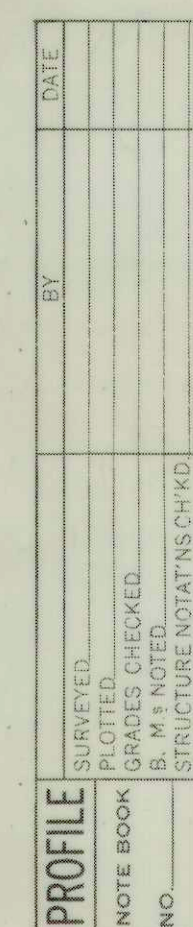

JACKSON ST / STONER DR. SLACK DR.			
FALL CREEK R.W.D. PLAN & PROFILE			SHEET
HORIZ. 1"=50'	BEAM, LONGEST & NEFF, INC.		54
VERT. 1"=10'	CONSULTING ENGINEERS INDIANAPOLIS, INDIANA		