


PLAN	DATE	BY
	SURVEYED	
	PLOTTED	
	NOTE BOOK NO.	

PROFILE	DATE	BY
	SURVEYED	
	PLOTTED	
	NOTE BOOK NO.	



RECORD DRAWING

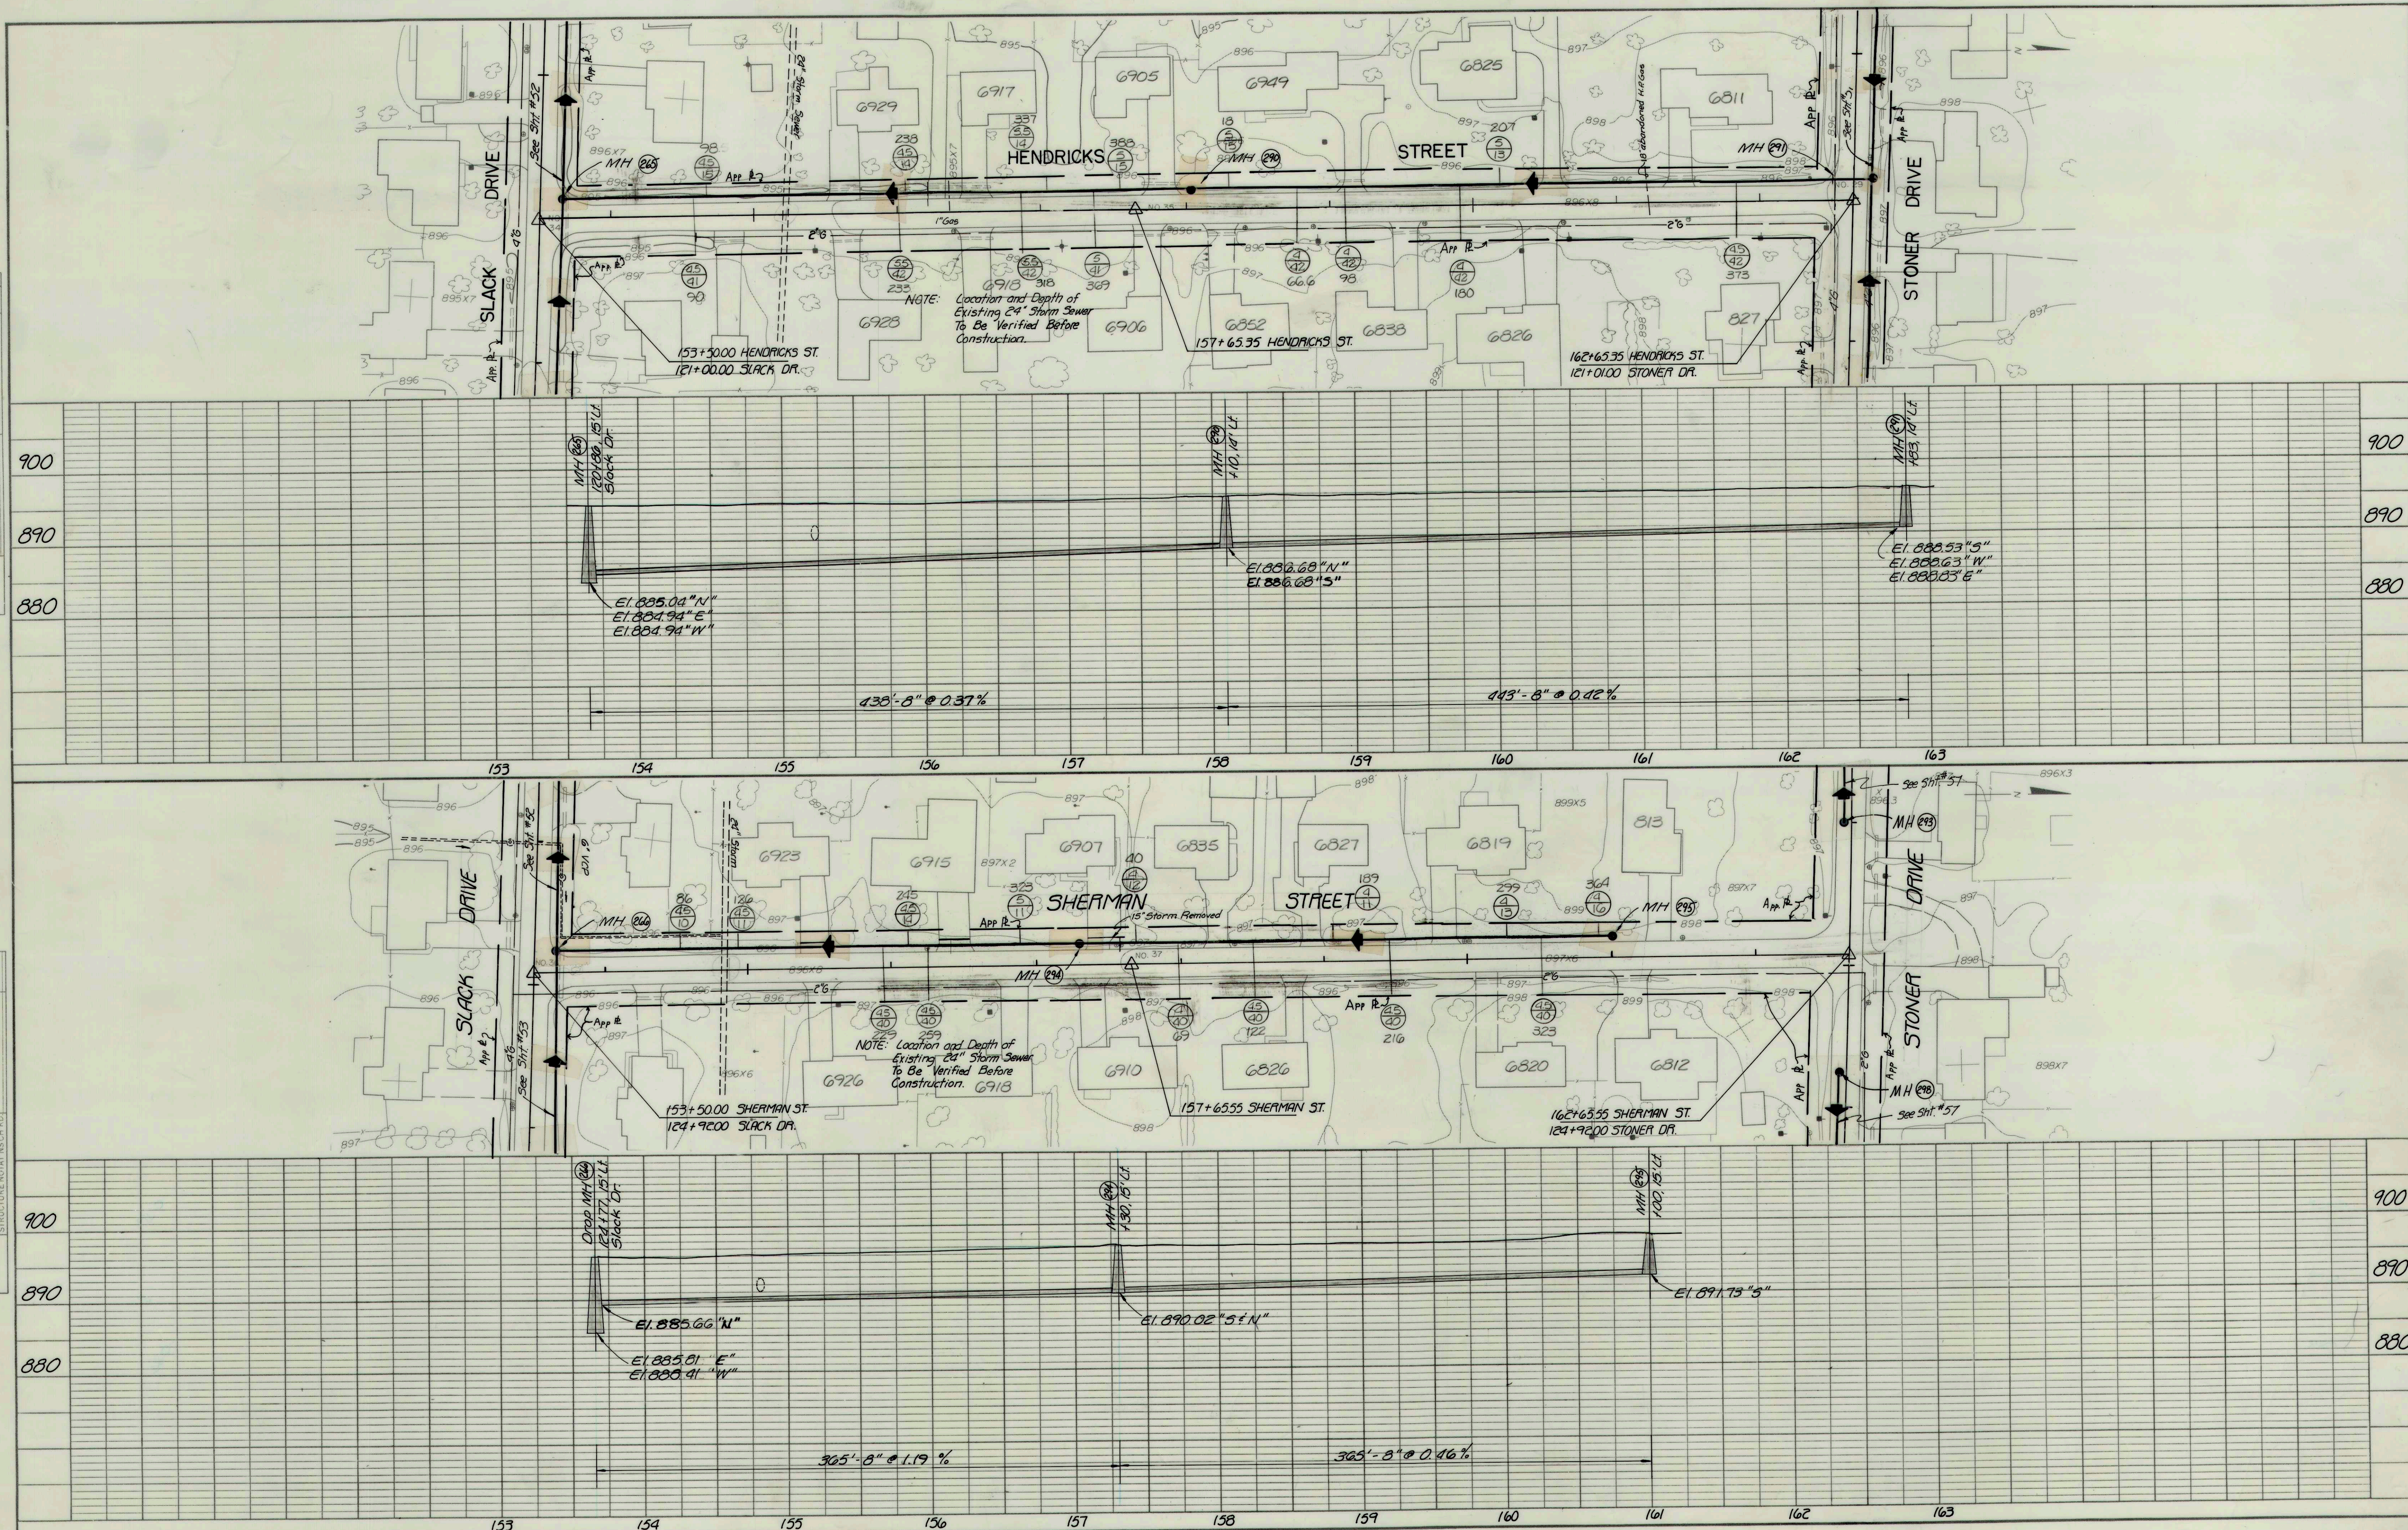

HENDRICKS ST/ SHERMAN ST.
FALL CREEK R.W.D. PLAN & PROFILE SHEET
HORIZ. 1"=50'
VERT. 1"=10'
BEAM, LONGEST & NEFF, INC.
CONSULTING ENGINEERS
INDIANAPOLIS, INDIANA