



PLAN	DATE	
	BY	
	REVISIONS	
	NOTES	

PROFILE	DATE	
	BY	
	REVISIONS	
	NOTES	

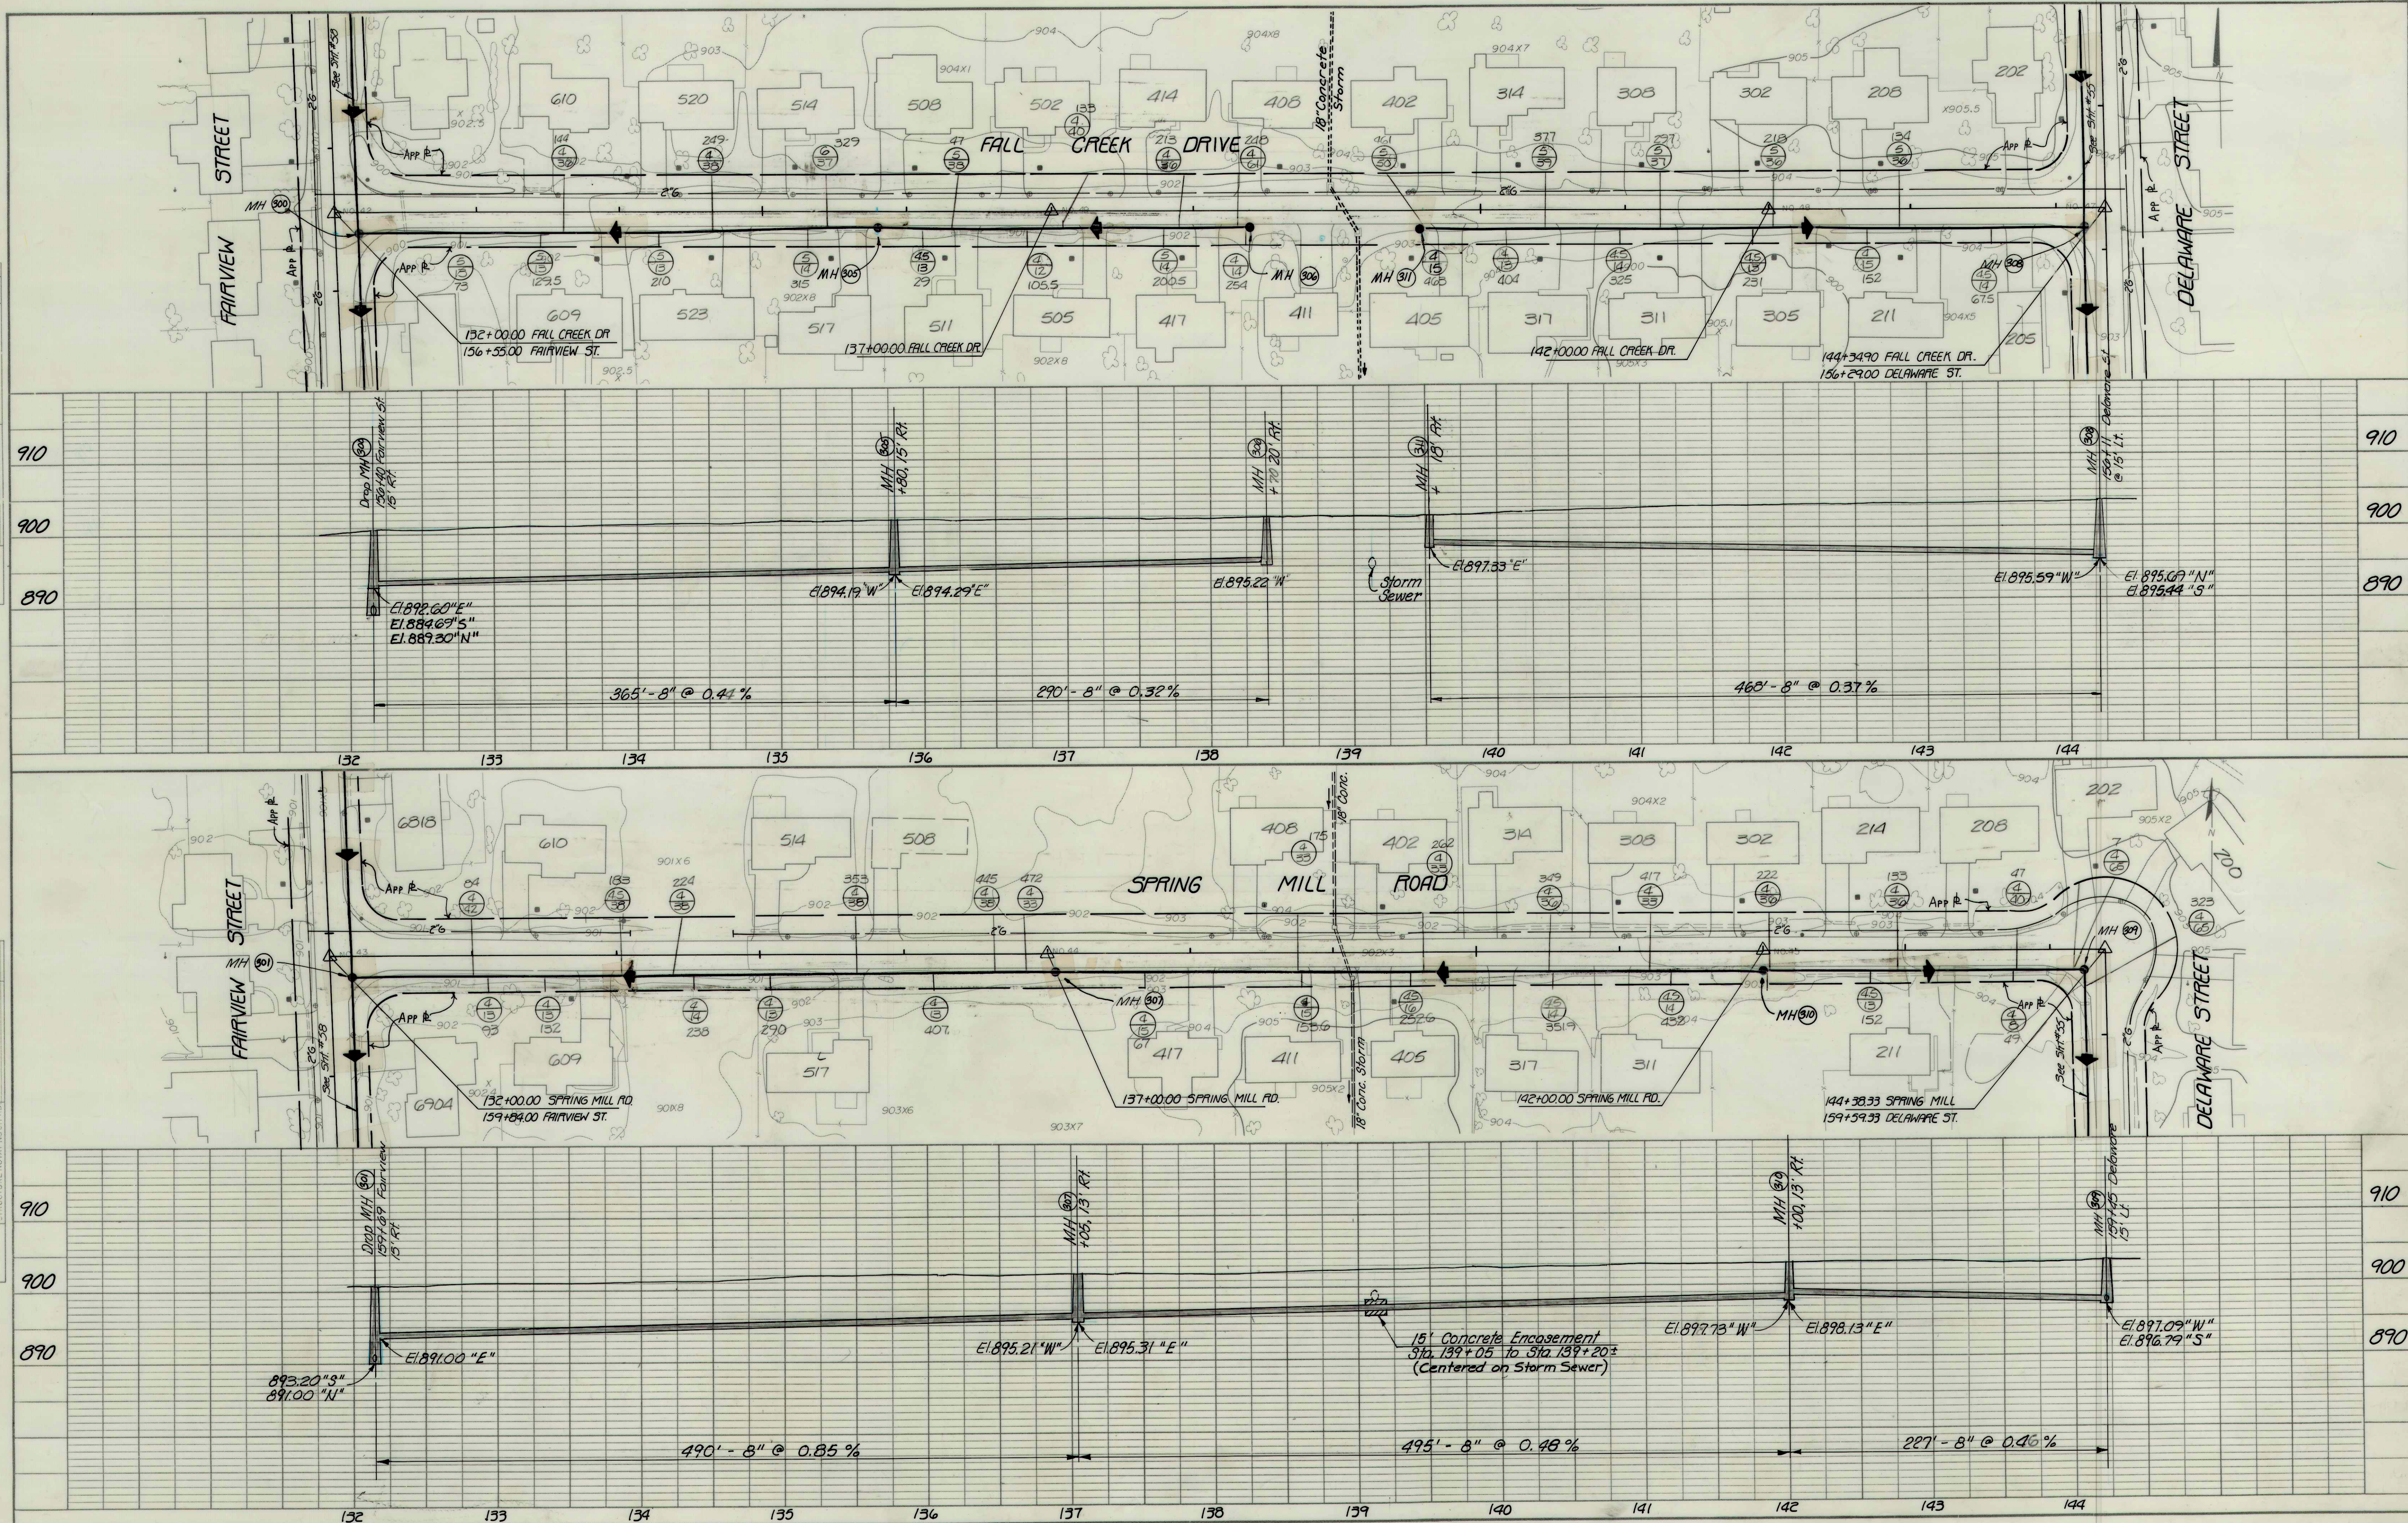

RECORD DRAWING

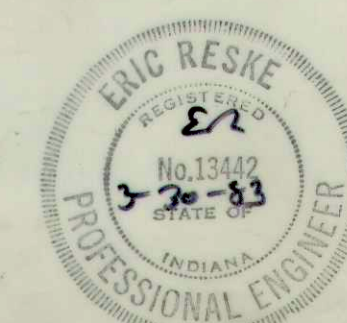

FALL CREEK DR./SPRING MILL RD.
 FALL CREEK R.W.D. PLAN & PROFILE SHEET
 HORIZ. 1"=50'
 VERT. 1"=10'
 BEAM, LONGEST & NEFF, INC.
 CONSULTING ENGINEERS
 INDIANAPOLIS, INDIANA
59