

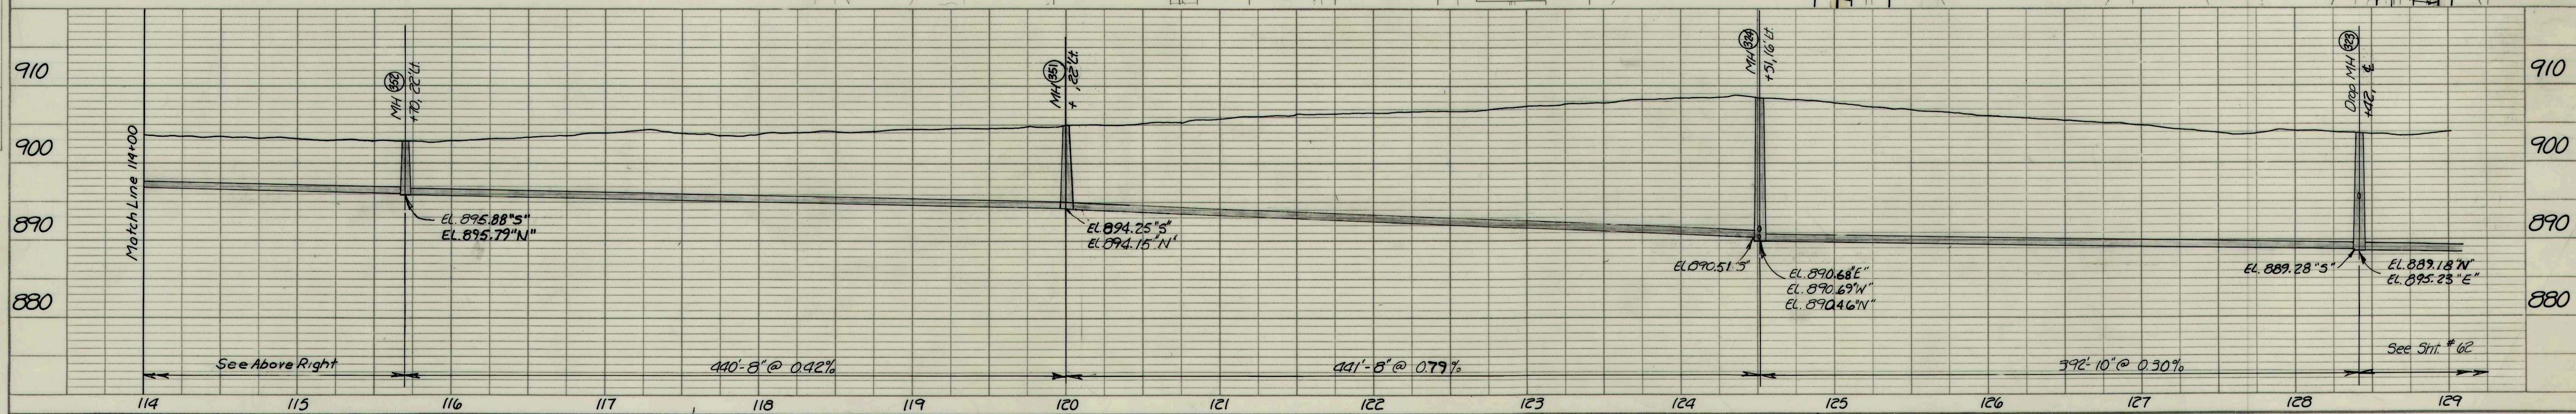
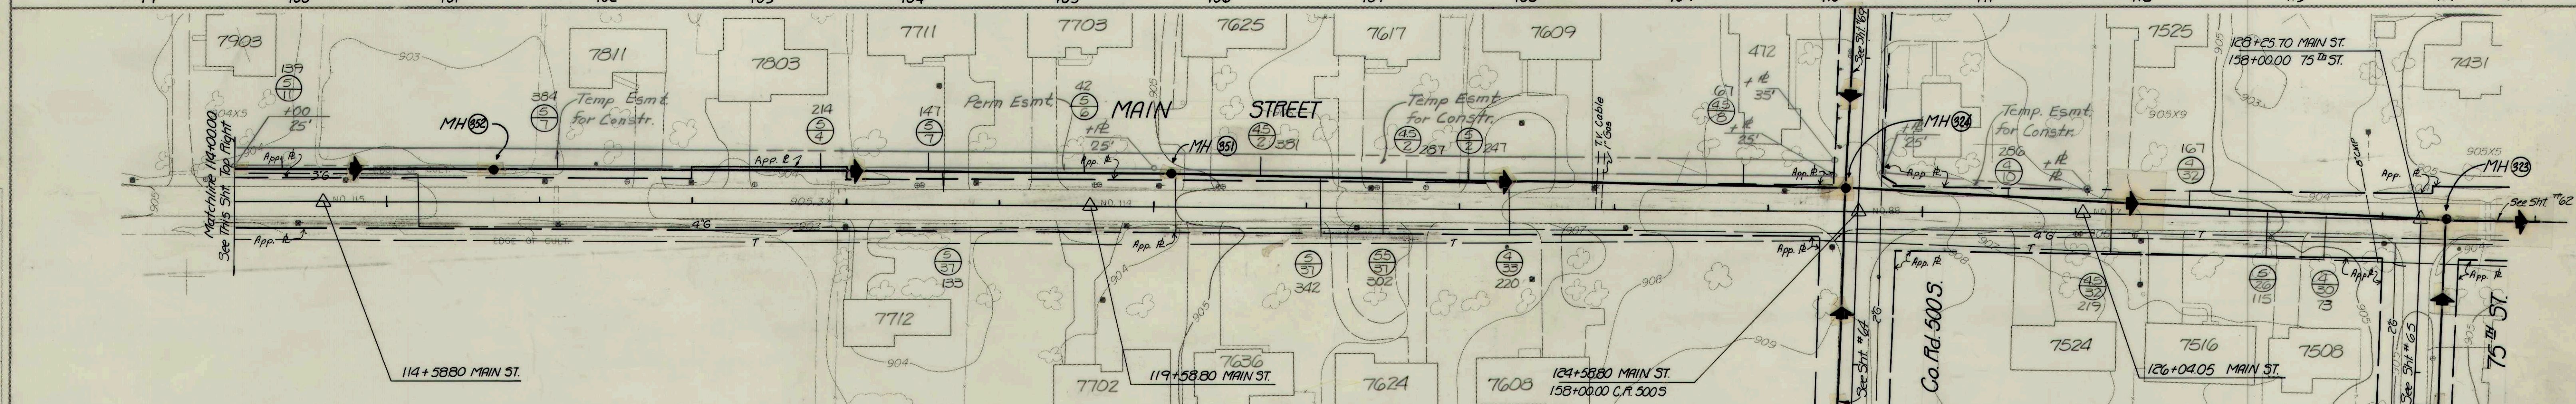


DATE: _____ BY: _____
 PLAN SURVEYED: _____
 PLOTTED: _____
 NOTE BOOK: _____
 NO. OF MAP SHEETS: _____

DATE: _____ BY: _____
 PROFILE SURVEYED: _____
 PLOTTED: _____
 NOTE BOOK: _____
 NO. OF MAP SHEETS: _____

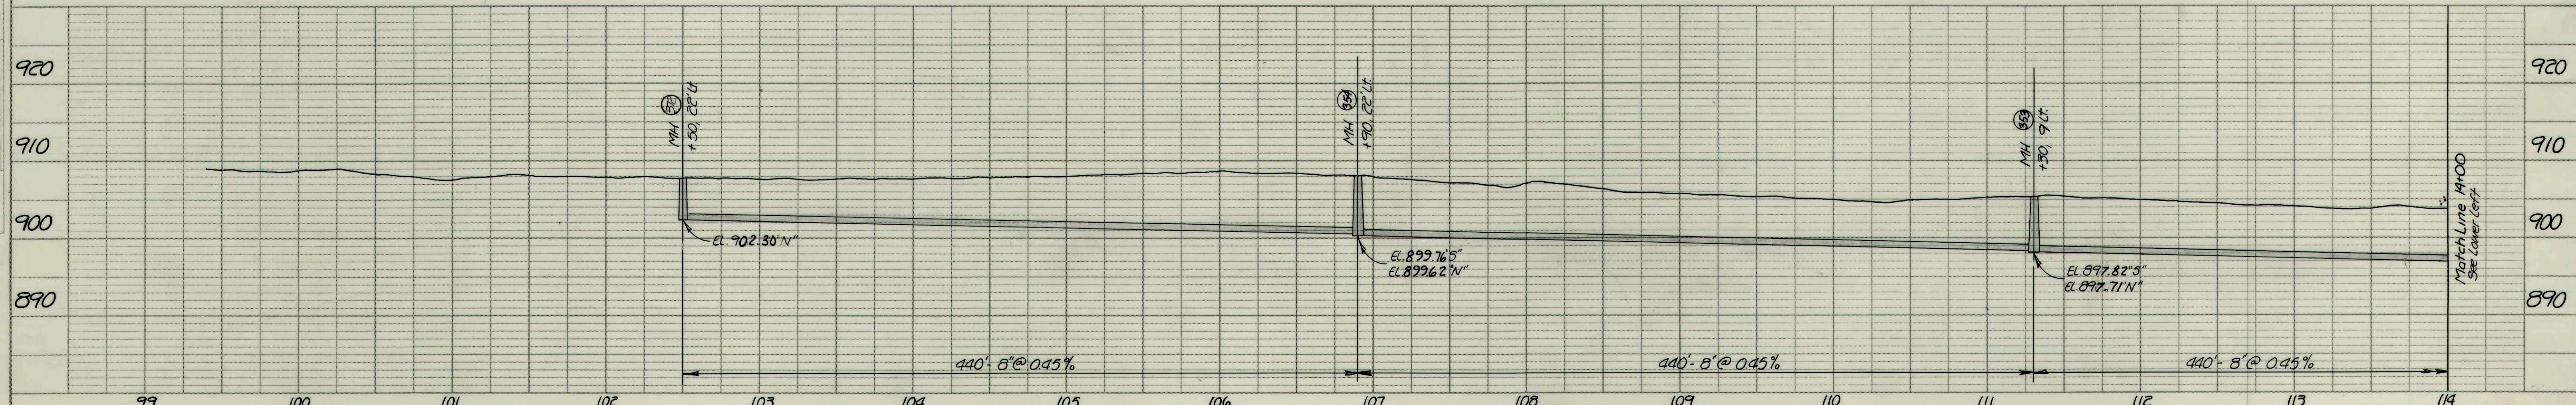

RECORD DRAWING

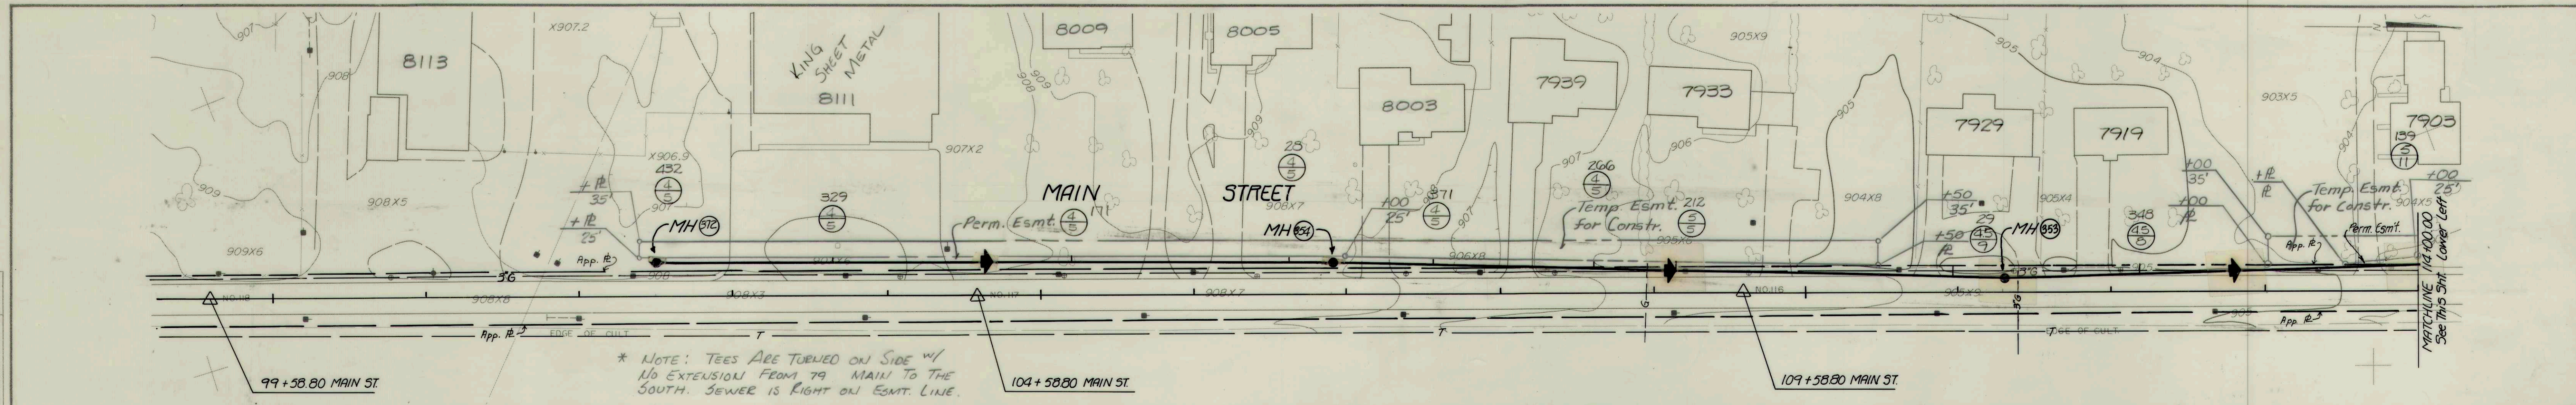

MAIN STREET
 FALL CREEK R.W.D. PLAN & PROFILE SHEET
 HORIZ. 1"=50' BEAM, LONGEST & NEFF, INC.
 VERT. 1"=10' CONSULTING ENGINEERS
 INDIANAPOLIS, INDIANA 63