


PLAN
 SURVEYED
 PLOTTED
 ALIGNED
 CHECKED
 NO. 10

PROFILE
 SURVEYED
 PLOTTED
 CHECKED
 NO. 10



RECORD DRAWING

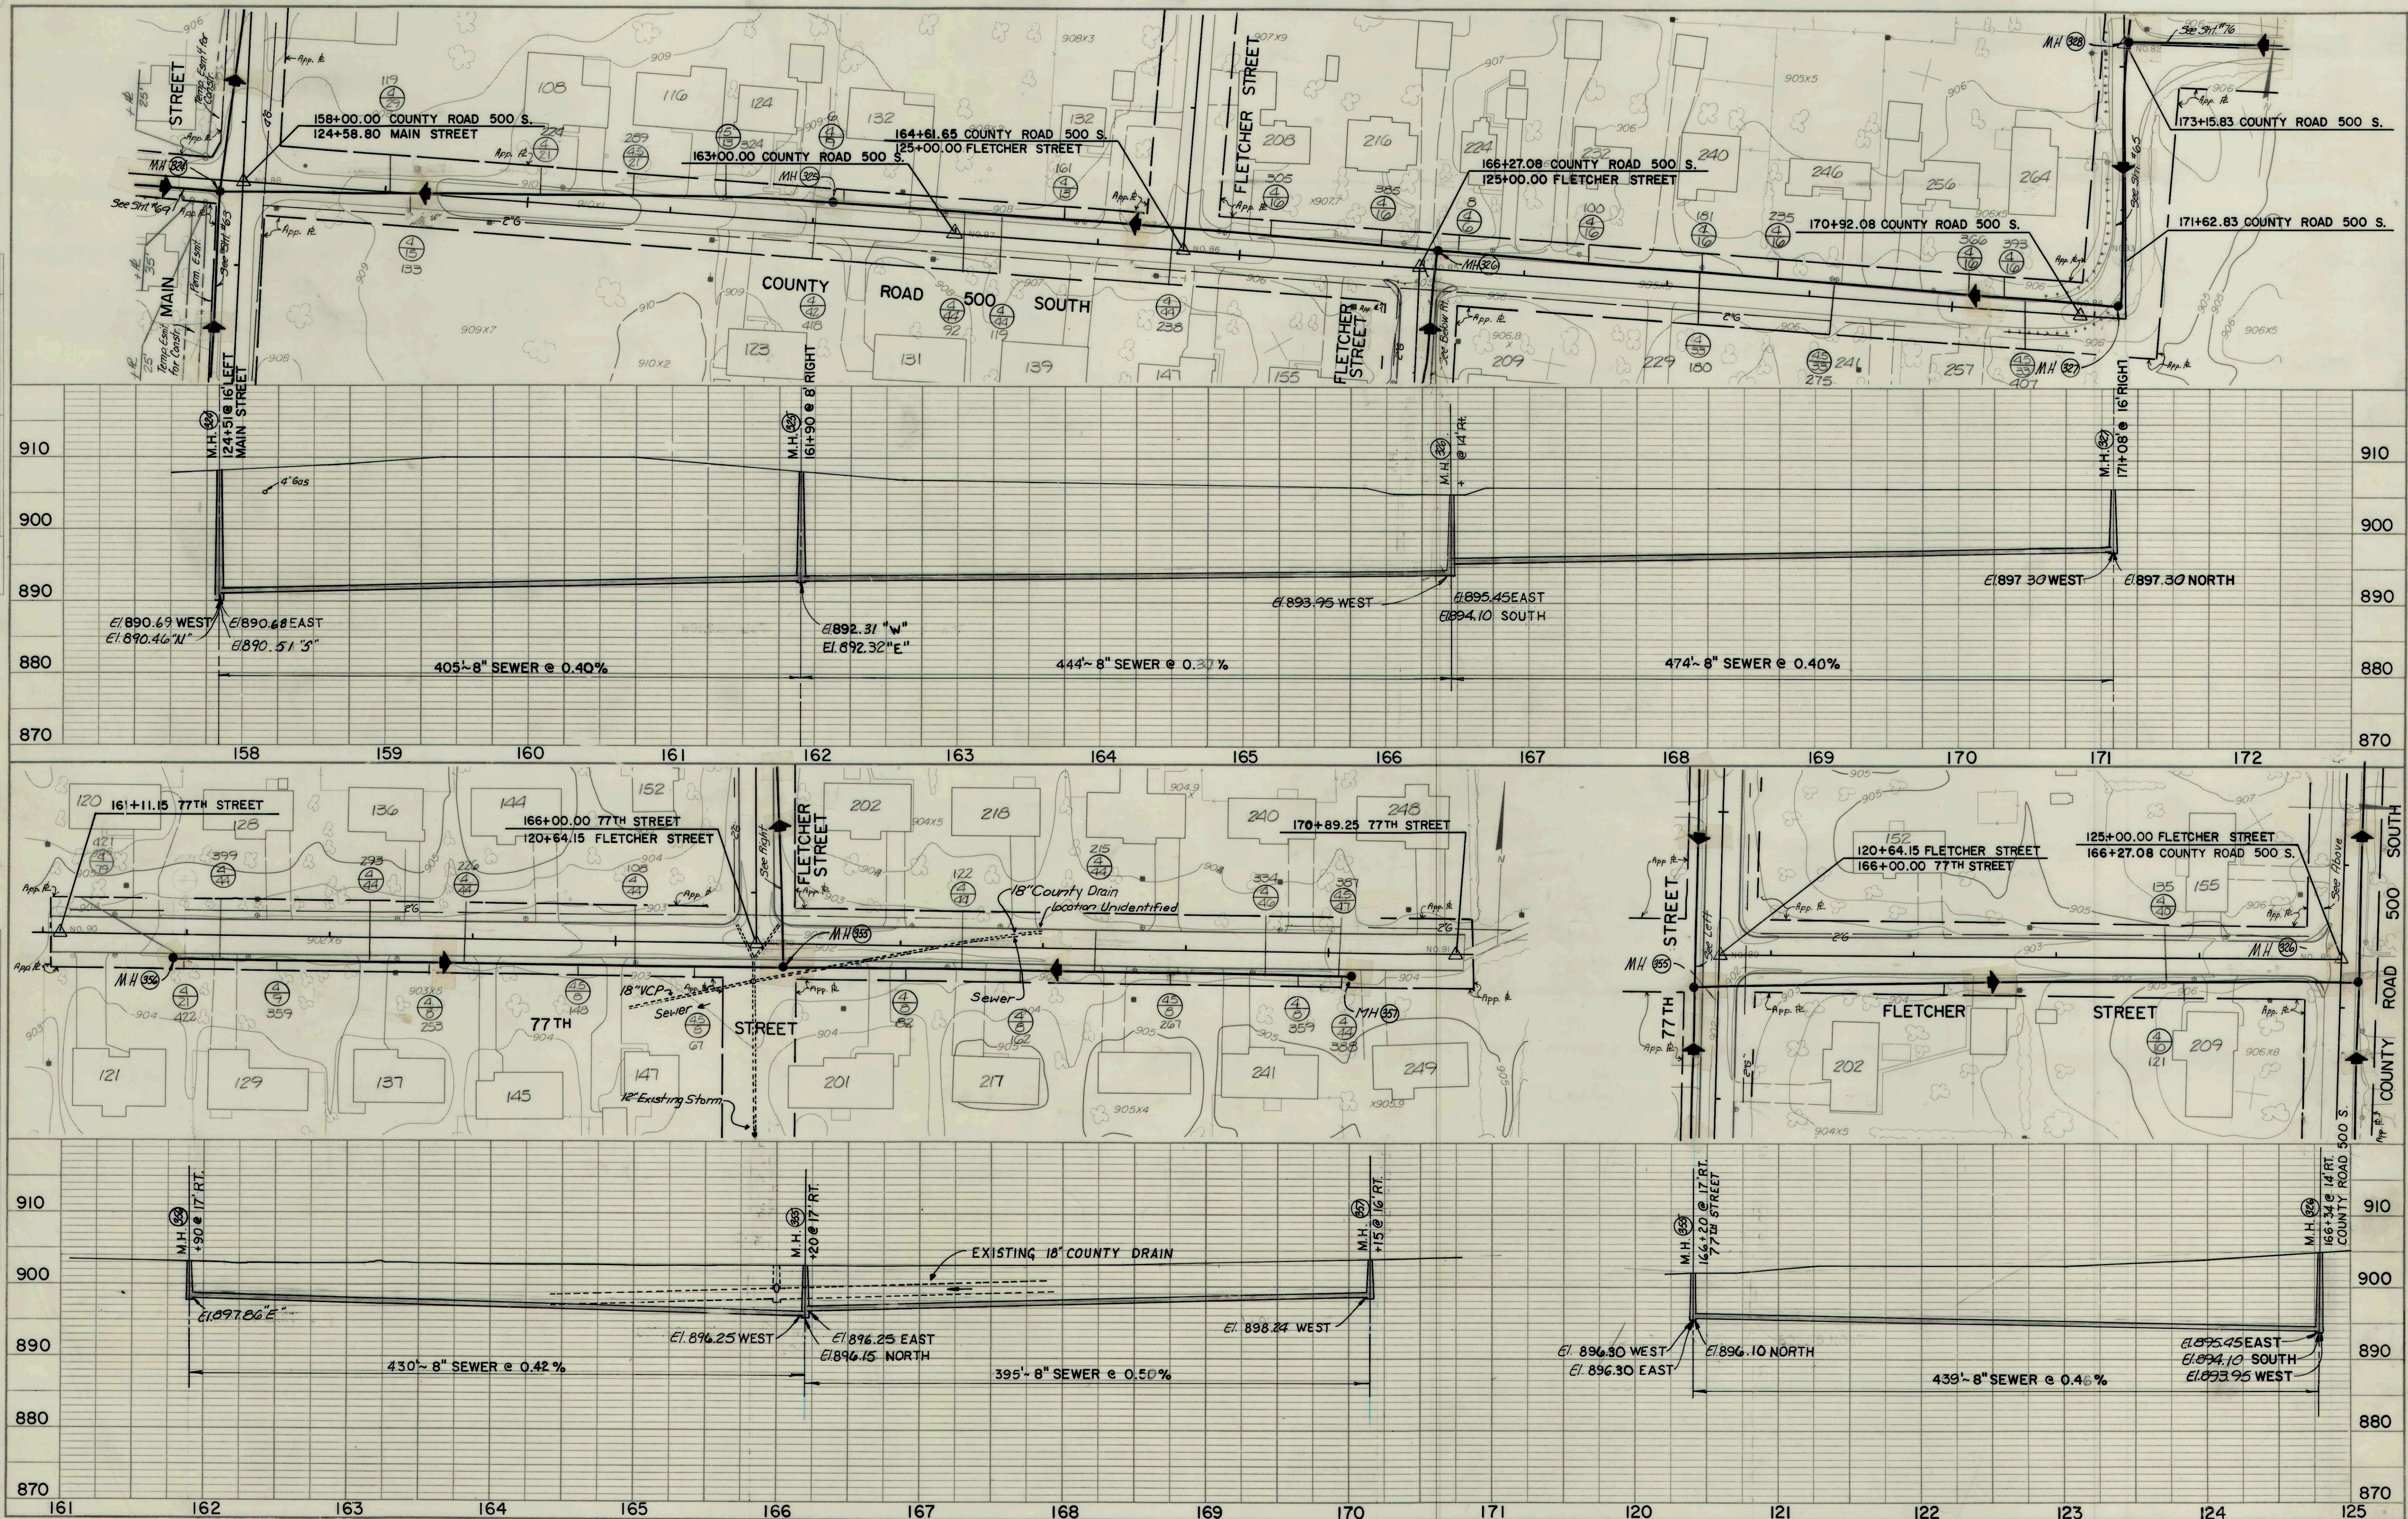

COUNTY ROAD 500 S. / FLETCHER ST.
 77TH ST.
 FALL CREEK R.W.D. PLAN & PROFILE SHEET
 HORIZ. 1"=50'
 VERT. 1"=10'
 BEAM, LONGEST & NEFF, INC.
 CONSULTING ENGINEERS
 INDIANAPOLIS, INDIANA
 64