



PLAN
 SURVEYED BY DATE
 PLOTTED BY
 NOTE BOOK NO.
 GRADES CHECKED
 STRUCTURE NOTATIONS CHECKED

PROFILE
 SURVEYED BY DATE
 PLOTTED BY
 NOTE BOOK NO.
 GRADES CHECKED
 STRUCTURE NOTATIONS CHECKED

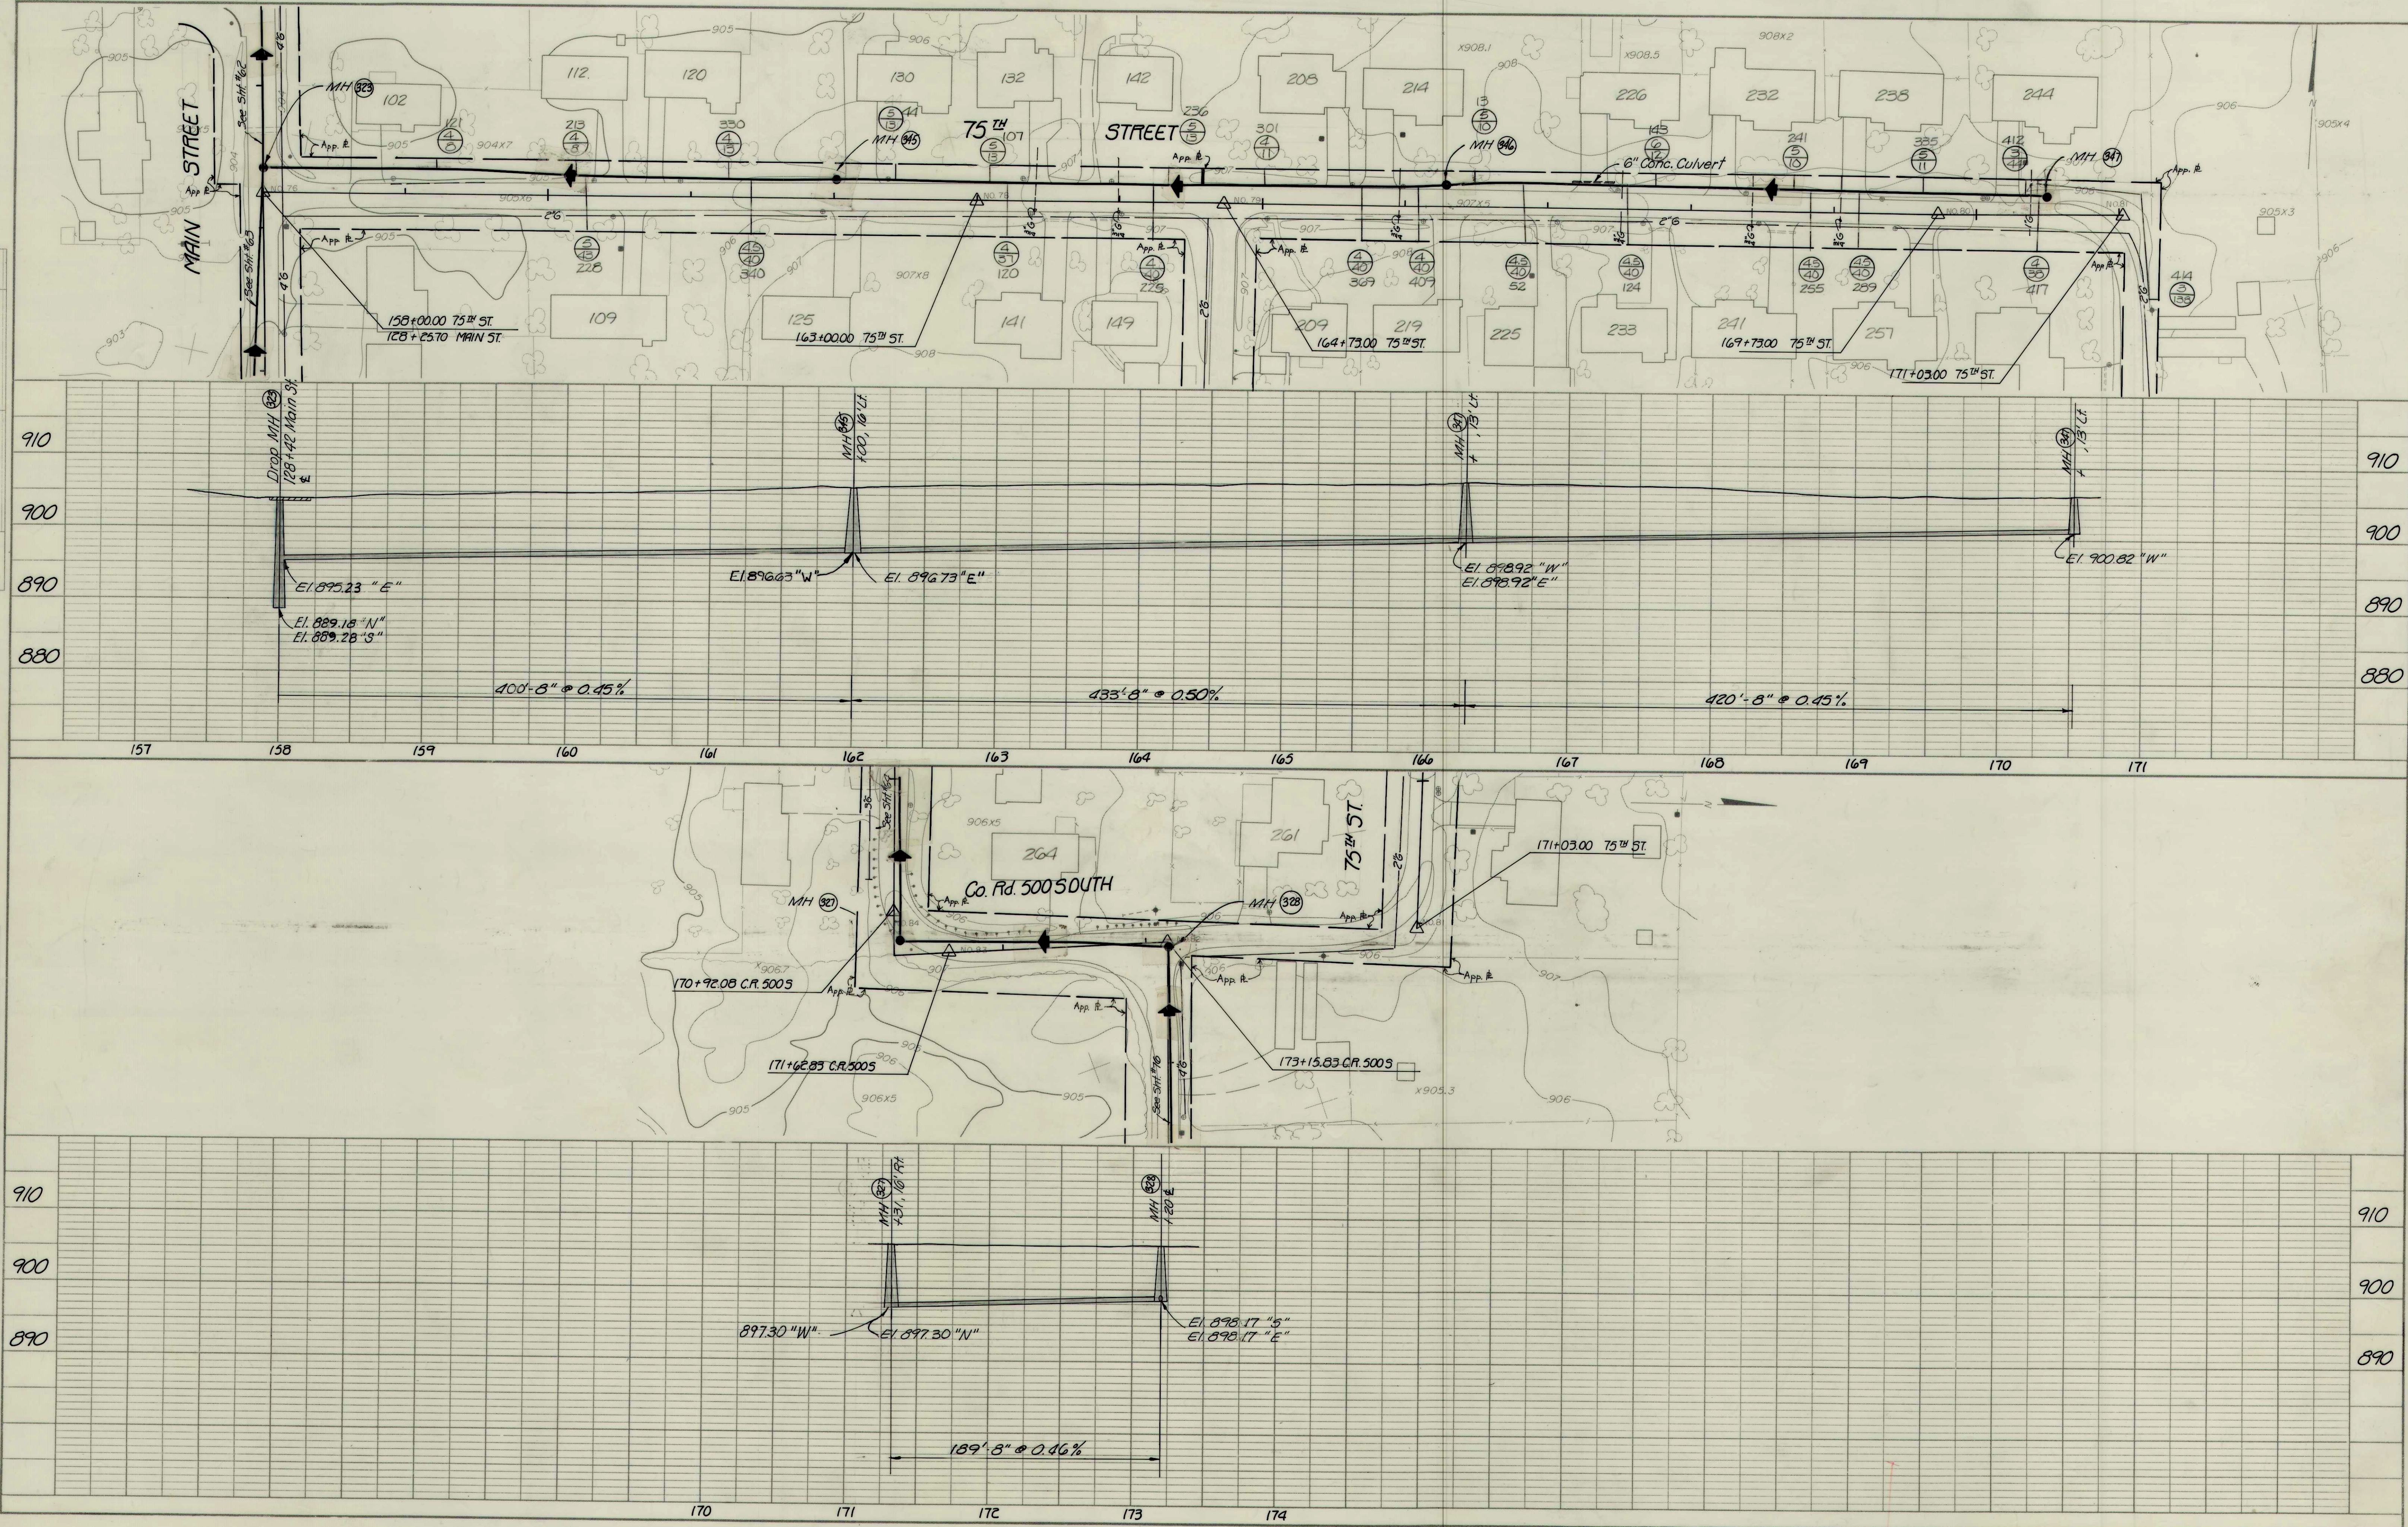

RECORD DRAWING

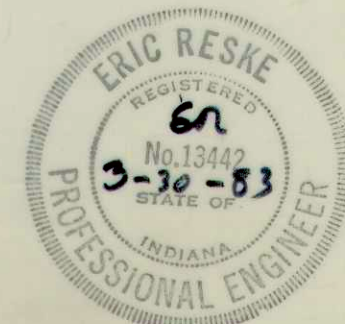

75TH ST. / Co. Rd. 500 SOUTH
 FALL CREEK R.W.D. PLAN & PROFILE SHEET
 HORIZ. 1"=50'
 VERT. 1"=10'
 BEAM, LONGEST & NEFF, INC.
 CONSULTING ENGINEERS
 INDIANAPOLIS, INDIANA
65