


PLAN
 SURVEYED
 PLOTTED
 CHECKED
 NO. OF W.A. CHECKED
 NO.

PROFILE
 SURVEYED
 PLOTTED
 CHECKED
 NO. OF W.A. CHECKED
 NO.



RECORD DRAWING

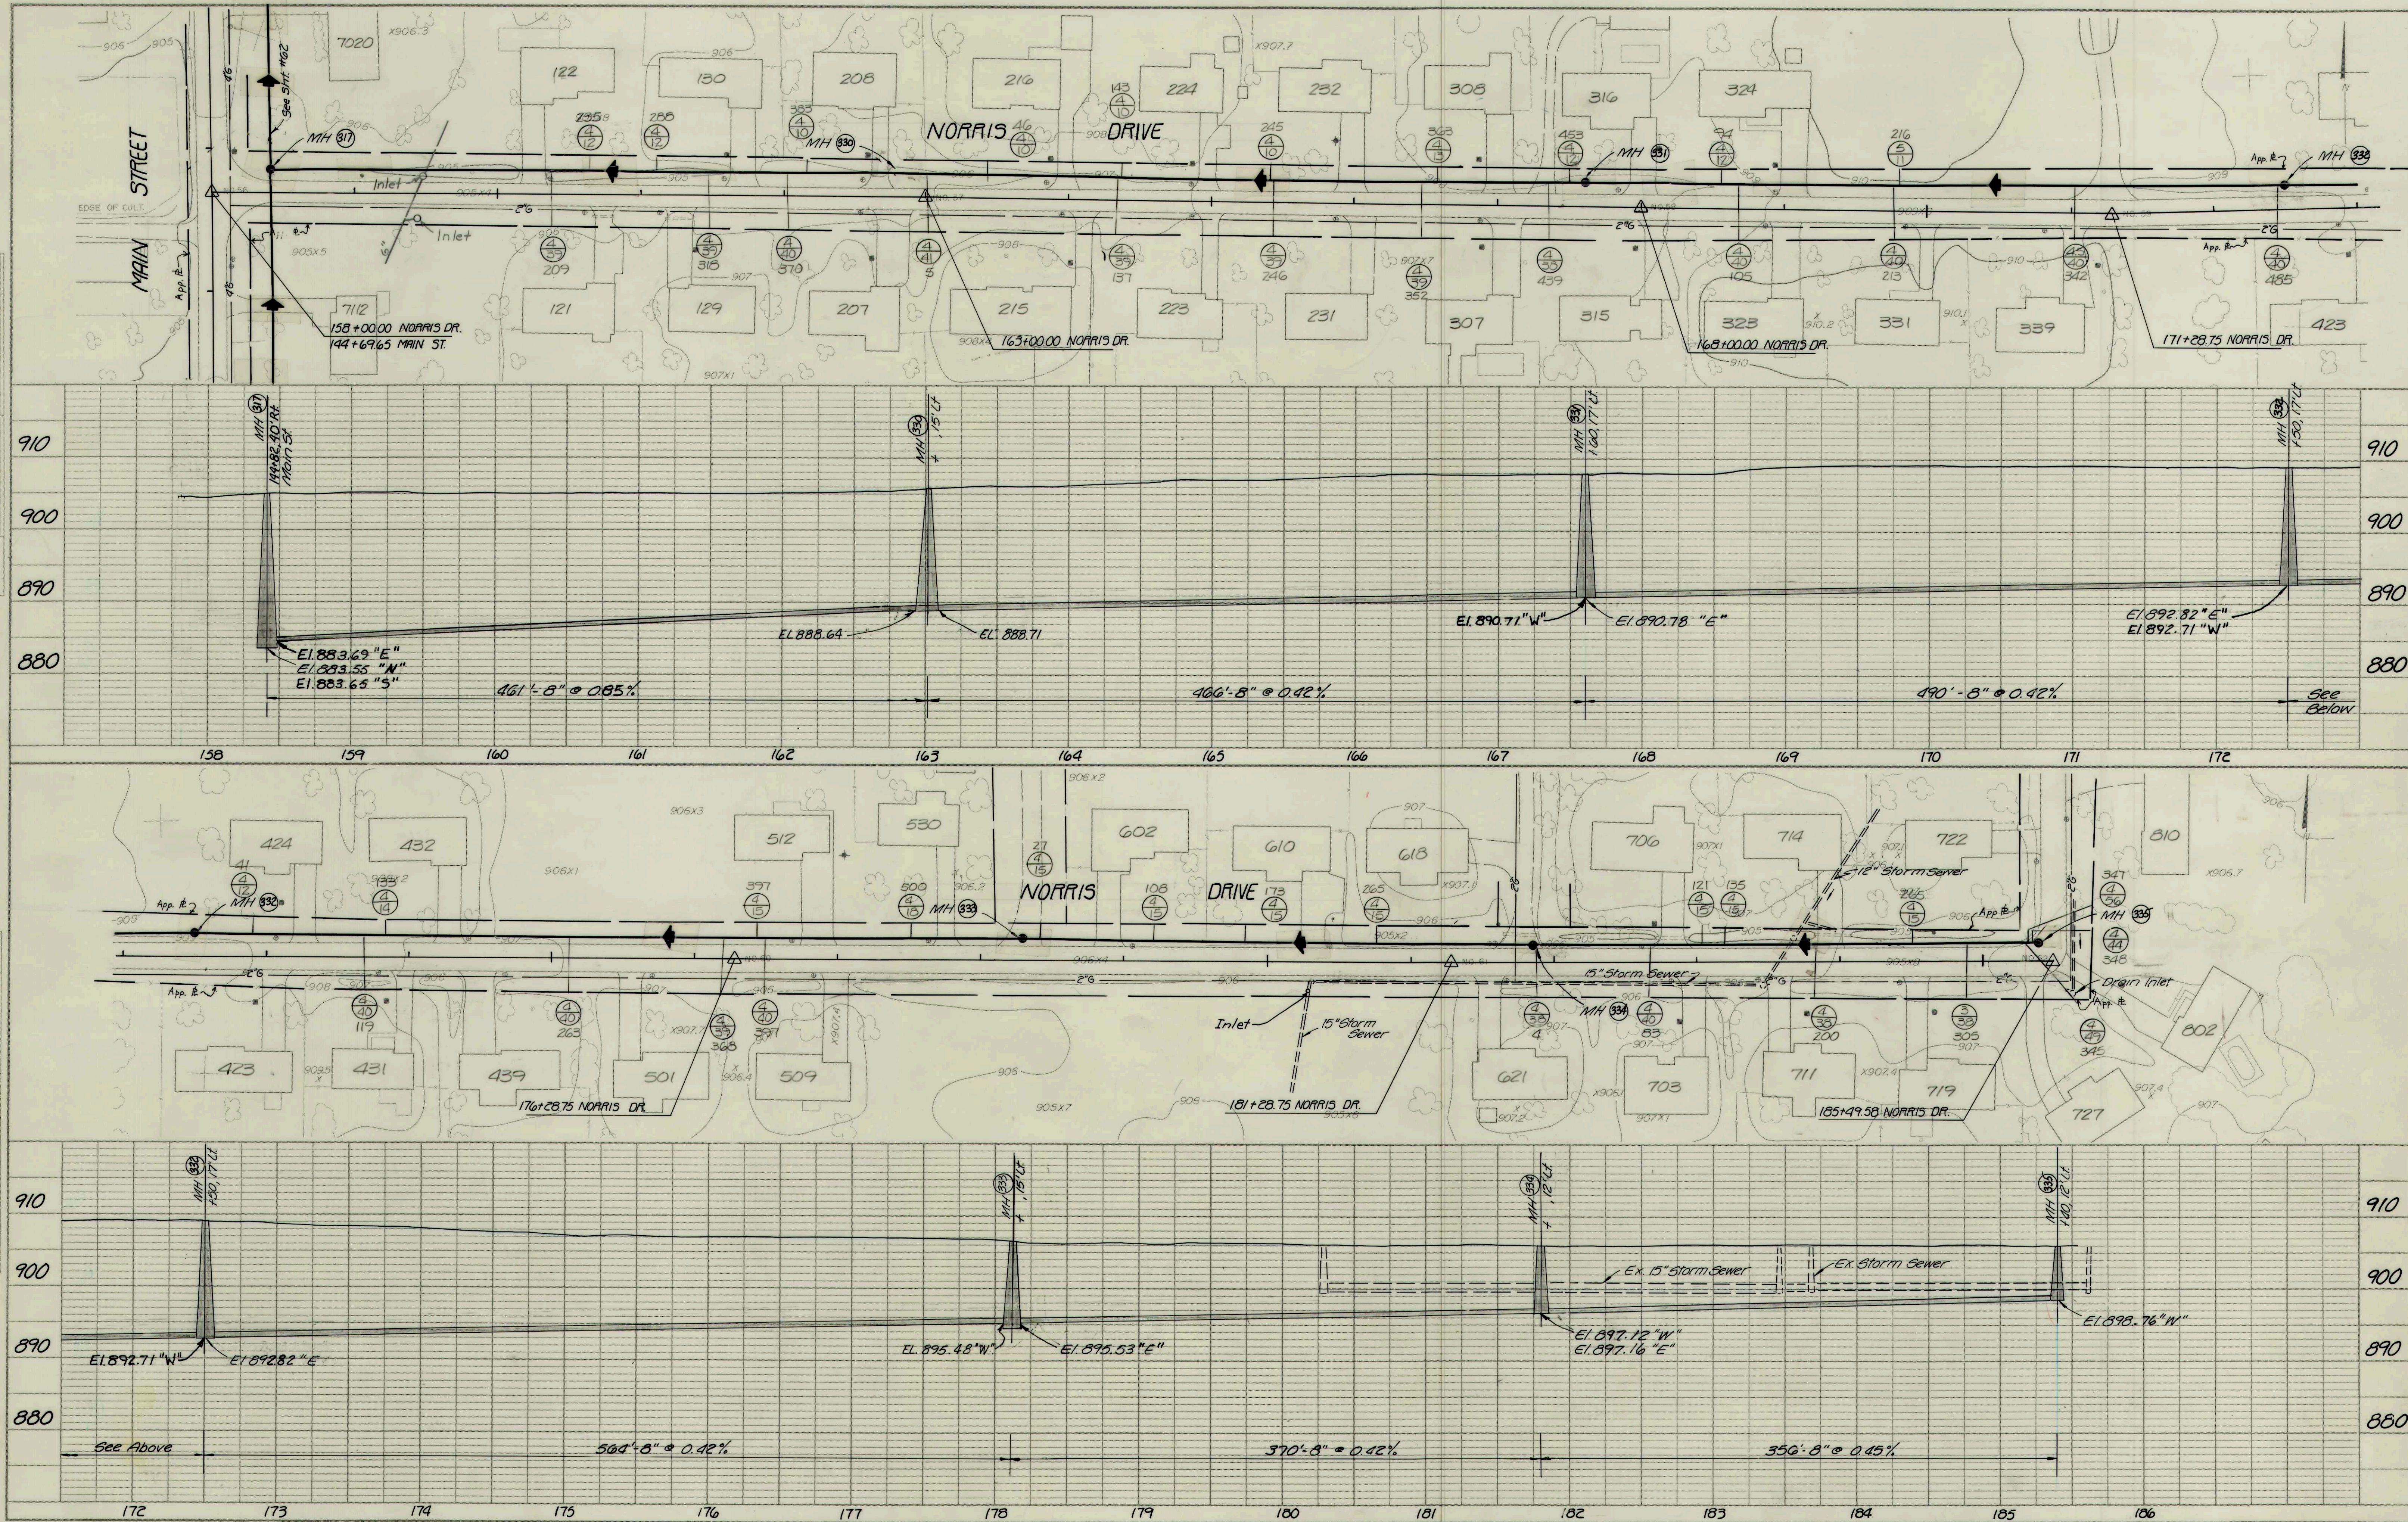

NORRIS DRIVE
 FALL CREEK R.W.D. PLAN & PROFILE SHEET
 HORIZ. 1"=50'
 VERT. 1"=10'
 BEAM, LONGEST & NEFF, INC.
 CONSULTING ENGINEERS
 INDIANAPOLIS, INDIANA
66