



PLAN	DATE	BY
	SURVEYED	NOTED
	FLIGHTS	ALIGNED
	NOTE BOOK	NO. OF MAP SHEETS

PROFILE	DATE	BY
	SURVEYED	NOTED
	FLIGHTS	ALIGNED
	NOTE BOOK	NO. OF MAP SHEETS

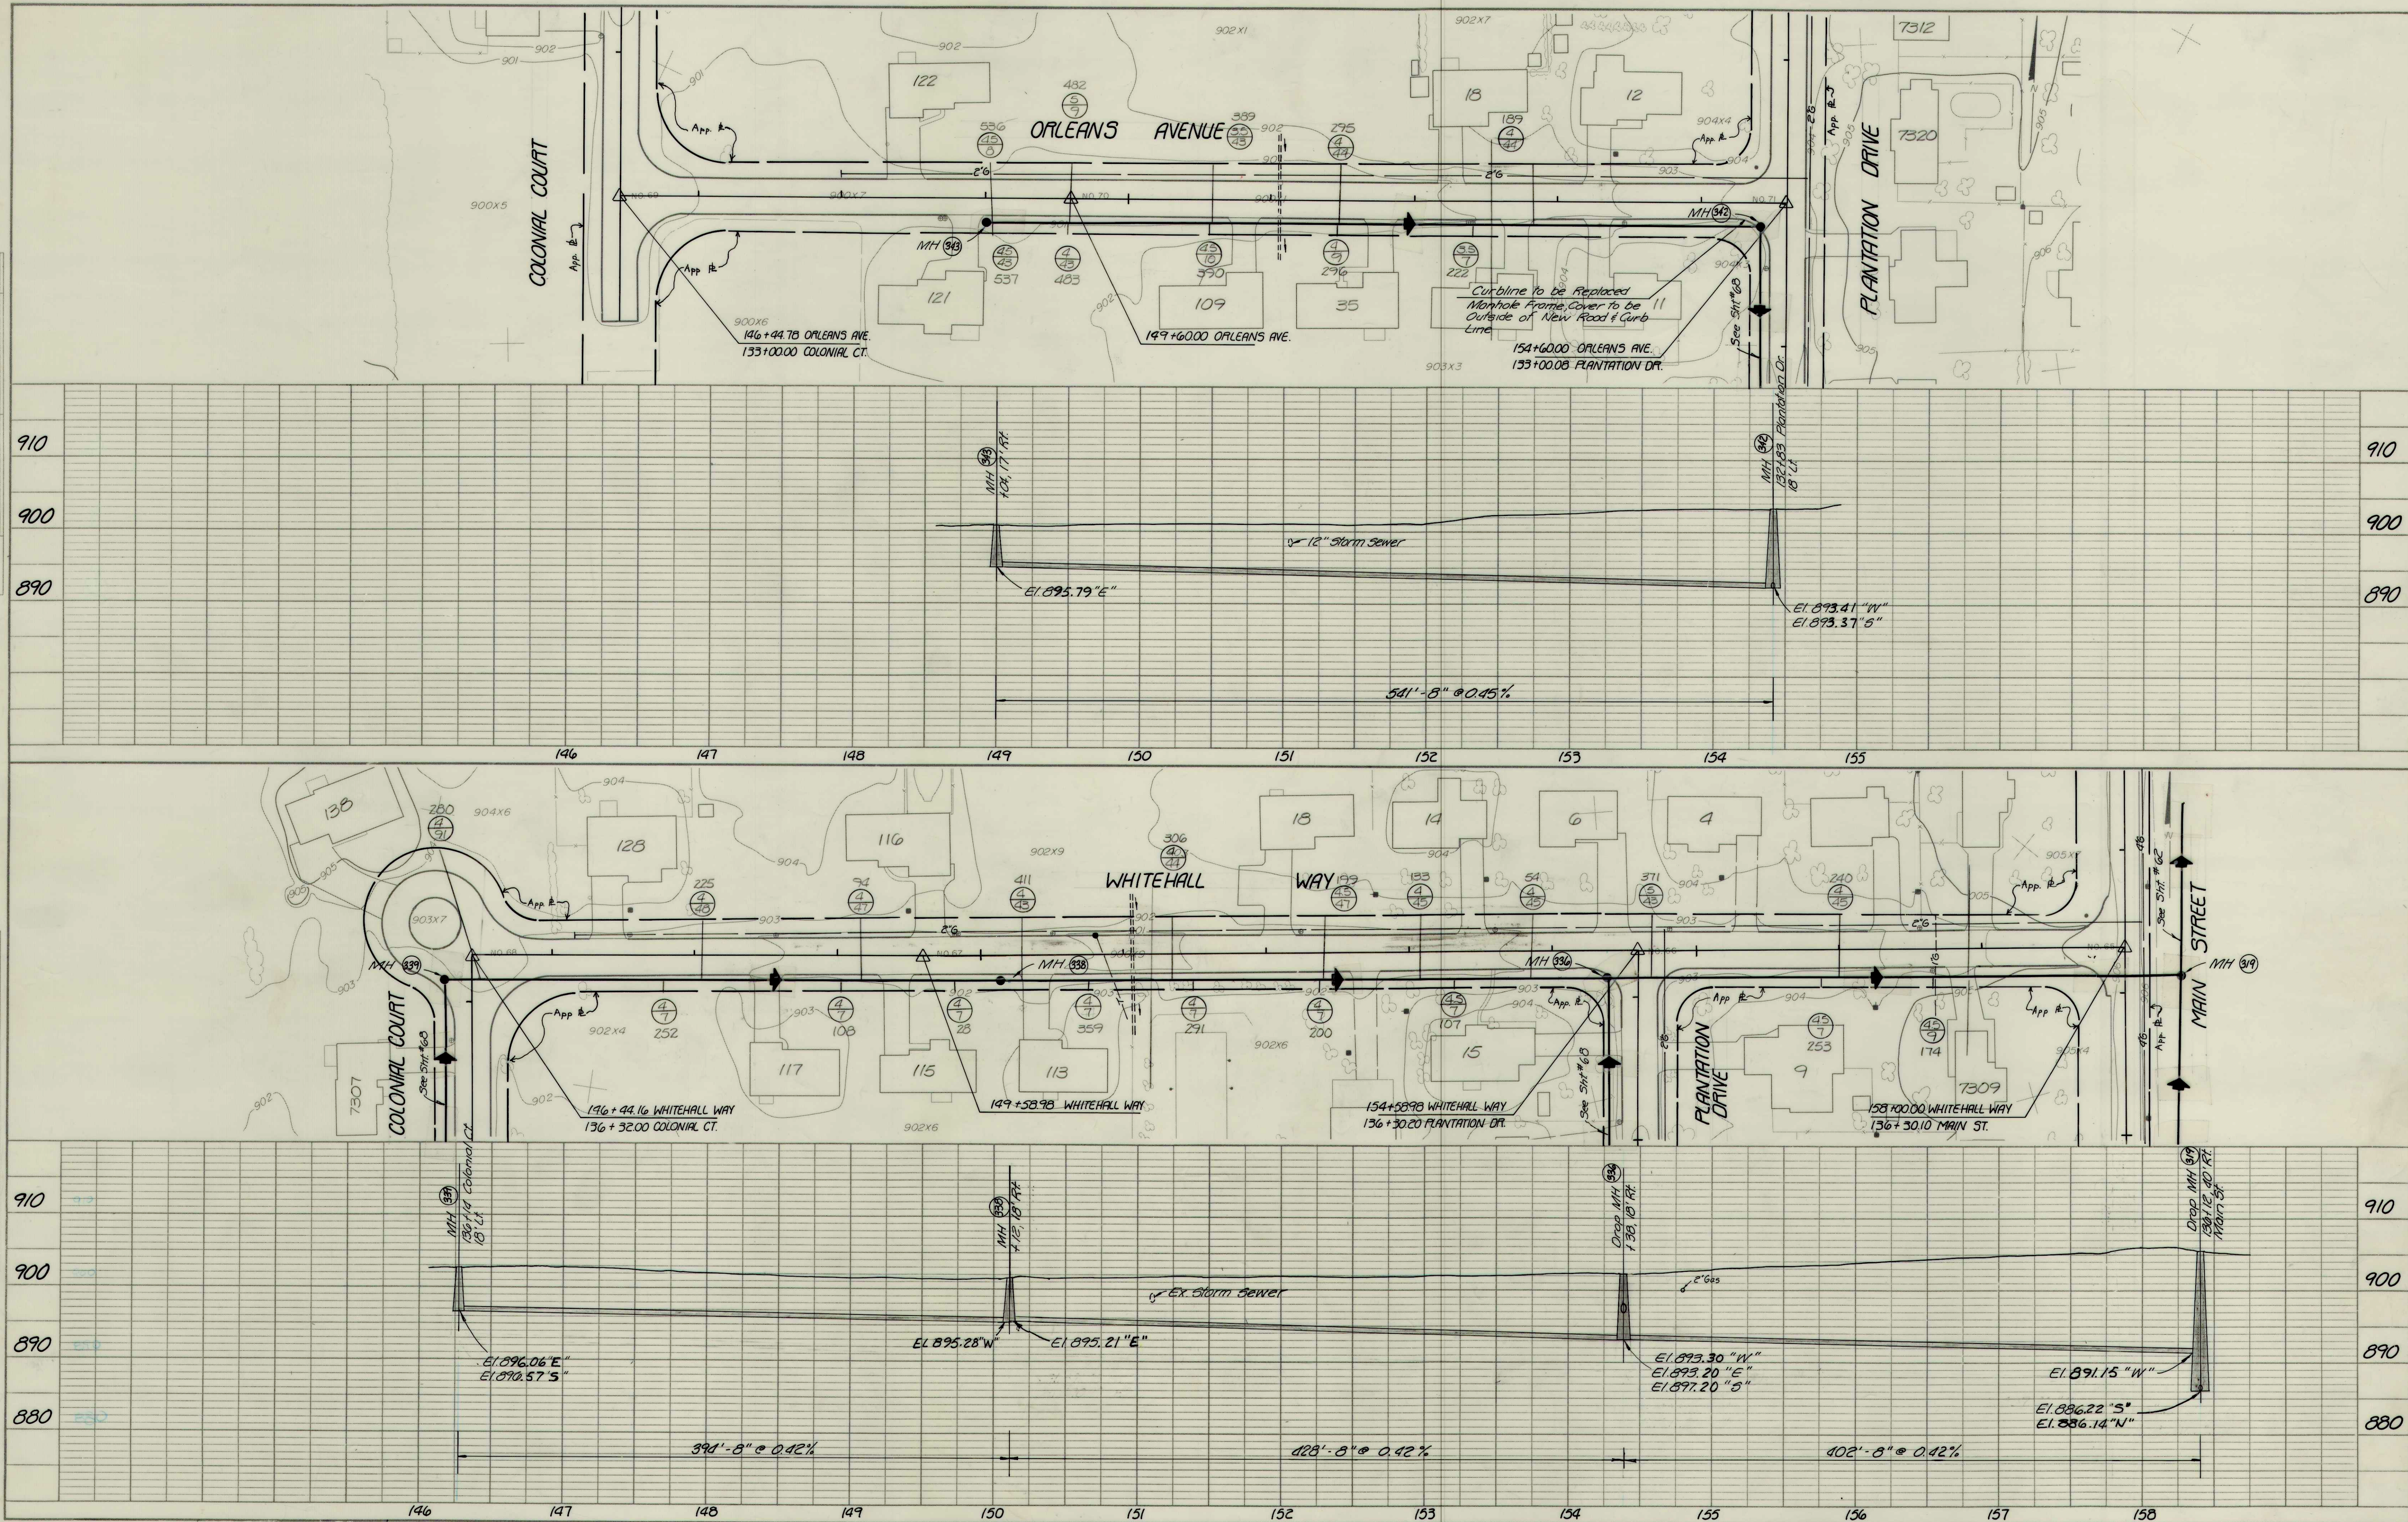

RECORD DRAWING

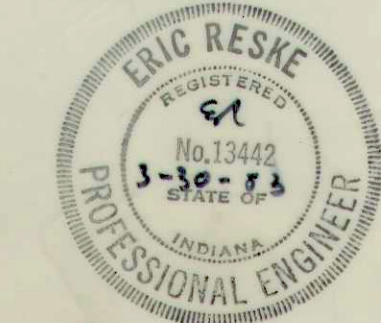

ORLEANS AVE/WHITEHALL WAY	
FALL CREEK R.W.D. PLAN & PROFILE	SHEET
HORIZ. 1"=50'	BEAM, LONGEST & NEFF, INC.
VERT. 1"=10'	CONSULTING ENGINEERS
	INDIANAPOLIS, INDIANA
	67