


PLAN	DATE	BY
	SURVEYED	NOTED
	ALIGNED	CHECKED
	NO.	NO.

PROFILE	DATE	BY
	SURVEYED	NOTED
	ALIGNED	CHECKED
	NO.	NO.



RECORD DRAWING

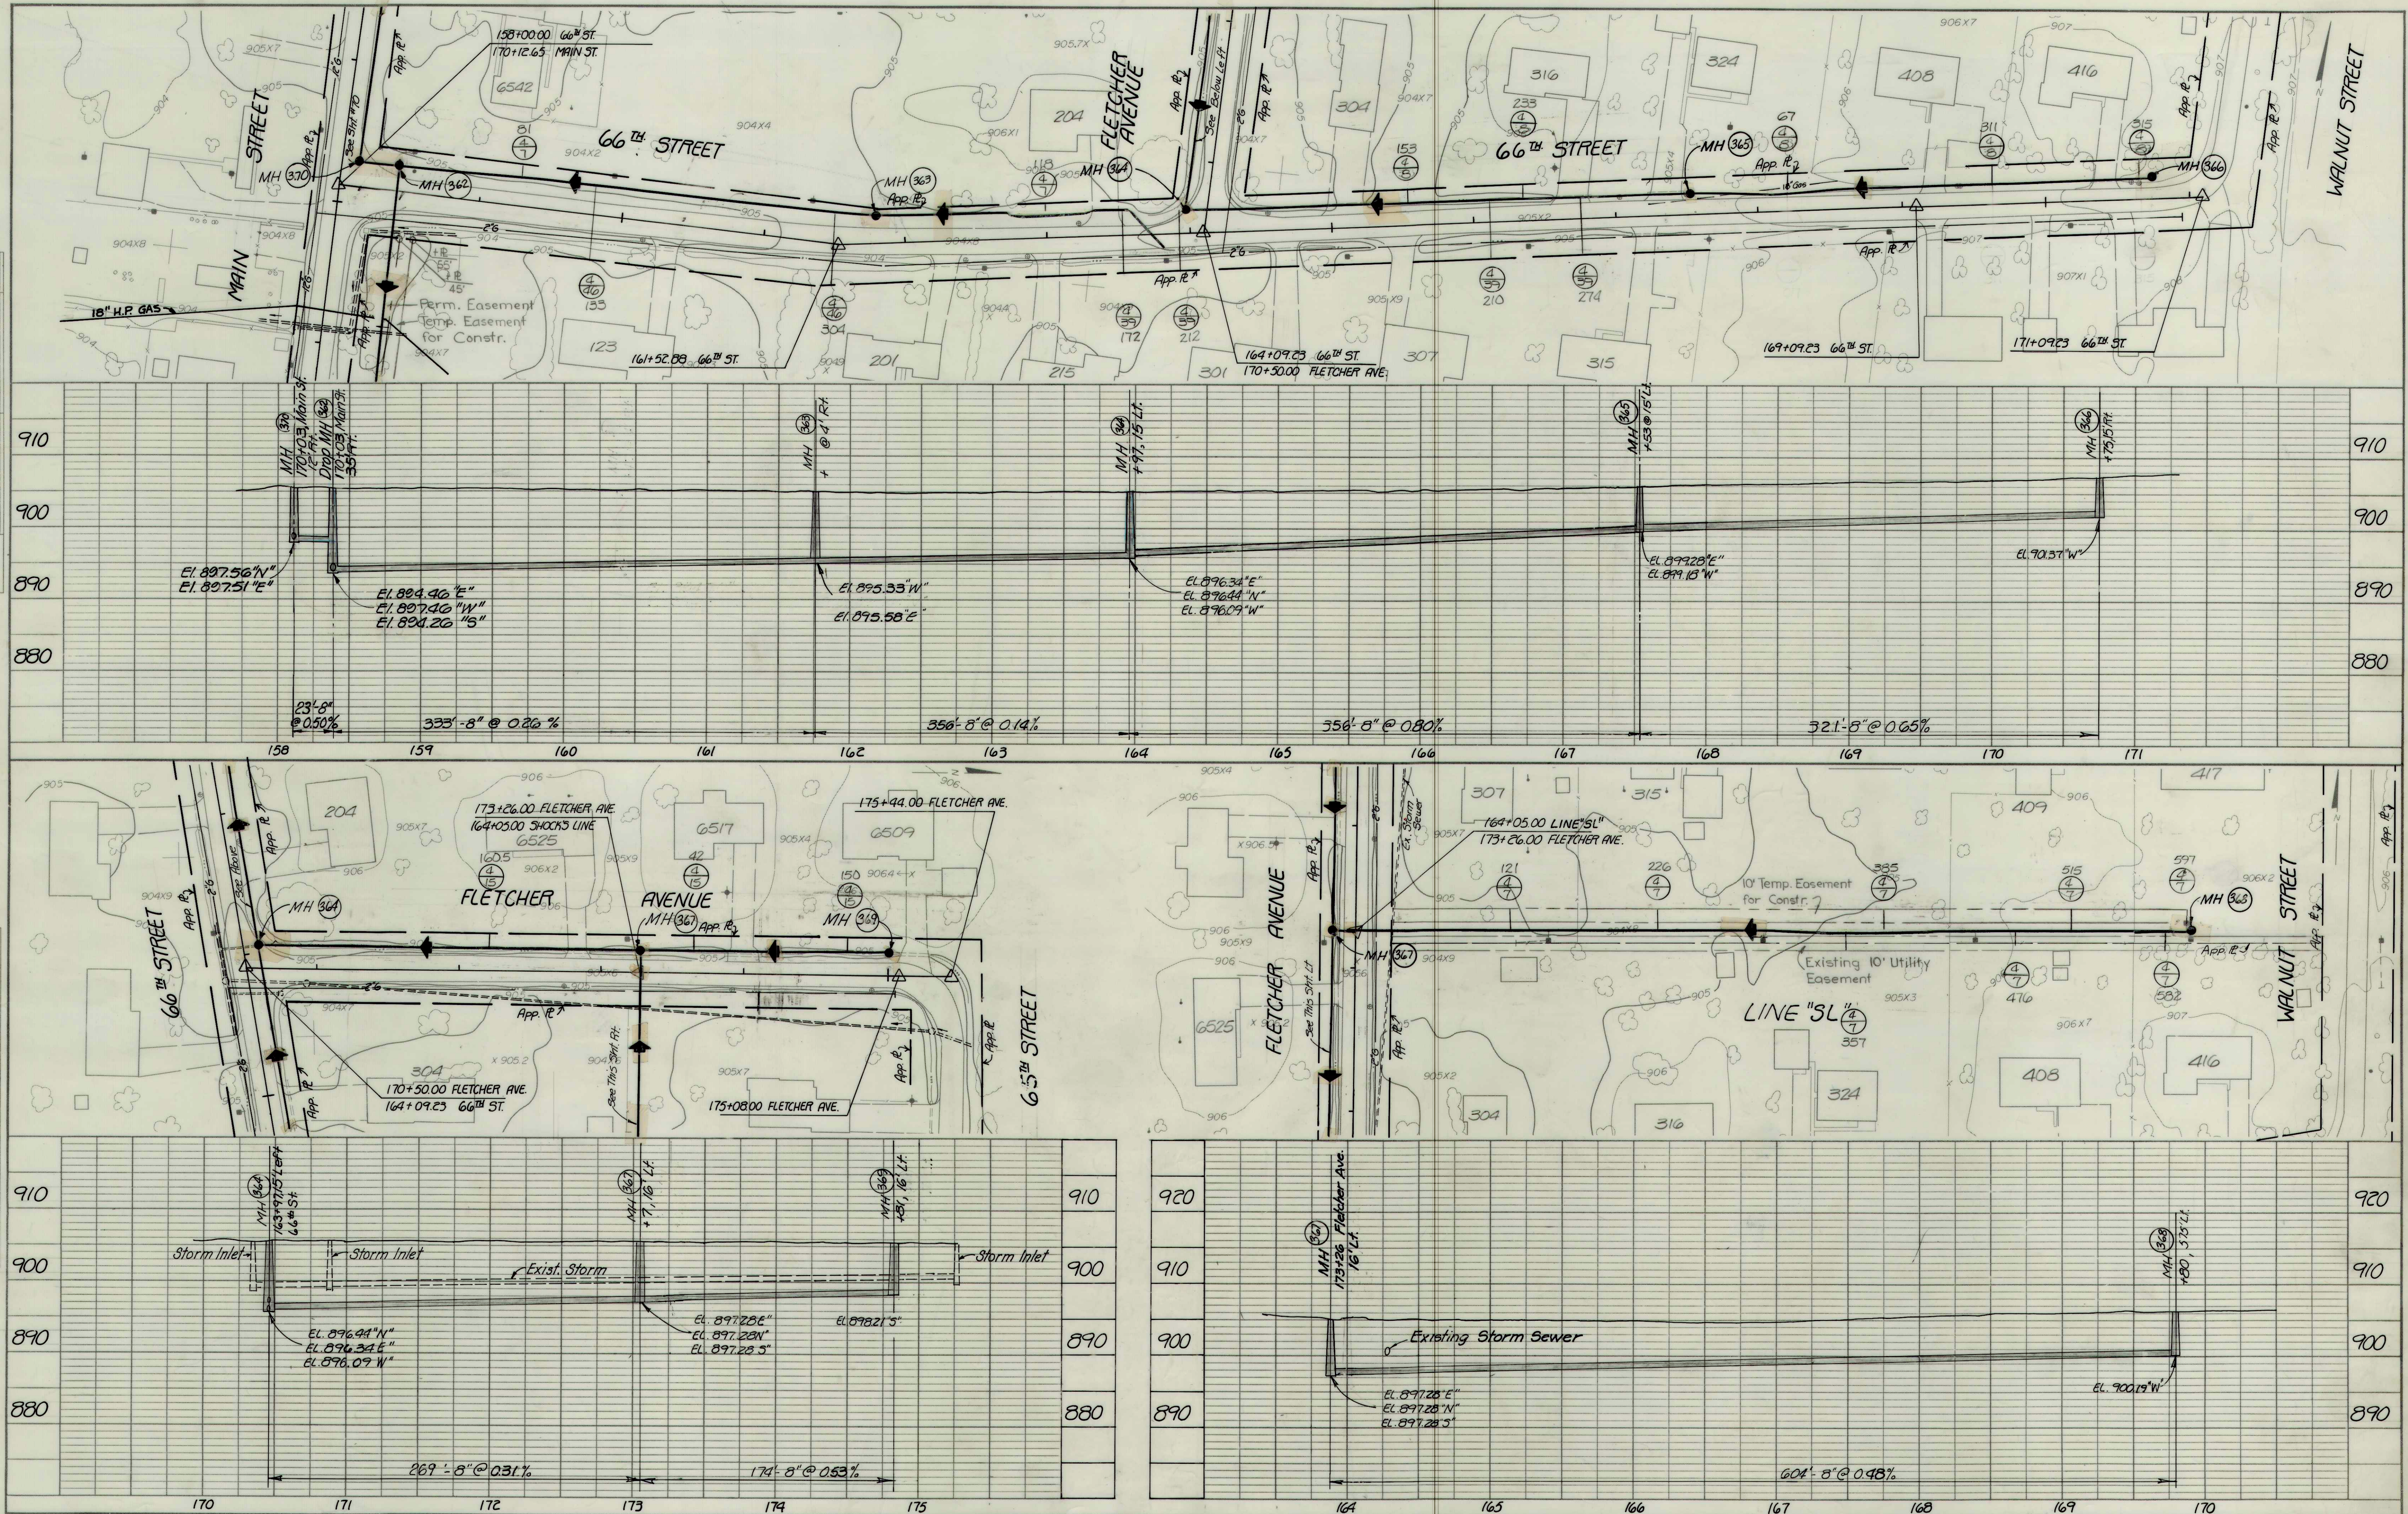

66TH ST / FLETCHER AVE / LINE "SL"
 FALL CREEK R.W.D. PLAN & PROFILE SHEET
 HORIZ. 1"=50' BEAM, LONGEST & NEFF, INC.
 VERT. 1"=10' CONSULTING ENGINEERS
 INDIANAPOLIS, INDIANA