
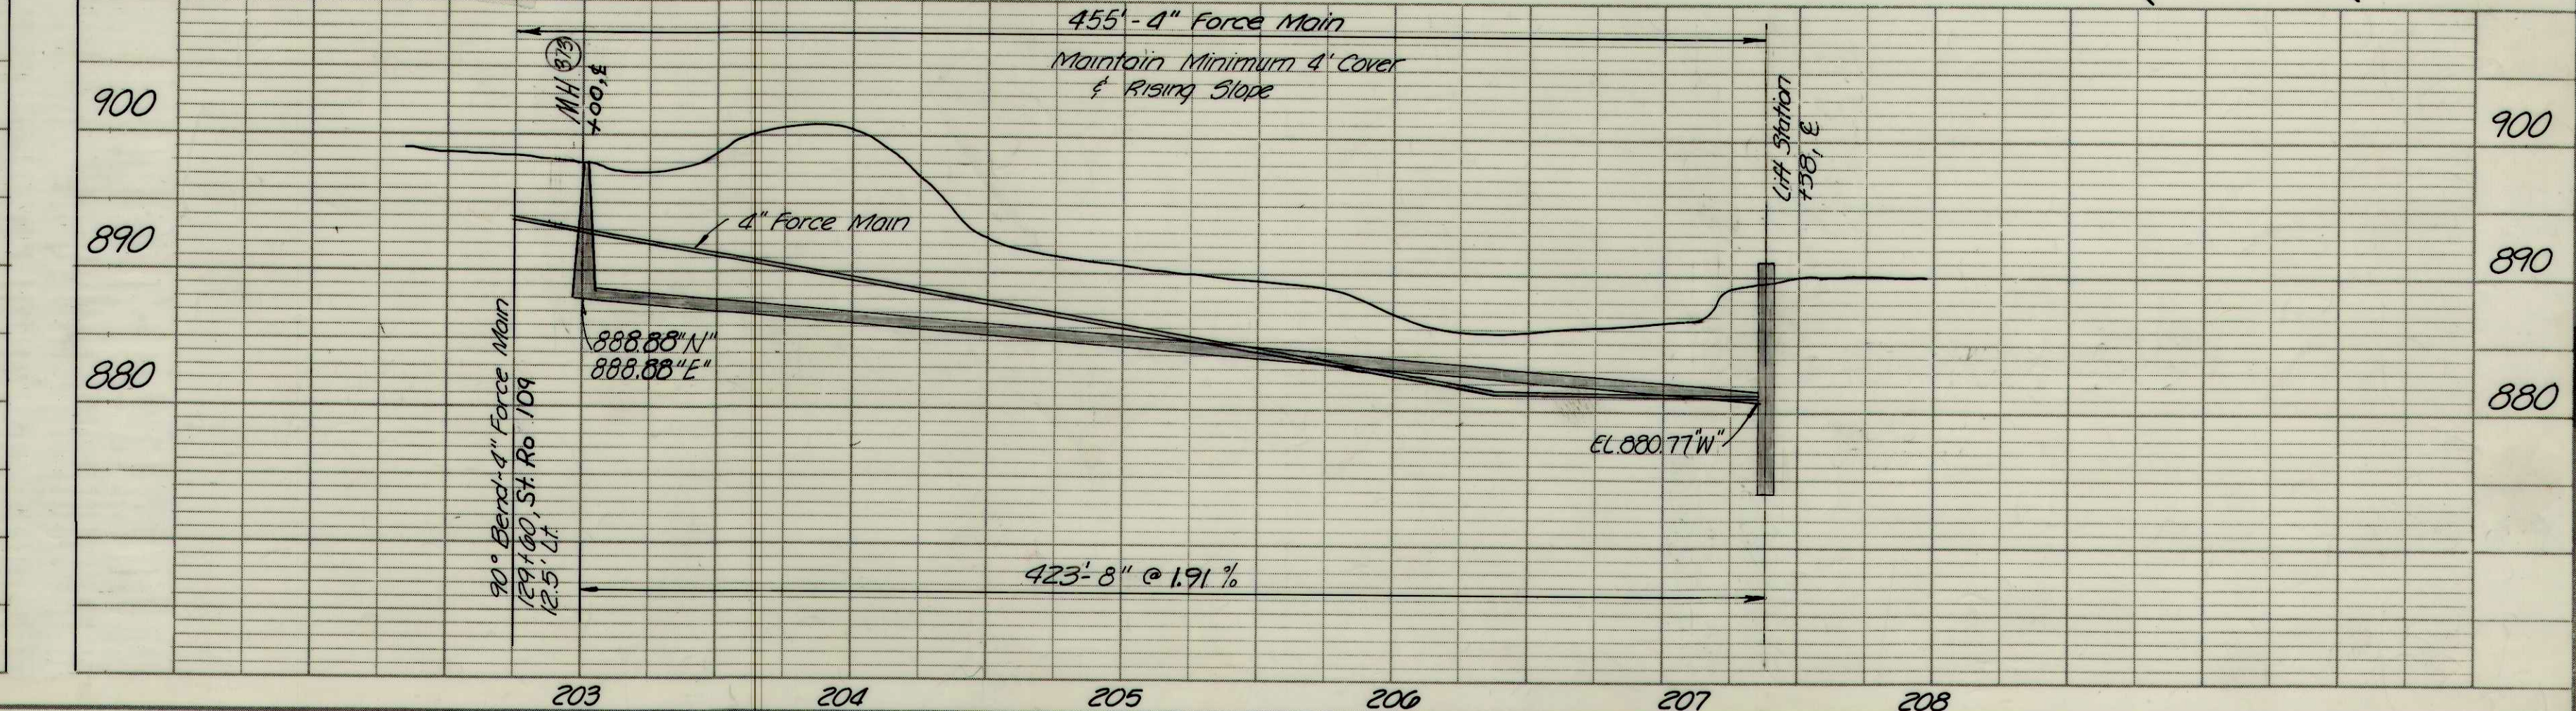
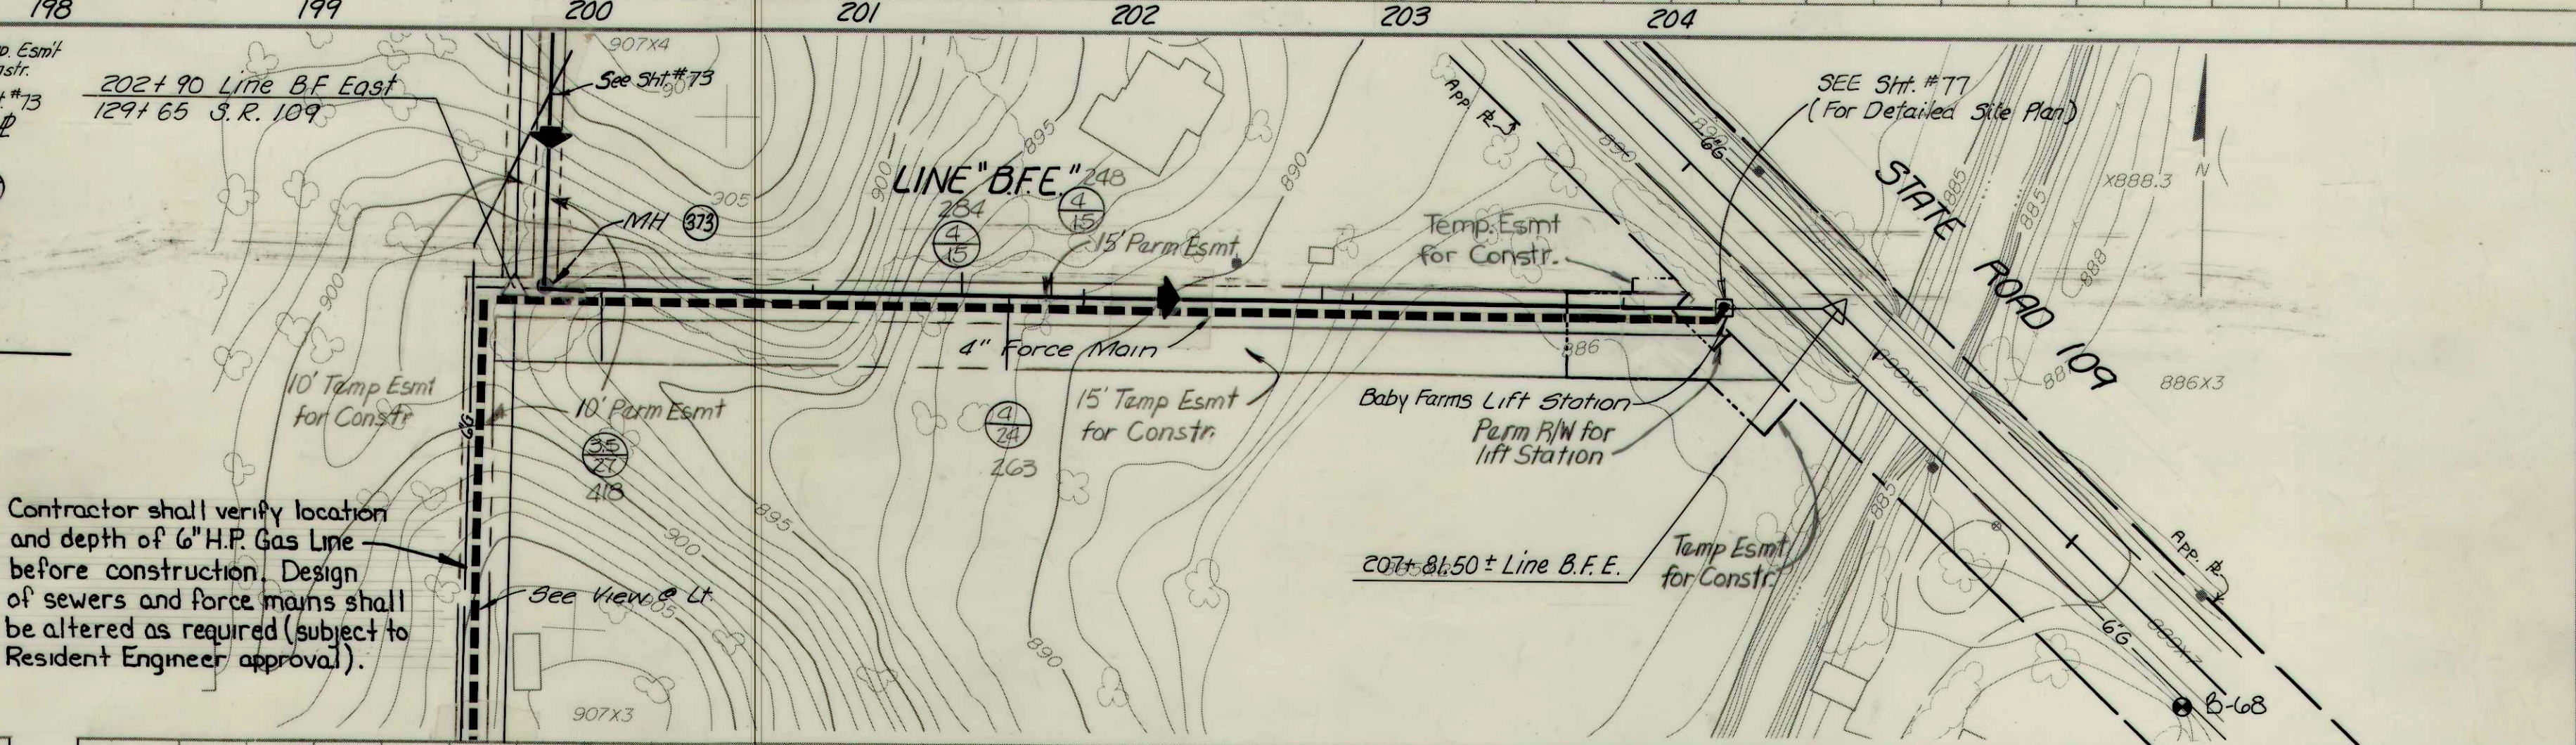
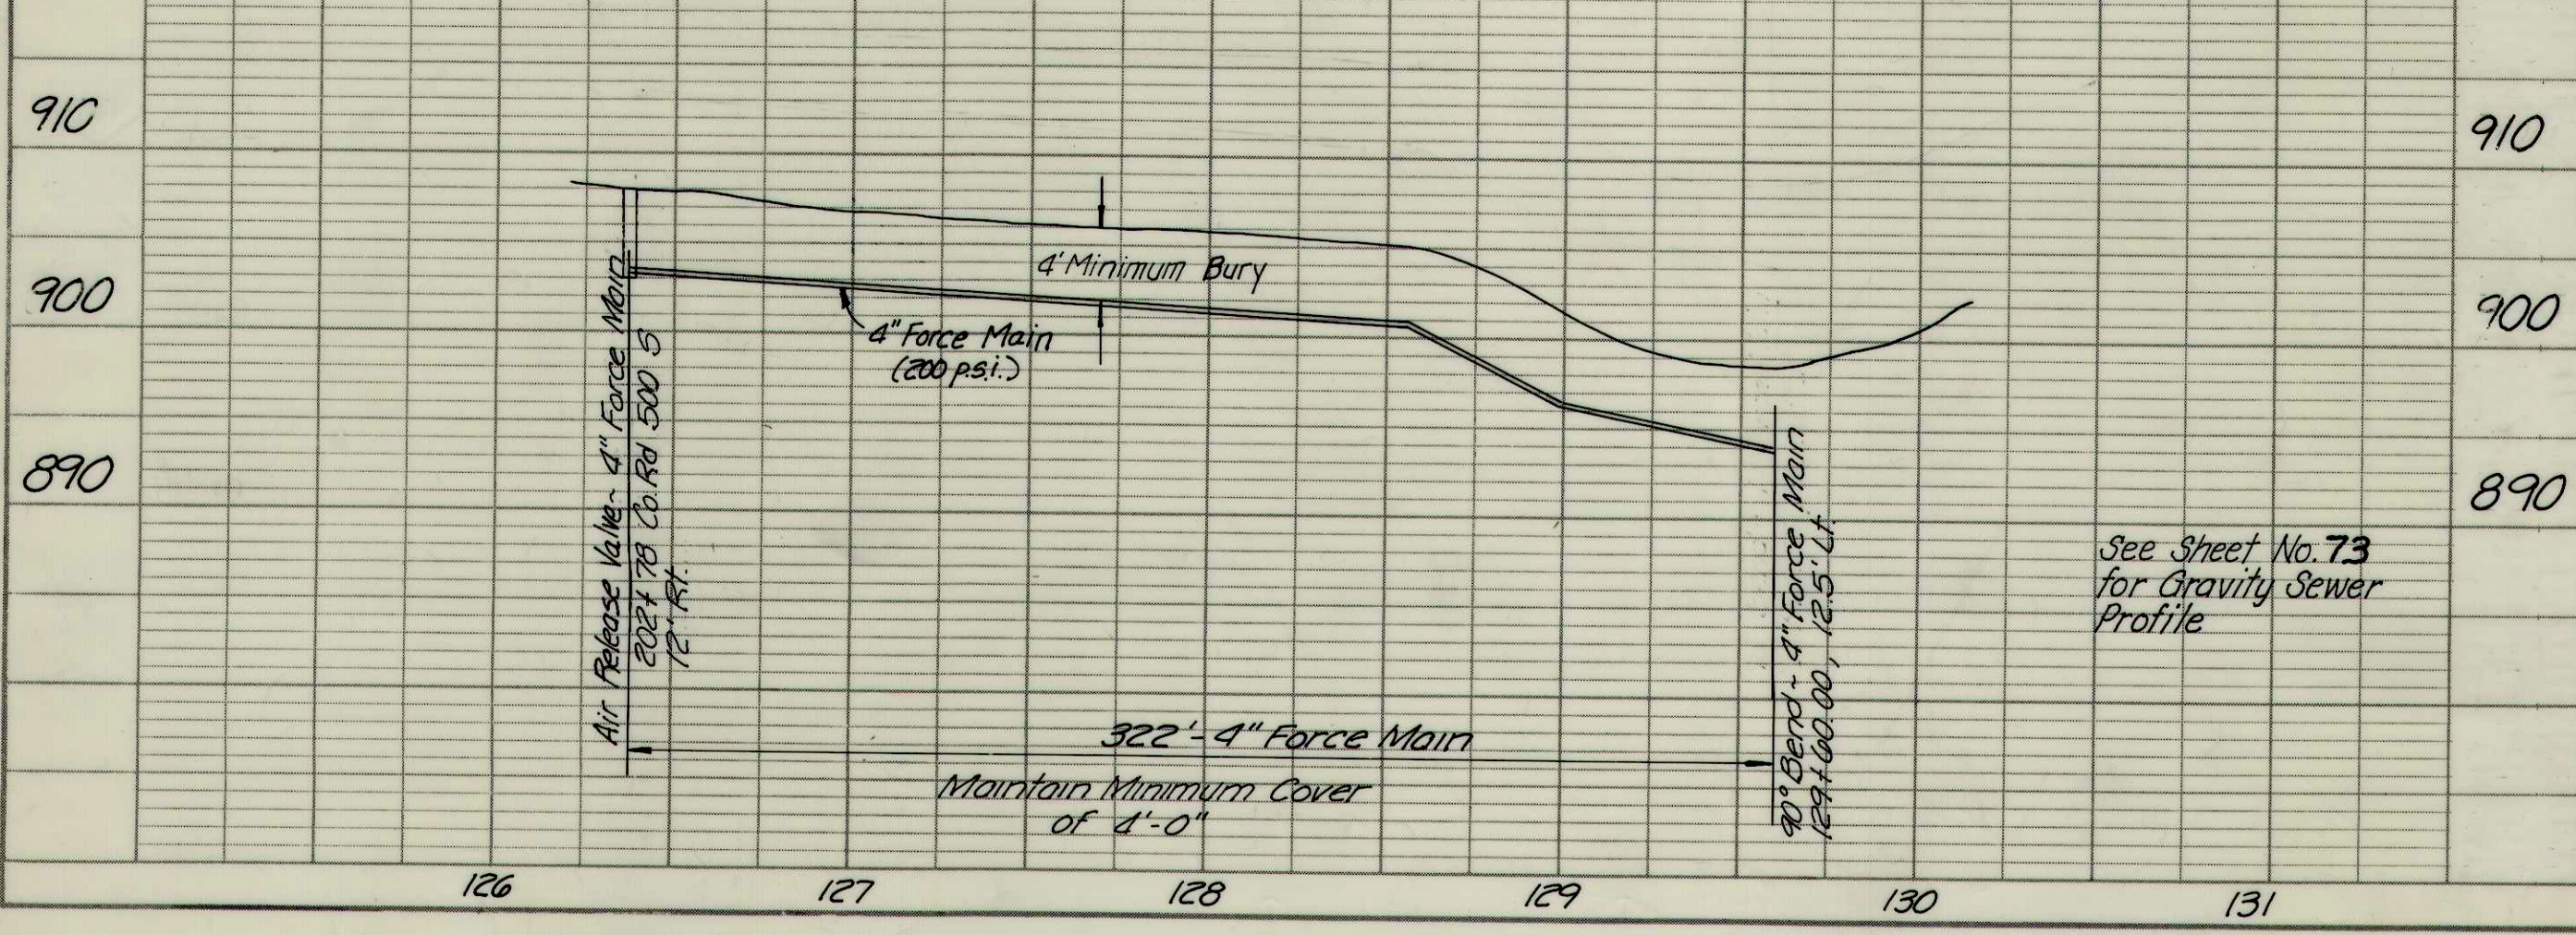
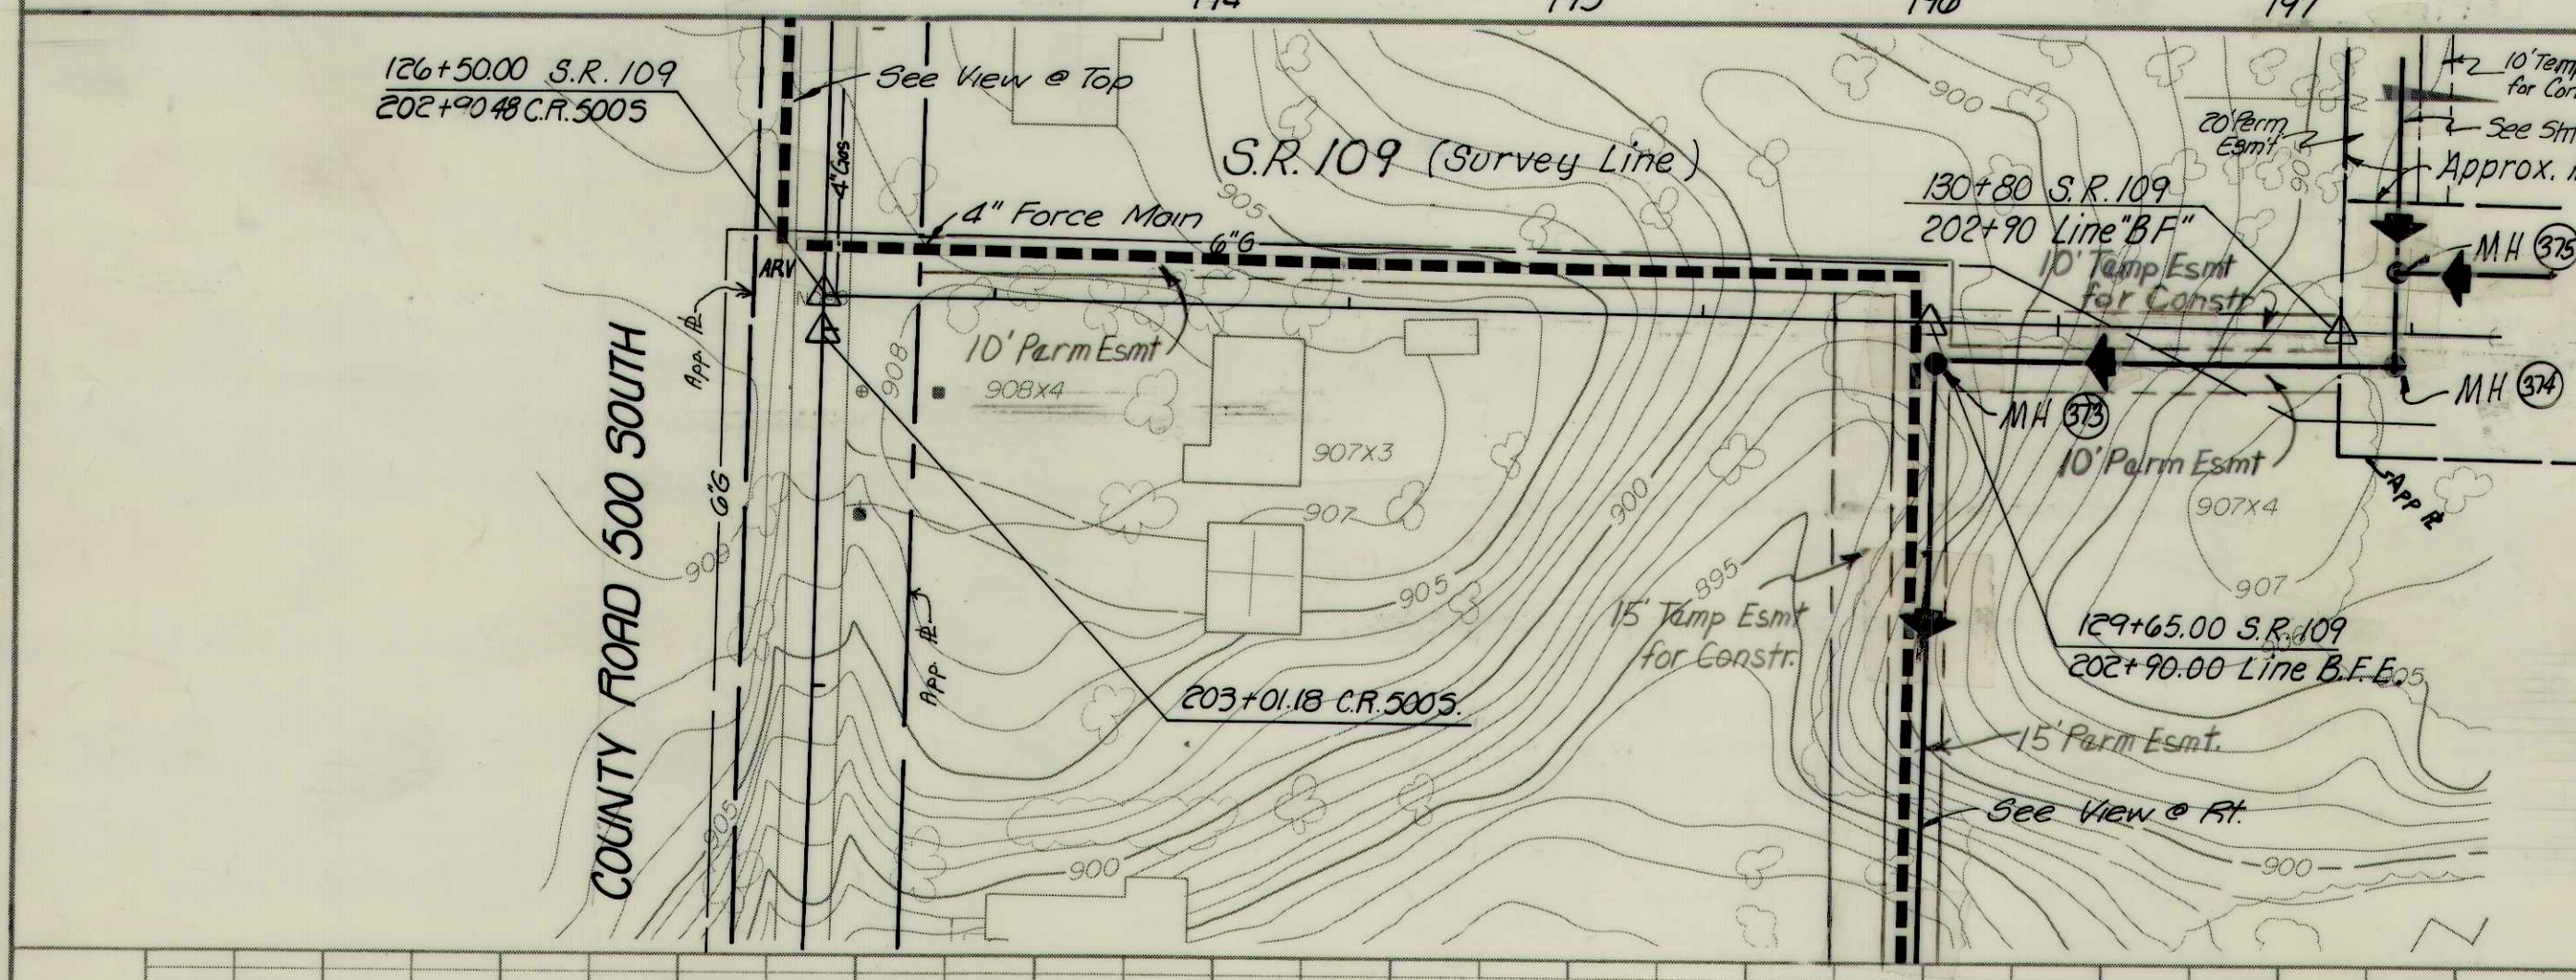
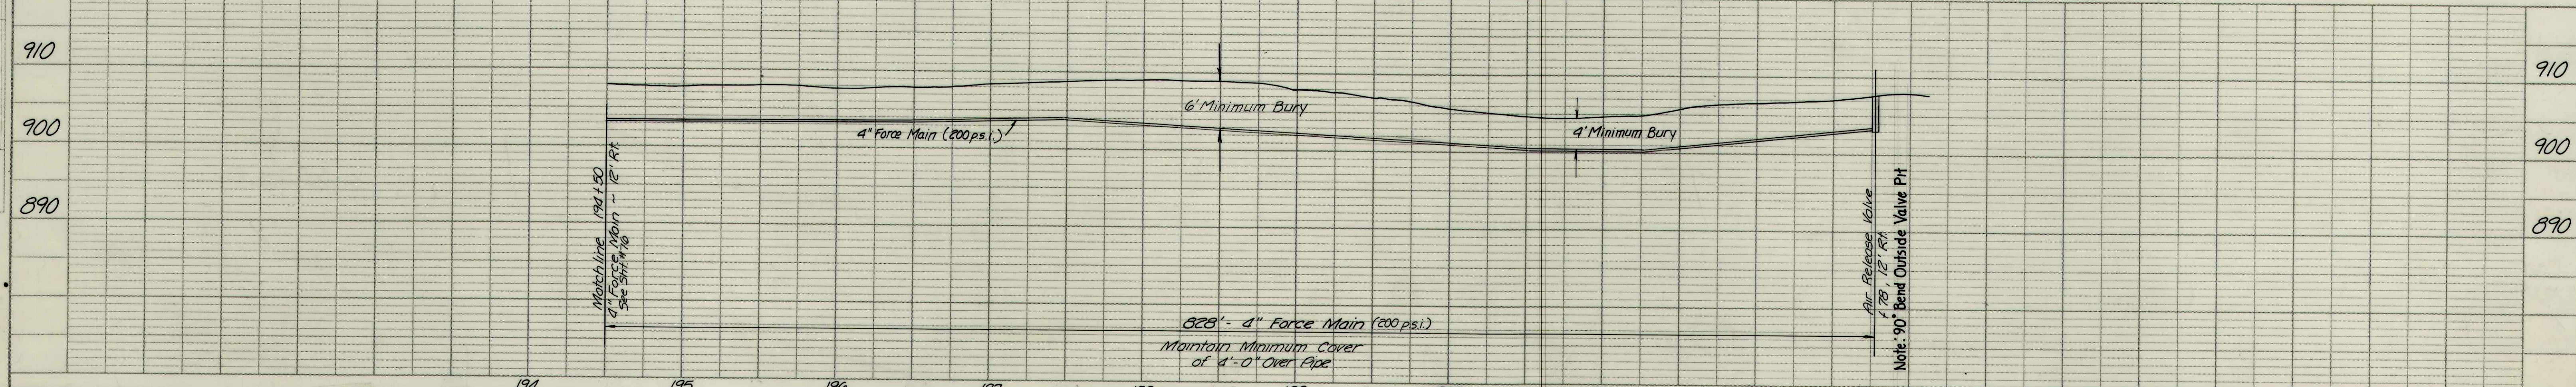



PLAN	SURVEYED	DATE
	PLOTTED	BY
	ALIGNMENT CHECKED	
	NOTES OF WAY CHECKED	

PROFILE	SURVEYED	DATE
	GRADES CHECKED	BY
	NOTES	
	STRUCTURE NOTATIONS	

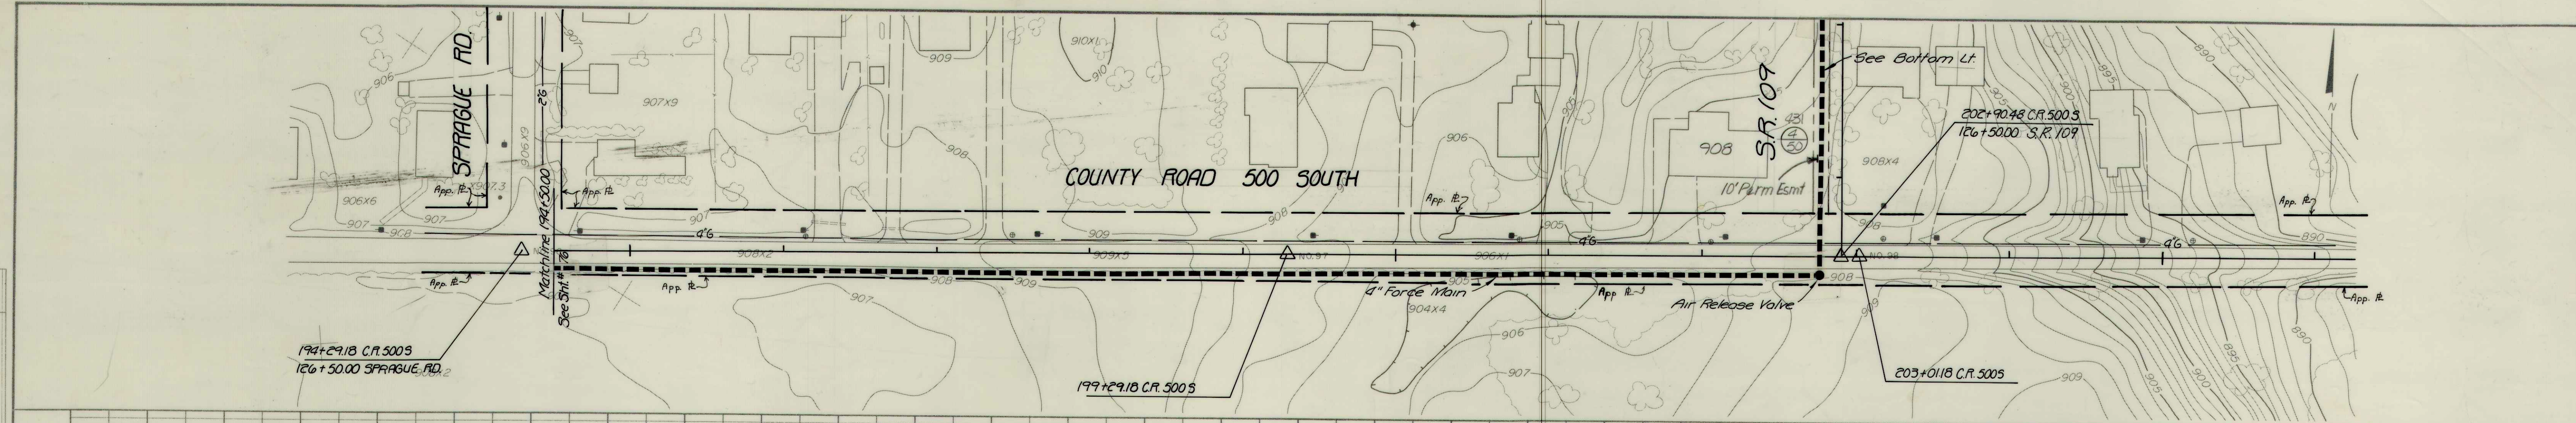

Contractor shall verify location and depth of 6" H.P. Gas Line before construction. Design of sewers and force mains shall be altered as required (subject to Resident Engineer approval).

RECORD DRAWING

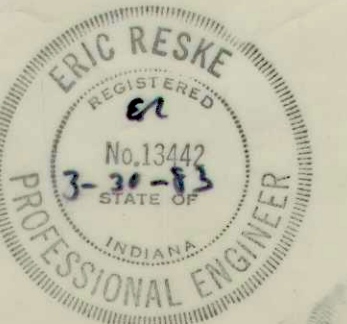

Co. Rd. 500 SOUTH S.R. 109 LINE "B.F.E."	
FALL CREEK R.W.D. PLAN & PROFILE	
HORIZ. 1"=50'	BEAM, LONGEST & NEFF, INC.
VERT. 1"=10'	CONSULTING ENGINEERS
	INDIANAPOLIS, INDIANA
	72