


|      |           |      |
|------|-----------|------|
| PLAN | SURVEYED  | DATE |
|      | PLOTTED   | BY   |
|      | NOTE BOOK |      |
|      | NO.       |      |

|         |           |      |
|---------|-----------|------|
| PROFILE | SURVEYED  | DATE |
|         | PLOTTED   | BY   |
|         | NOTE BOOK |      |
|         | NO.       |      |



**RECORD DRAWING**

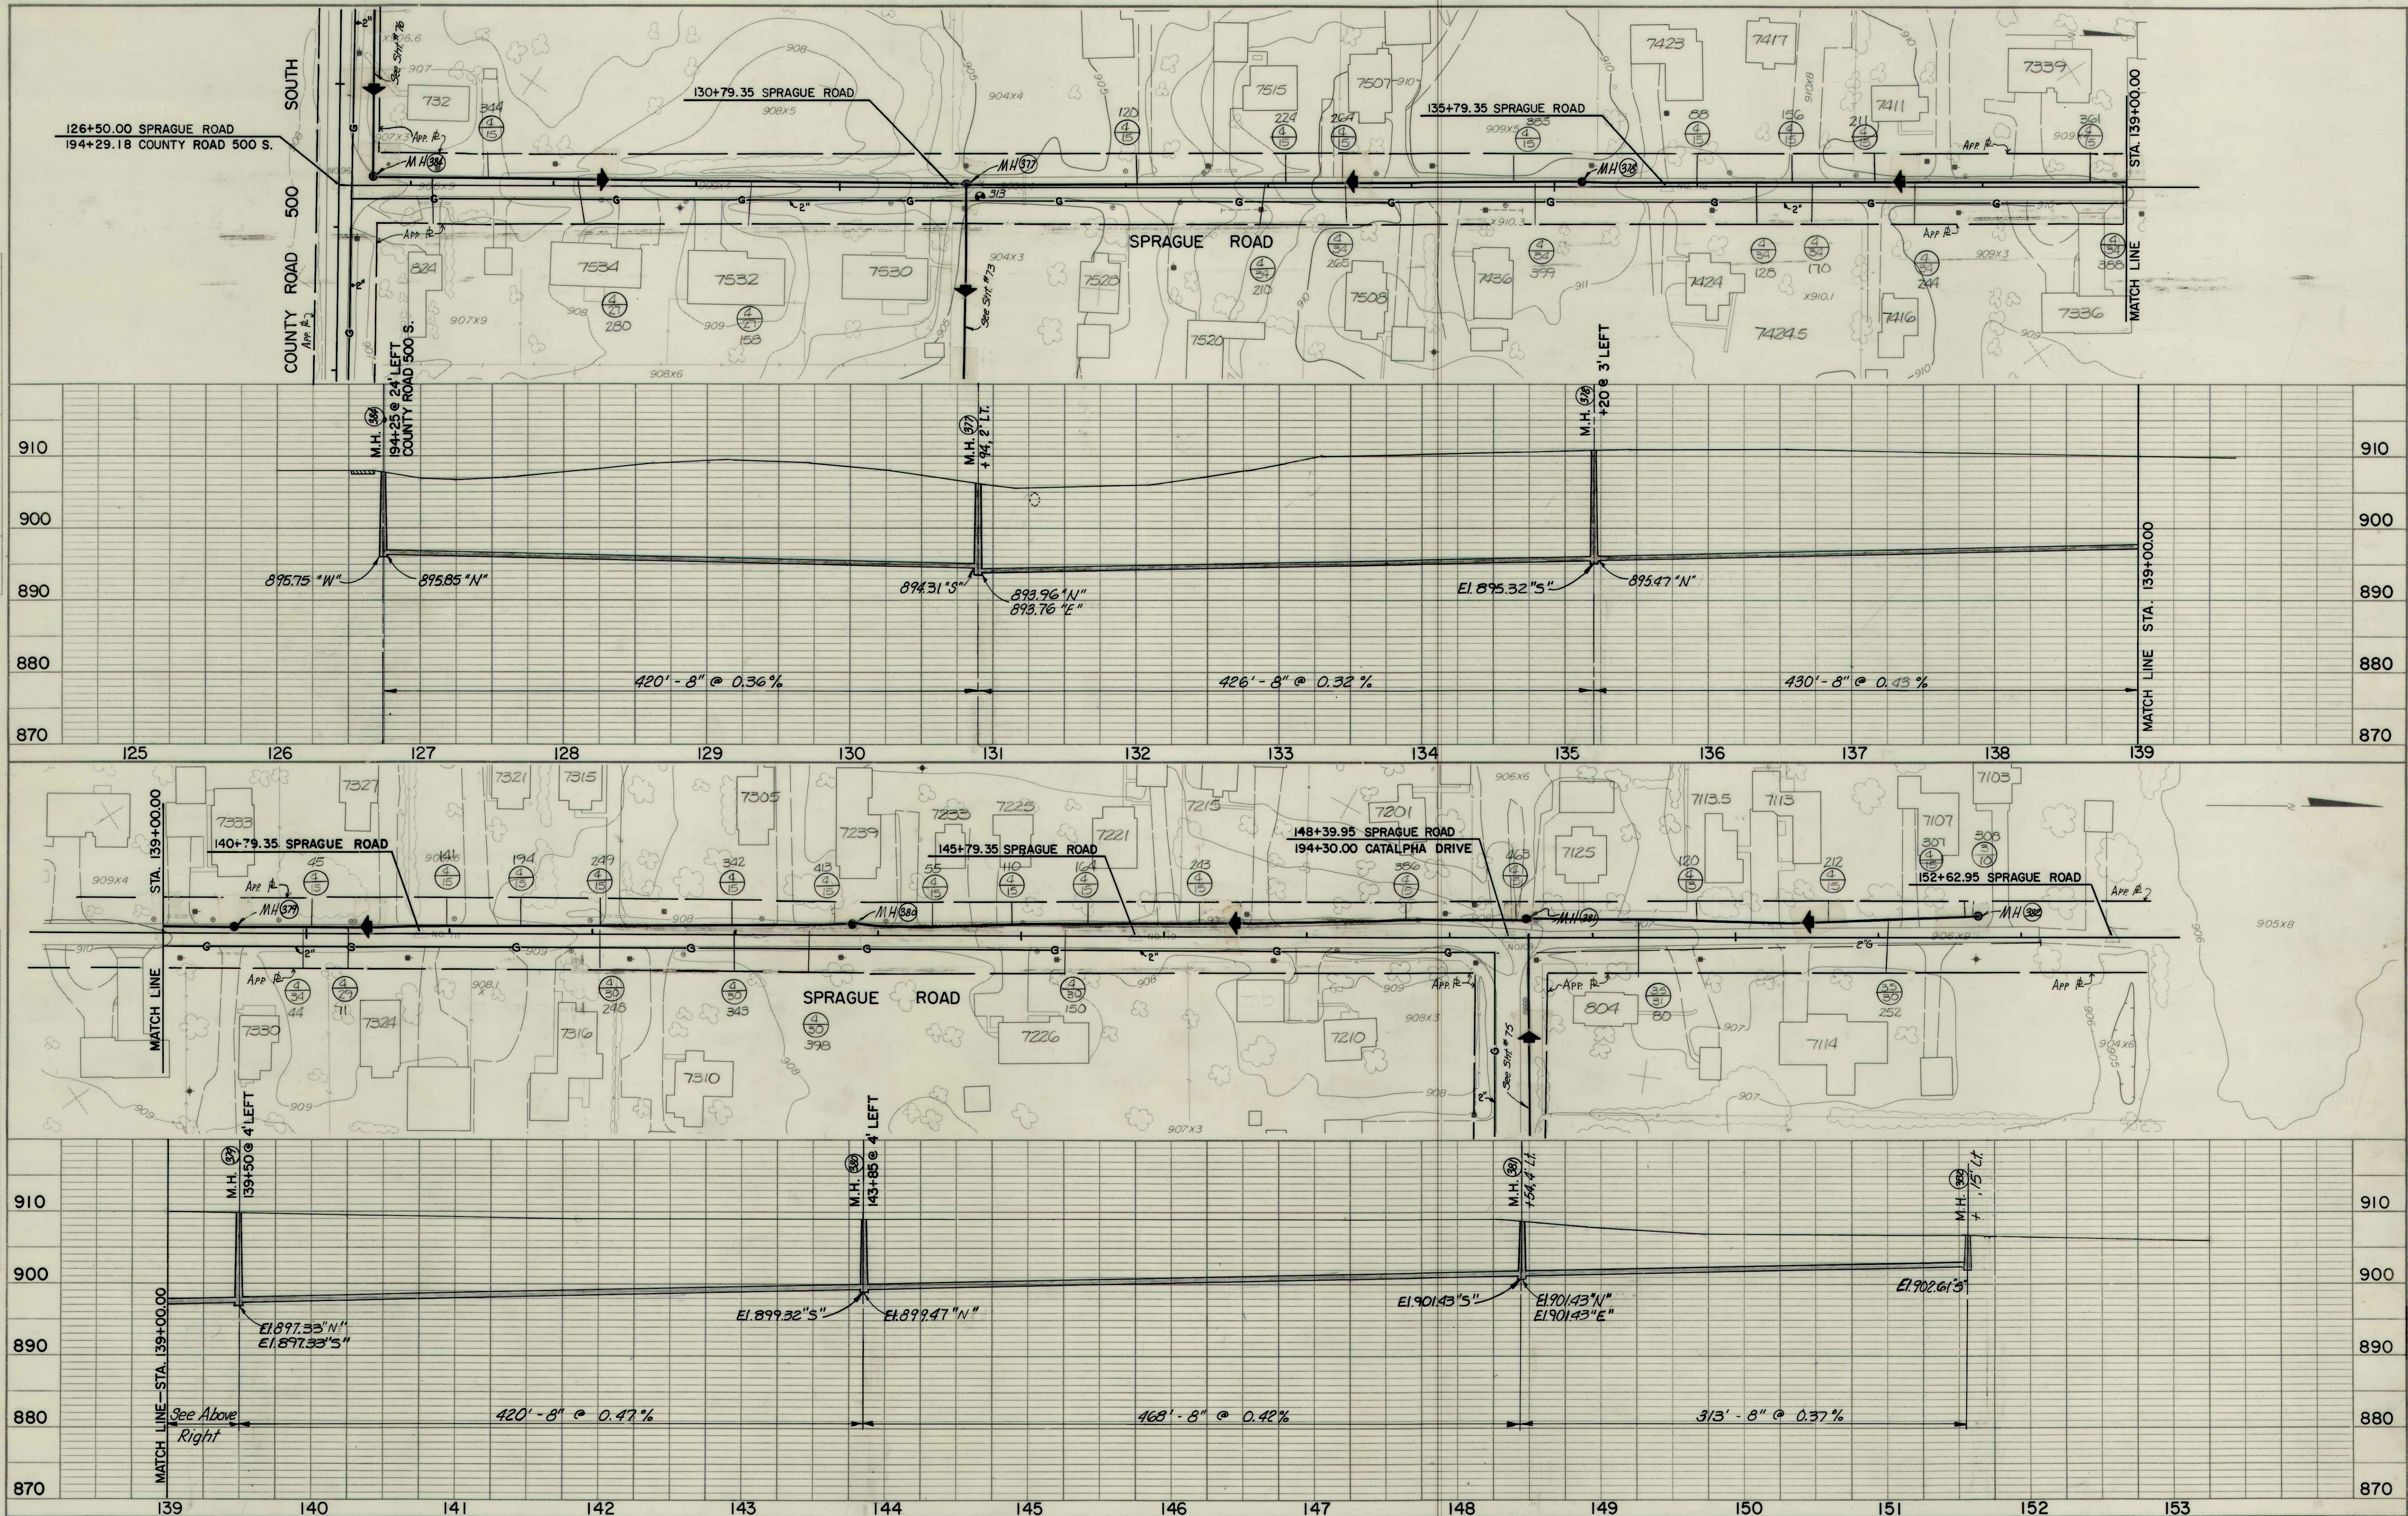

| SPRAGUE ROAD                     |                                               |             |
|----------------------------------|-----------------------------------------------|-------------|
| FALL CREEK R.W.D. PLAN & PROFILE |                                               |             |
| HORIZ. 1"=50'                    | BEAM, LONGEST & NEFF, INC.                    | SHEET<br>74 |
| VERT. 1"=10'                     | CONSULTING ENGINEERS<br>INDIANAPOLIS, INDIANA |             |