



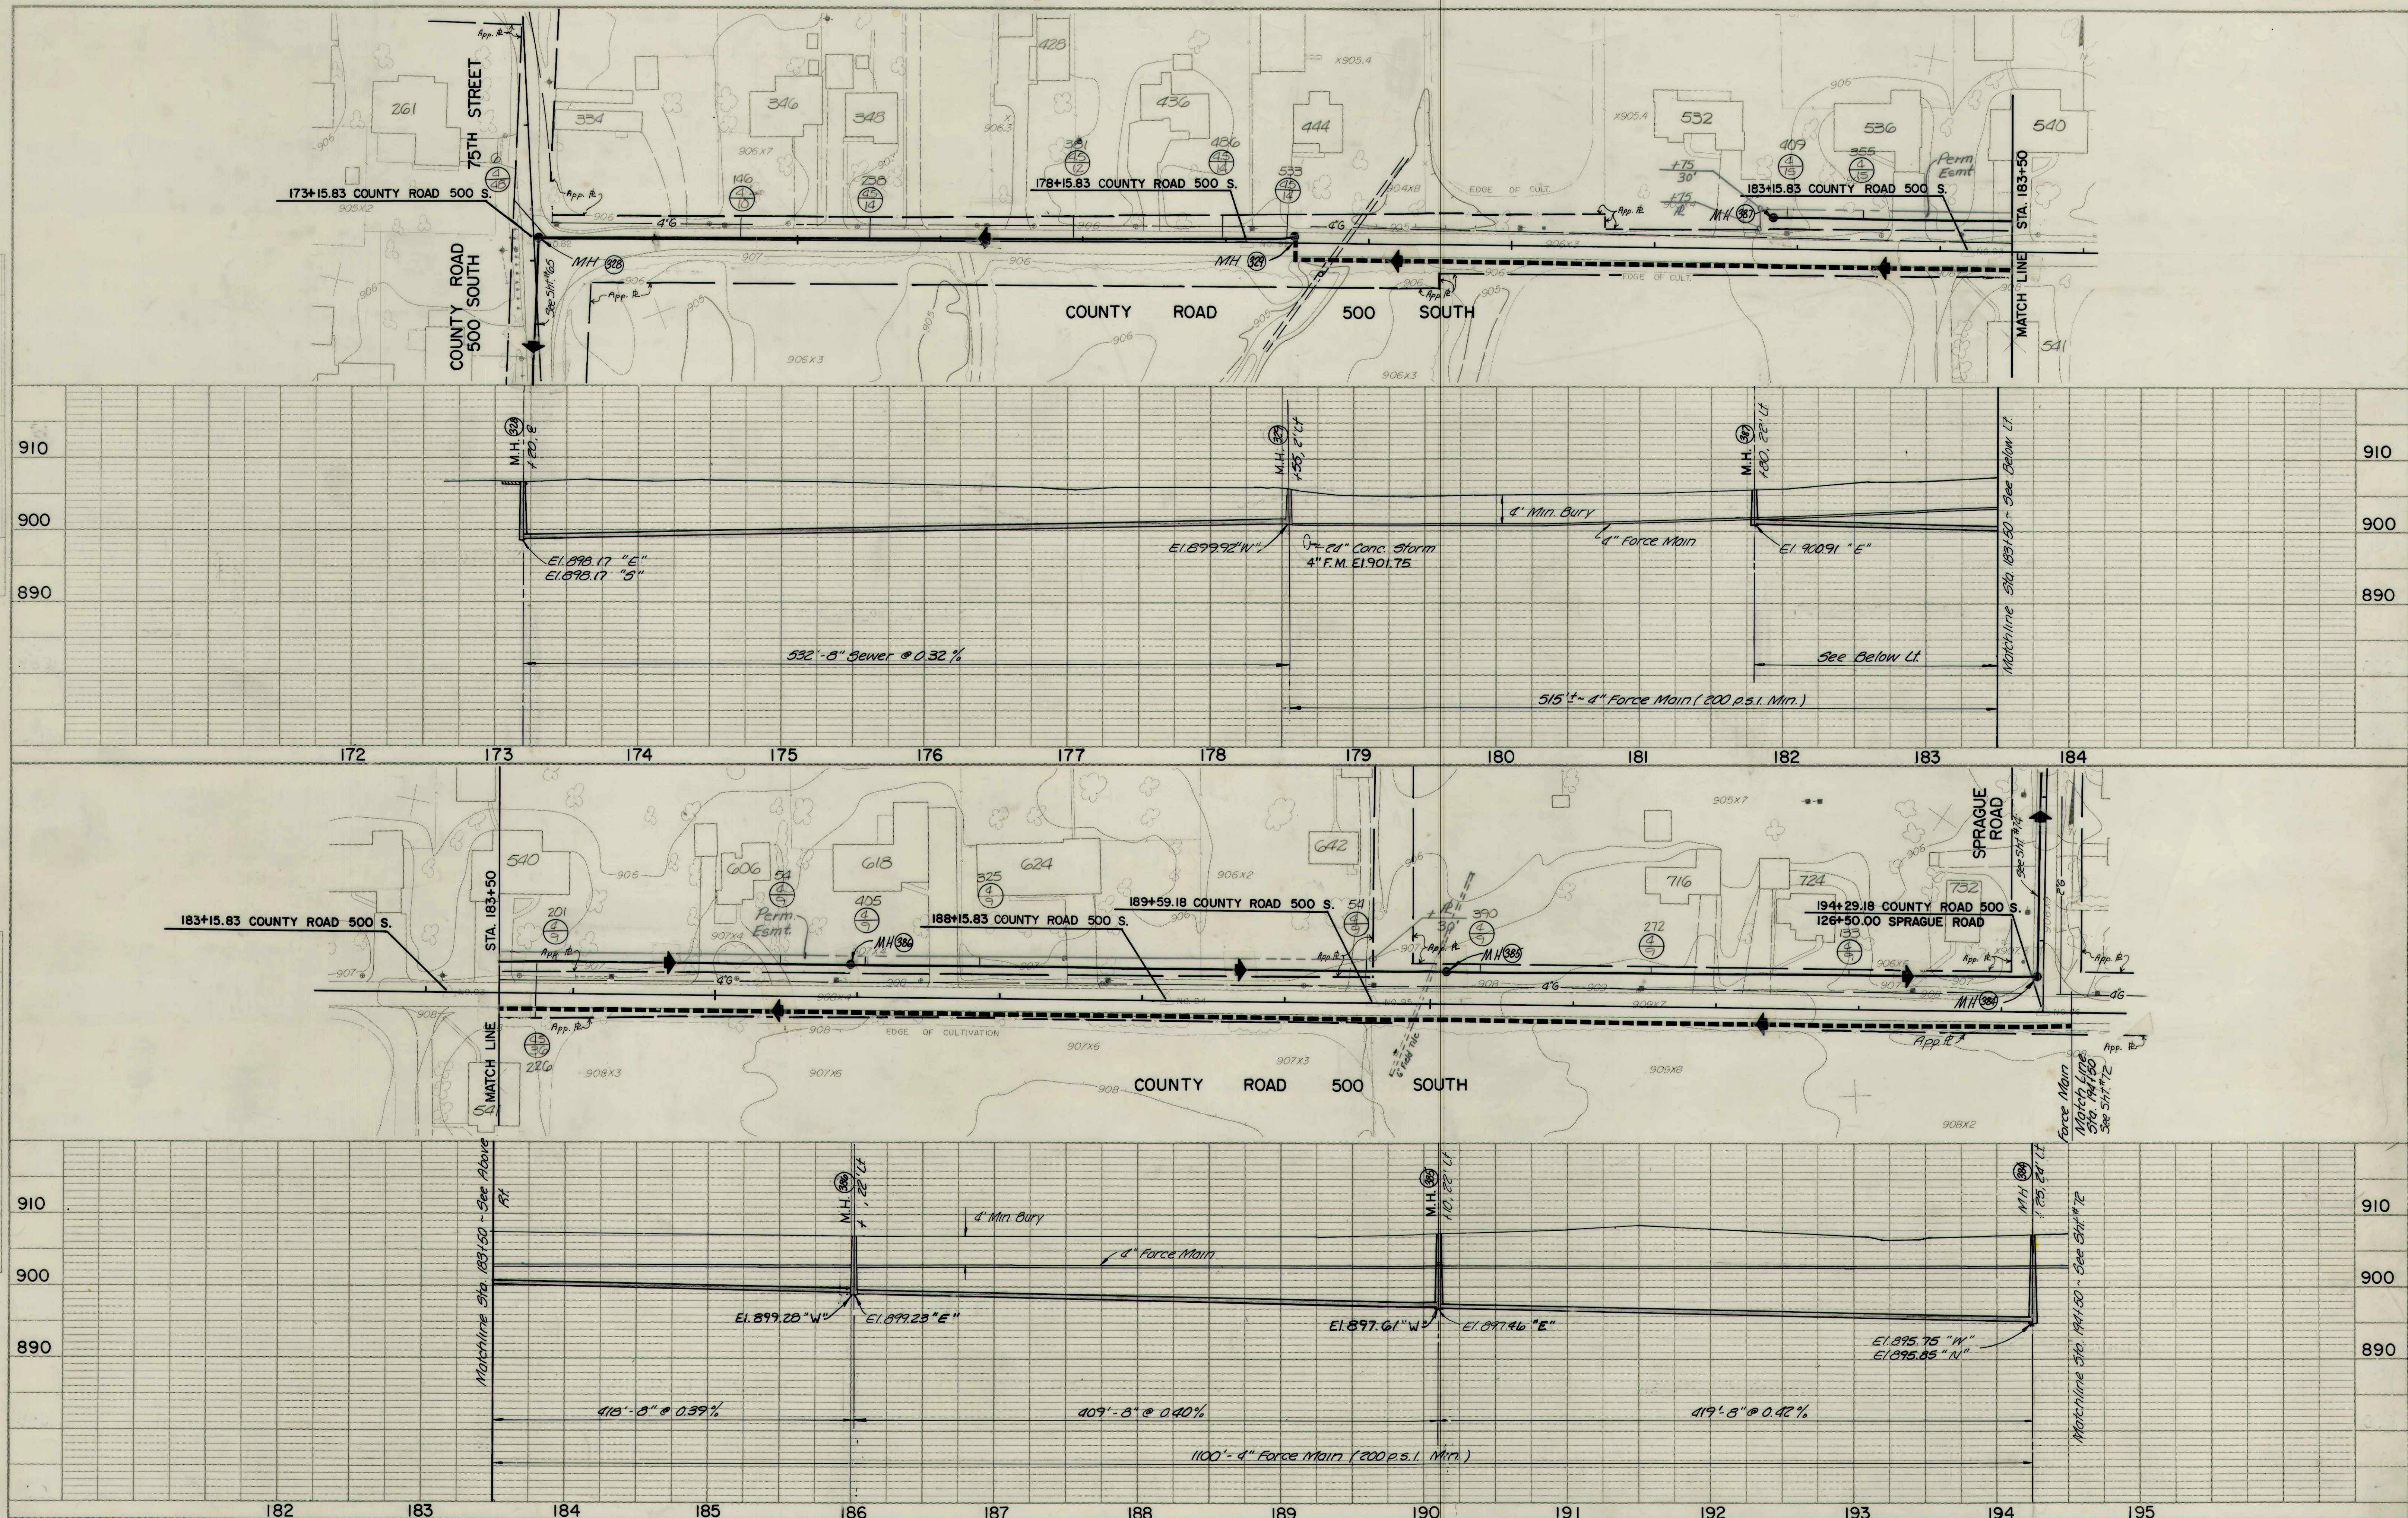

## RECORD DRAWING

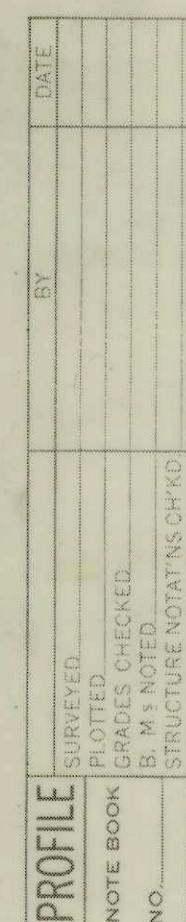

CO. RD. 500 S

|                                  |                                                    |       |
|----------------------------------|----------------------------------------------------|-------|
| FALL CREEK R.W.D. PLAN & PROFILE |                                                    | SHEET |
| HORIZ. 1"=50'                    | BEAM, LONGEST & NEFF, INC.<br>CONSULTING ENGINEERS | 76    |
| VERT. 1"=10'                     | INDIANAPOLIS, INDIANA                              |       |

F SHEET

76