



TYPE "A" VALVE BOX
NO SCALE

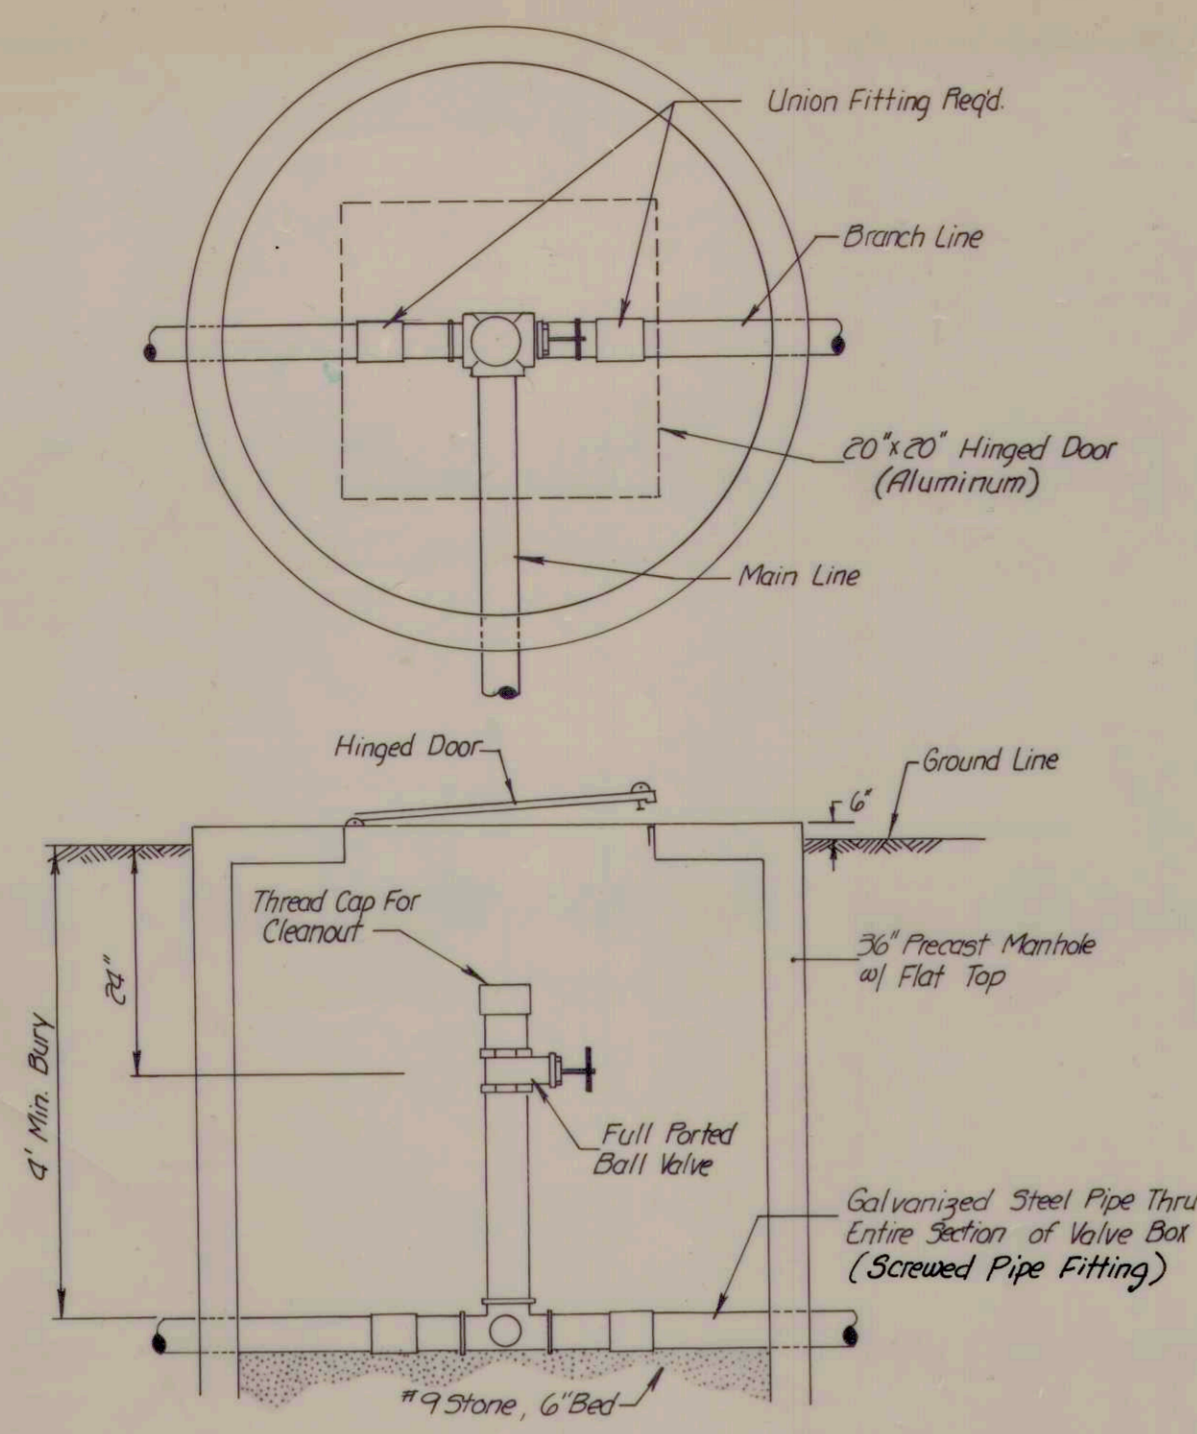


TYPE "B" VALVE BOX
NO SCALE

VALVE BOX NOTES



- 1) STANDARD THREADED GALVANIZED T-FITTING, MAY BE UTILIZED IN LIEU OF A SIDE OUTLET TEE OR A SIDE OUTLET CROSS.
- 2) CLEANOUT RISER AND VALVE SHALL BE SIZED TO MATCH LARGEST PRESSURE SEWER ENTERING VALVE BOX.
- 3) SIZE REDUCTION/INCREASE SHALL BE MADE WITH STD. REDUCER FITTINGS INSIDE VALVE BOX.
- 4) GALVANIZED PIPE TO EXTEND TO 5' MINIMUM OUTSIDE VALVE BOX.

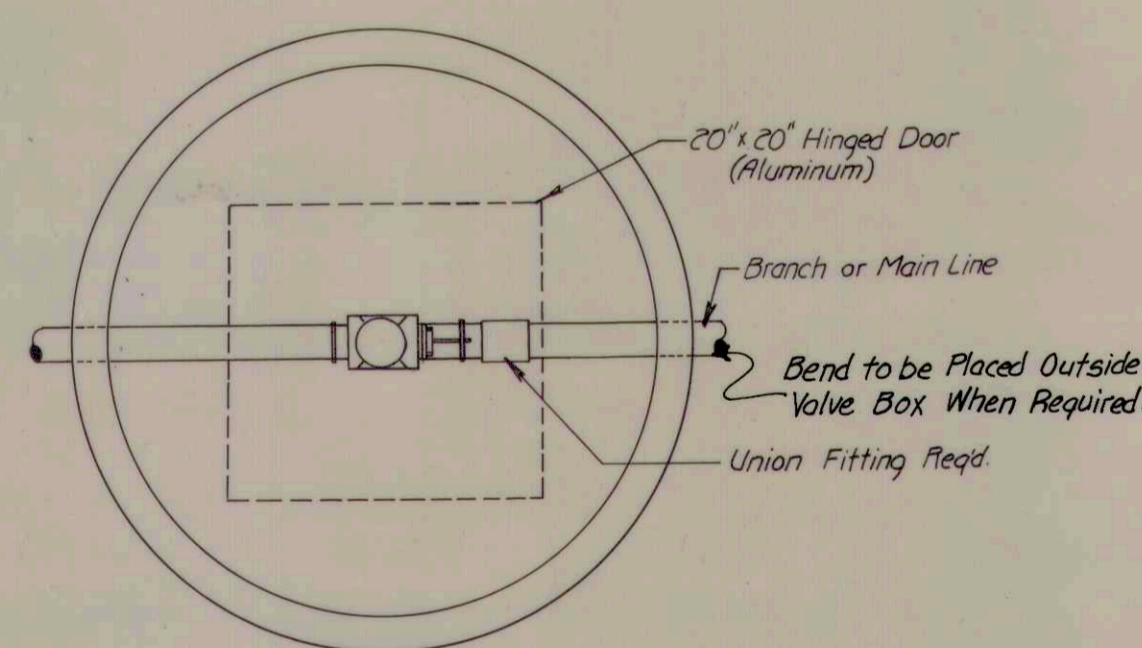


TYPE "C" VALVE BOX
NO SCALE

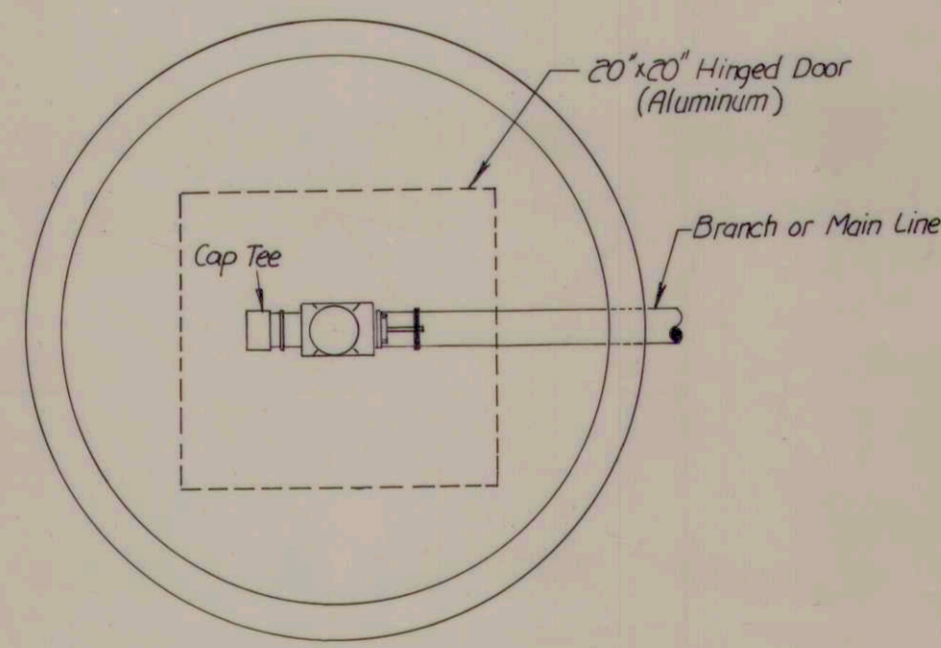

TYPE "D" VALVE BOX
NO SCALE

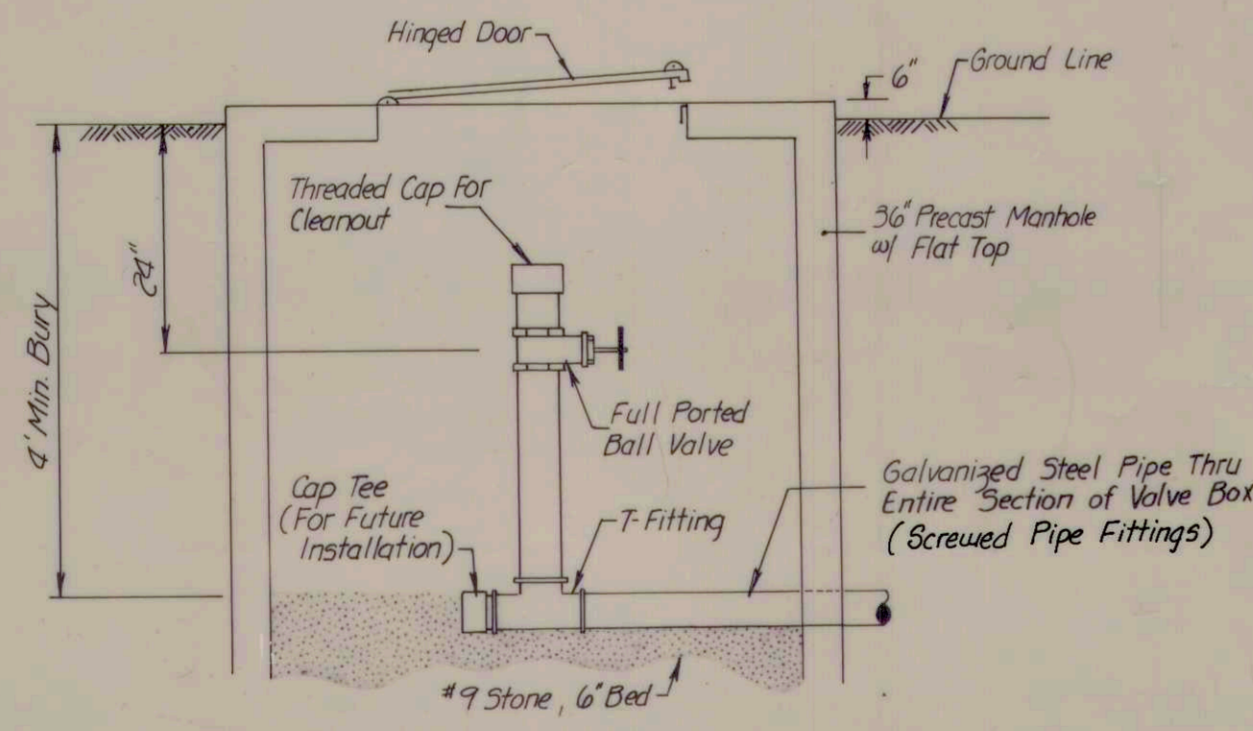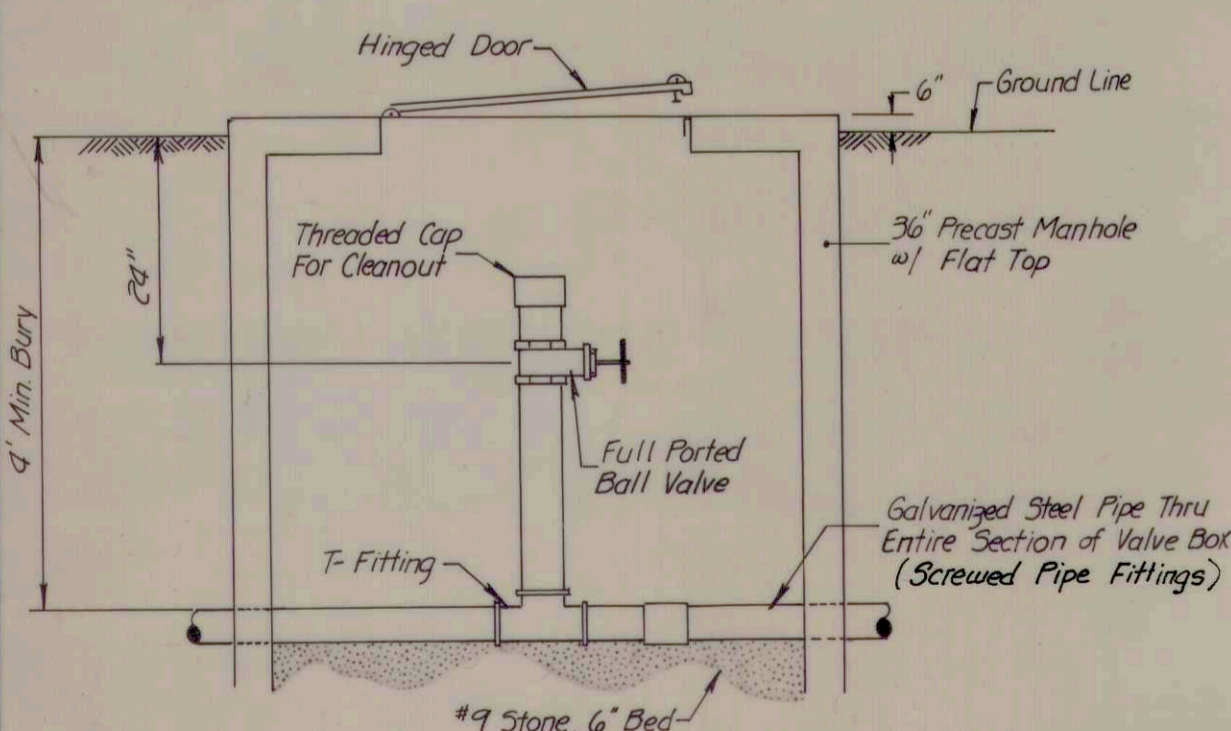

VALVE BOX DETAILS

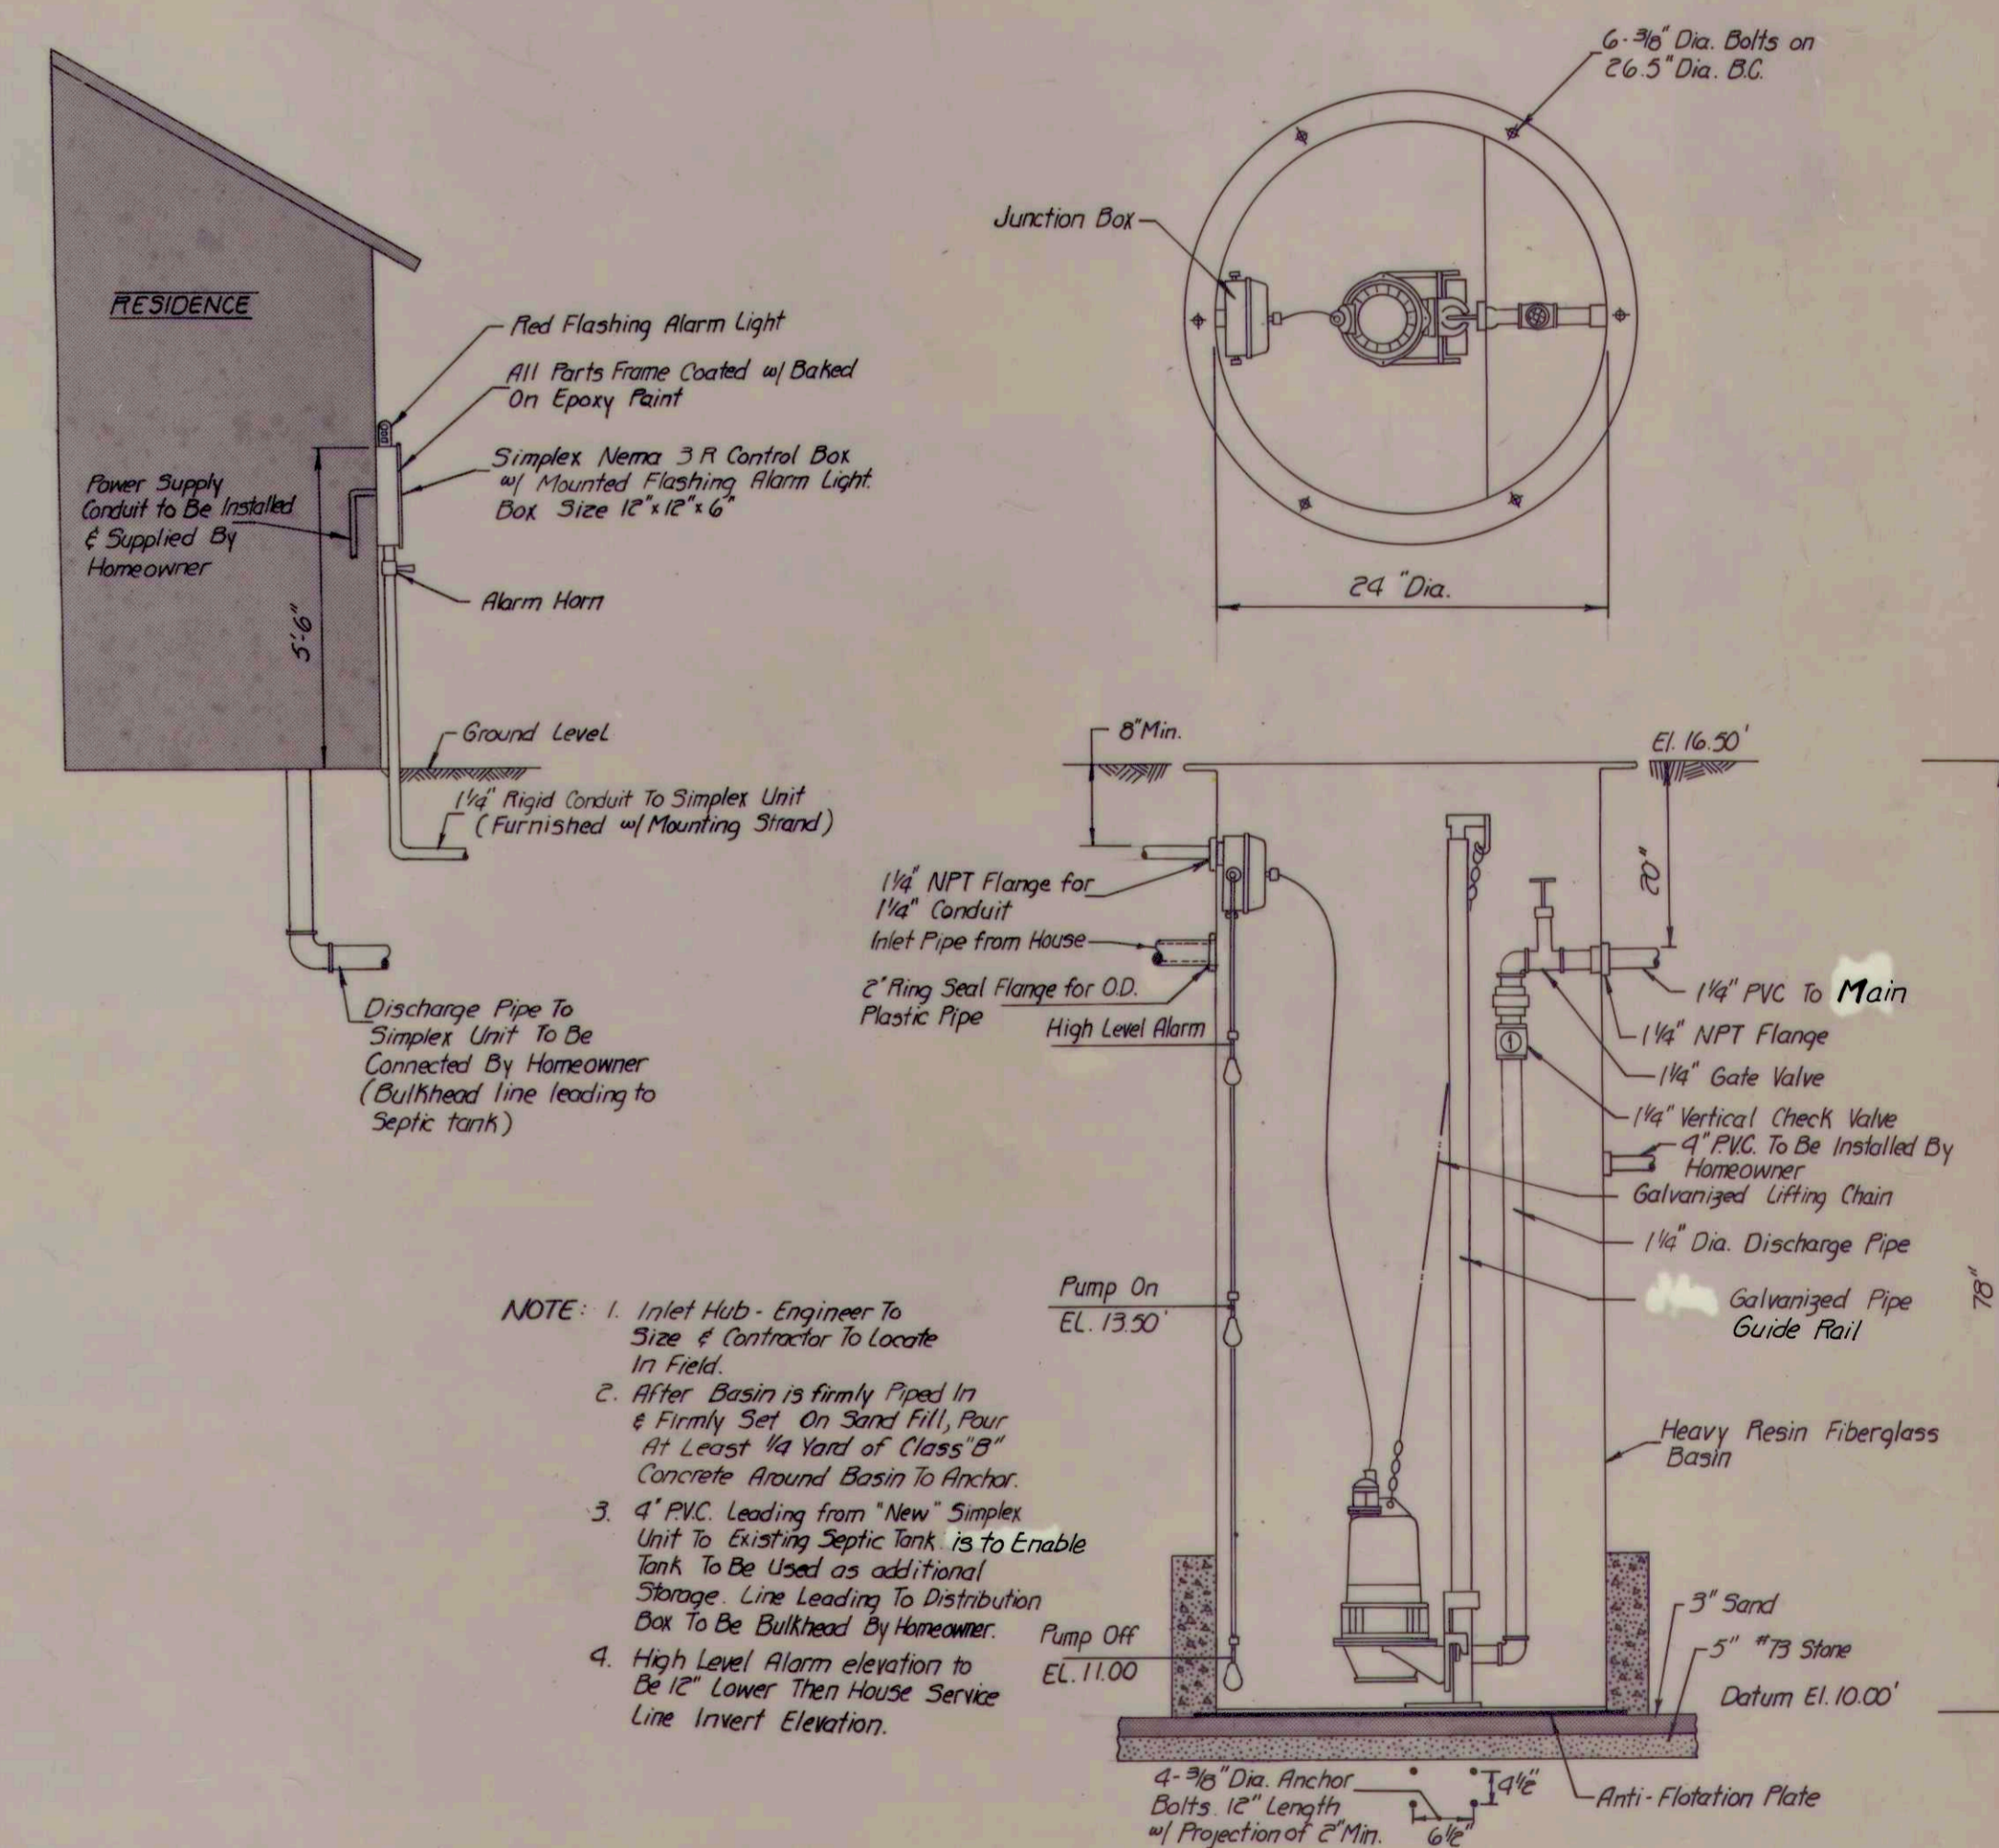

SIMPLEX UNIT GRINDER PUMP
NO SCALE

RECORD DRAWING

GRINDER STATION & PRESSURE SEWER DETAILS		
Scale: NONE	FALL CREEK WASTEWATER FACILITIES	Sheet
Drawn By:	BEAM, LONGEST & NEFF	80
Designed By:	Consulting Engineers 8136 Castleton Road Indianapolis In. 46250	
Certified By:		

