

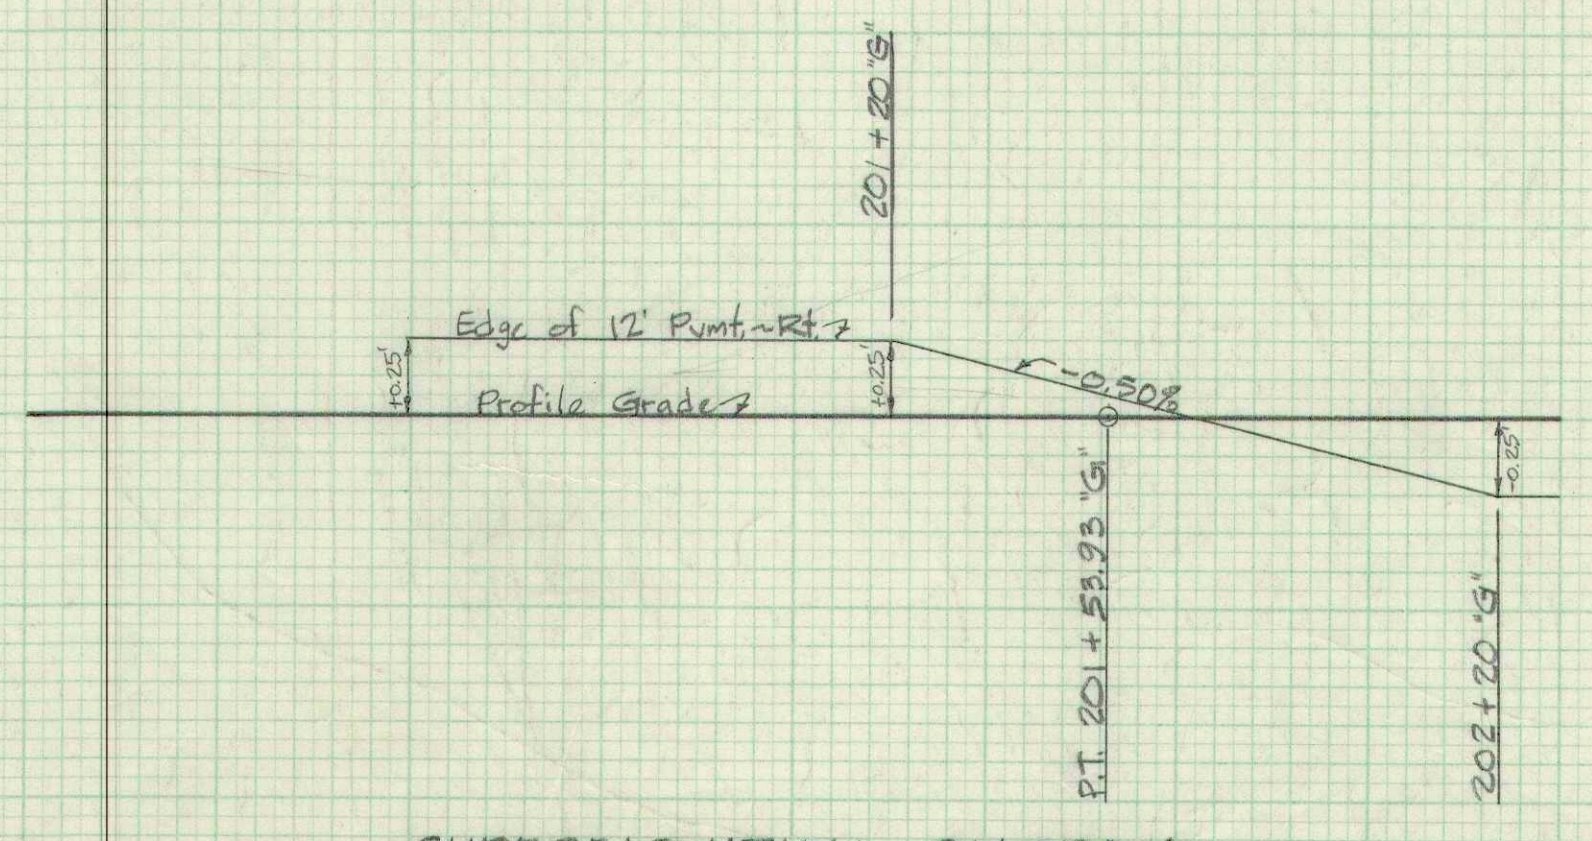
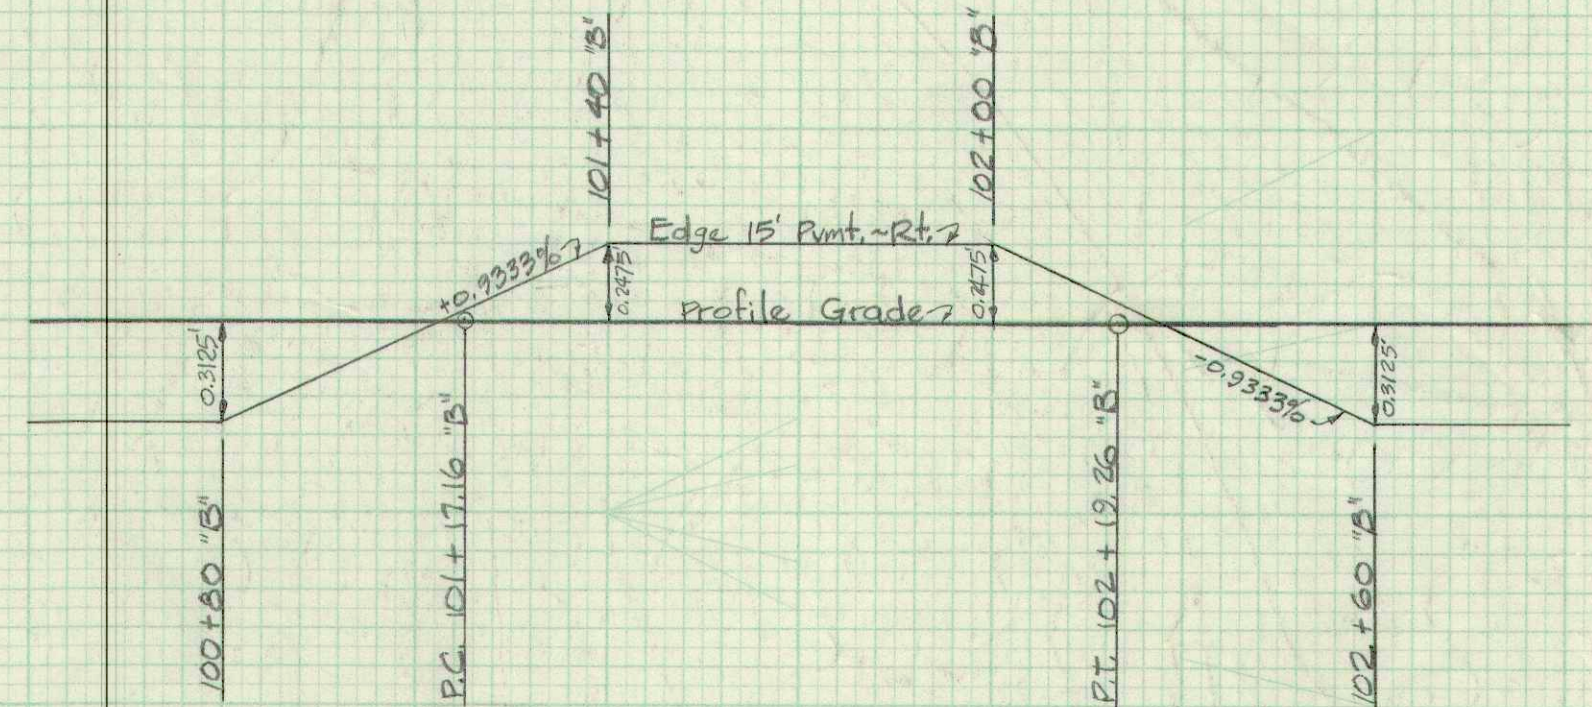


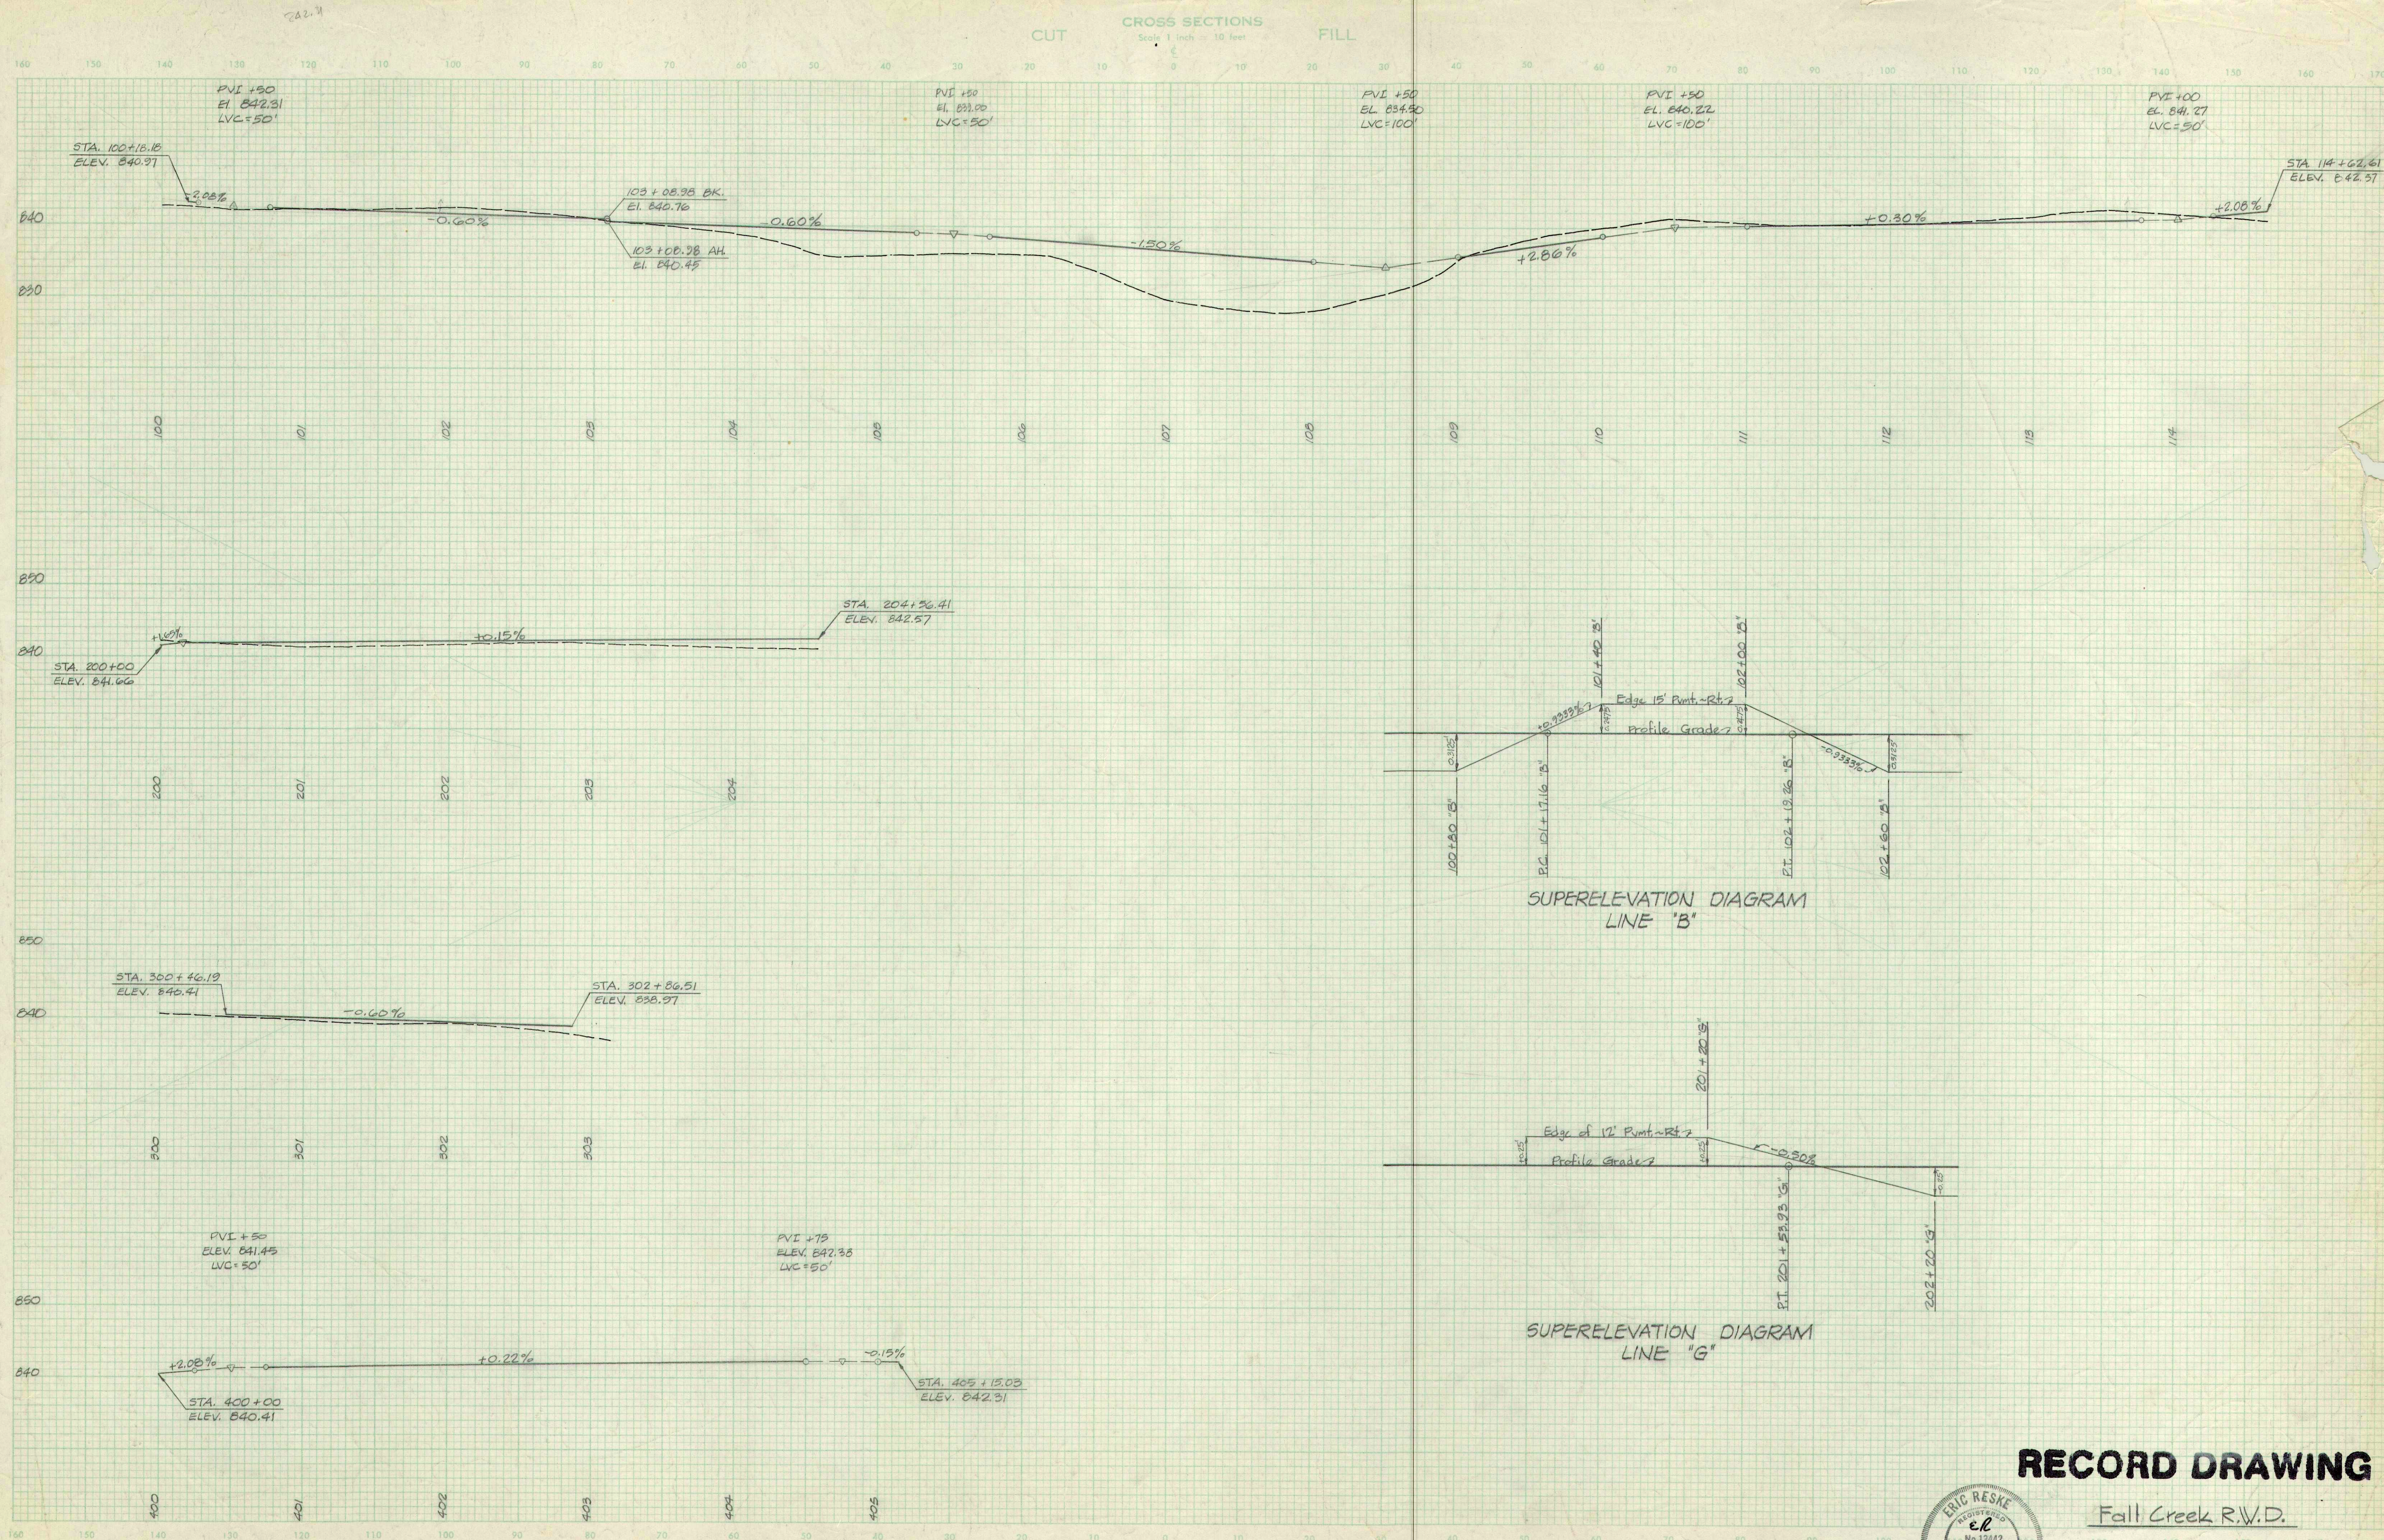

RECORD DRAWING

Fall Creek R.W.D.

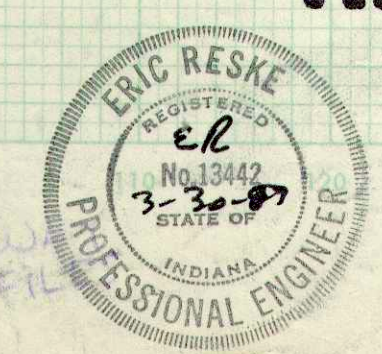

FEDERAL ROAD DISTRICT NO.	STATE	PROJECT NO.	FISCAL YEAR	SHEET NO.	TOTAL SHEETS
5	IND.			81	

ROADWAY PROFILE LINE