



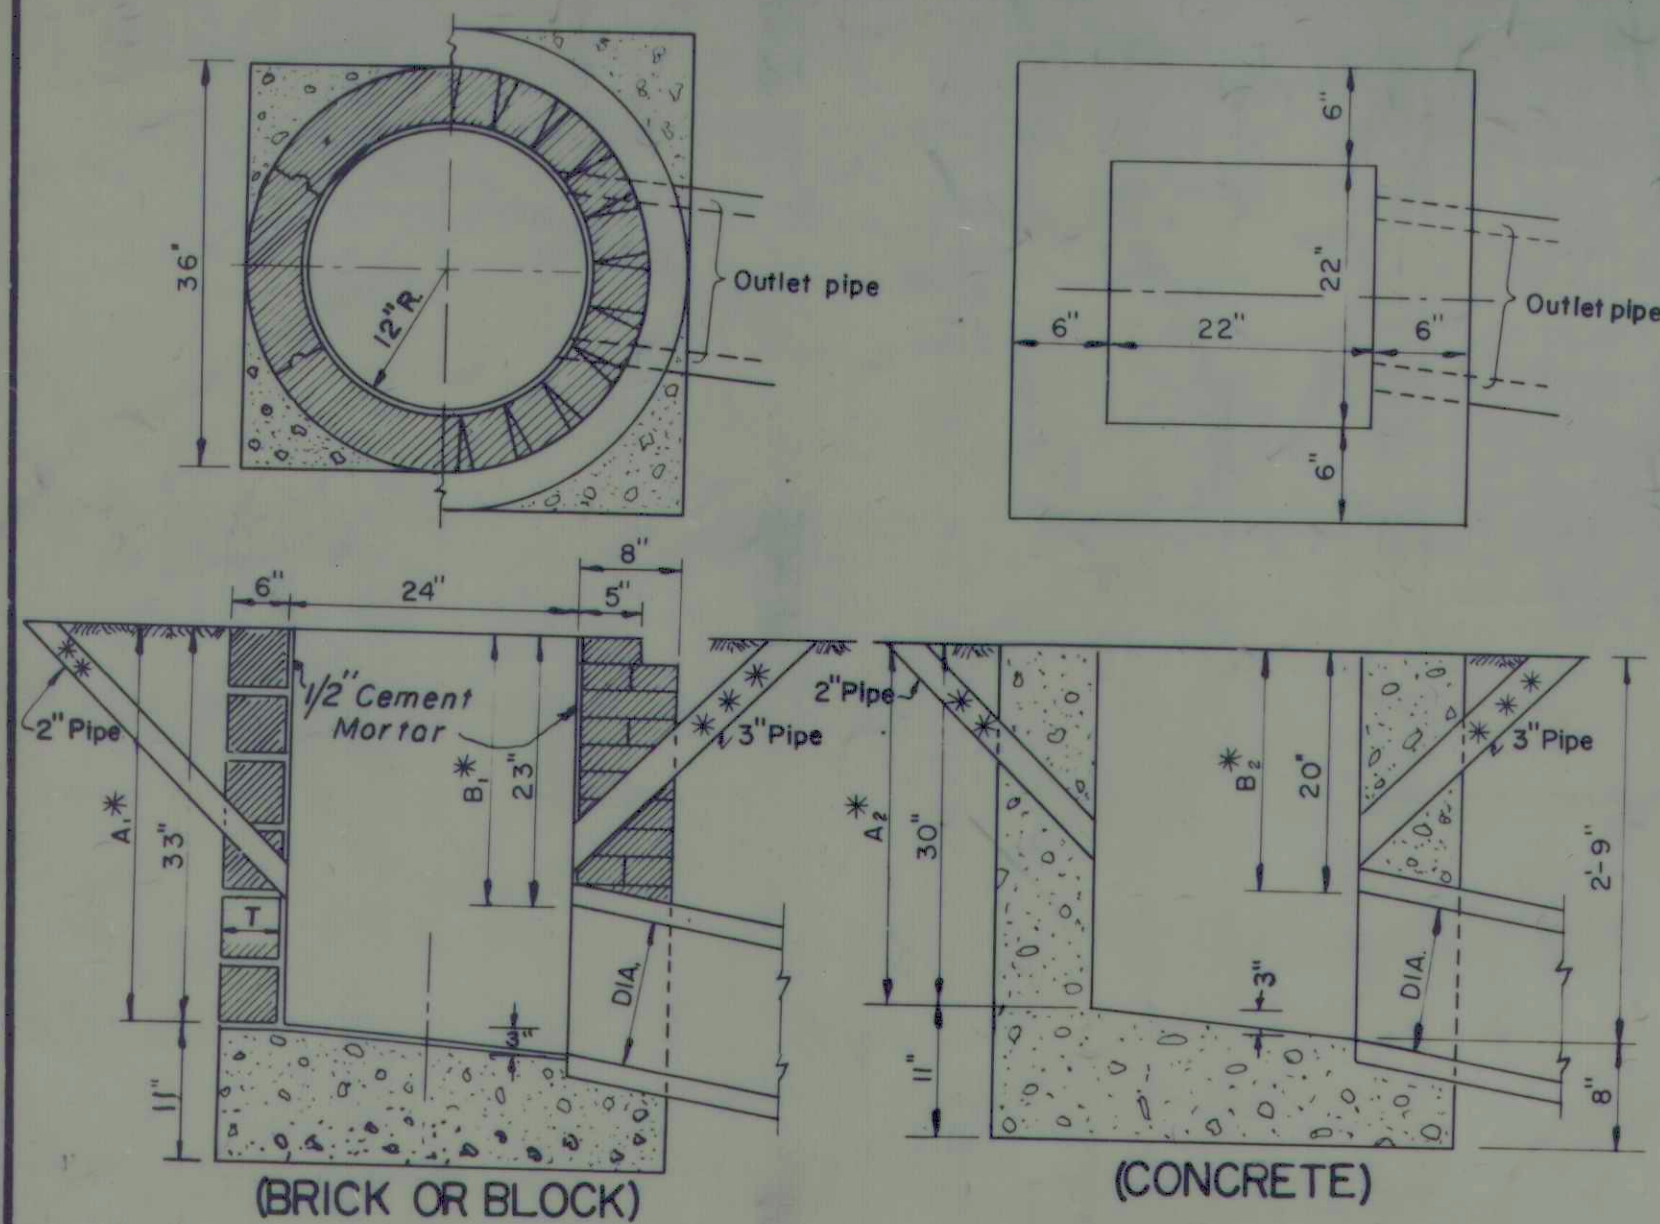


NOTE:- Use of Brick, Block or Concrete permissible.


Type A

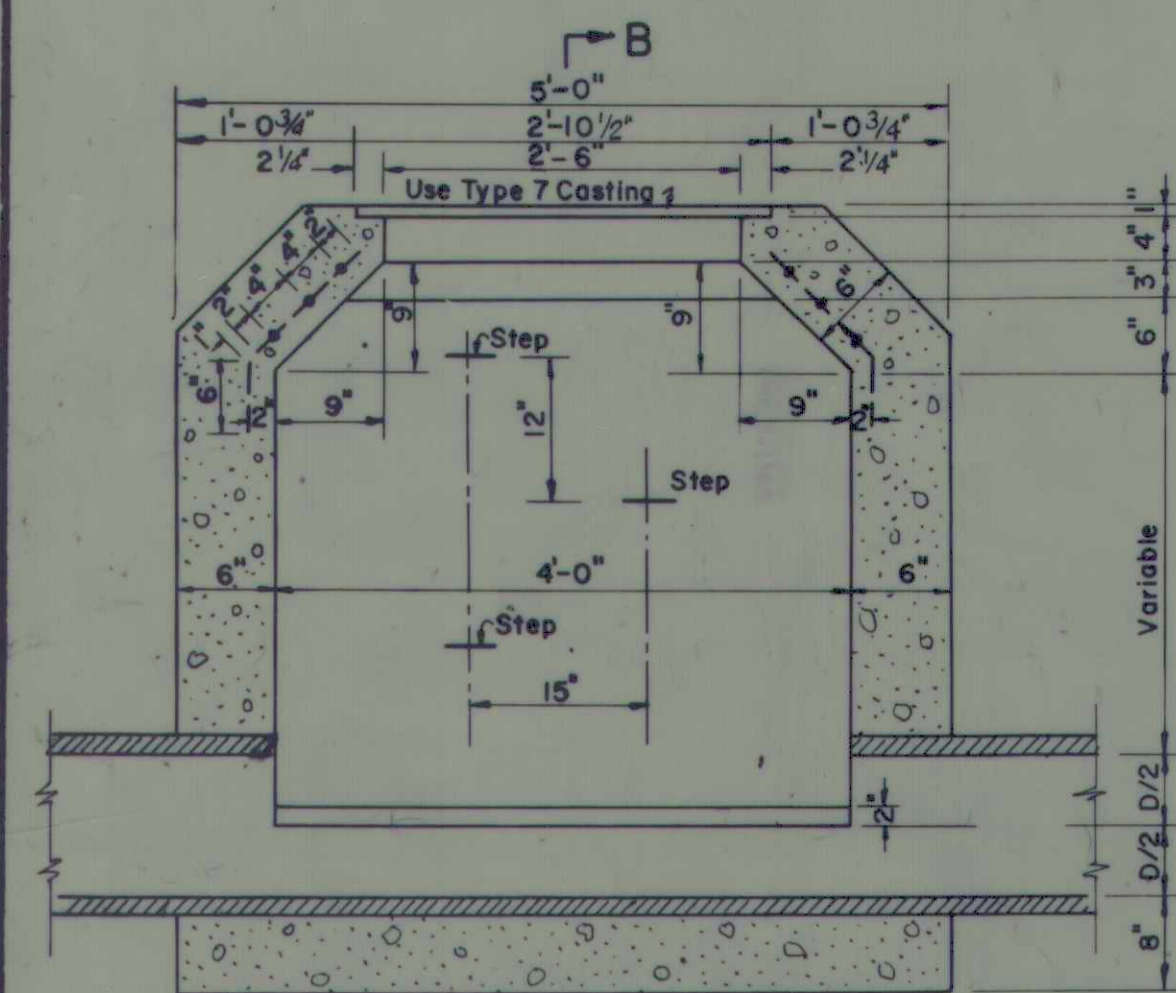


SECTION A-A

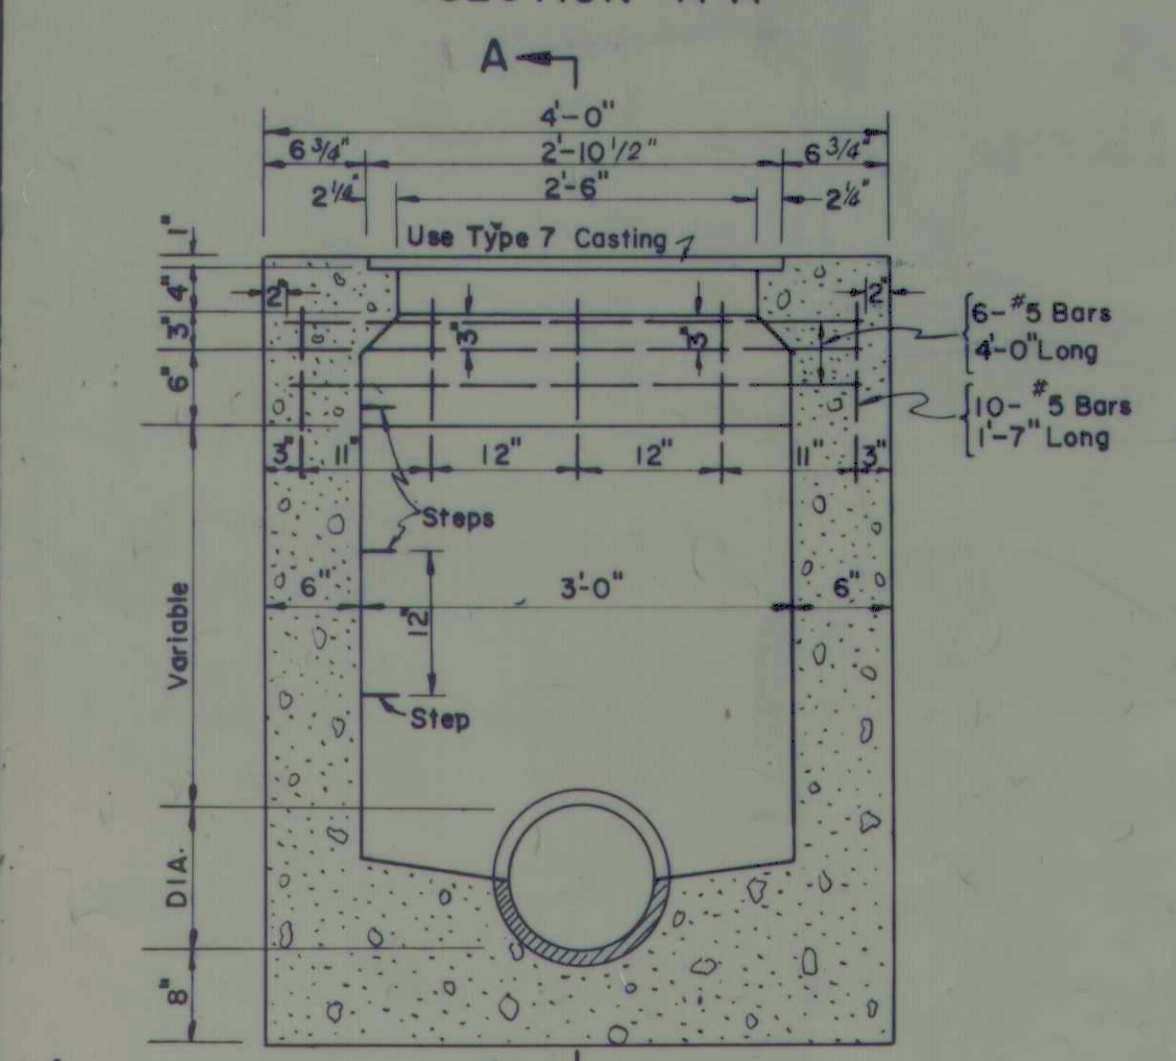

SECTION B-B
Type G (Conc.)

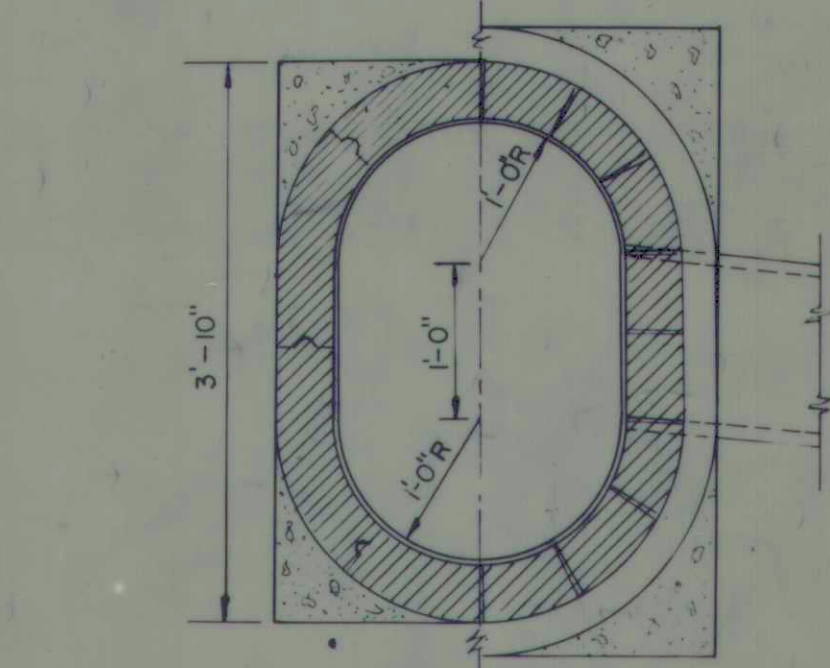


(BRICK OR BLOCK)

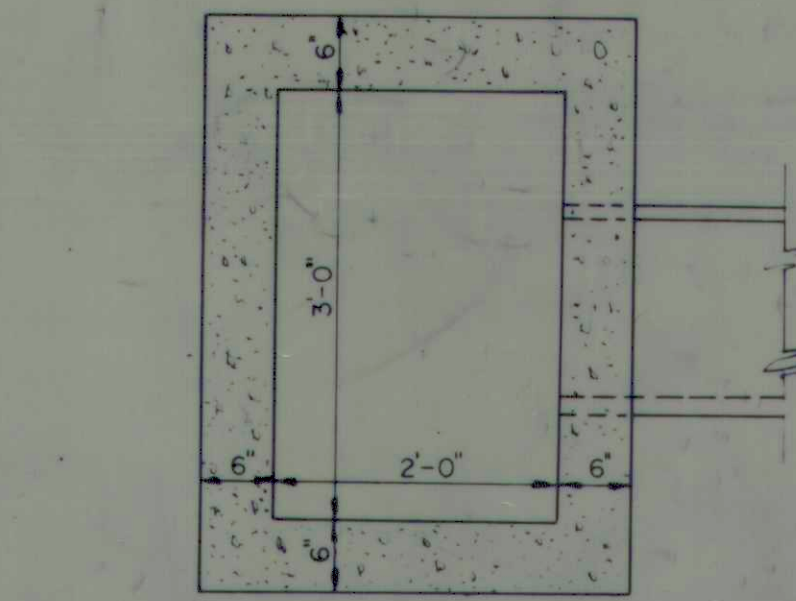

(CONCRETE)

NOTE:- Use of Brick, Block or Concrete permissible.


Type J

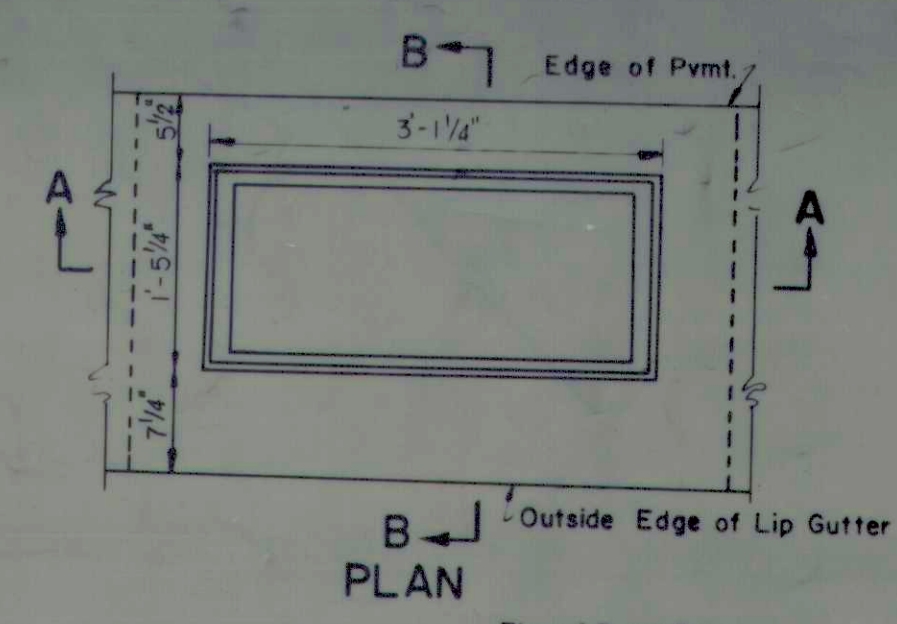


SECTION A-A

Type D (Conc.)

NOTE:
T = 8" For Brick Structure
T = 6" For Segmental Block Structure

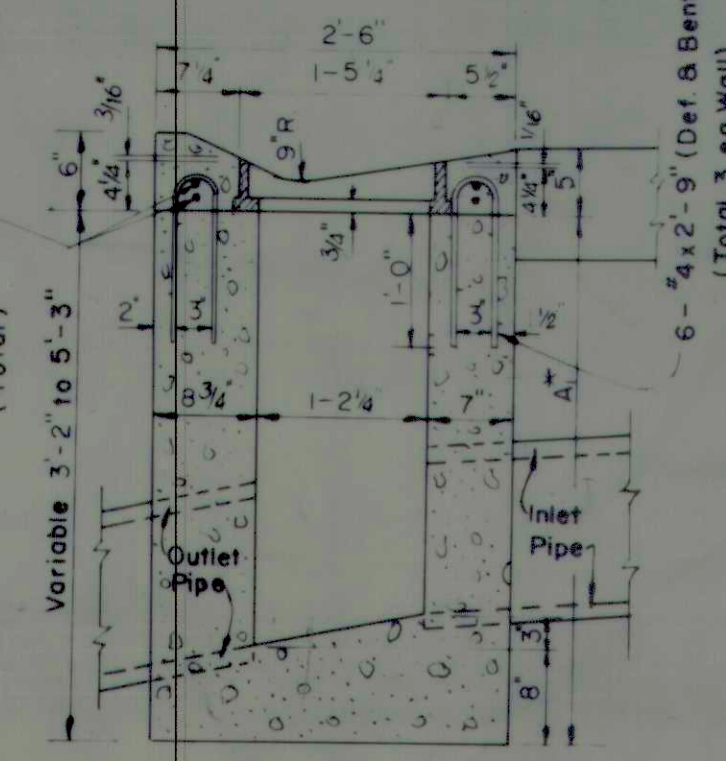


SECTION B-B

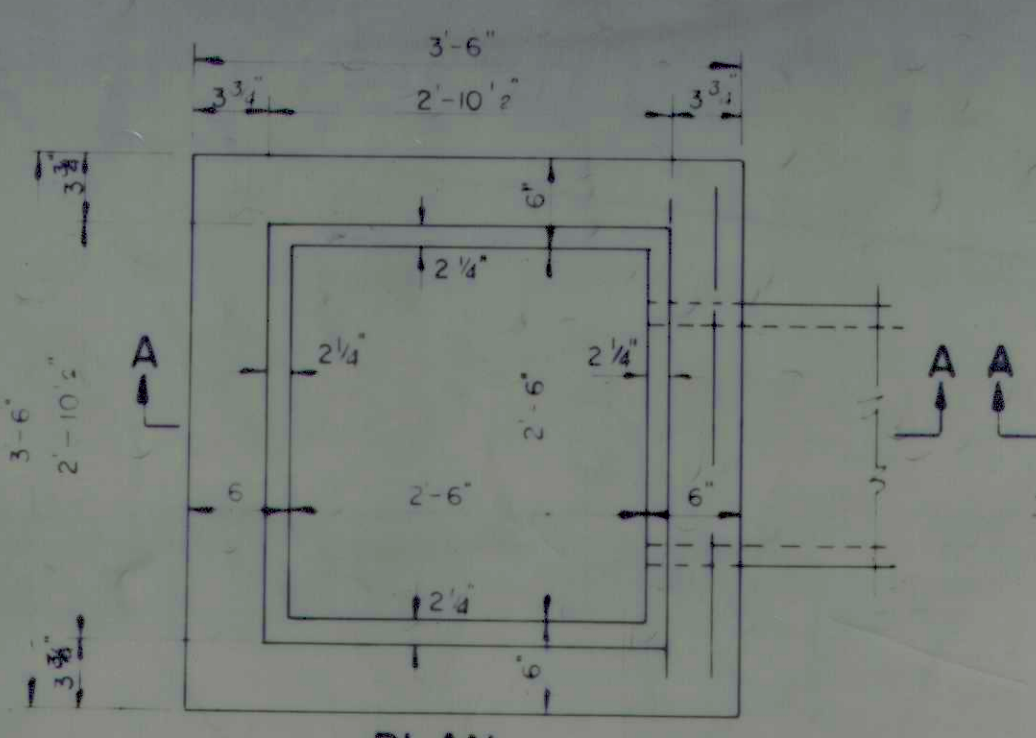


PLAN

SECTION A-A
Type E (Conc.)

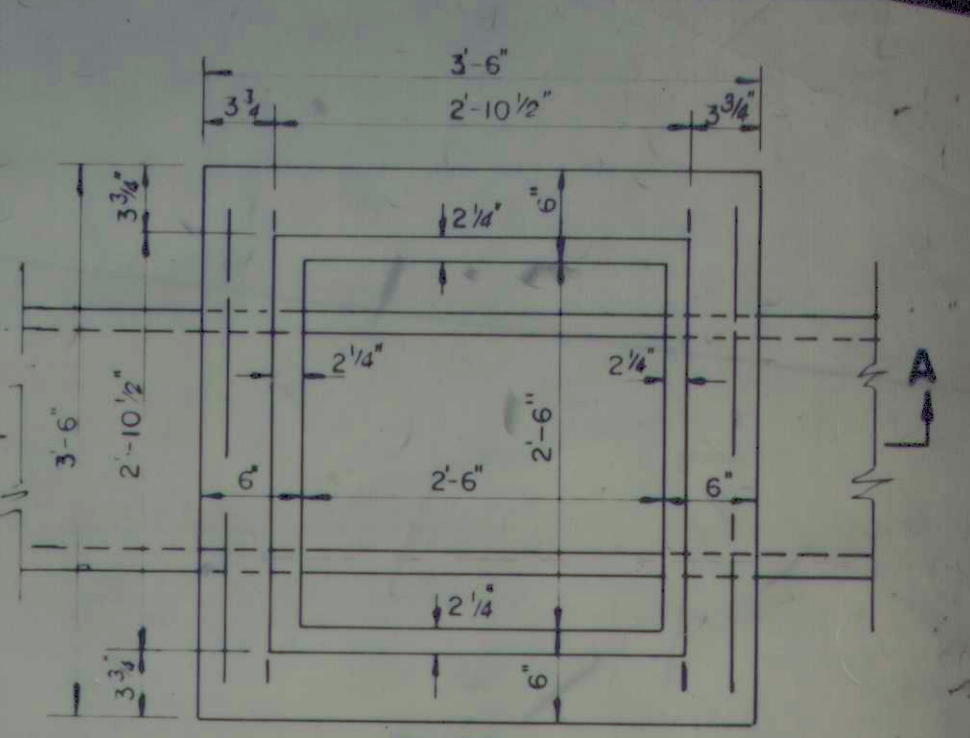


PLAN


SECTION A-A
Type F (Conc.)

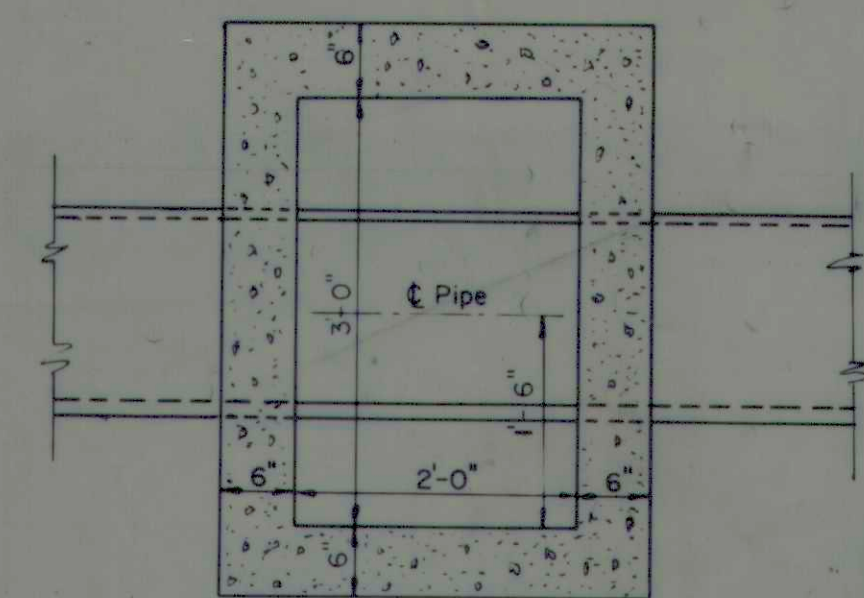

Type M (Conc.)

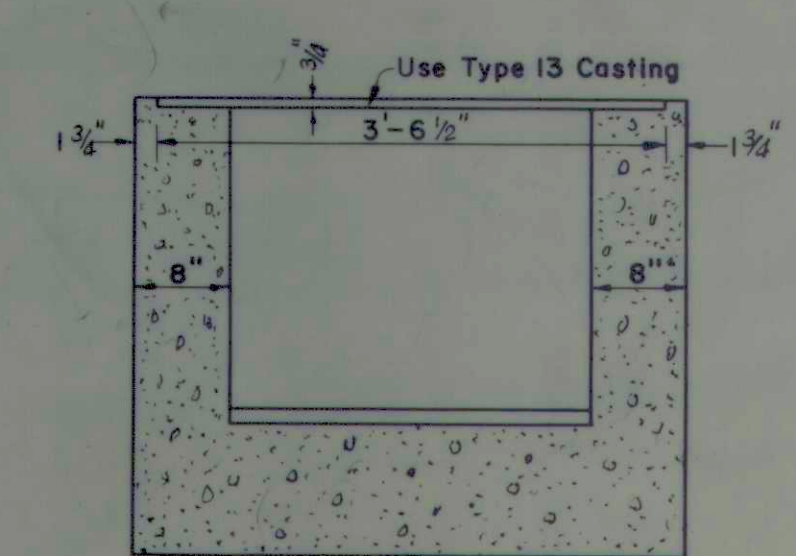

SECTION A-A
Type R (Conc.)

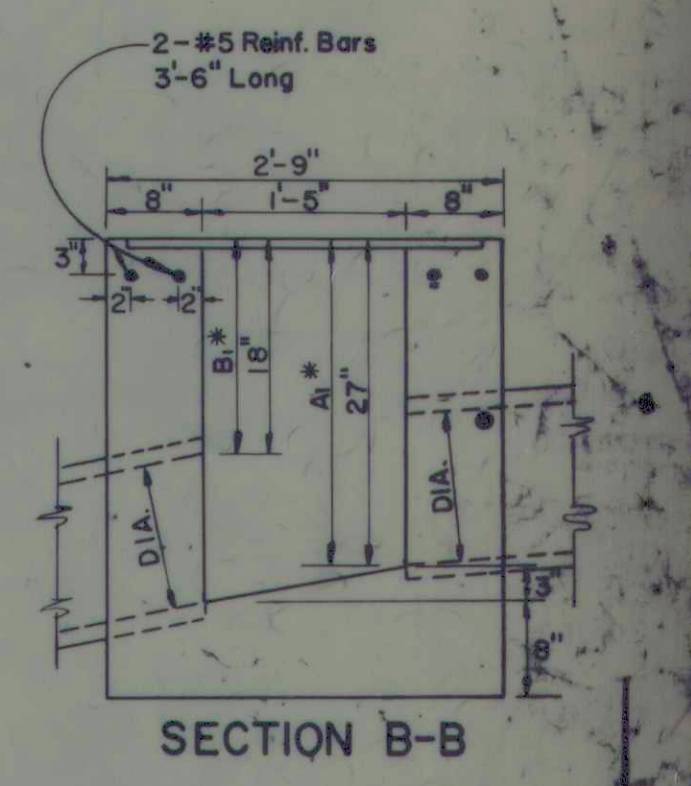

SECTION B-B

NOTE:
THE CONTRACTOR MAY BE PERMITTED TO PRECAST INLETS SUBJECT TO THE APPROVAL OF THE ENGINEER AND IN ACCORDANCE WITH THE STANDARD SPECIFICATIONS.

INLETS
SCALE:- 3/4" = 1'-0"

MISCELLANEOUS
STANDARDS
STATE OF INDIANA
DEC. 1964

RECOMMENDED FOR APPROVAL
ENGINEER OF PLANS & SPECIFICATIONS
APPROVED
CHIEF DIVISION OF DESIGN
APPROVED
CHIEF ENGINEER

REVISIONS
8-3-65 TYPE "R"
10-18-65 "TYPE" "R"
5-6-66 TYPE "R" & "J"
4-1-70 REMOVAL OF TYPE "C" & "F"
10-1-70 "TYPE" "R" & "J"
3-1-71 NOTE
11-2-74 1974 SPEC

SHEET
M
D