
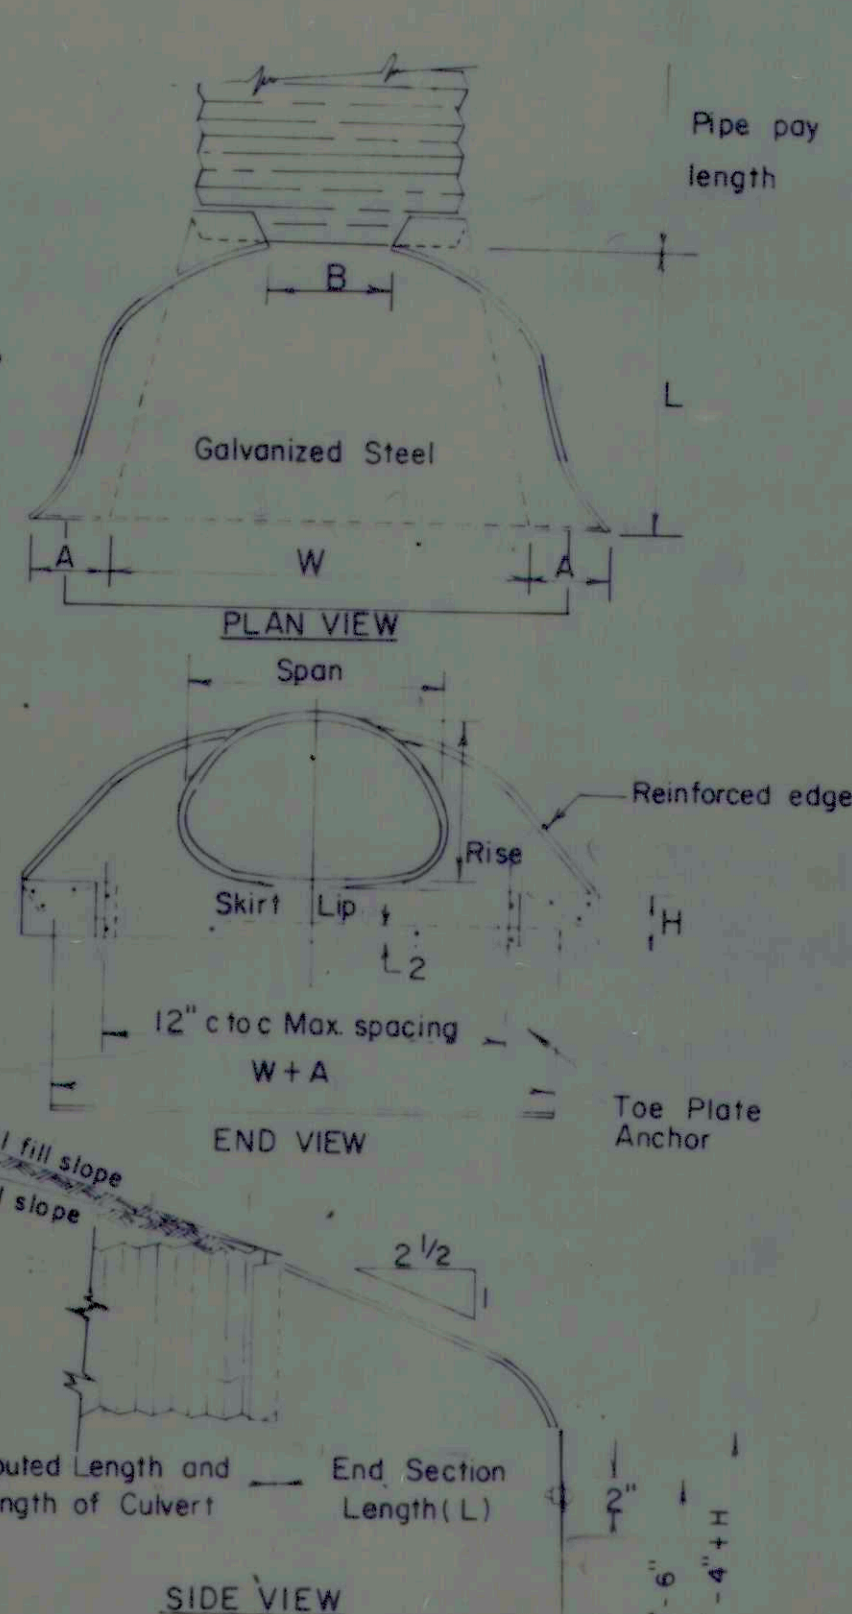
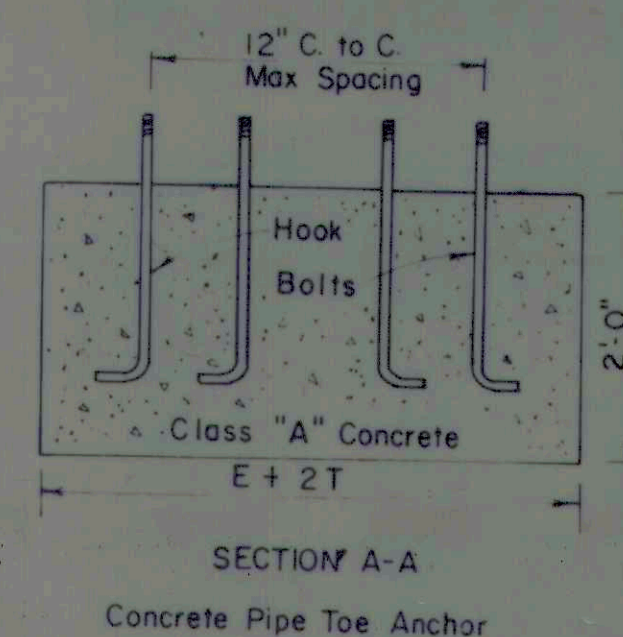




DIMENSIONS									
DIA	T(min)	A ±	C ±	D ±	E ±	K	R1	R2	APPROX WEIGHT
12"	2"	5'-3"	6'-2"	2'-0"	1.3	10 1/8"	9"	800	
15"	2 1/4"	7'-4"	6'-3"	2'-6"	1.5	12 1/2"	11"	1100	
18"	2 1/2"	11'-4"	6'-2"	3'-0"	1.8	15 1/2"	12"	1300	
21"	2 3/4"	11'-3"	6'-3"	3'-6"	2.1	16 1/8"	13"	1500	
24"	3"	1'-0"	2'-8"	6'-3"	2.3	16 3/8"	14"	1800	
27"	3 1/4"	1'-5"	2'-5"	6'-3"	2.6	18 3/8"	14 1/2"	2100	
30"	3 1/2"	1'-2"	1'-10"	6'-3"	2.9	18 1/2"	15"	2400	
33"	3 3/4"	1'-3"	3'-6"	8'-3"	3.1	23 3/8"	17 1/2"	4100	
36"	4"	1'-5"	3'-11"	8'-3"	3.4	24 7/8"	20"	4200	

± Tolerance ± 1"

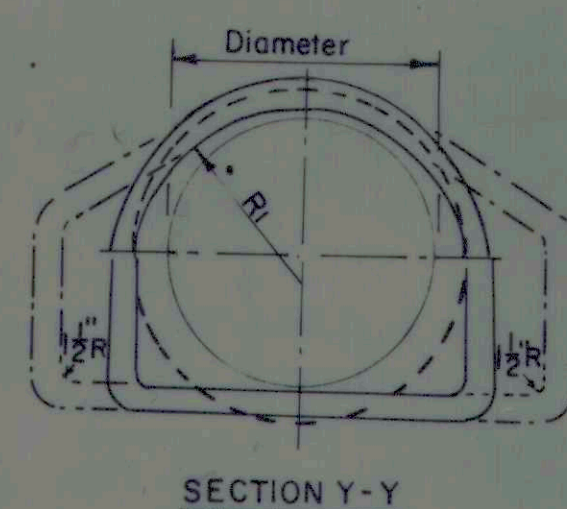

PIPE ARCH DIMENSIONS			T	DIMENSIONS						SLOPE approx.	BOOTS
SPAN	RISE	in.		A (1)	B (Max)	H (1)	L (1/2)	W (2)			
18	11	0.64	7	9	6	19	30	2/2	1Pc.		
22	13	0.64	7	10	6	23	36	2/2	1Pc.		
25	16	0.64	8	12	6	28	42	2/2	1Pc.		
29	18	0.64	9	14	6	32	48	2/2	1Pc.		
36	22	0.79	10	16	6	39	60	2/2	1Pc.		
43	27	0.79	12	18	8	46	75	2/2	1Pc.		

PIPE DIA.	T in.	DIMENSIONS					SLOPE approx	BO
		A (1")	B (Max) (1")	H (1")	L (1/2")	W (2")		
12	.064	6	6	6	21	24	2/2	1P
15	.064	7	8	6	26	30	2/2	1P
18	.064	8	10	6	31	36	2/2	1P
21	.064	9	12	6	36	42	2/2	1P
24	.064	10	13	6	41	48	2/2	1P
30	.079	12	16	8	51	60	2/2	1P
36	.079	14	19	9	60	72	2/2	2P

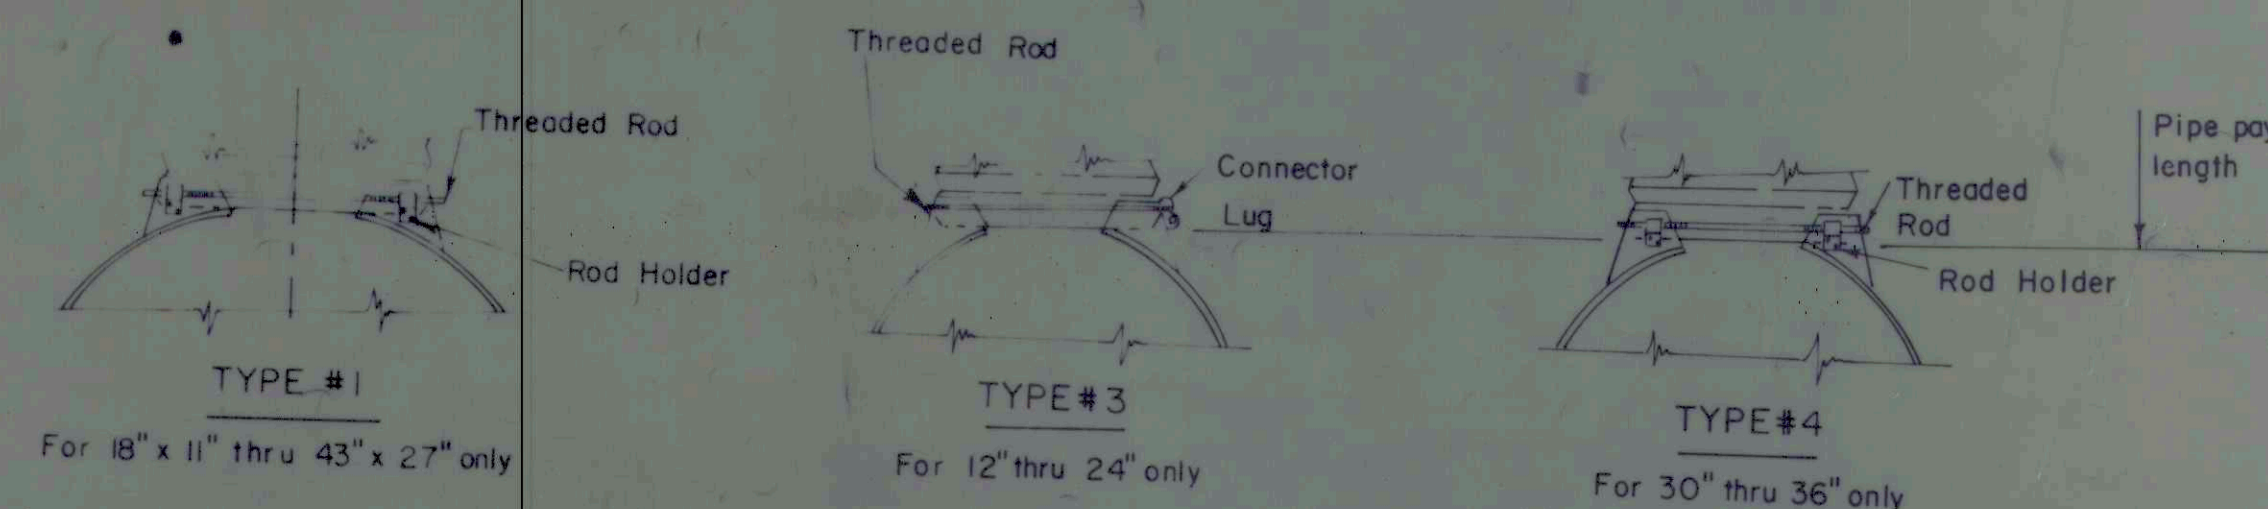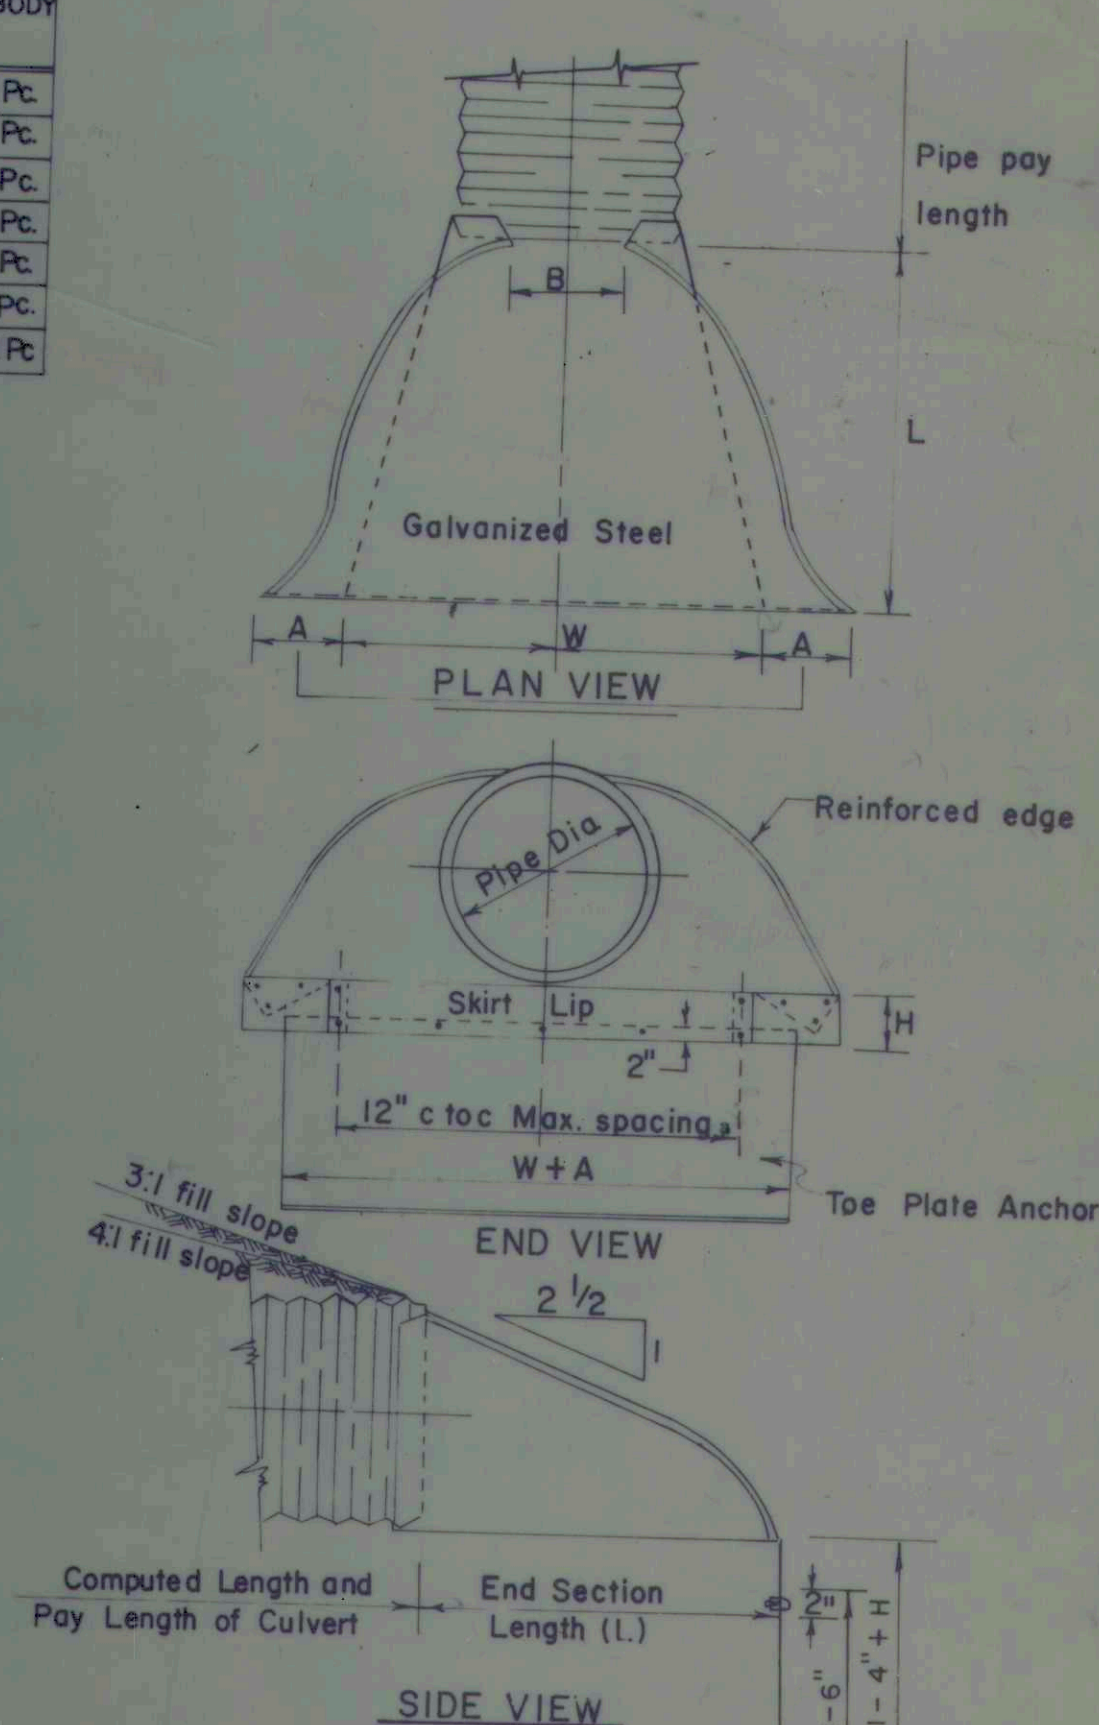


PRECAST CONCRETE END SECTION

NOTE: Metal Pipe End Sections may be used with Concrete Pipe providing the method of connection is approved by the engineer prior to installation of pipe.

1. Concrete in these end sections shall be the same grade and strength as specified for reinforced concrete pipe, A.S.T.M. designation C76 CLASS II (As set out in the Standard Specifications
2. Reinforcement in the "C" Portion shall be the same as specified for reinforced concrete, A.S.T.M. designation C76, CLASS II for the size of connecting pipe.
3. Reinforcement in the "B" Portion shall have a cross-sectional area equal to that of one layer of steel in the "C" Portion.
4. The end of the pipe culvert shall be placed in the concrete end section so that the flow lines are flush. The joint shall be completely filled with mortar.
5. In 3:1 or 4:1 fill slope, change to the slope of the end section in a smooth, pleasing transition approximately 10'-0" in length.
6. Variations in Dimensions - The thickness of the concrete, the position of steel, and the internal diameter of the pipe shall conform with the variations in dimensions as provided in the Specifications for Reinforced Concrete Culvert, Storm Drain, and Sewer Pipe, A.S.T.M. Designation C-76.
7. Where Vitrified Clay Culvert or Cast Iron Culvert pipe is used, a "Pipe End Section" comparable to that as shown for Metal or Concrete shall be furnished and shall be as approved by the Engineer.
8. End sections will be paid for at the contract unit price each for "Pipe End Section" complete in place and accepted.
9. Concrete pipe toe anchors shall be required on all concrete pipe sections. The cost thereof shall be included in the contract unit price per each for "Pipe End Sections".
10. For type of Pipe End Section permitted in Acid or Mine water areas see "Instruction to Bidders" of the contract proposal.

Hook Bolt material shall meet the current ASTM A-307. Threads shall be American Standard Coarse Thread Series, Class 2, Free Fit Bolts shall be galvanized to meet current ASTM specification A-157. The threaded portion shall not prevent turning the nut by hand.

Nut and washers shall be carbon steel hot dip galvanized to meet ASTM specification A-153. Nut threads shall be American standard Coarse Thread Series (1/64" maximum oversize), cleaned after galvanizing to provide a free running fit on the Class 2 bolt. Nuts shall be 1 1/4" across flats, 13/16" thick, curve crowned to approximately 1" radius.

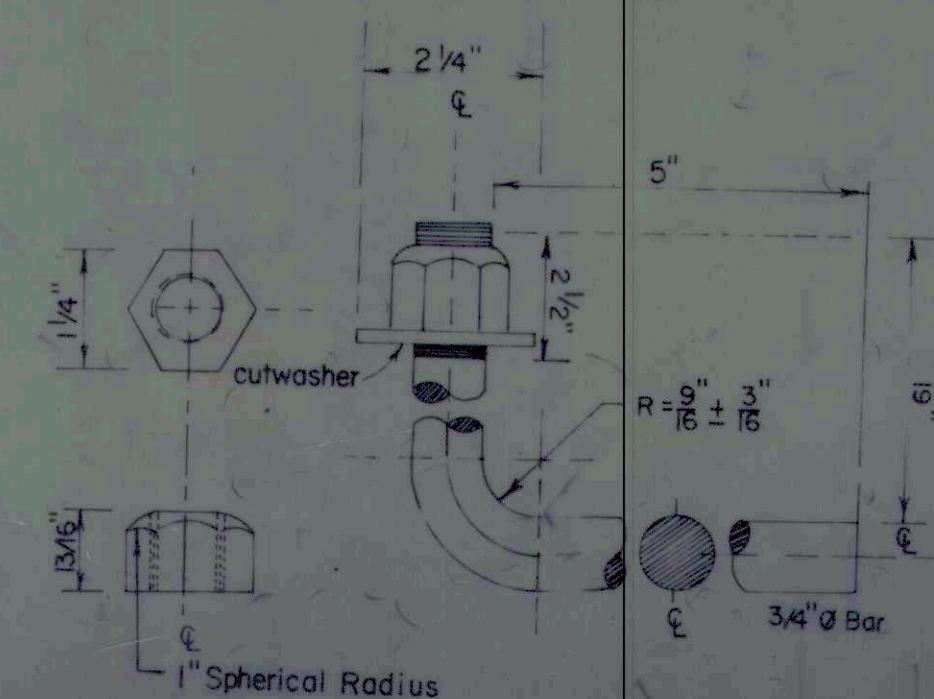

MISCELLANEOUS
STANDARDS
STATE OF INDIANA
JULY 1972

REVISIONS	
10-2-72	METAL NOTE 8
1-2-74	1974 Spec's

M E₂

RECORD DRAWING

Sheet 87

14A