



FALL CREEK REGIONAL WASTE DISTRICT WASTEWATER FACILITIES

DIVISION 'A' - INGALLS COLLECTION SYSTEM
DIVISION 'B' - PENDLETON SEWER IMPROVEMENTS
AND REFORMATORY LIFT STATION

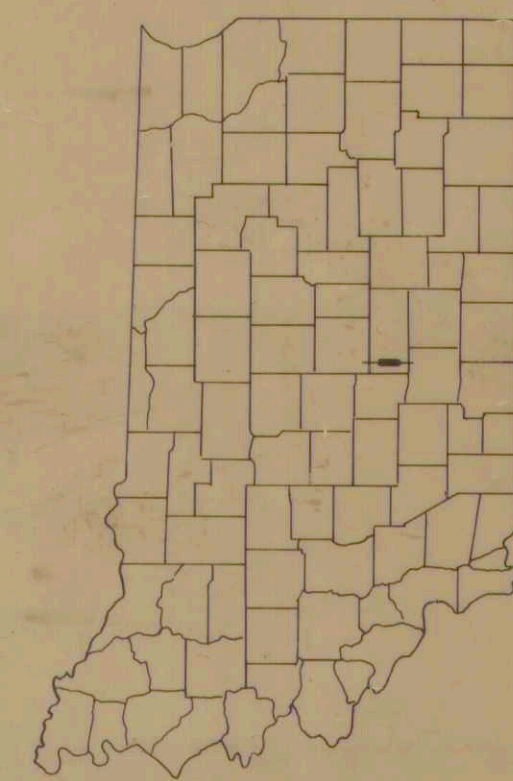

LOCATION OF SECTION INDICATED

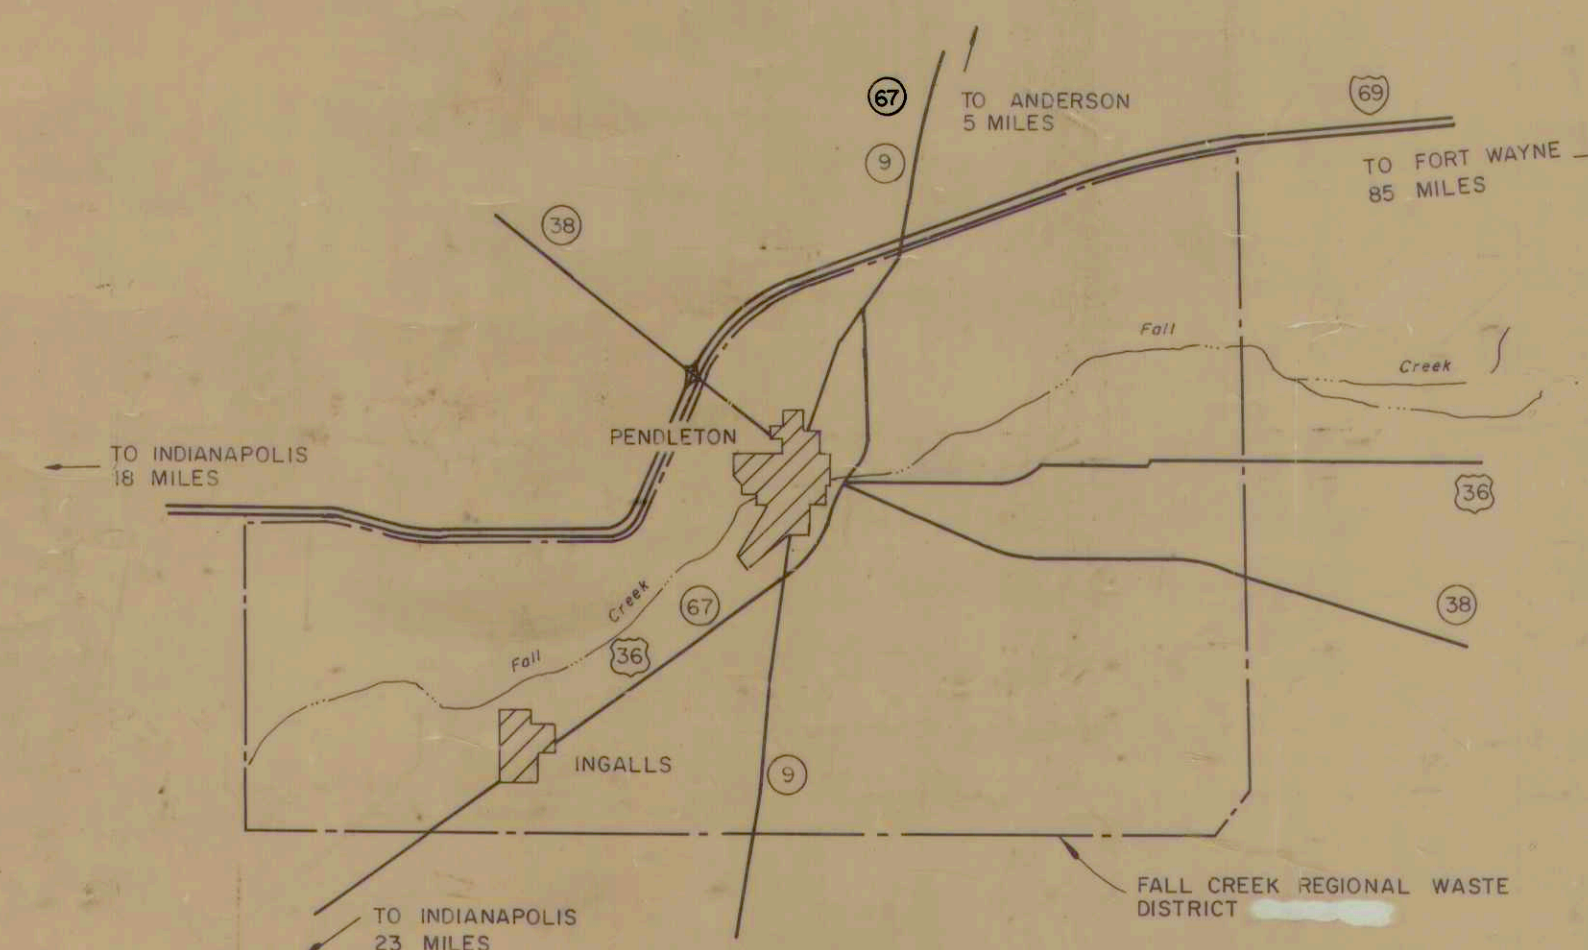

PLANS PREPARED BY:

BEAM, LONGEST & NEFF, INC.

CONSULTING ENGINEERS
INDIANAPOLIS, INDIANA



Eric Reske March 30, 1983
CERTIFIED DATE

APPROVED BY: *William Clark* WILLIAM CLARK - PRESIDENT

Marvin Kelly MARVIN KELLY - VICE PRESIDENT

Morris McCurdy MORRIS MCCURDY - TREASURER

Robert Post ROBERT POST - SECRETARY

Hugh Begley HUGH BEGLEY - MEMBER

Robert Buss ROBERT BUSS - MEMBER

John Ellingwood JOHN ELLINGWOOD - MEMBER

Charles Hennis CHARLES HENNIS - MEMBER

Paul Stoner PAUL STONER - MEMBER

7-20-83
DATE

RECORD DRAWING