


PLAN	SURVEYED	DATE
	ALIGNED	BY
	CHECKED	
	RT. OF WAY CHECKED	
NO.		

PROFILE	SURVEYED	DATE
	GRADES CHECKED	BY
	NOTED	
	STRUCTURE NOTATIONS	
NO.		



RECORD DRAWING

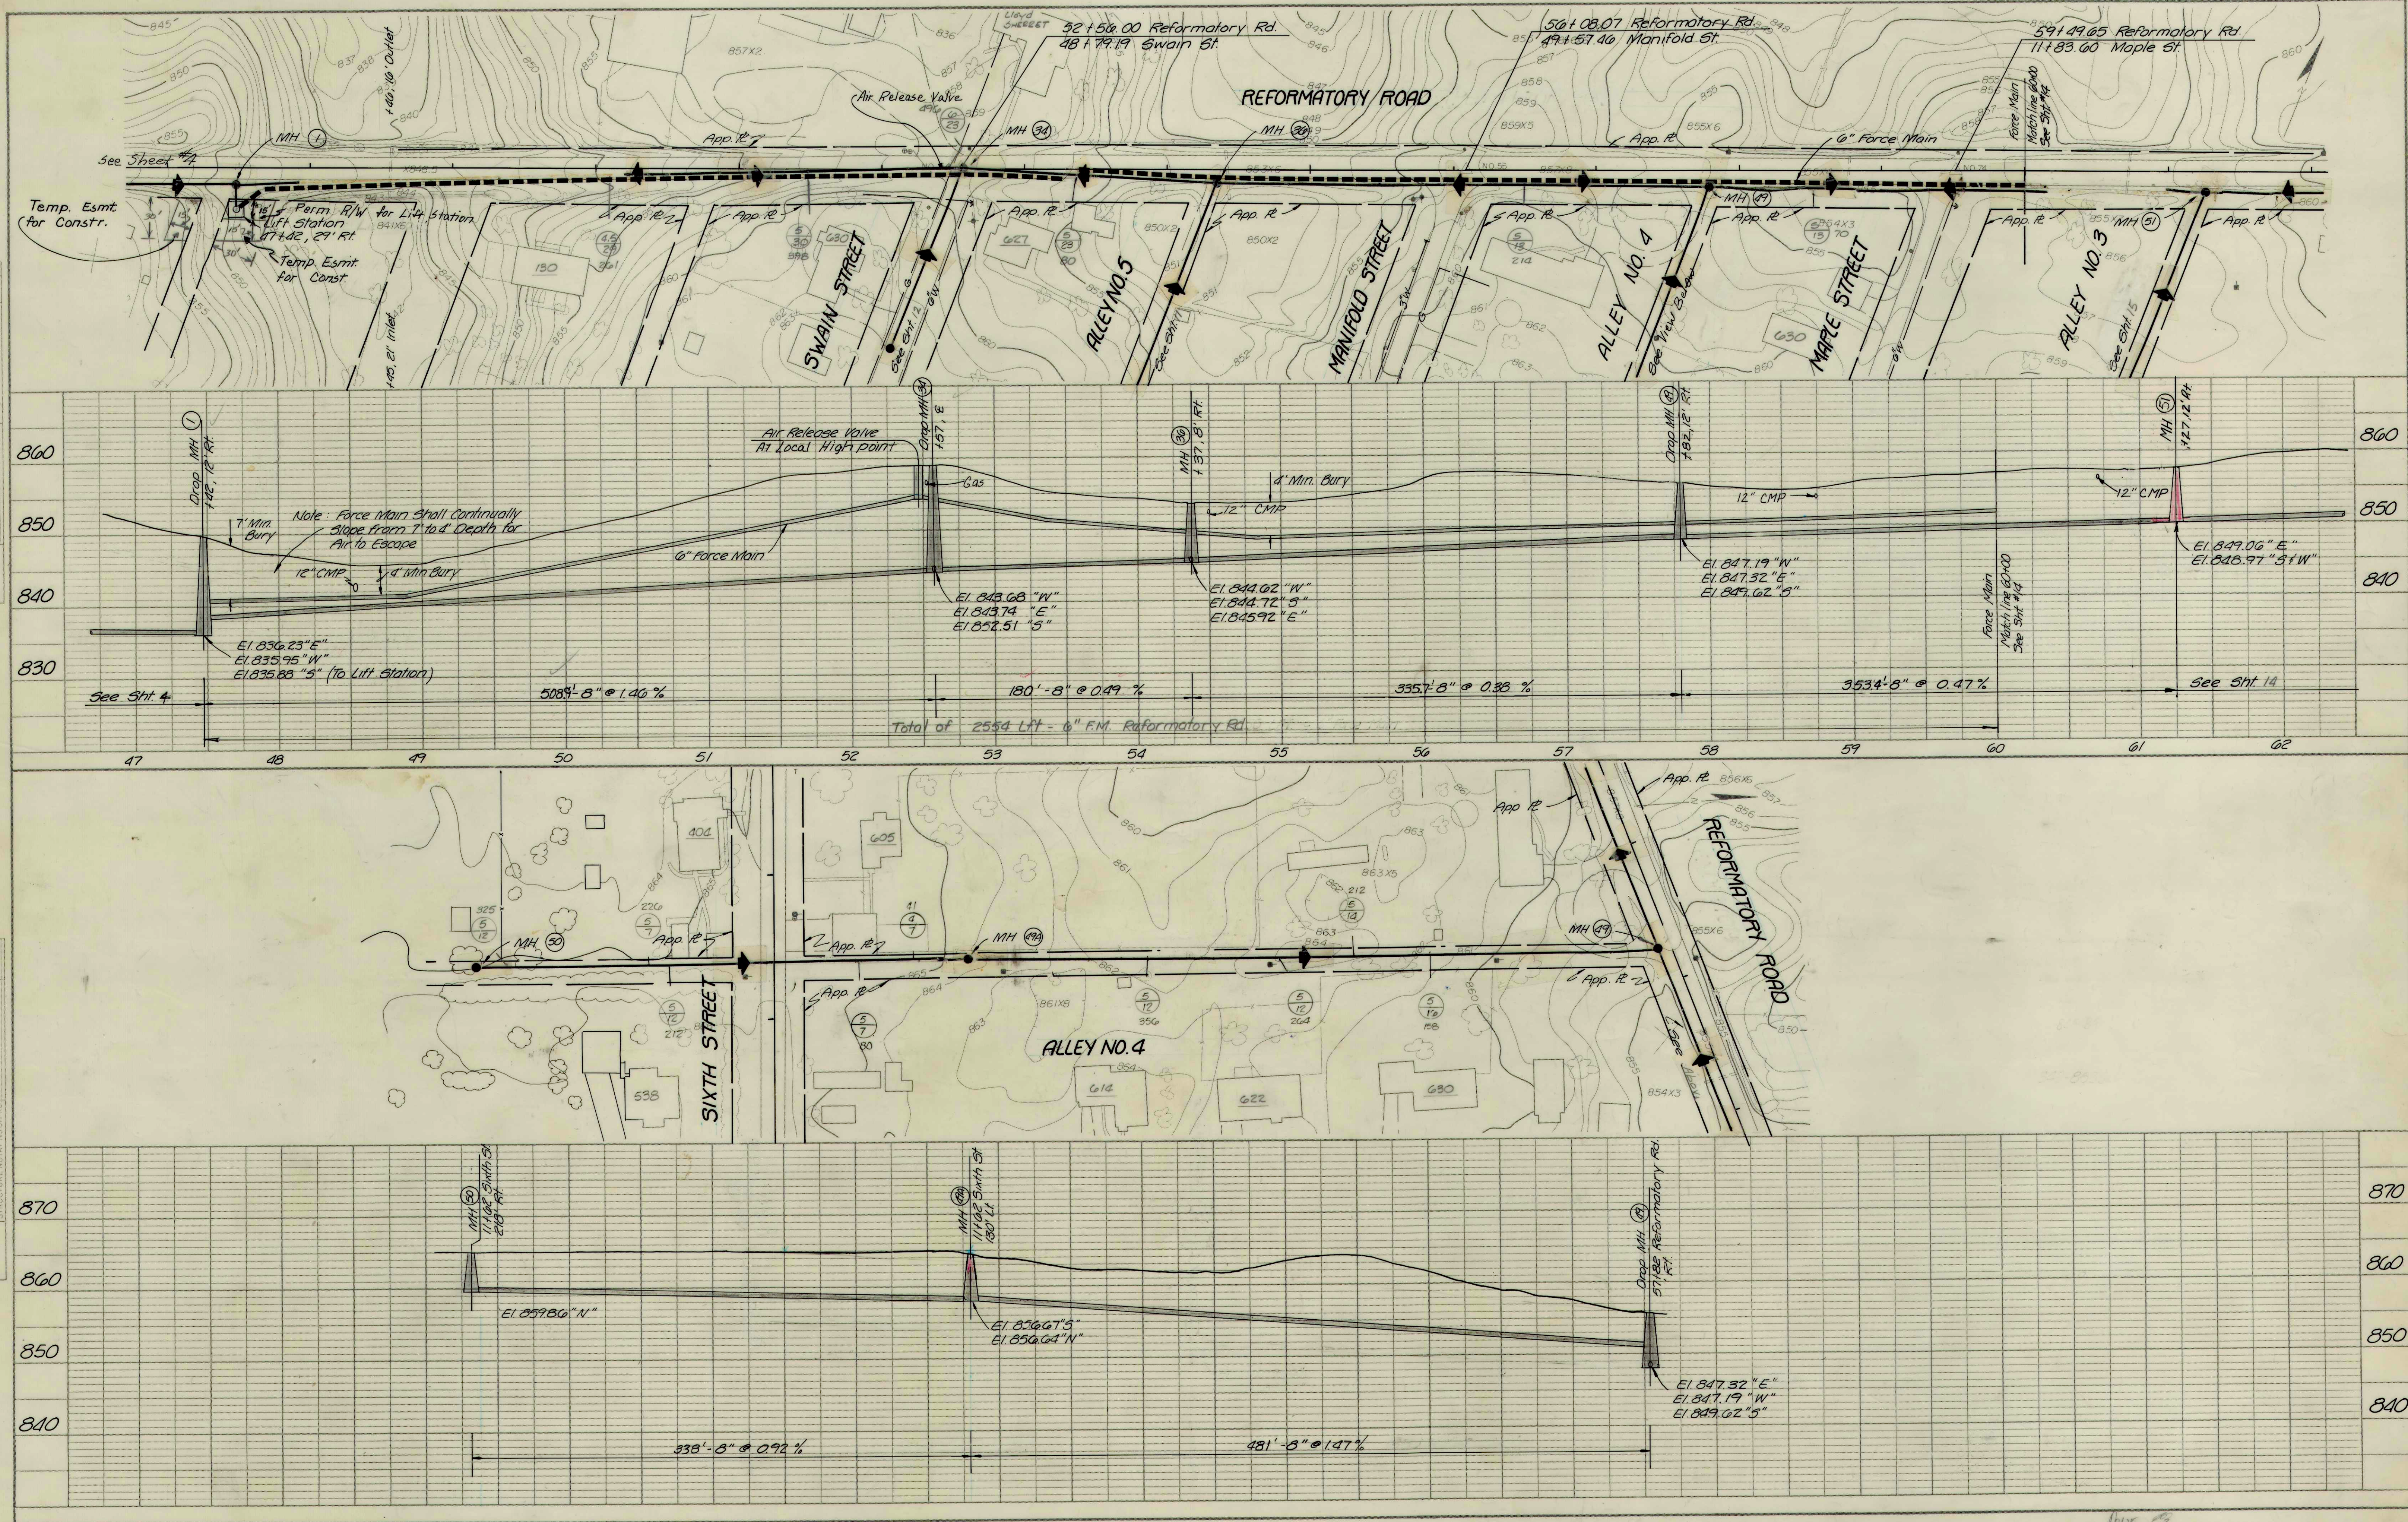

REFORMATORY RD.
ALLEY #4
FALL CREEK R.W.D. PLAN & PROFILE SHEET
HORIZ. 1"=50'
VERT. 1"=10'
BEAM, LONGEST & NEFF, INC.
CONSULTING ENGINEERS
INDIANAPOLIS, INDIANA
10