



PLAN	DATE	BY
	SURVEYED	
	PLOTTED	
	CHECKED	
NOTE BOOK		
NO. OF WAY CHECKED		

PROFILE	DATE	BY
	SURVEYED	
	PLOTTED	
	CHECKED	
NOTE BOOK		
NO. OF WAY CHECKED		

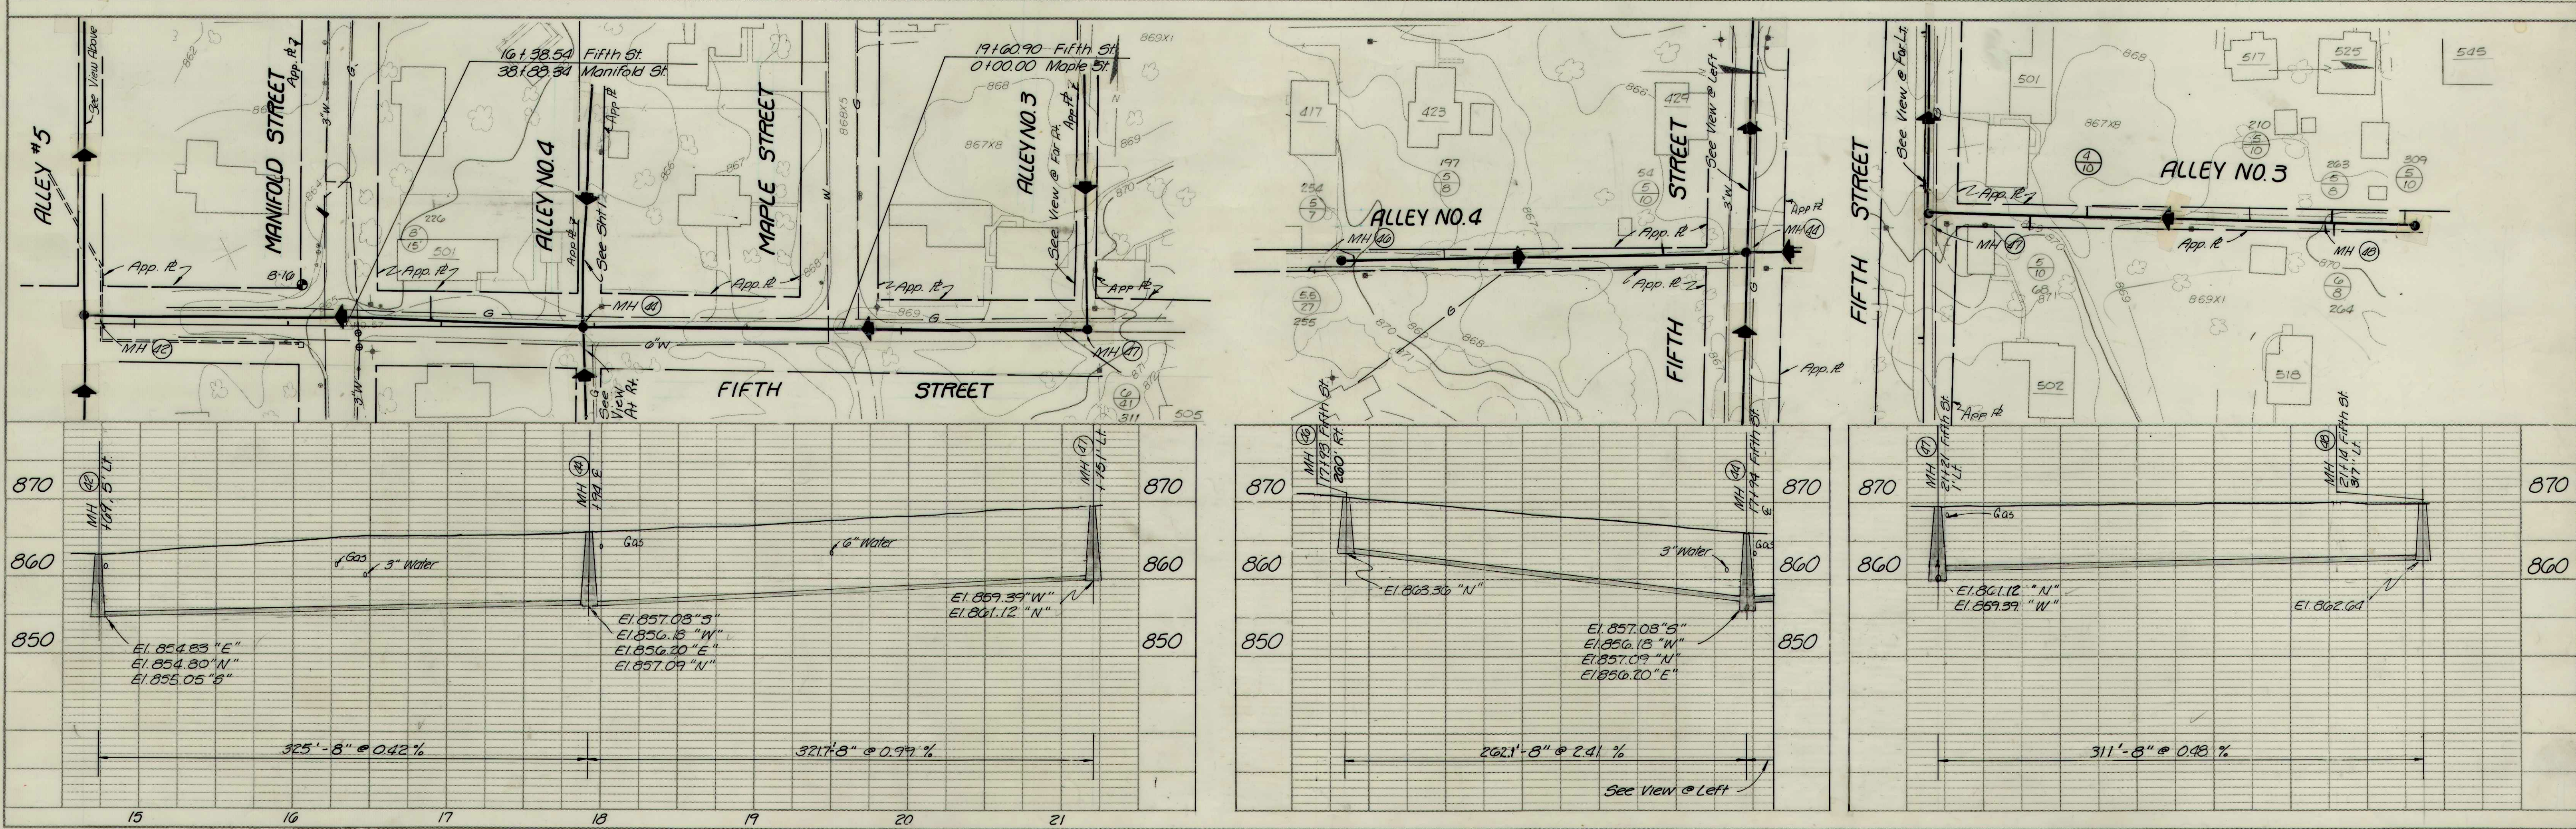

RECORD DRAWING

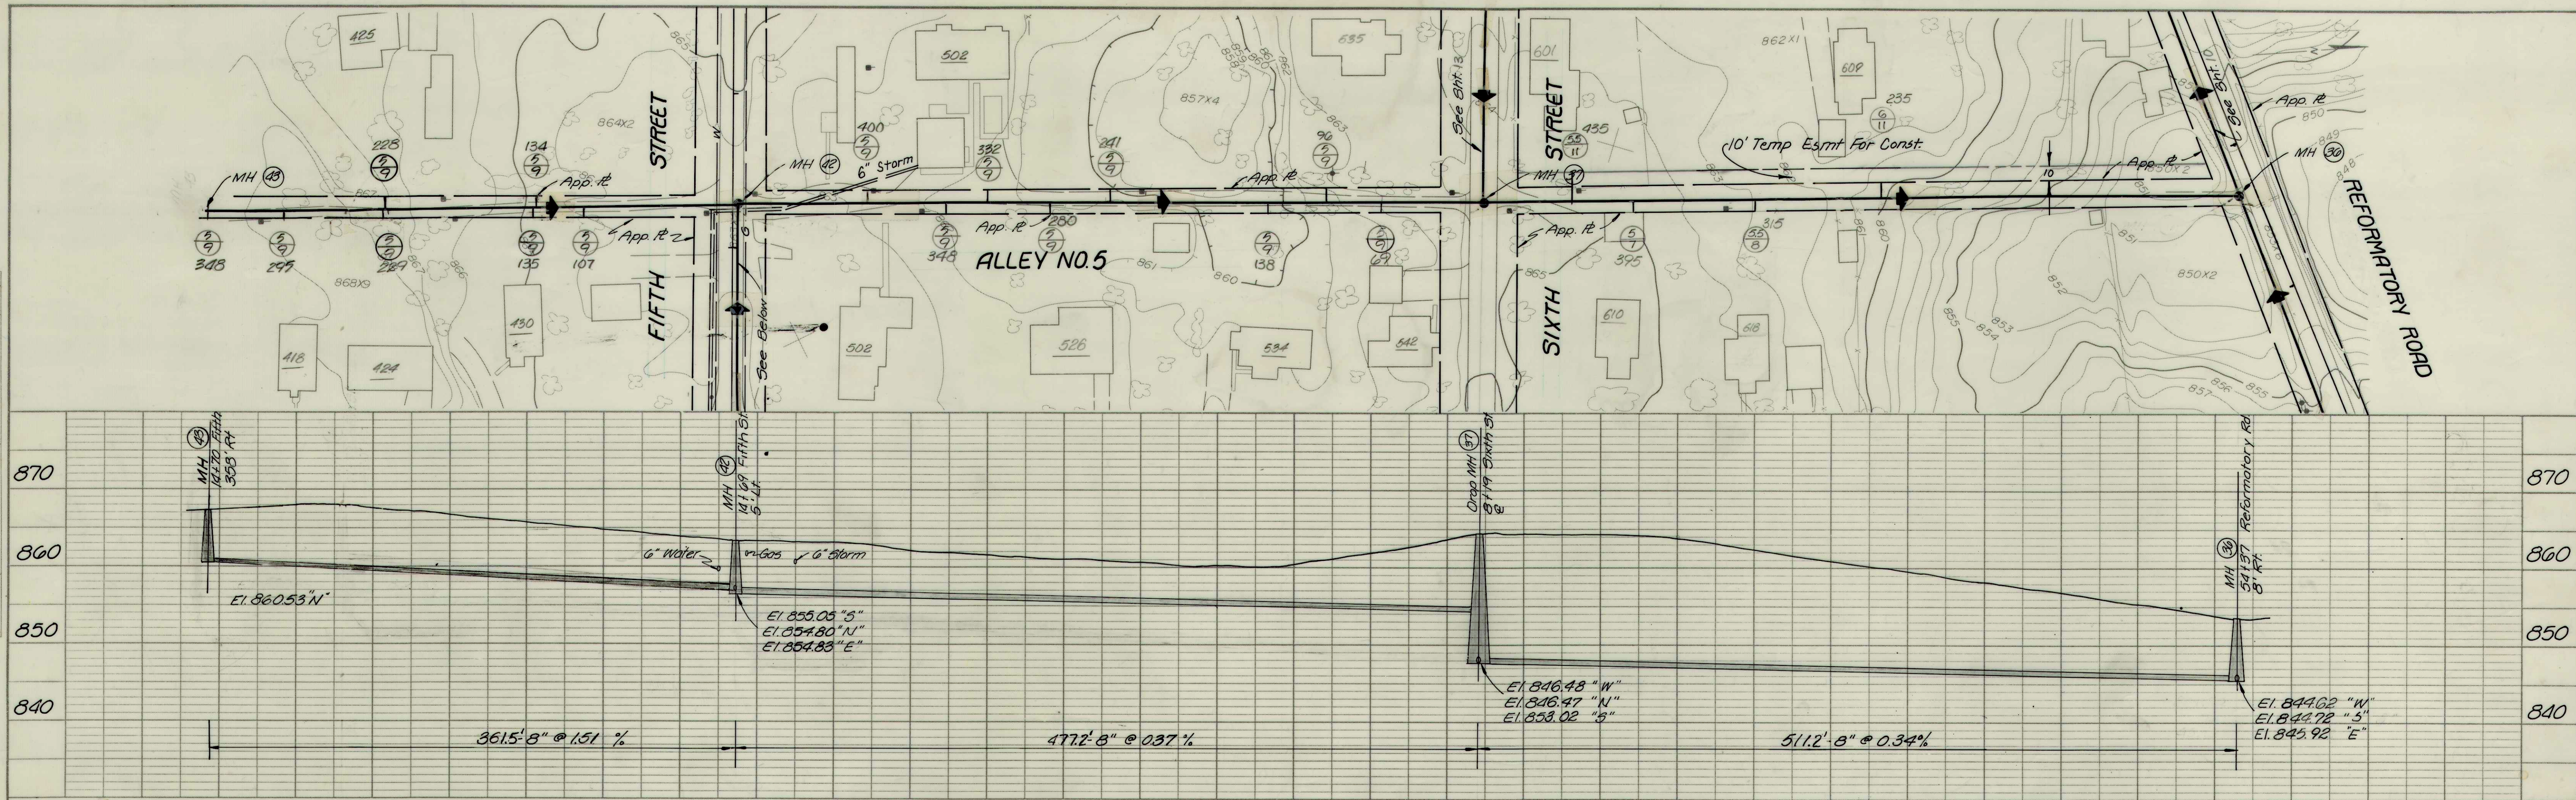

ALLEYS #3, #4, #5 FIFTH ST.	
FALL CREEK R.W.D. PLAN & PROFILE	
HORIZ. 1"=50'	BEAM, LONGEST & NEFF, INC.
VERT. 1"=10'	CONSULTING ENGINEERS
	INDIANAPOLIS, INDIANA
	11