

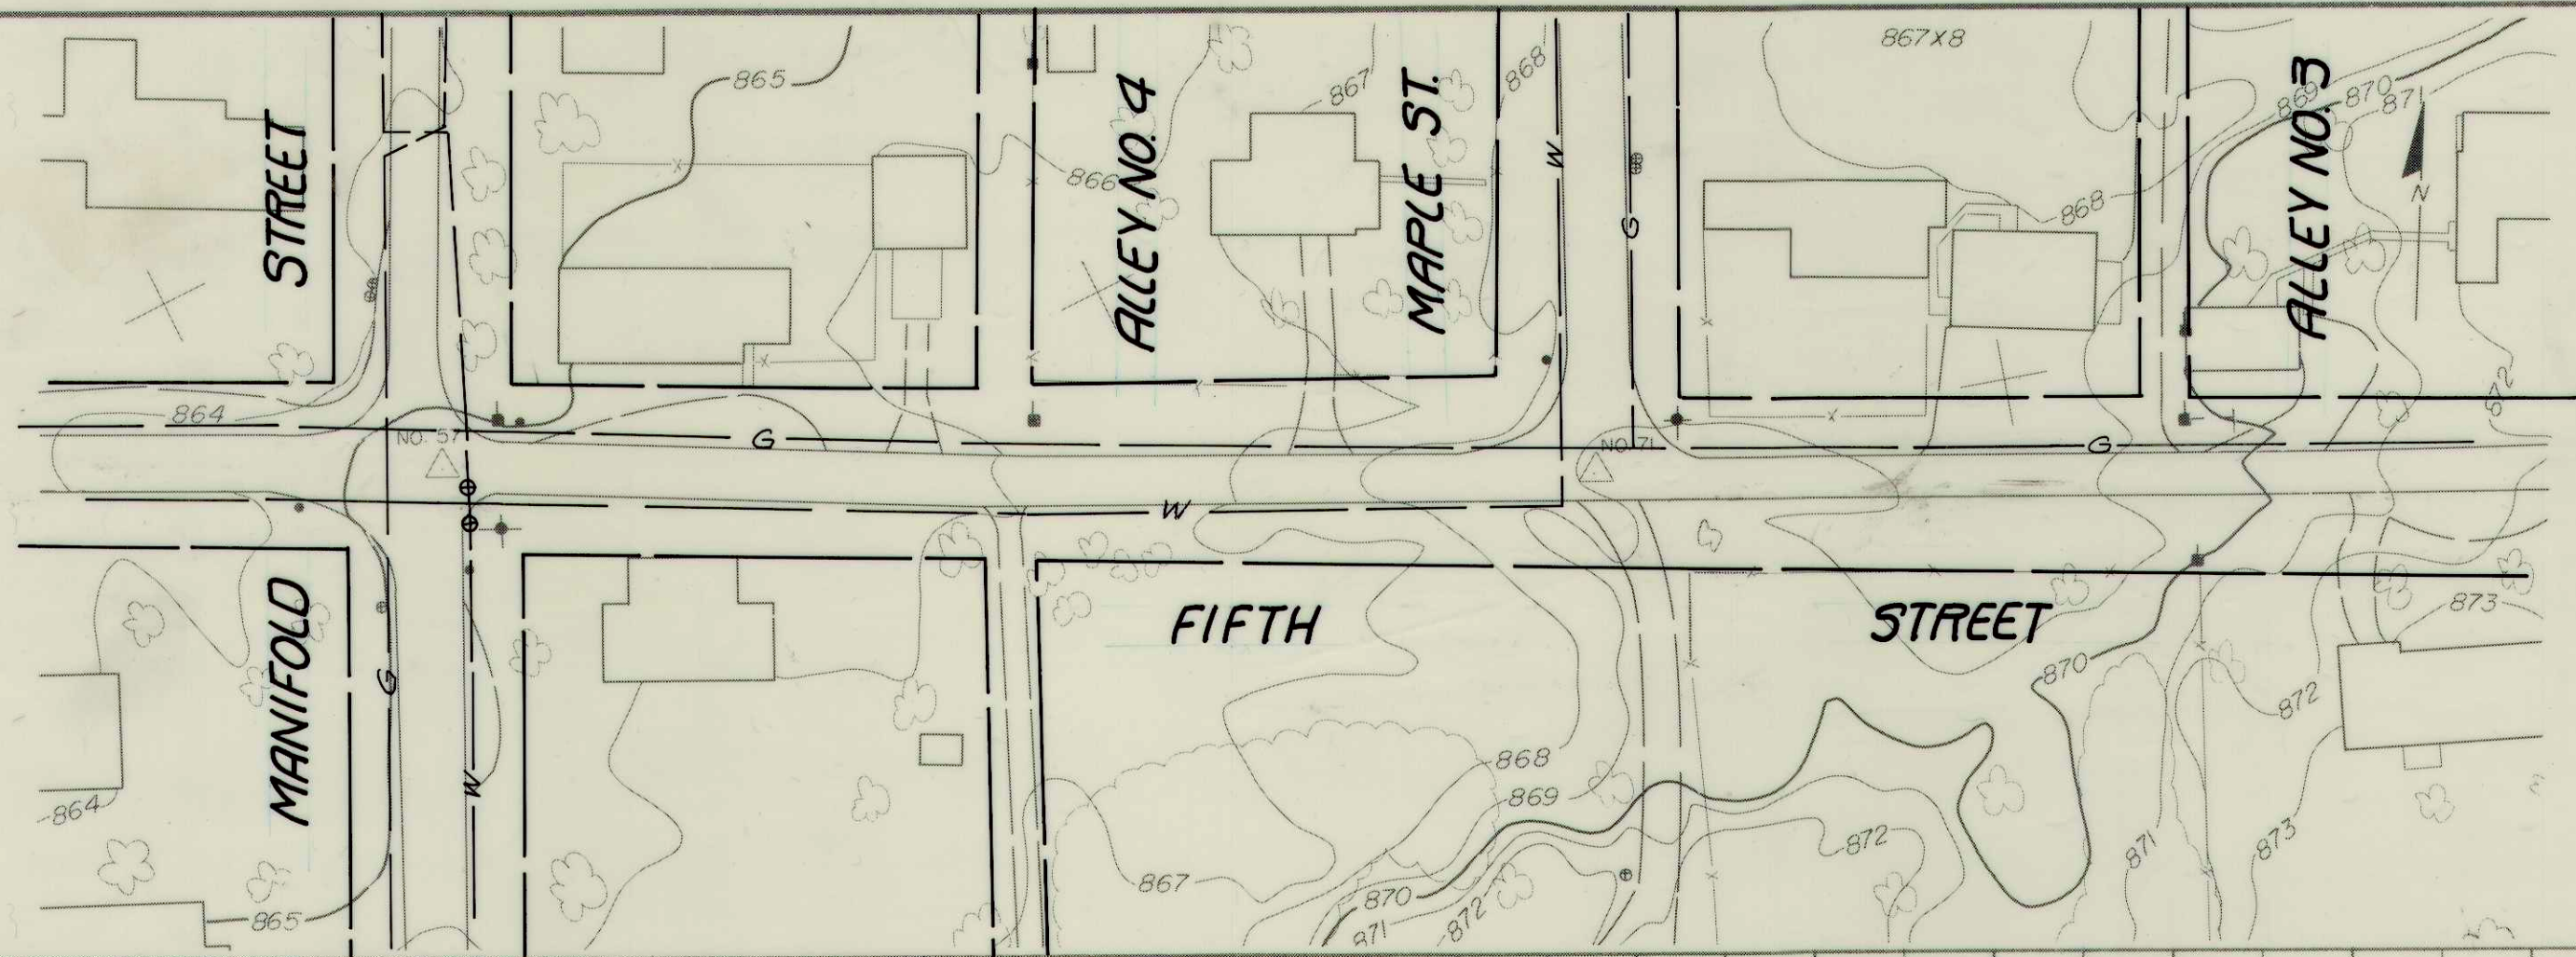
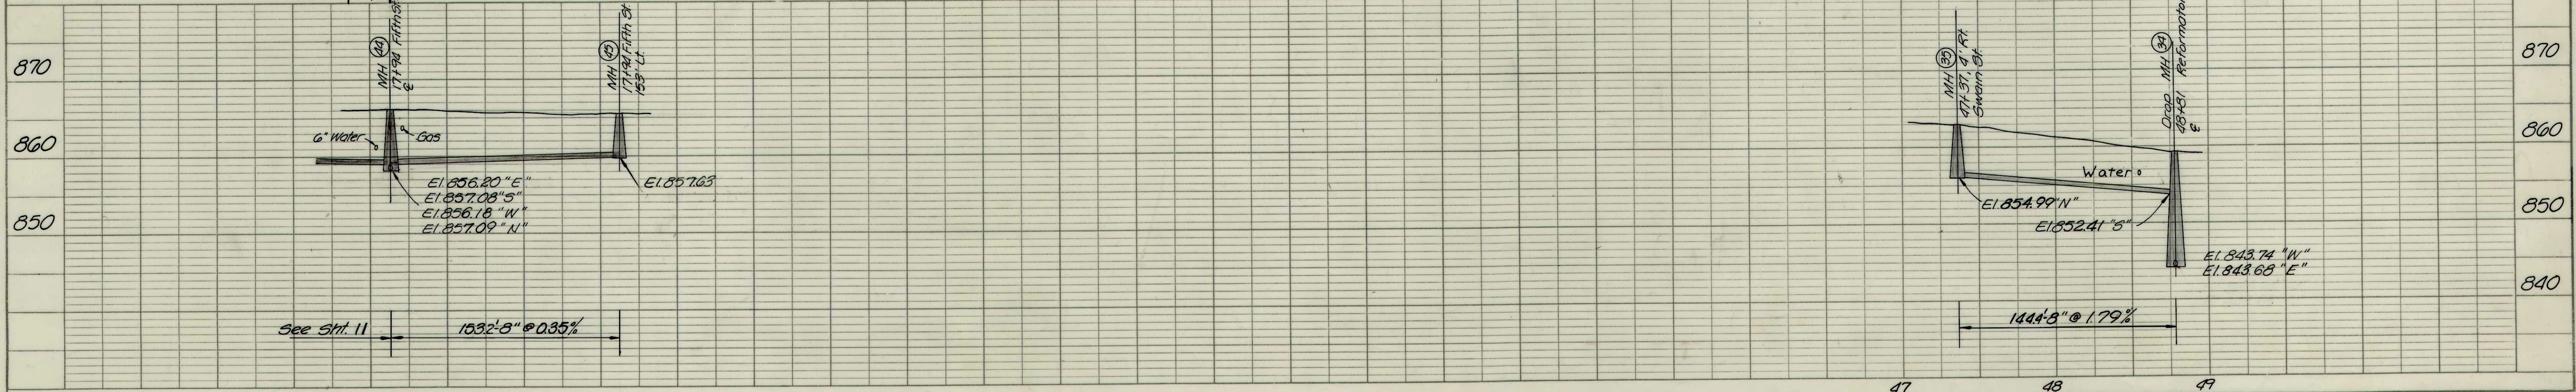


|      |                    |      |
|------|--------------------|------|
| PLAN | SURVEYED           | DATE |
|      | NOTE BOOK          | BY   |
|      | ALIGNMENT CHECKED  |      |
|      | RT. OF WAY CHECKED |      |

|         |                             |      |
|---------|-----------------------------|------|
| PROFILE | SURVEYED                    | DATE |
|         | NOTE BOOK                   | BY   |
|         | GRADES CHECKED              |      |
|         | STRUCTURE NOTATIONS CHECKED |      |

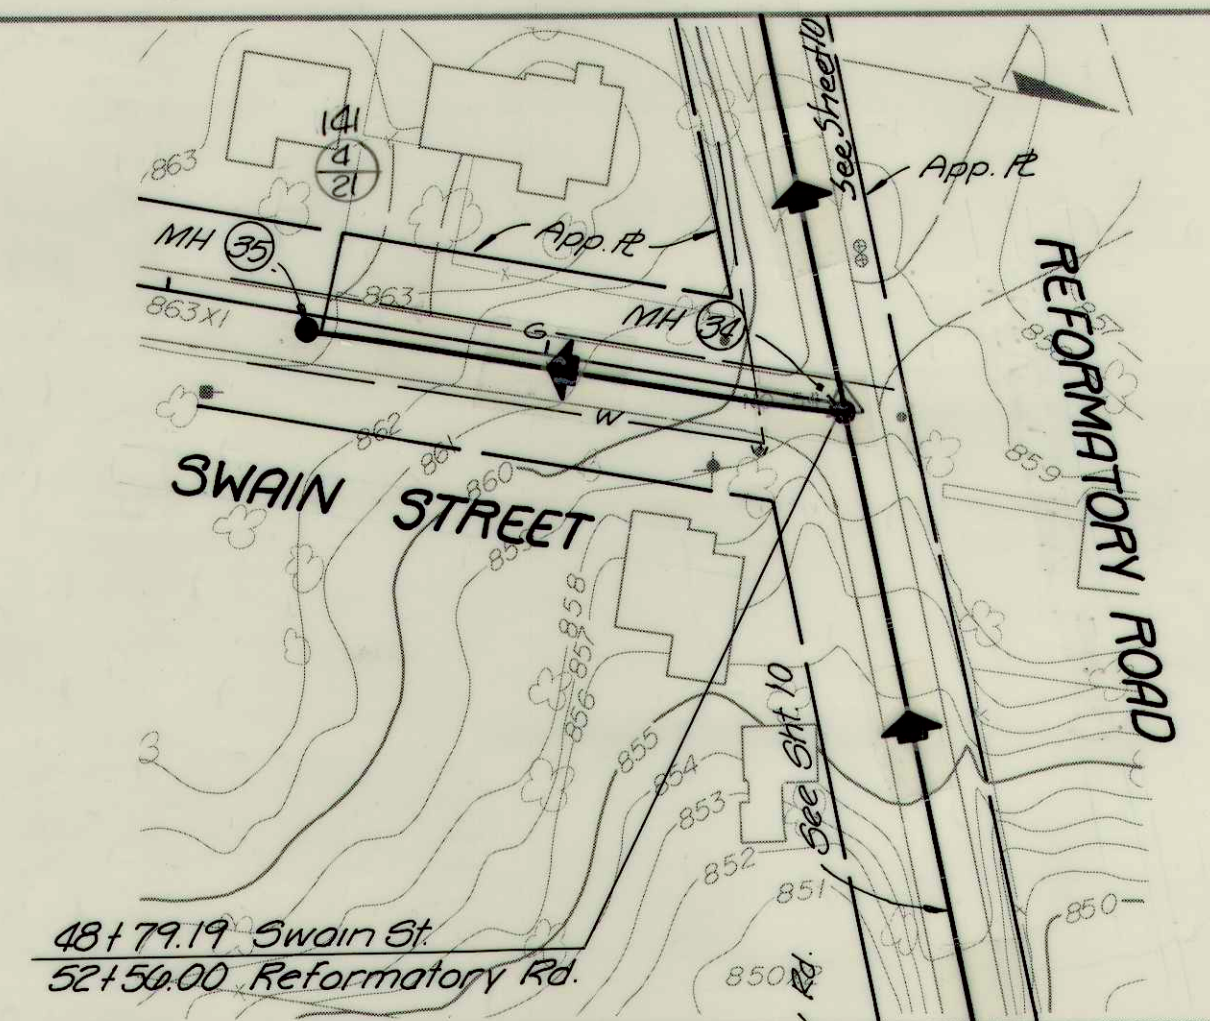

VOID

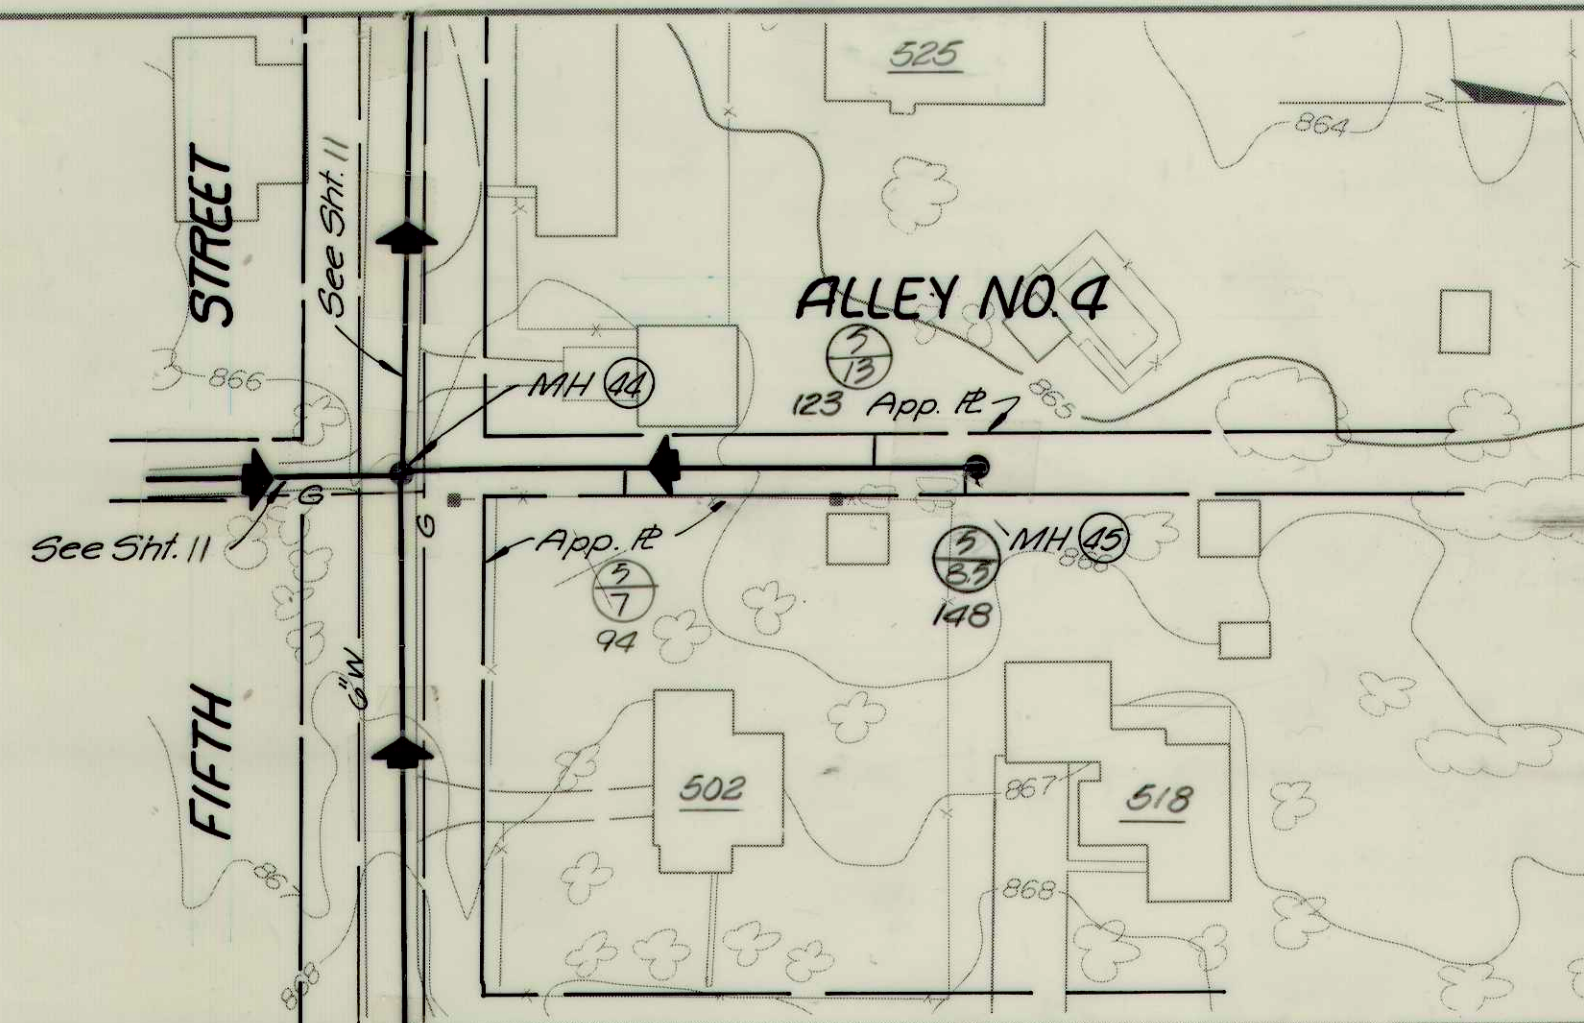

**RECORD DRAWING**



|                                        |                            |
|----------------------------------------|----------------------------|
| FIFTH ST. ALLEY #4 SWAIN ST.           |                            |
| FALL CREEK R.W.D. PLAN & PROFILE SHEET |                            |
| HORIZ. 1"=50'                          | BEAM, LONGEST & NEFF, INC. |
| VERT. 1"=10'                           | CONSULTING ENGINEERS       |
|                                        | INDIANAPOLIS, INDIANA      |

PHOTODUPLICATION BY ACCU-AR SURVEYS, INC., NEWBURGH, NEW YORK