

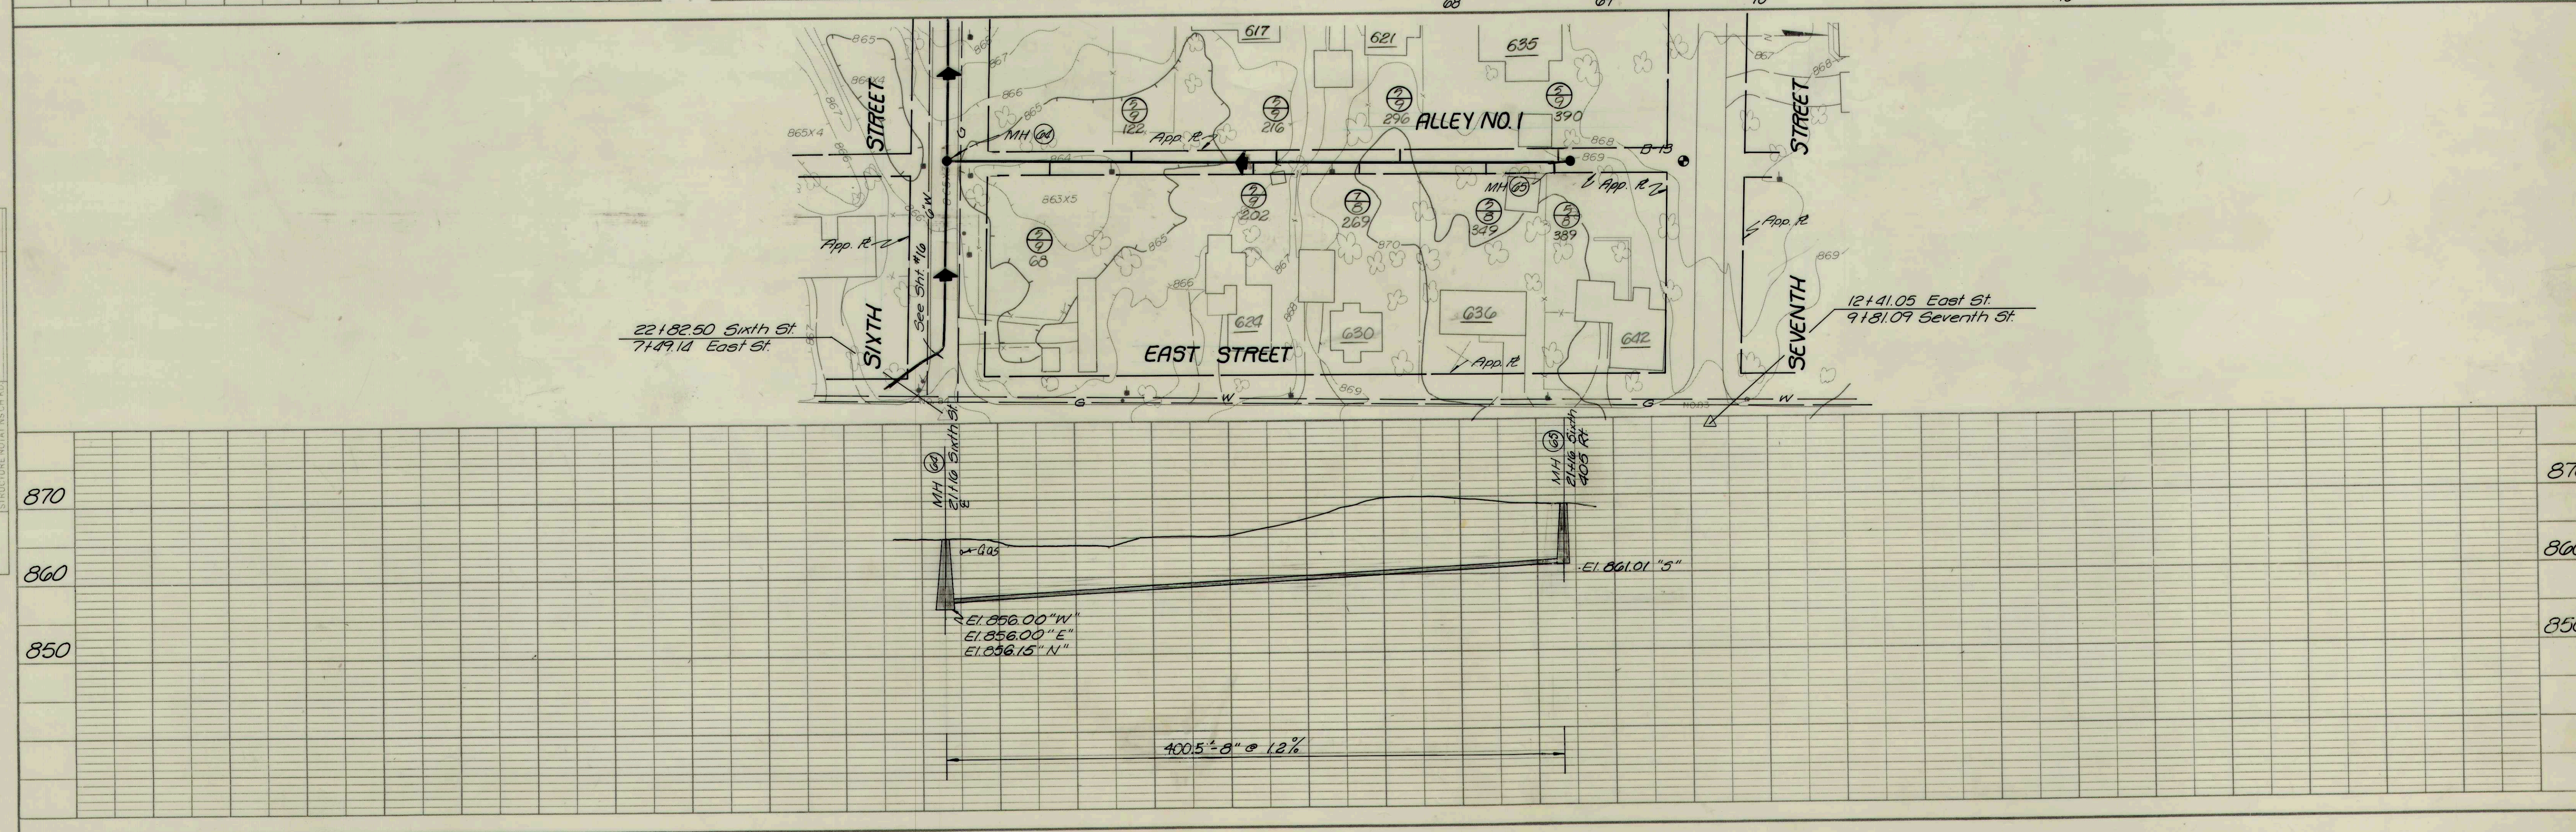
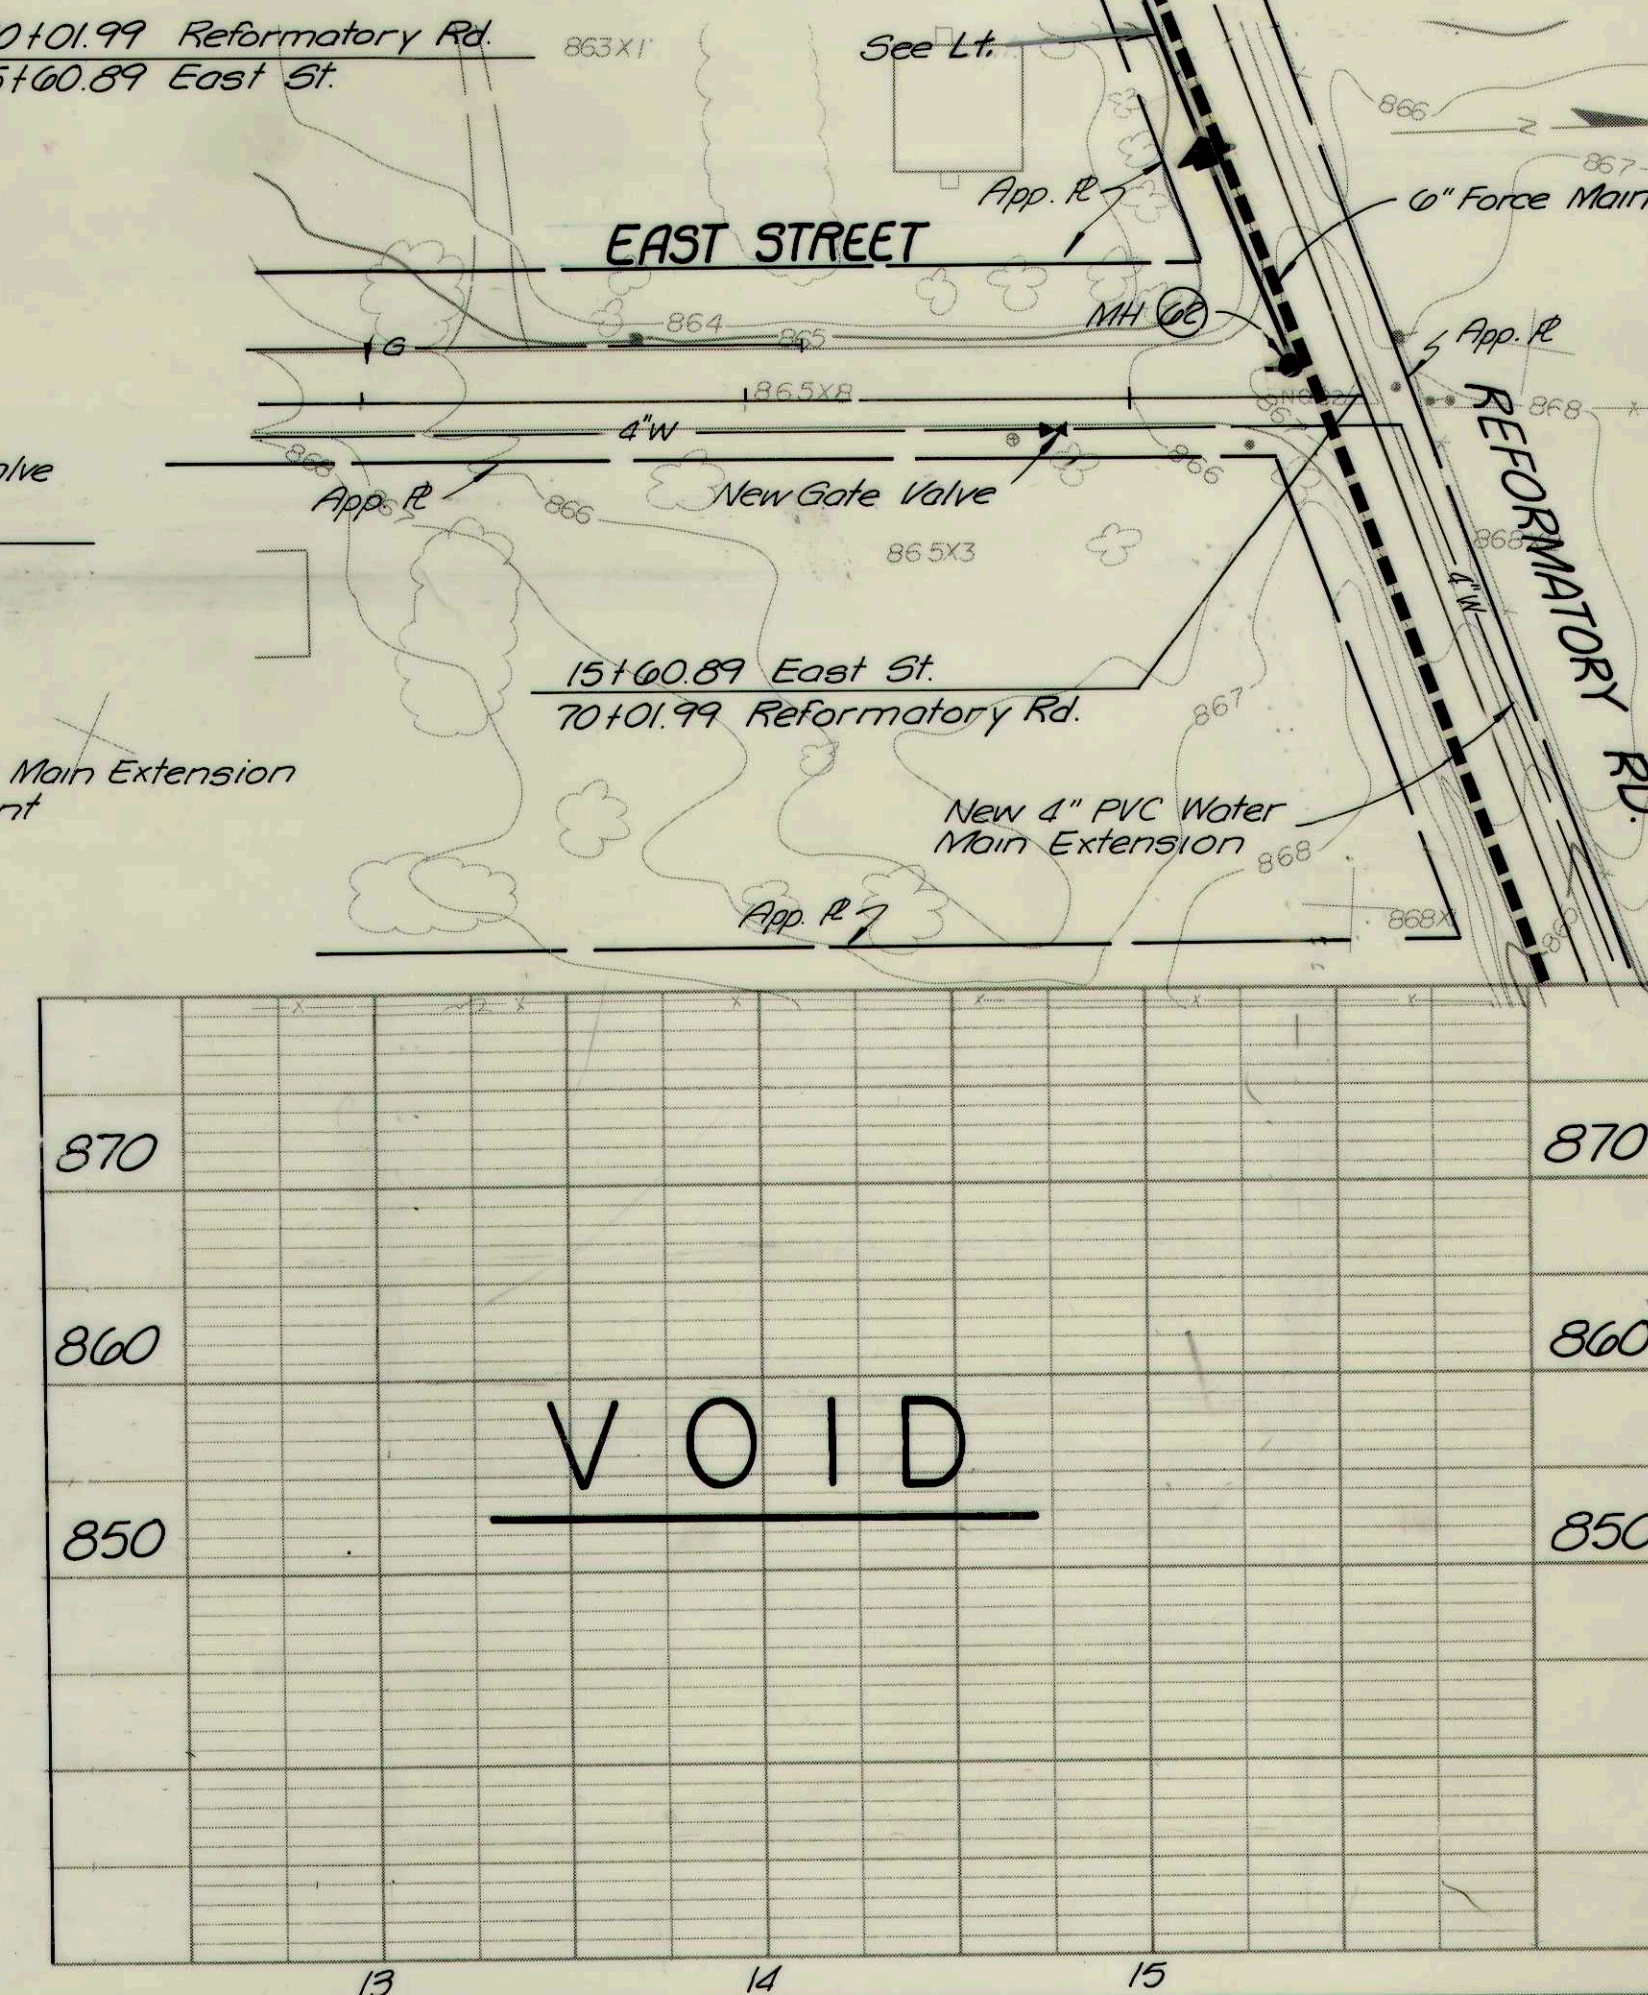
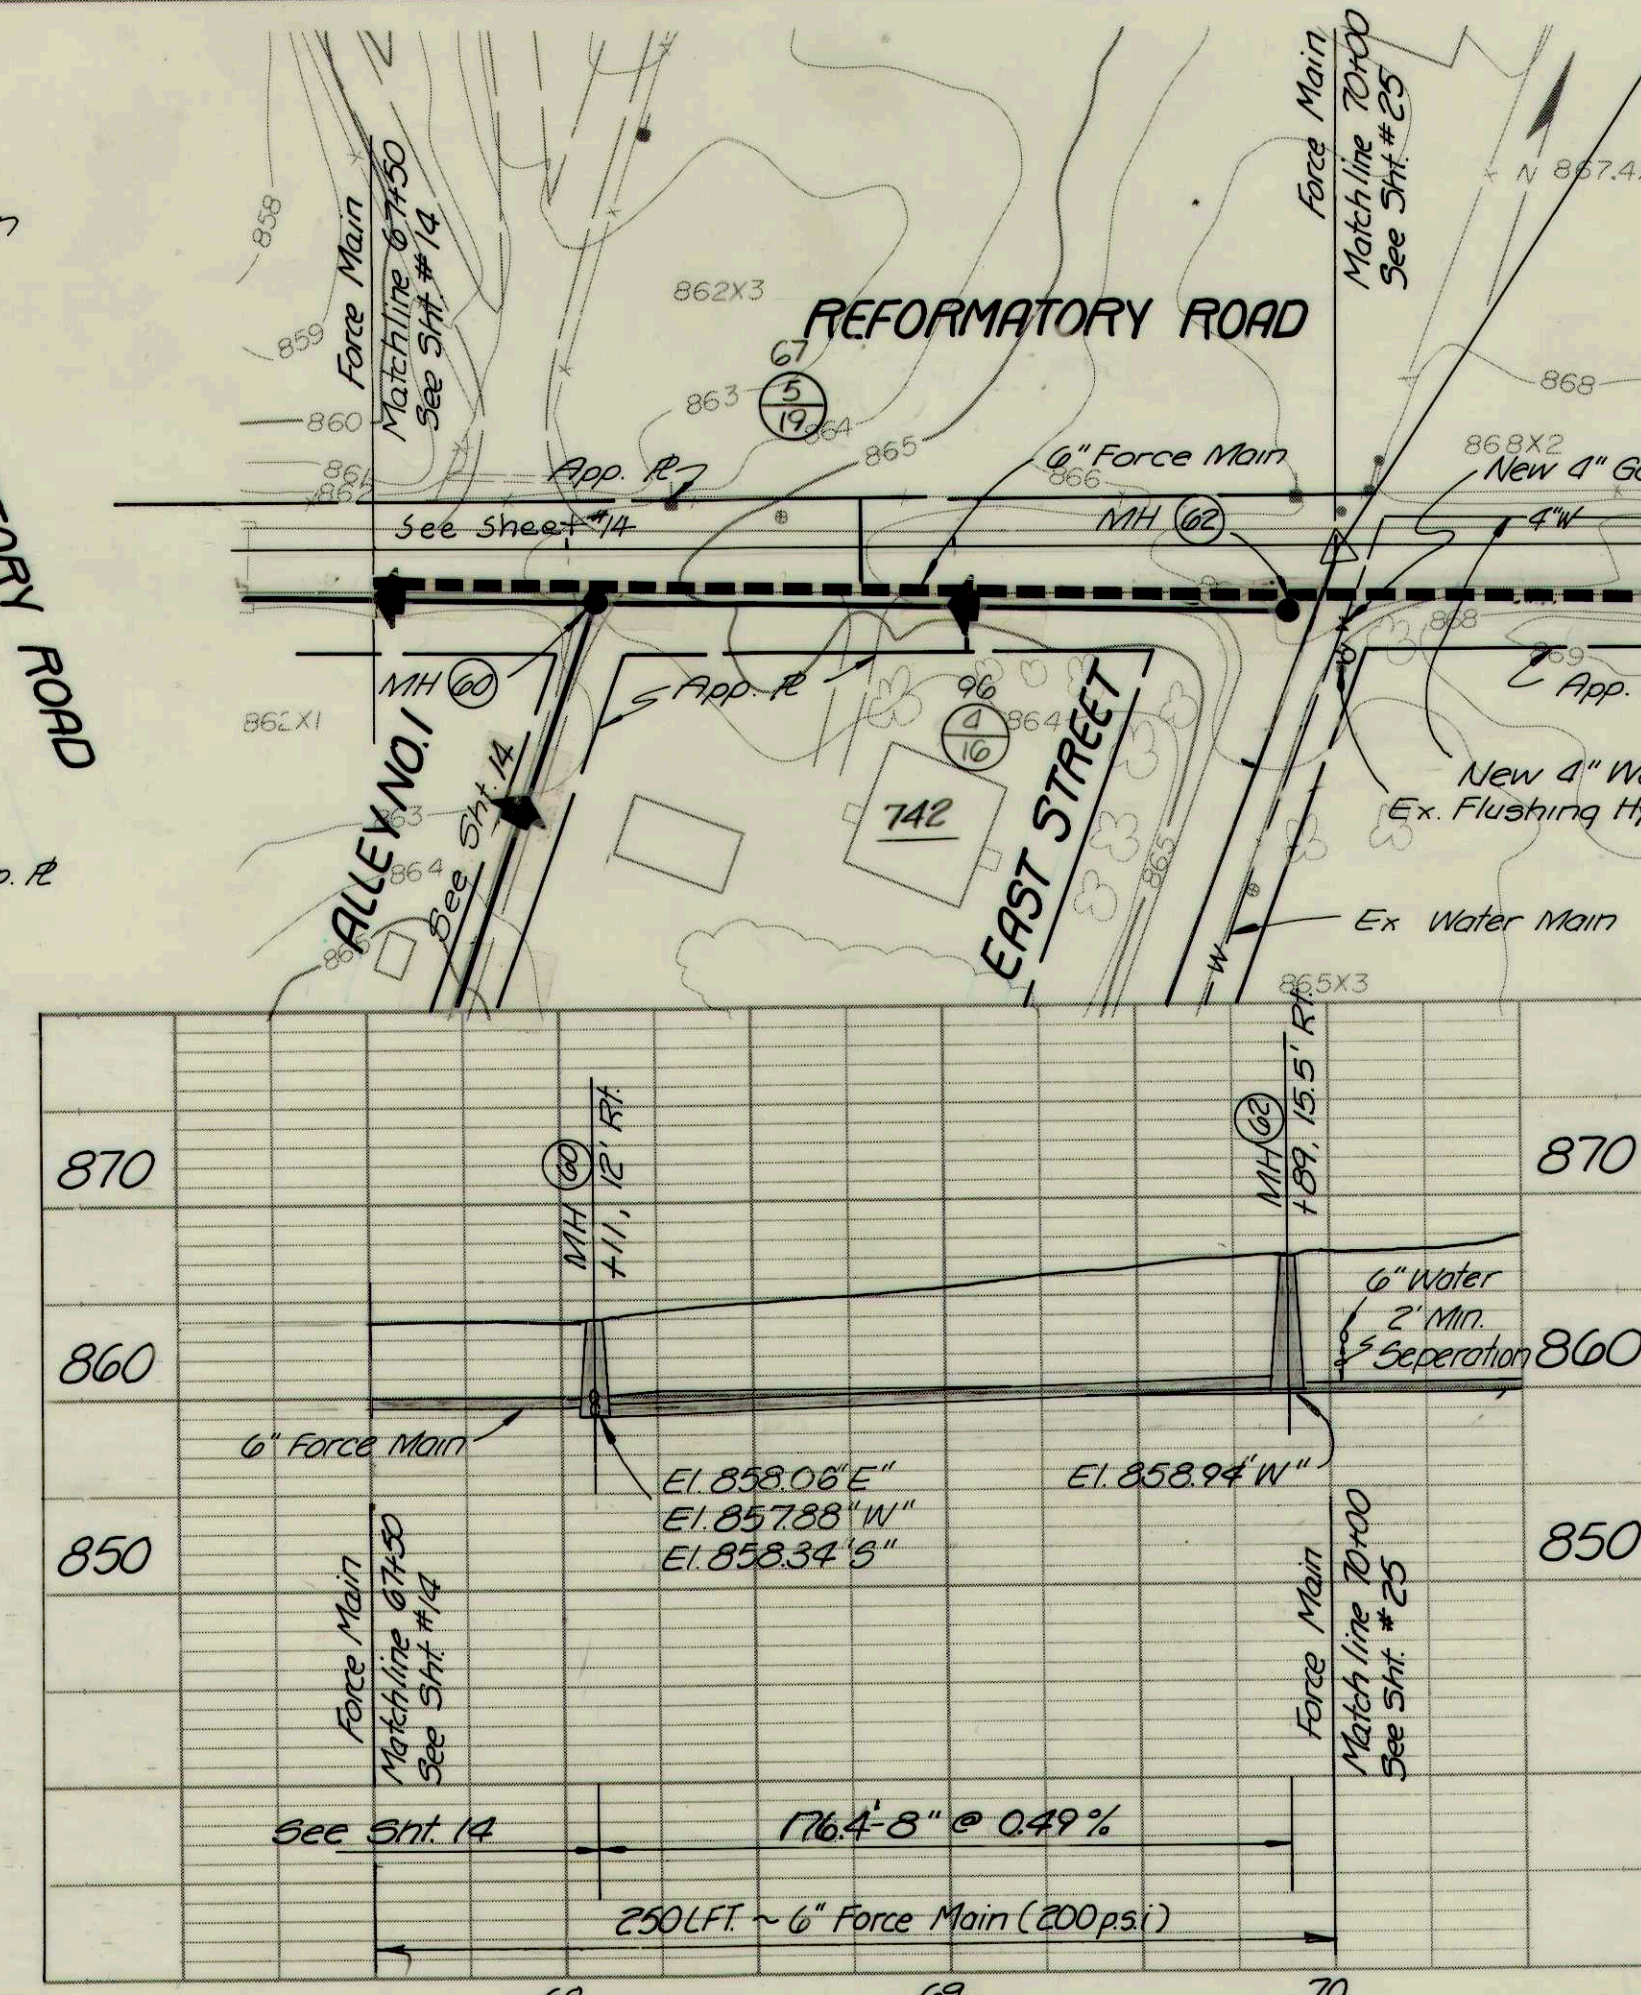
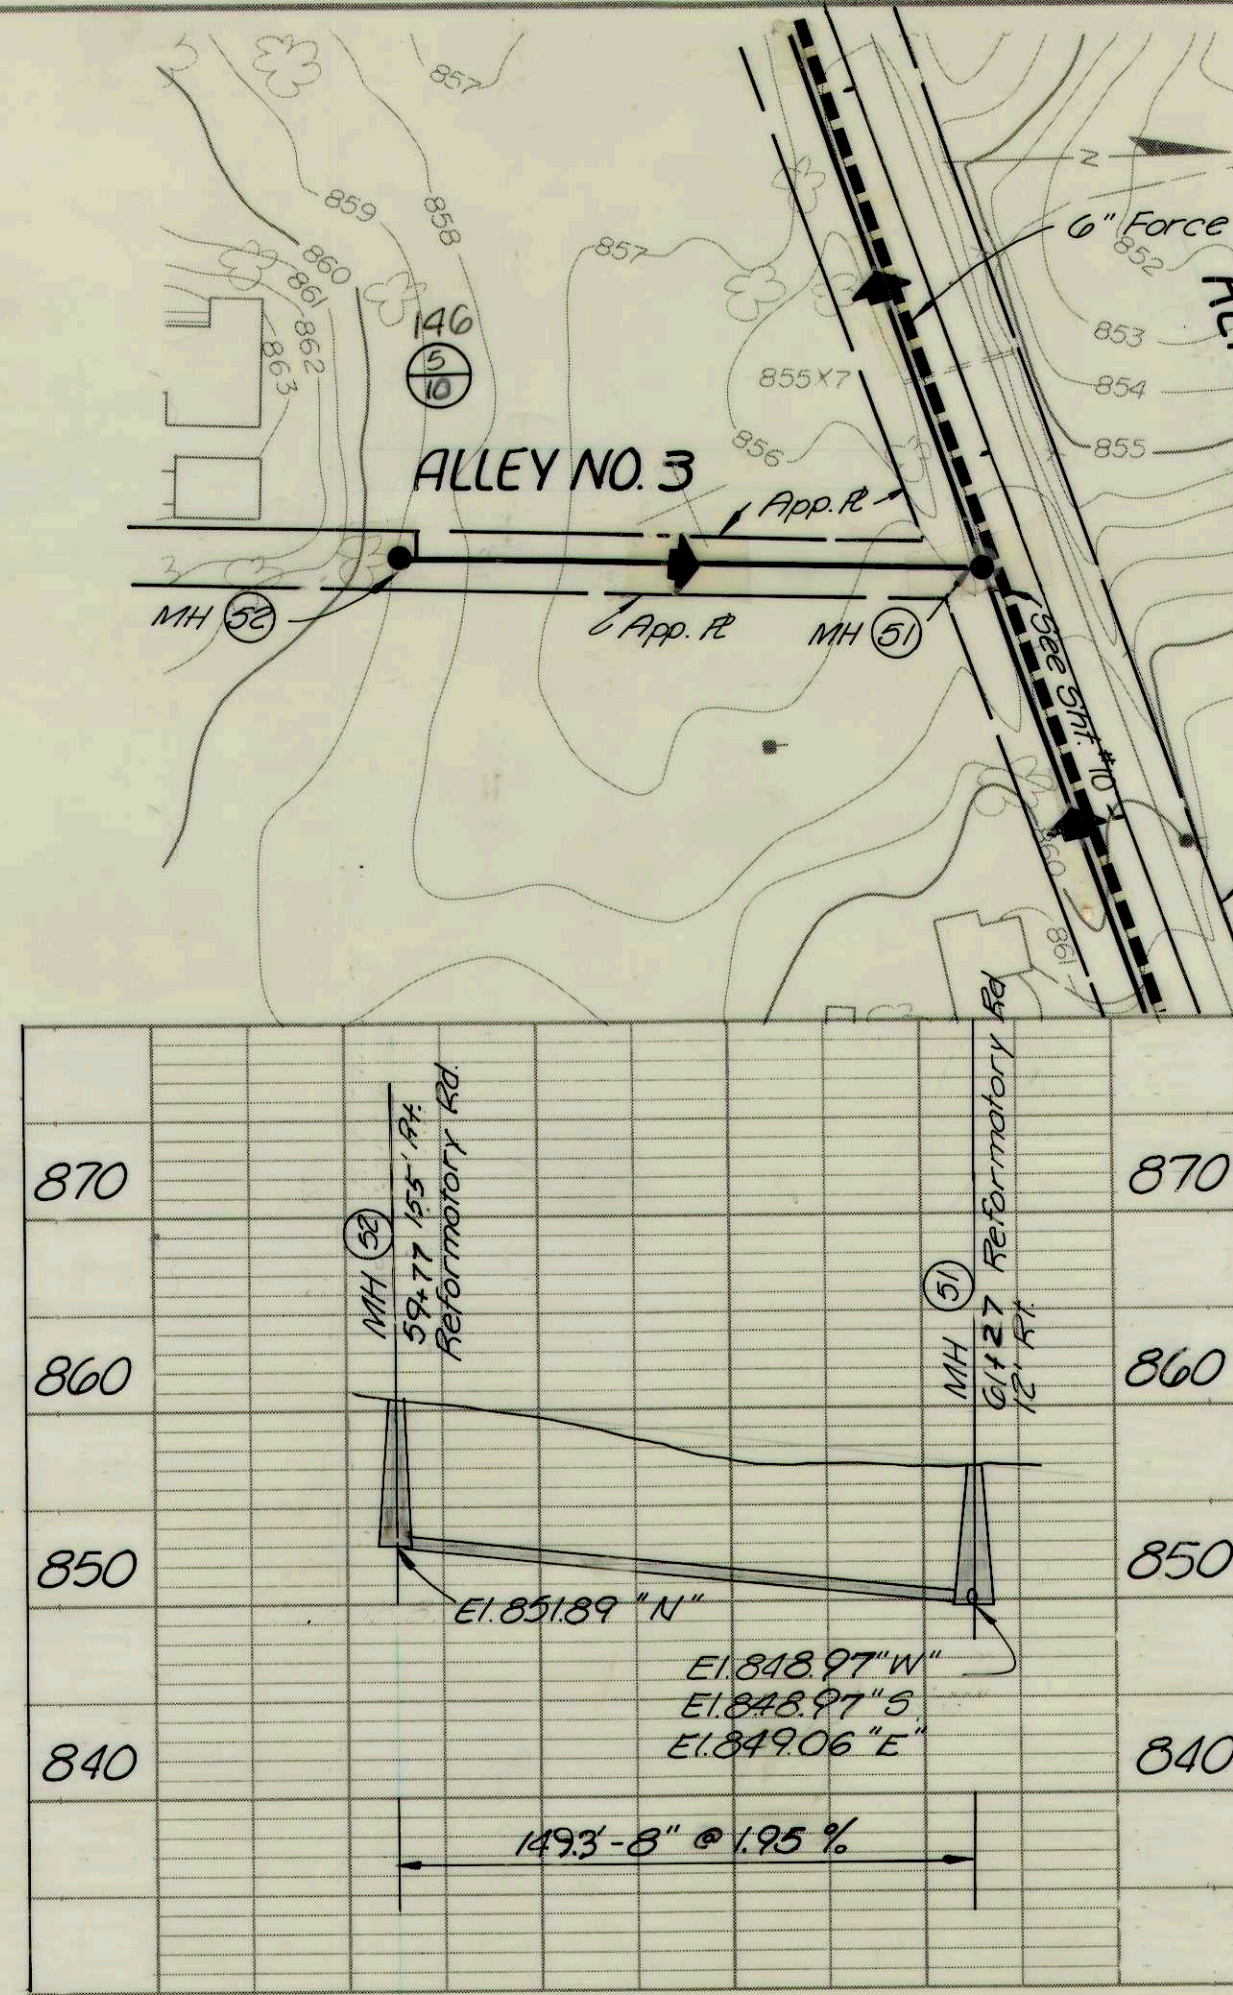


PLAN	SURVEYED	DATE
	NOTED	BY
	GRADES CHECKED	
	RT. OF WAY CHECKED	
NO.		

PROFILE	SURVEYED	DATE
	NOTED	BY
	GRADES CHECKED	
	STRUCTURE NOTATIONS CHECKED	
NO.		

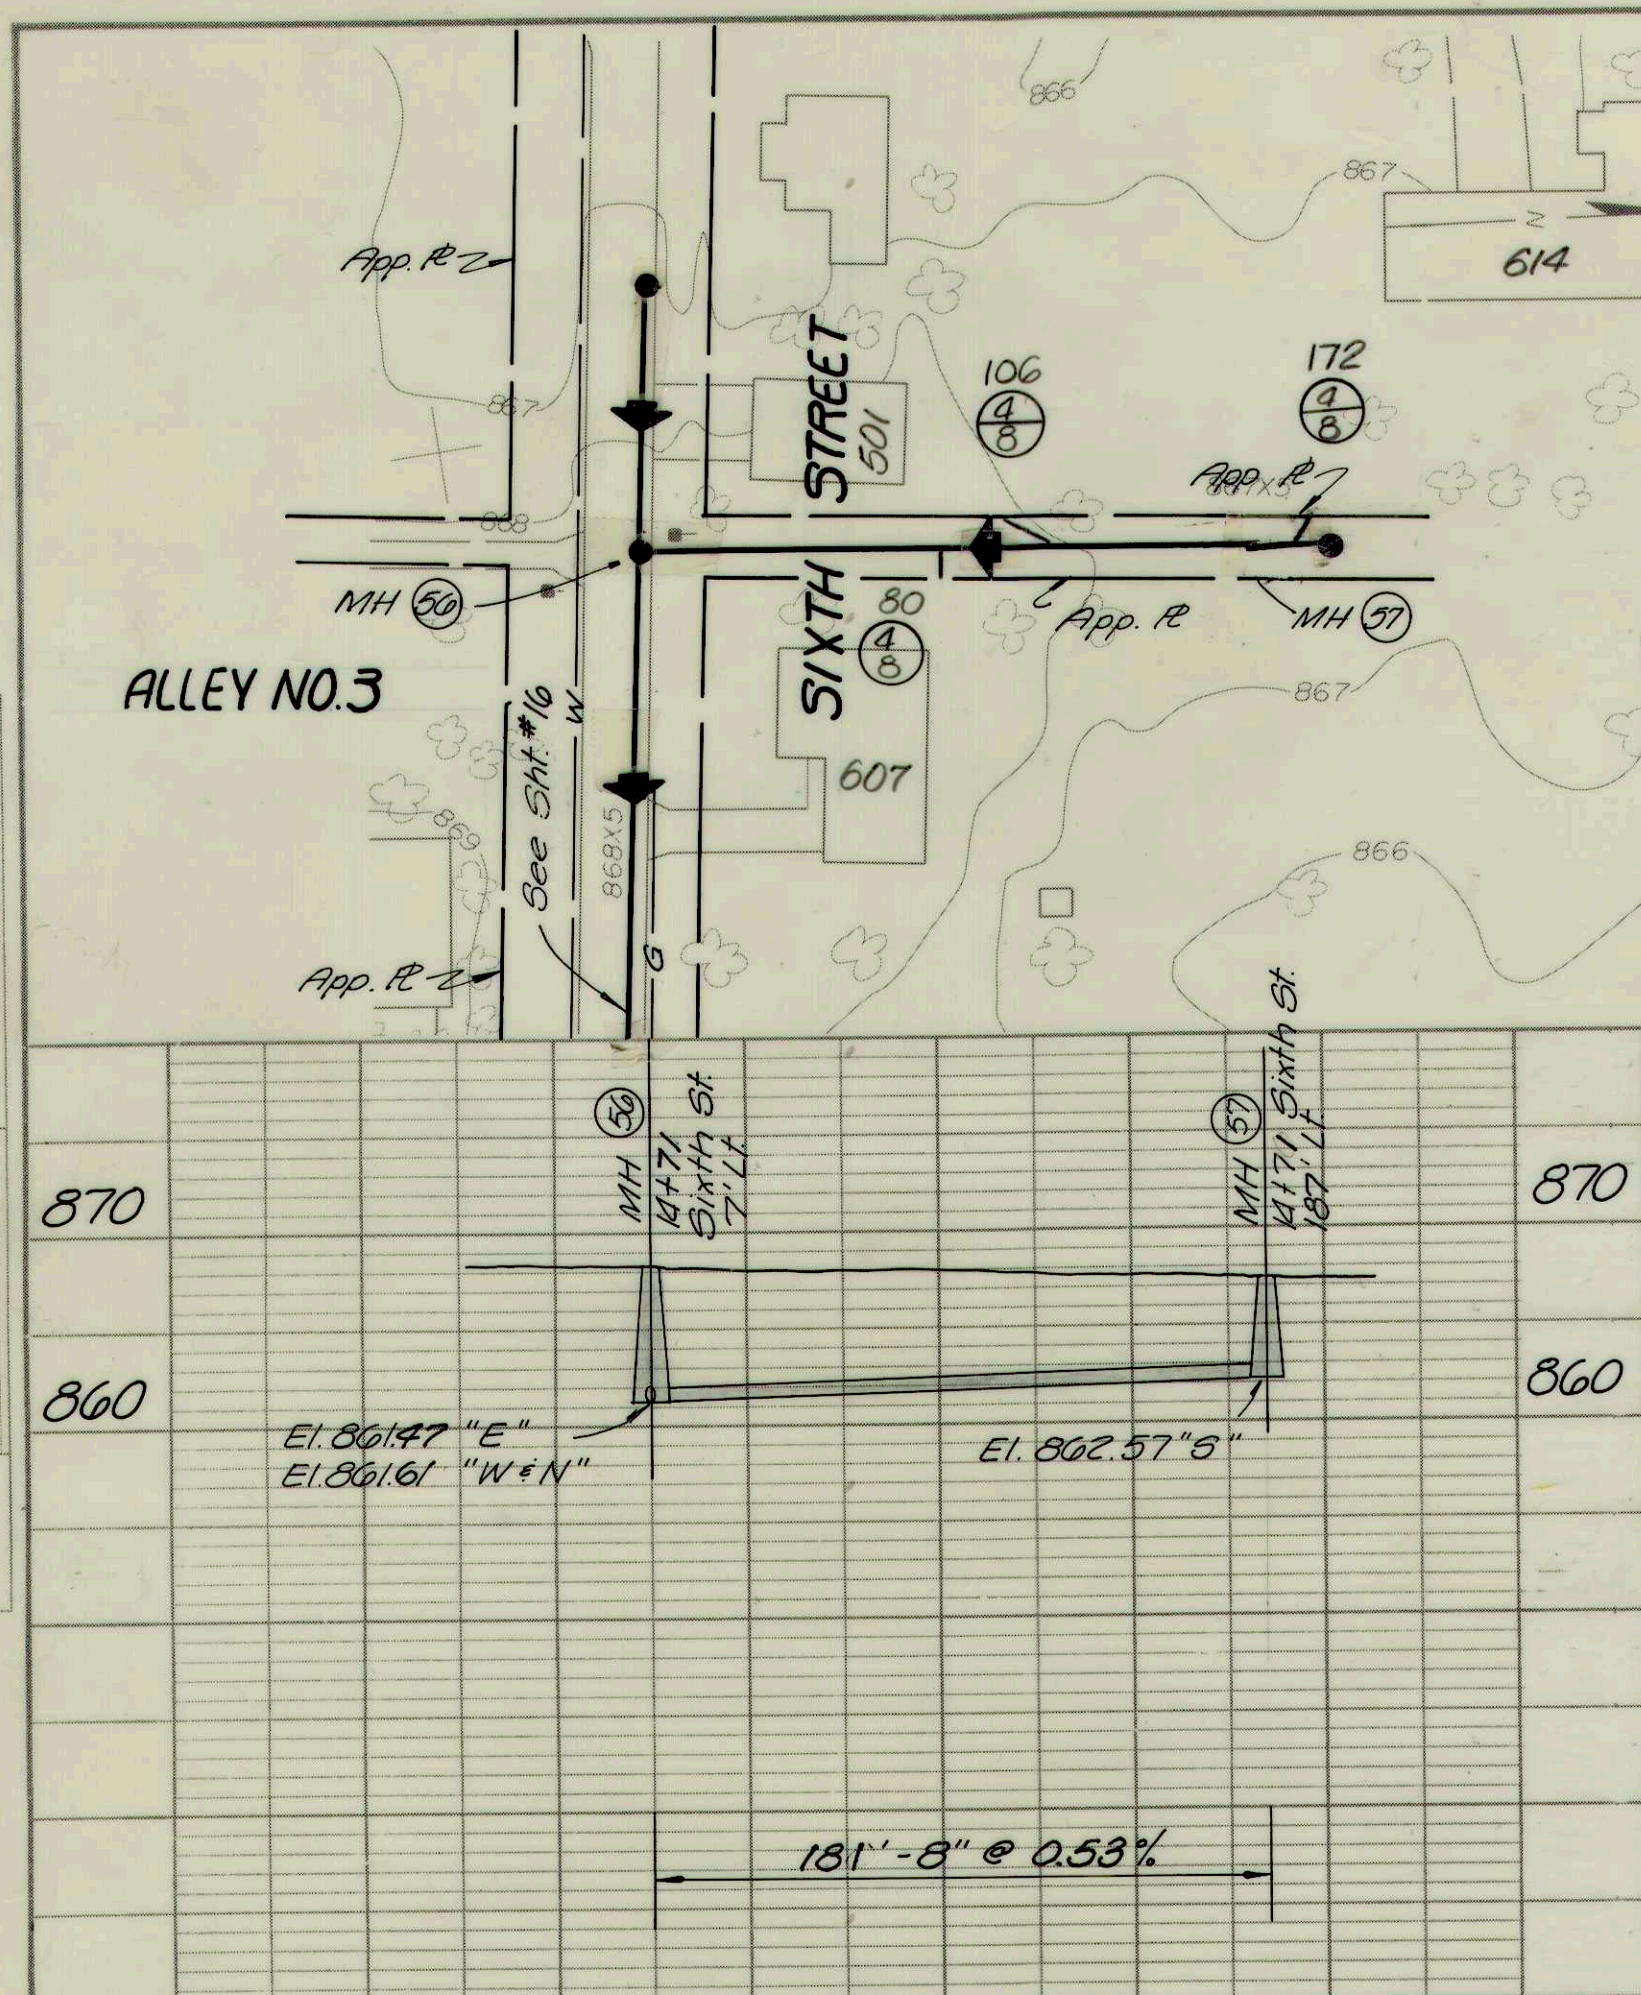

RECORD DRAWING

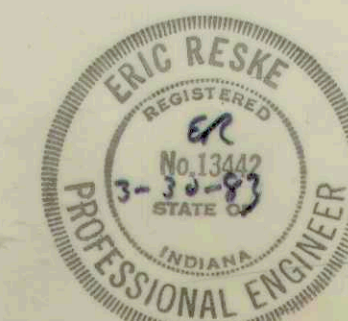

ALLEY #3 REFORMATORY RD. EAST ST. ALLEY #1	
FALL CREEK R.W.D. PLAN & PROFILE	SHEET
HORIZ. 1"=50'	BEAM, LONGEST & NEFF, INC.
VERT. 1"=10'	CONSULTING ENGINEERS
	INDIANAPOLIS, INDIANA
	15