


PLAN	DATE	
	BY	
	SURVEYED	
	NOTED	

PROFILE	DATE	
	BY	
	SURVEYED	
	NOTED	

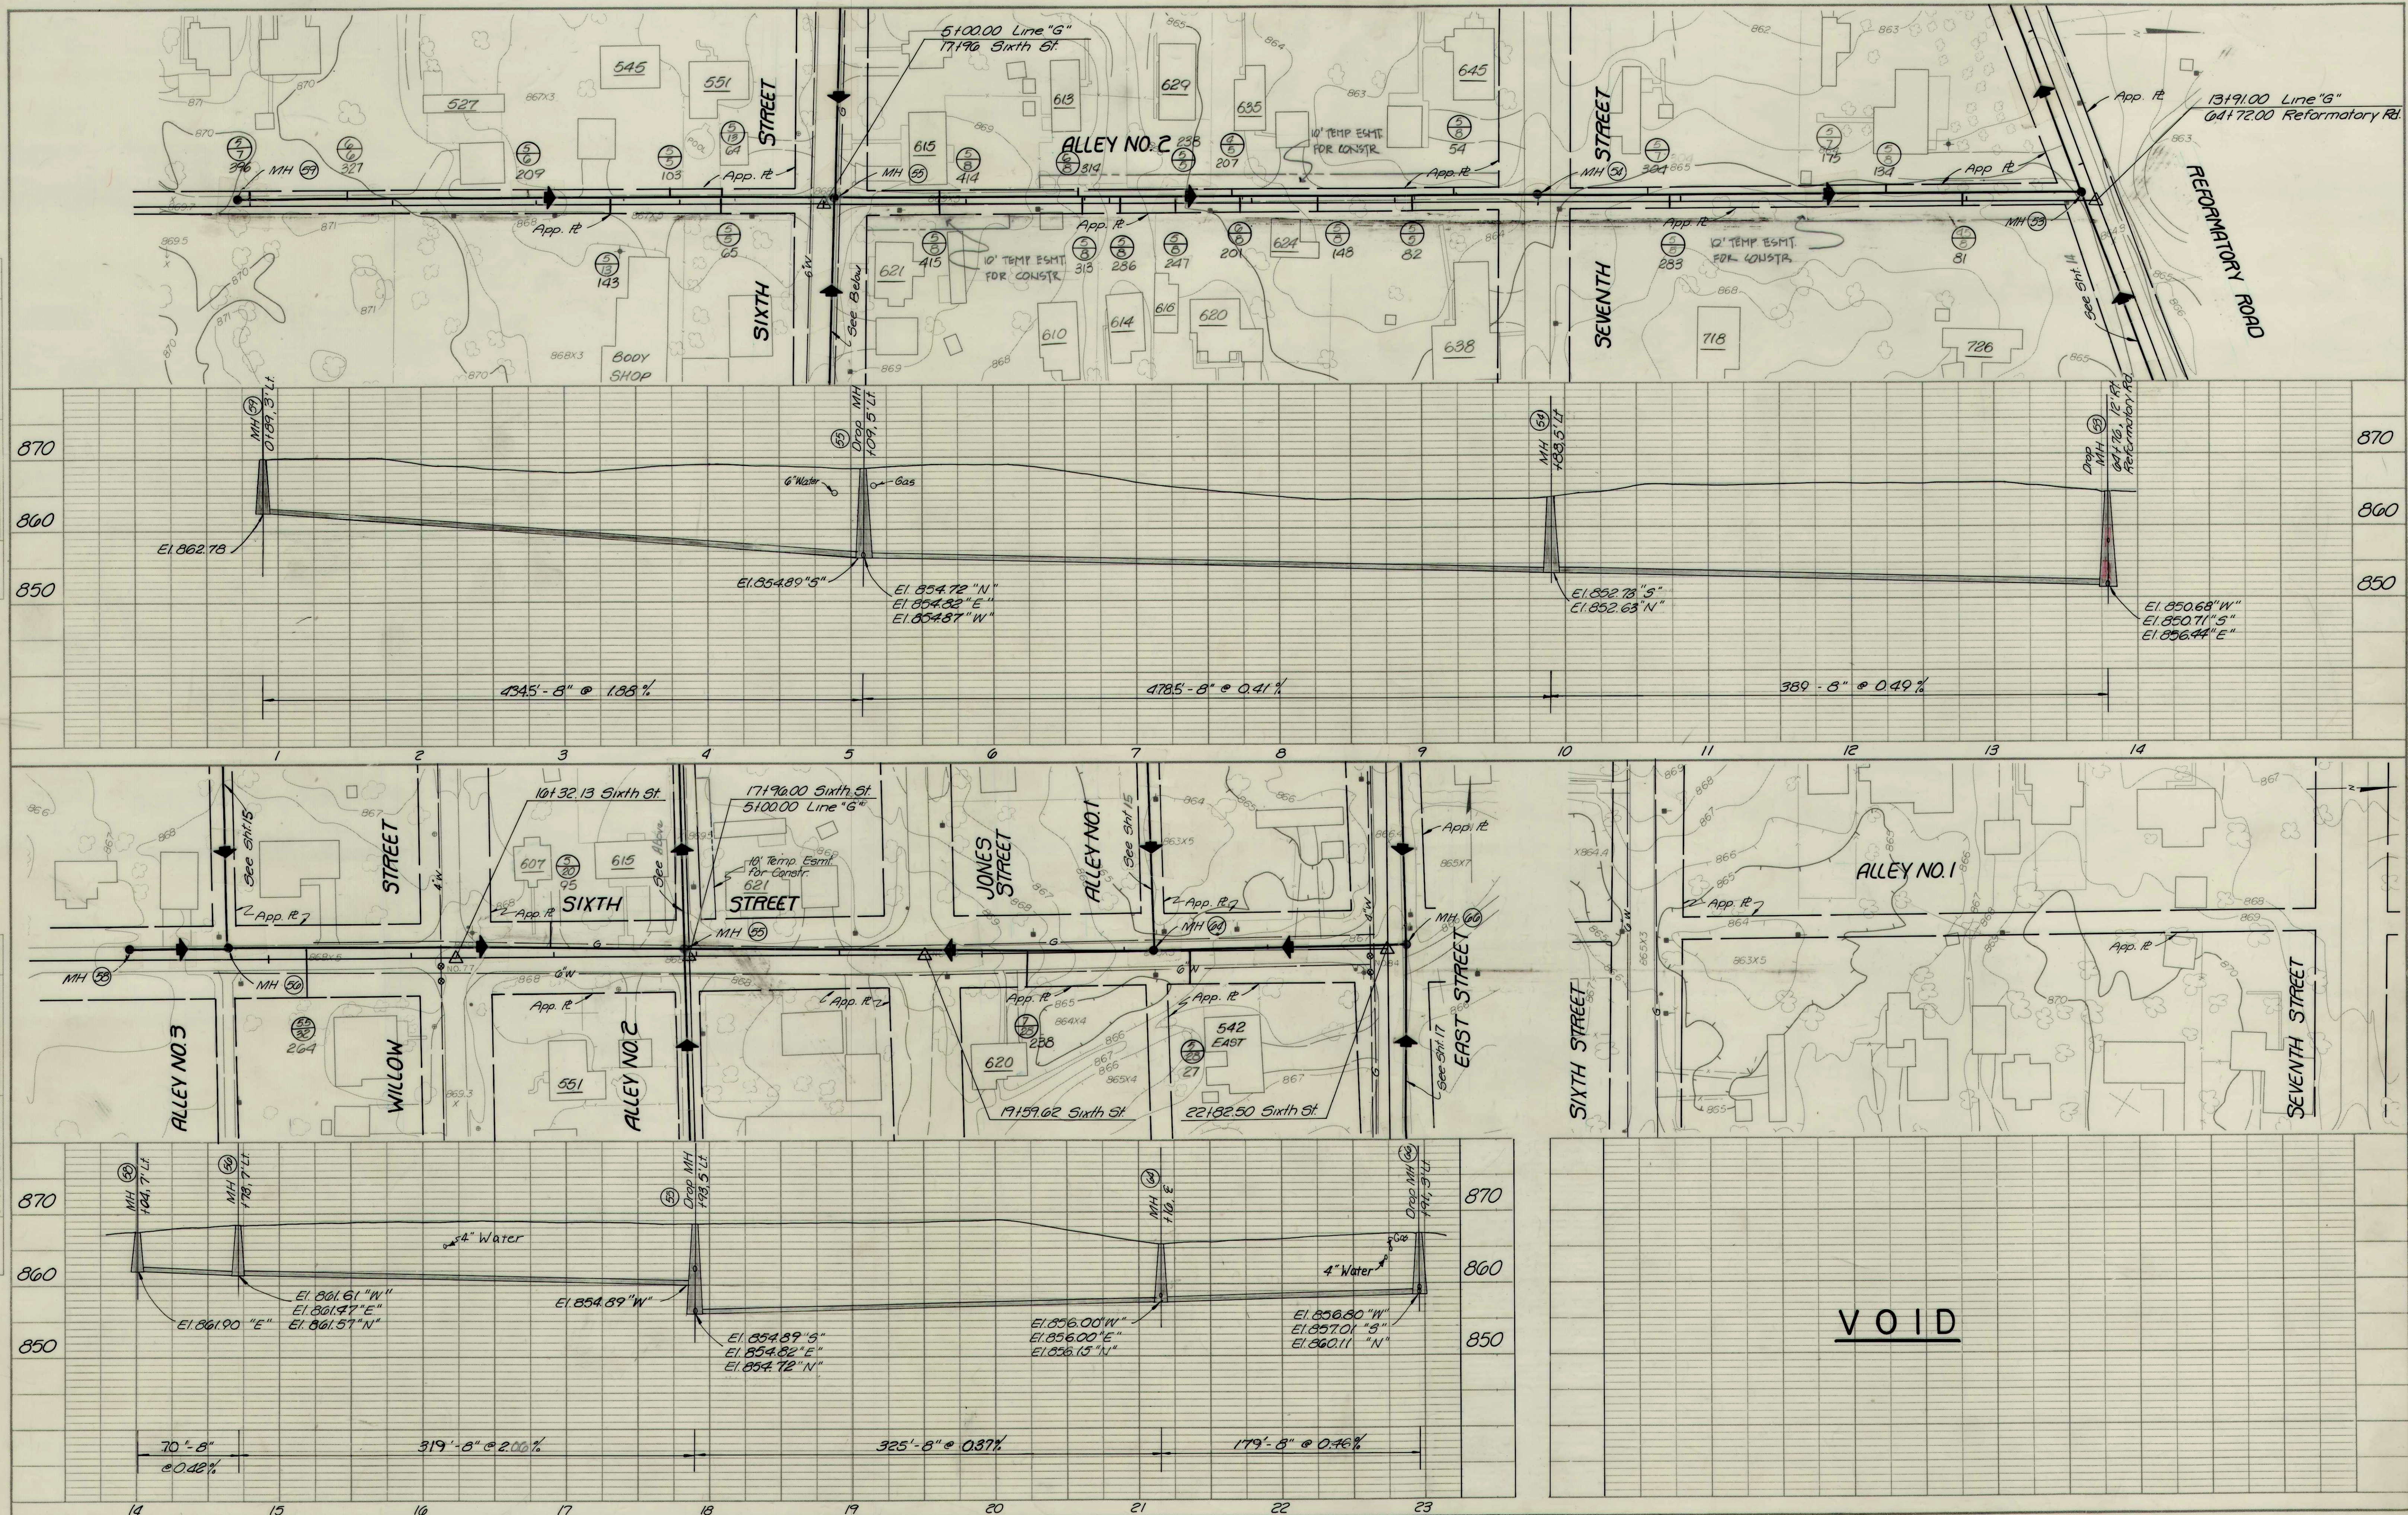

REVISED 3-19-84
CHANGED APP.

RECORD DRAWING

ERIC RESKE
REGISTERED
No. 13442
STATE OF
INDIANA
PROFESSIONAL ENGINEER

ALLEYS #2 SIXTH ST.

FALL CREEK R.W.D. PLAN & PROFILE SHEET

HORIZ. 1"=50'

VERT. 1"=10'

BEAM, LONGEST & NEFF, INC.
CONSULTING ENGINEERS
INDIANAPOLIS, INDIANA

16