

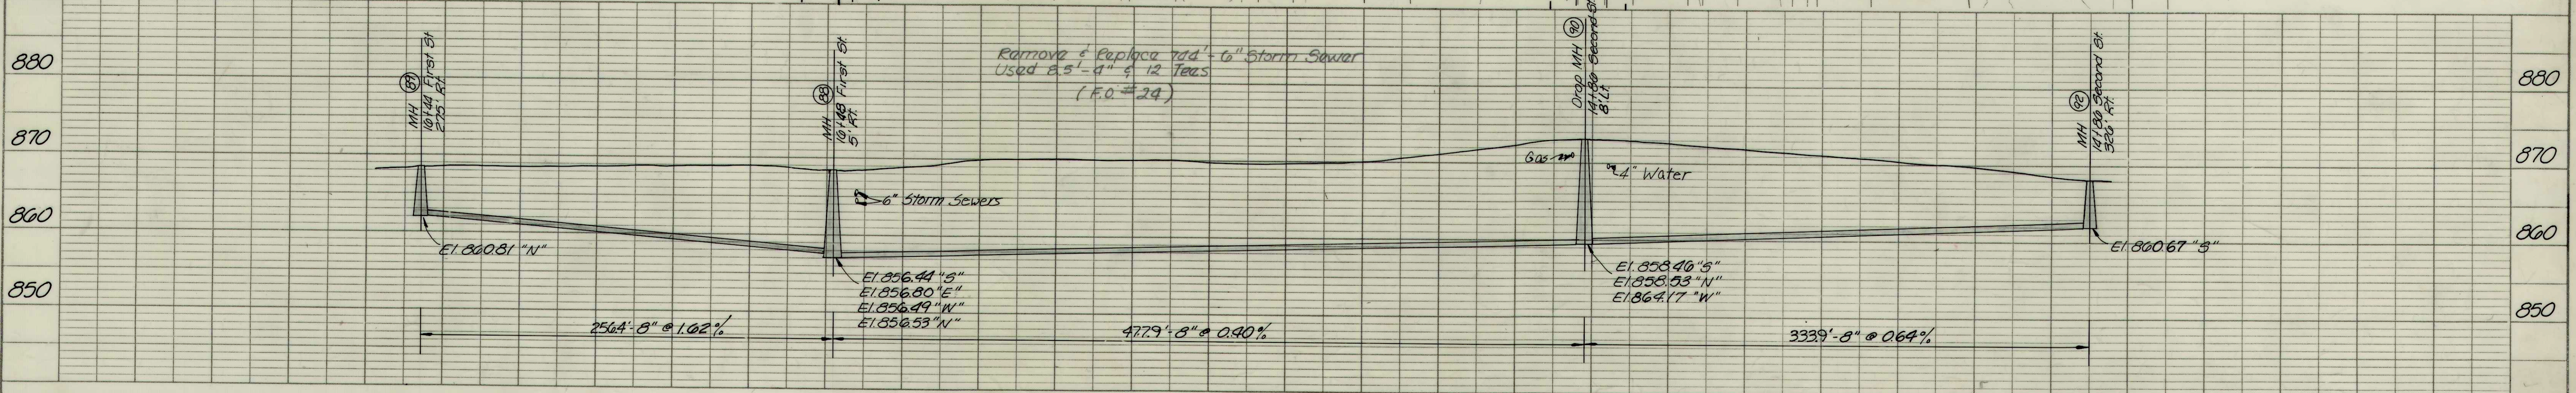
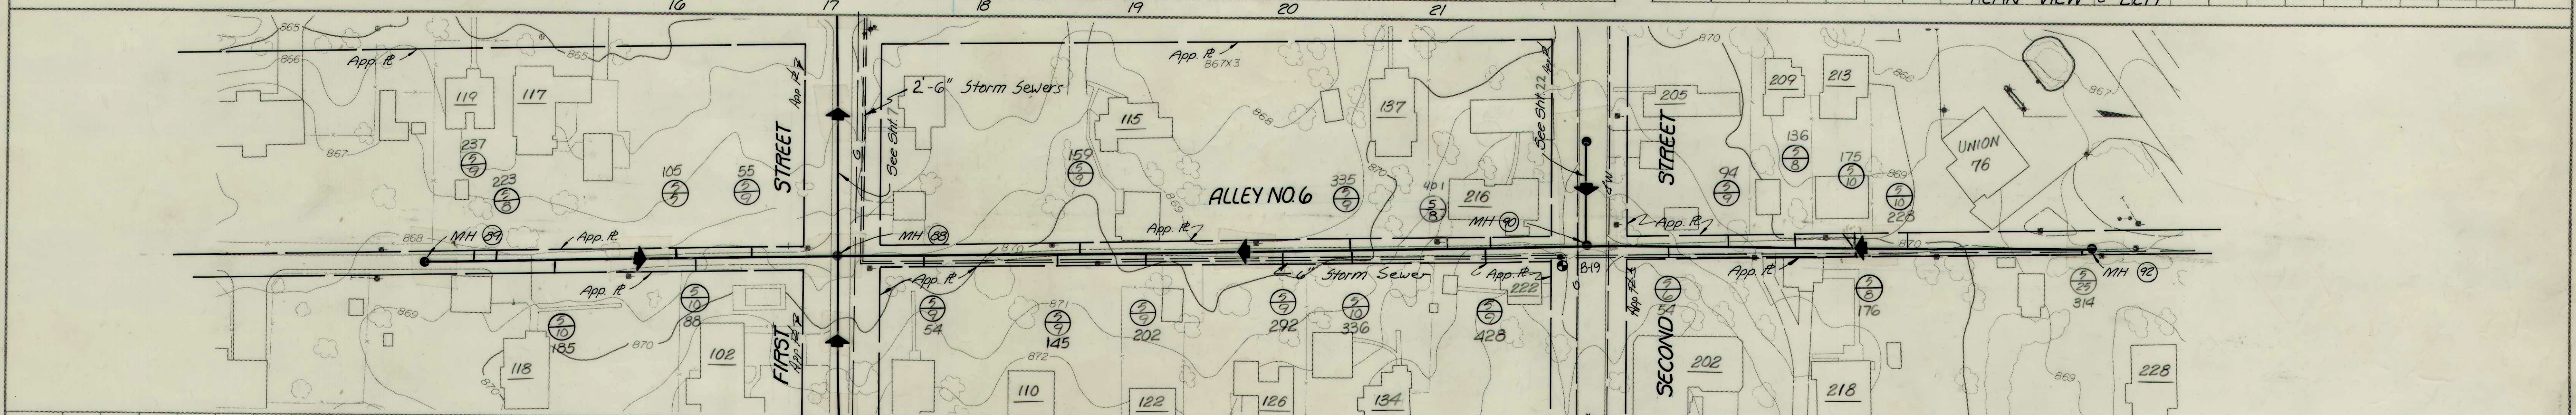
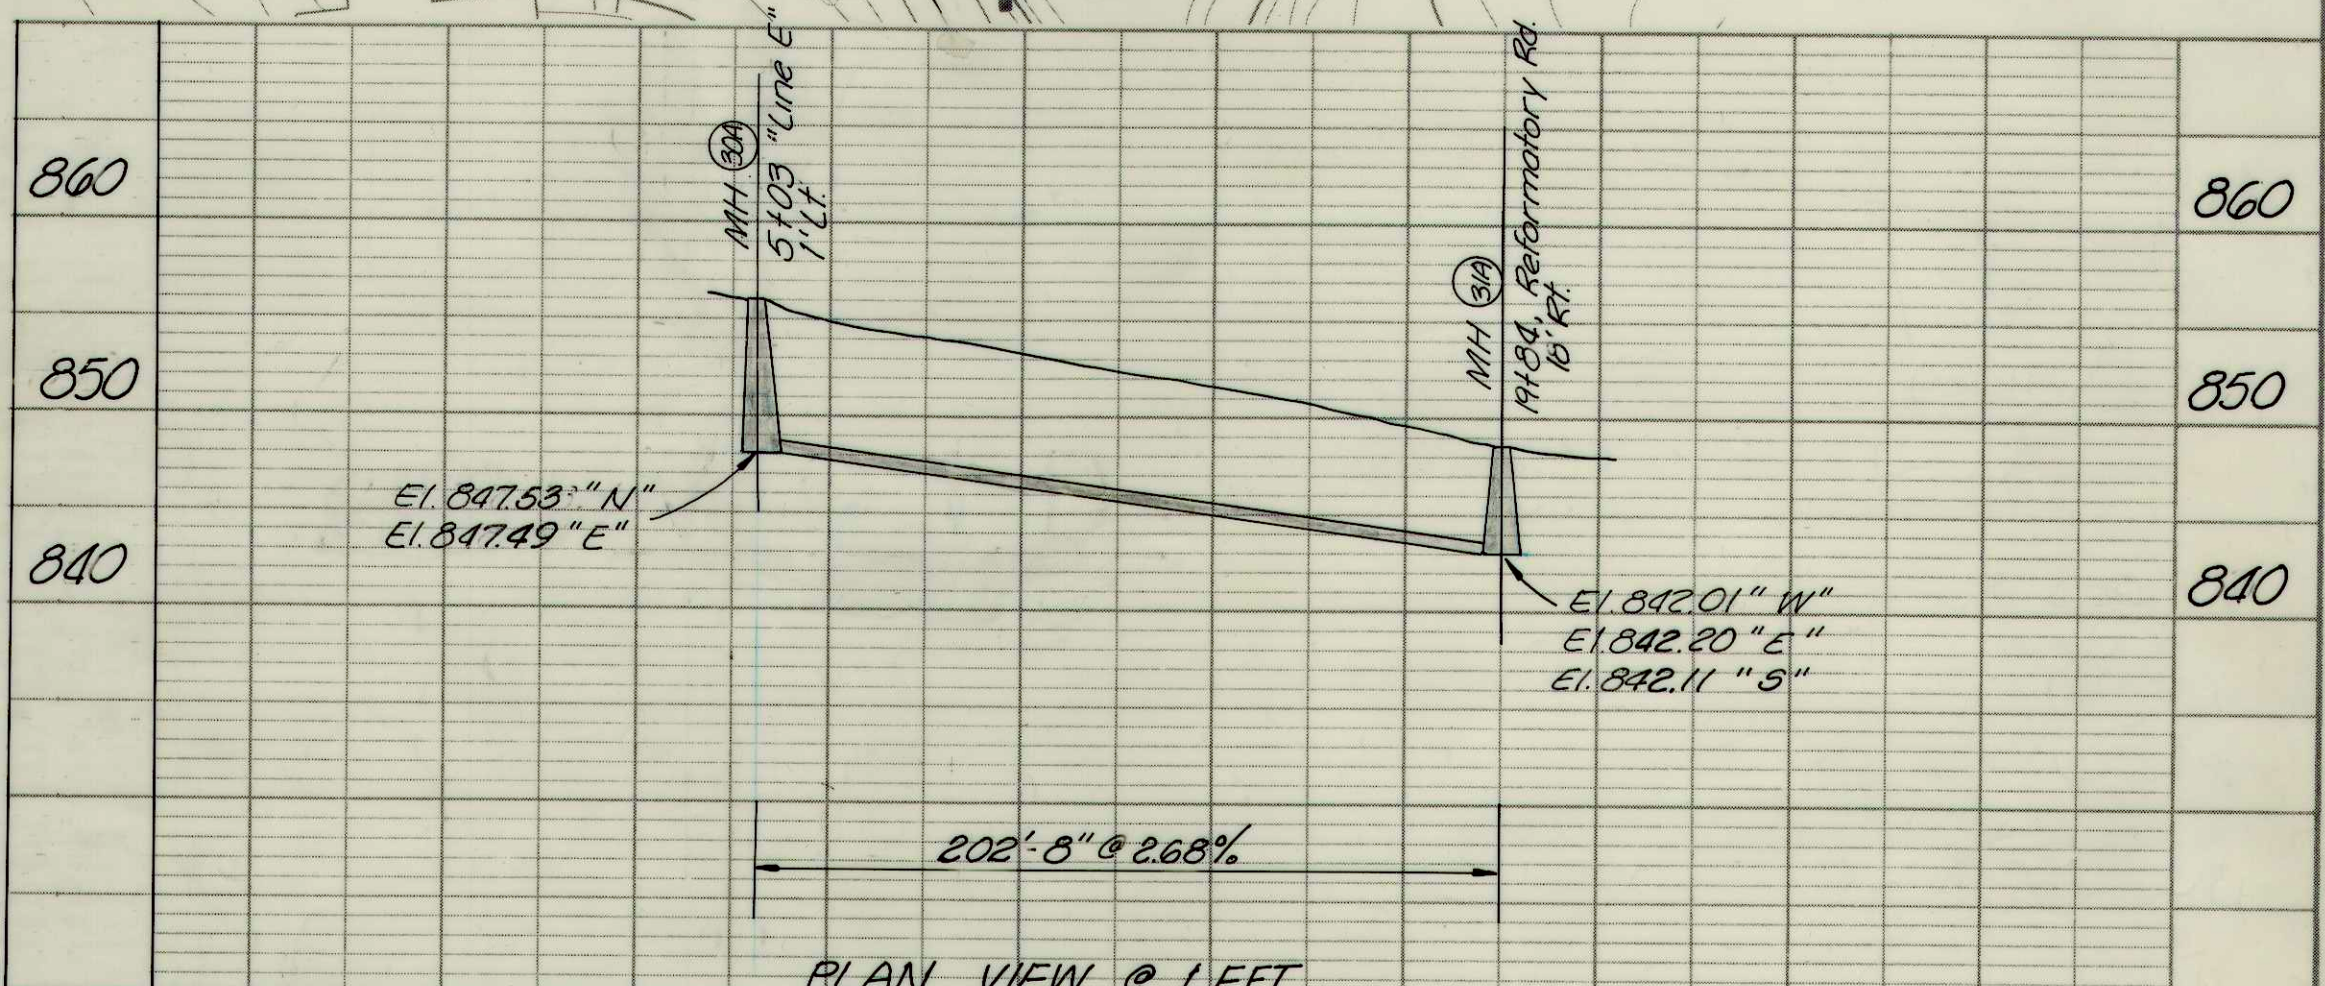
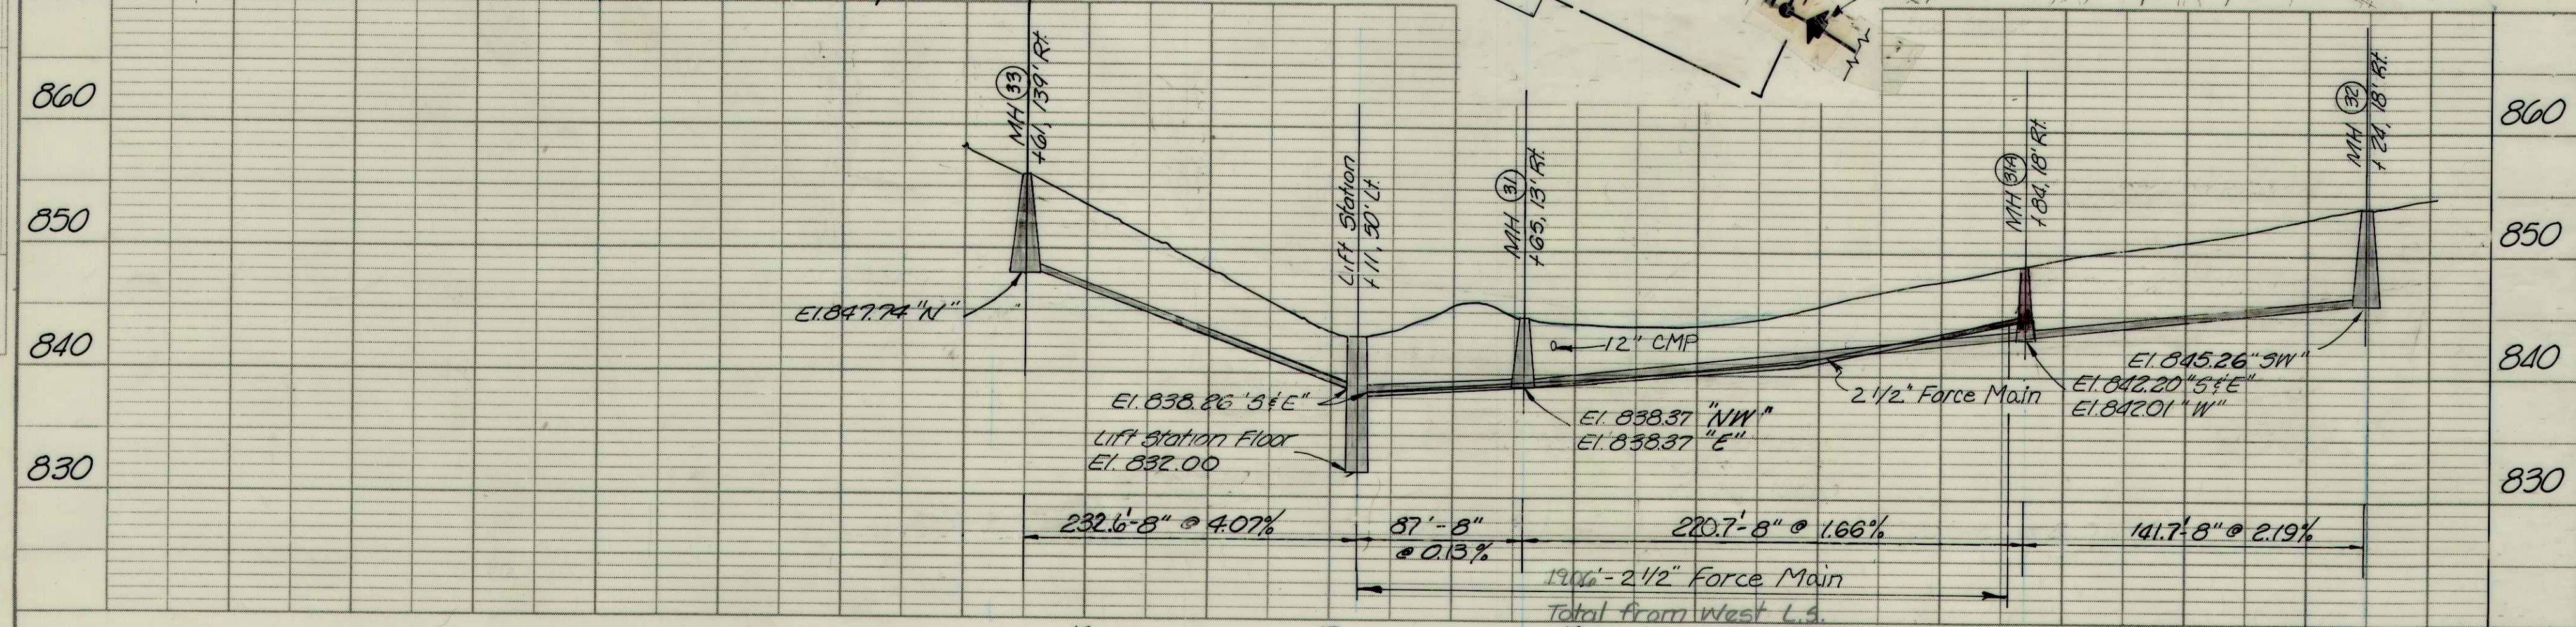


PLAN	SURVEYED	DATE
	NOTED	BY
	FLIGHT	
	NOTE BOOK	

PROFILE	SURVEYED	DATE
	NOTED	BY
	FLIGHT	
	NOTE BOOK	

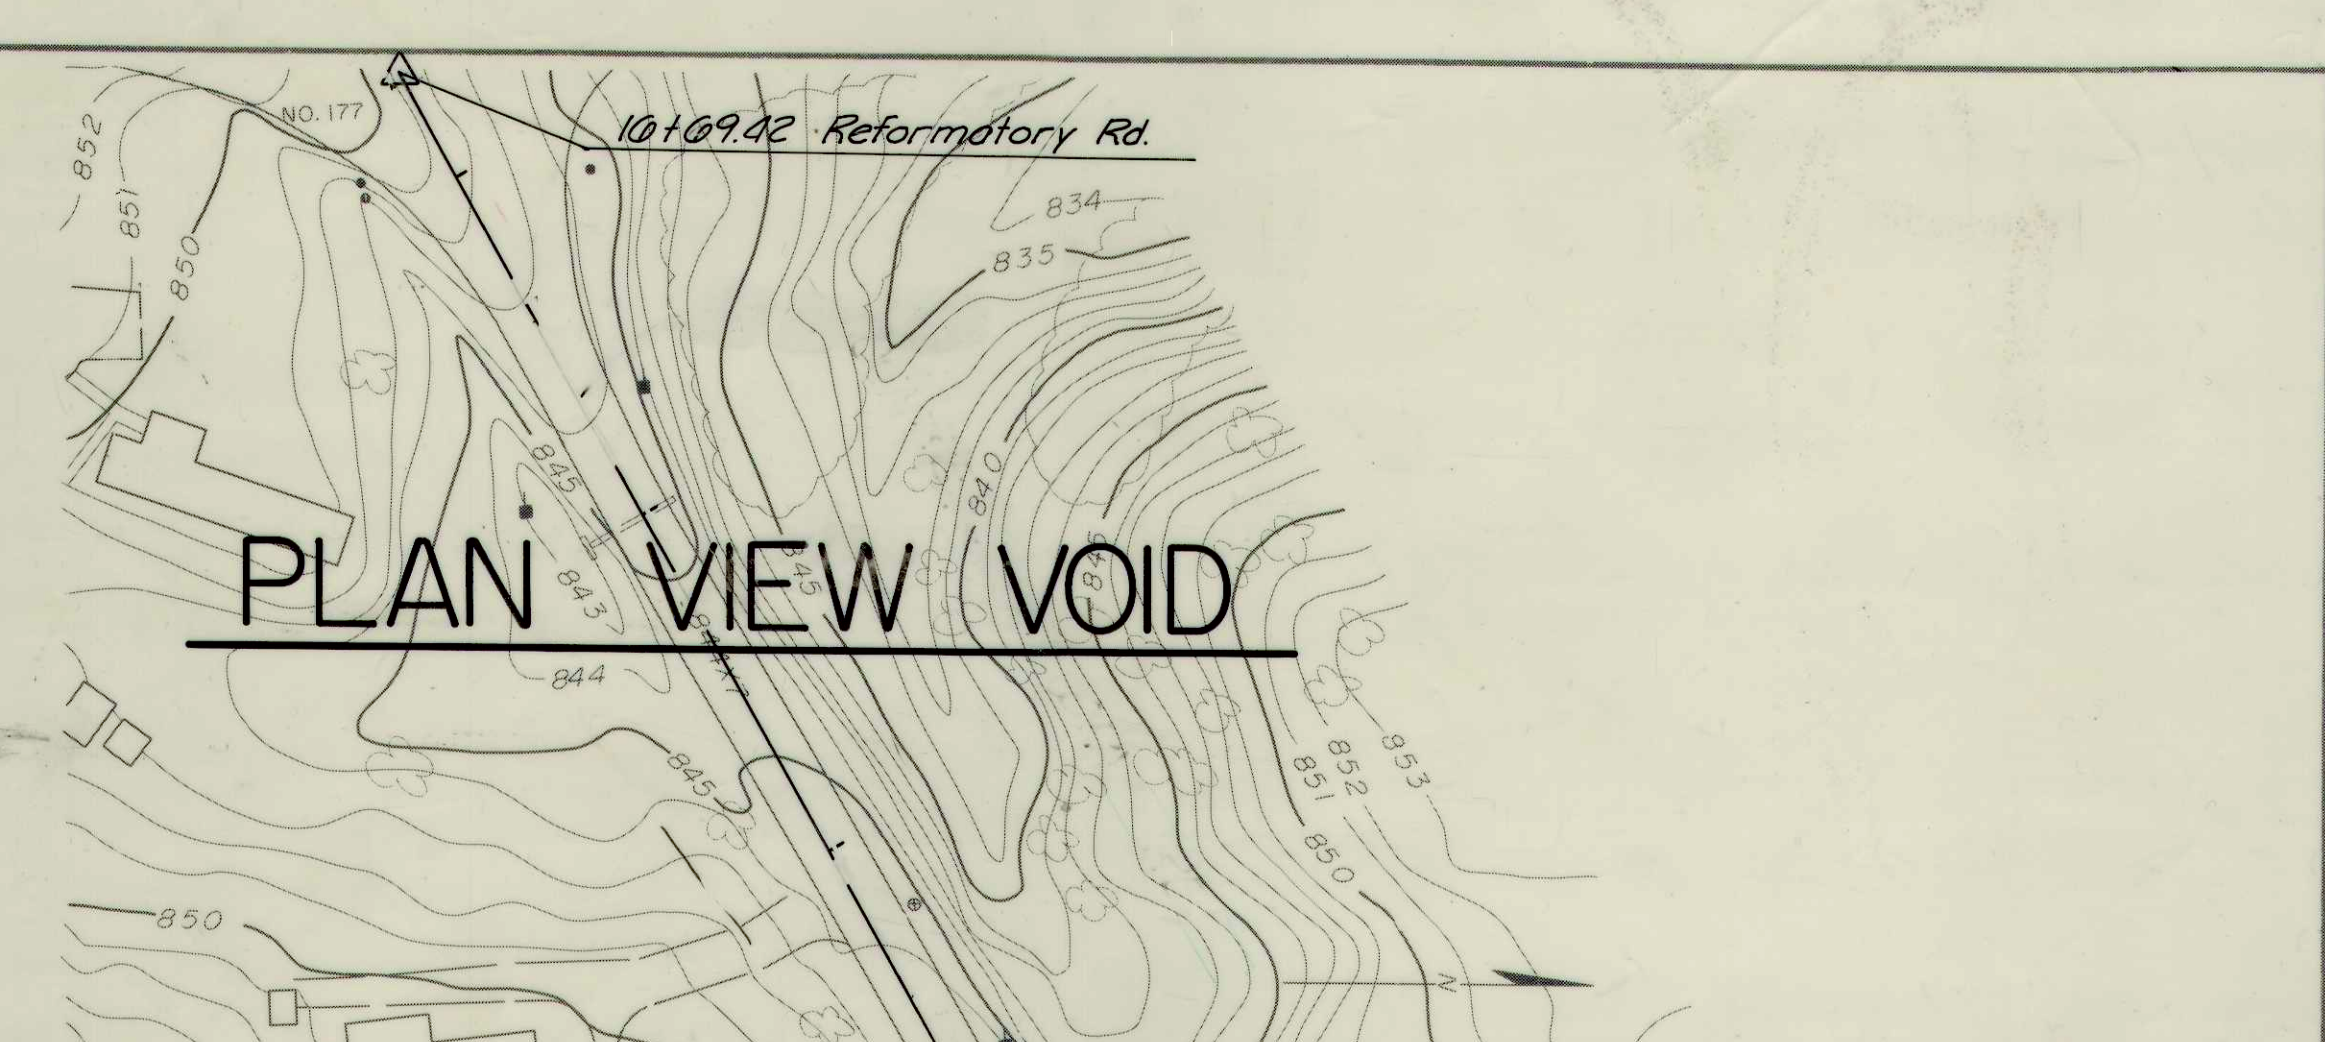

RECORD DRAWING

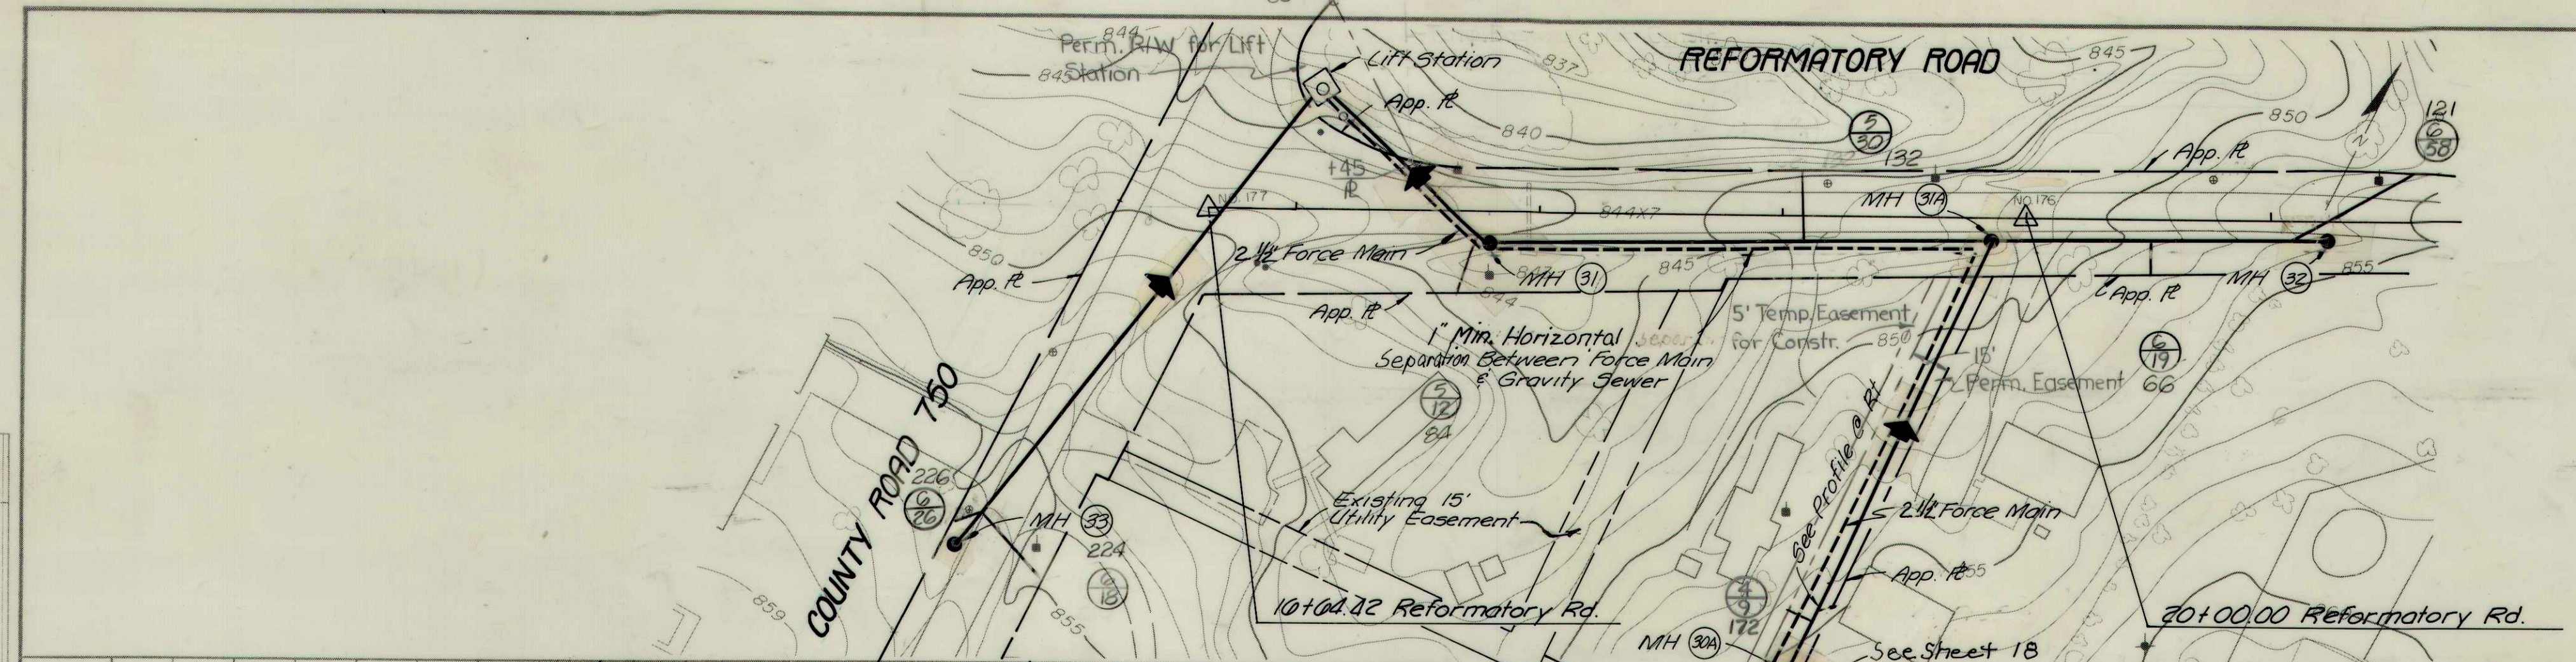

REFORMATORY RD ALLEY #6	
FALL CREEK R.W.D. PLAN & PROFILE	SHEET
HORIZ. 1"=50'	BEAM, LONGEST & NEFF, INC.
VERT. 1"=10'	CONSULTING ENGINEERS
	INDIANAPOLIS, INDIANA
	19